

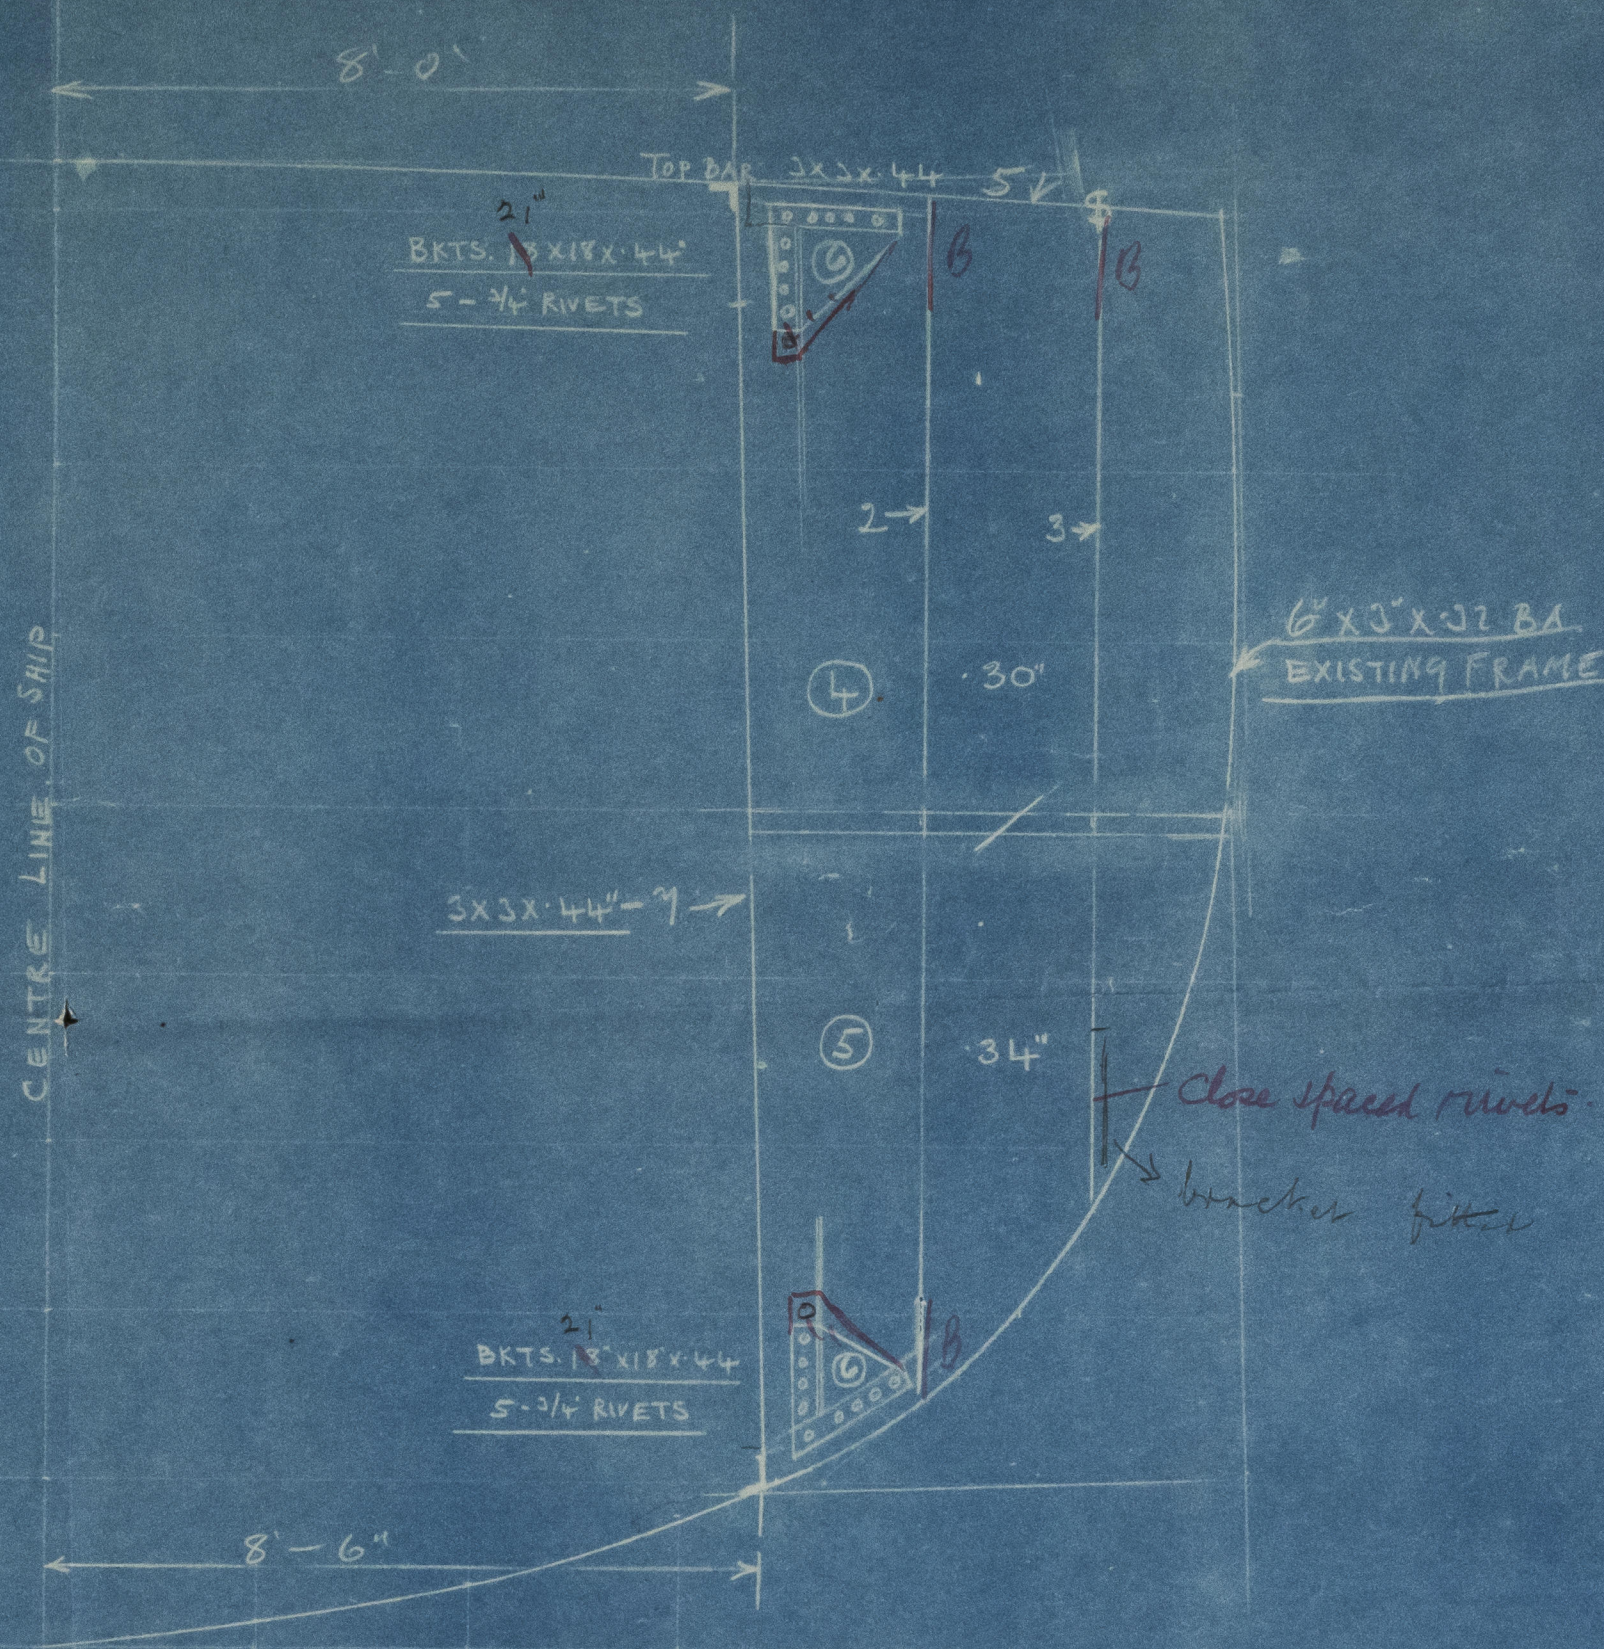


12/1/28

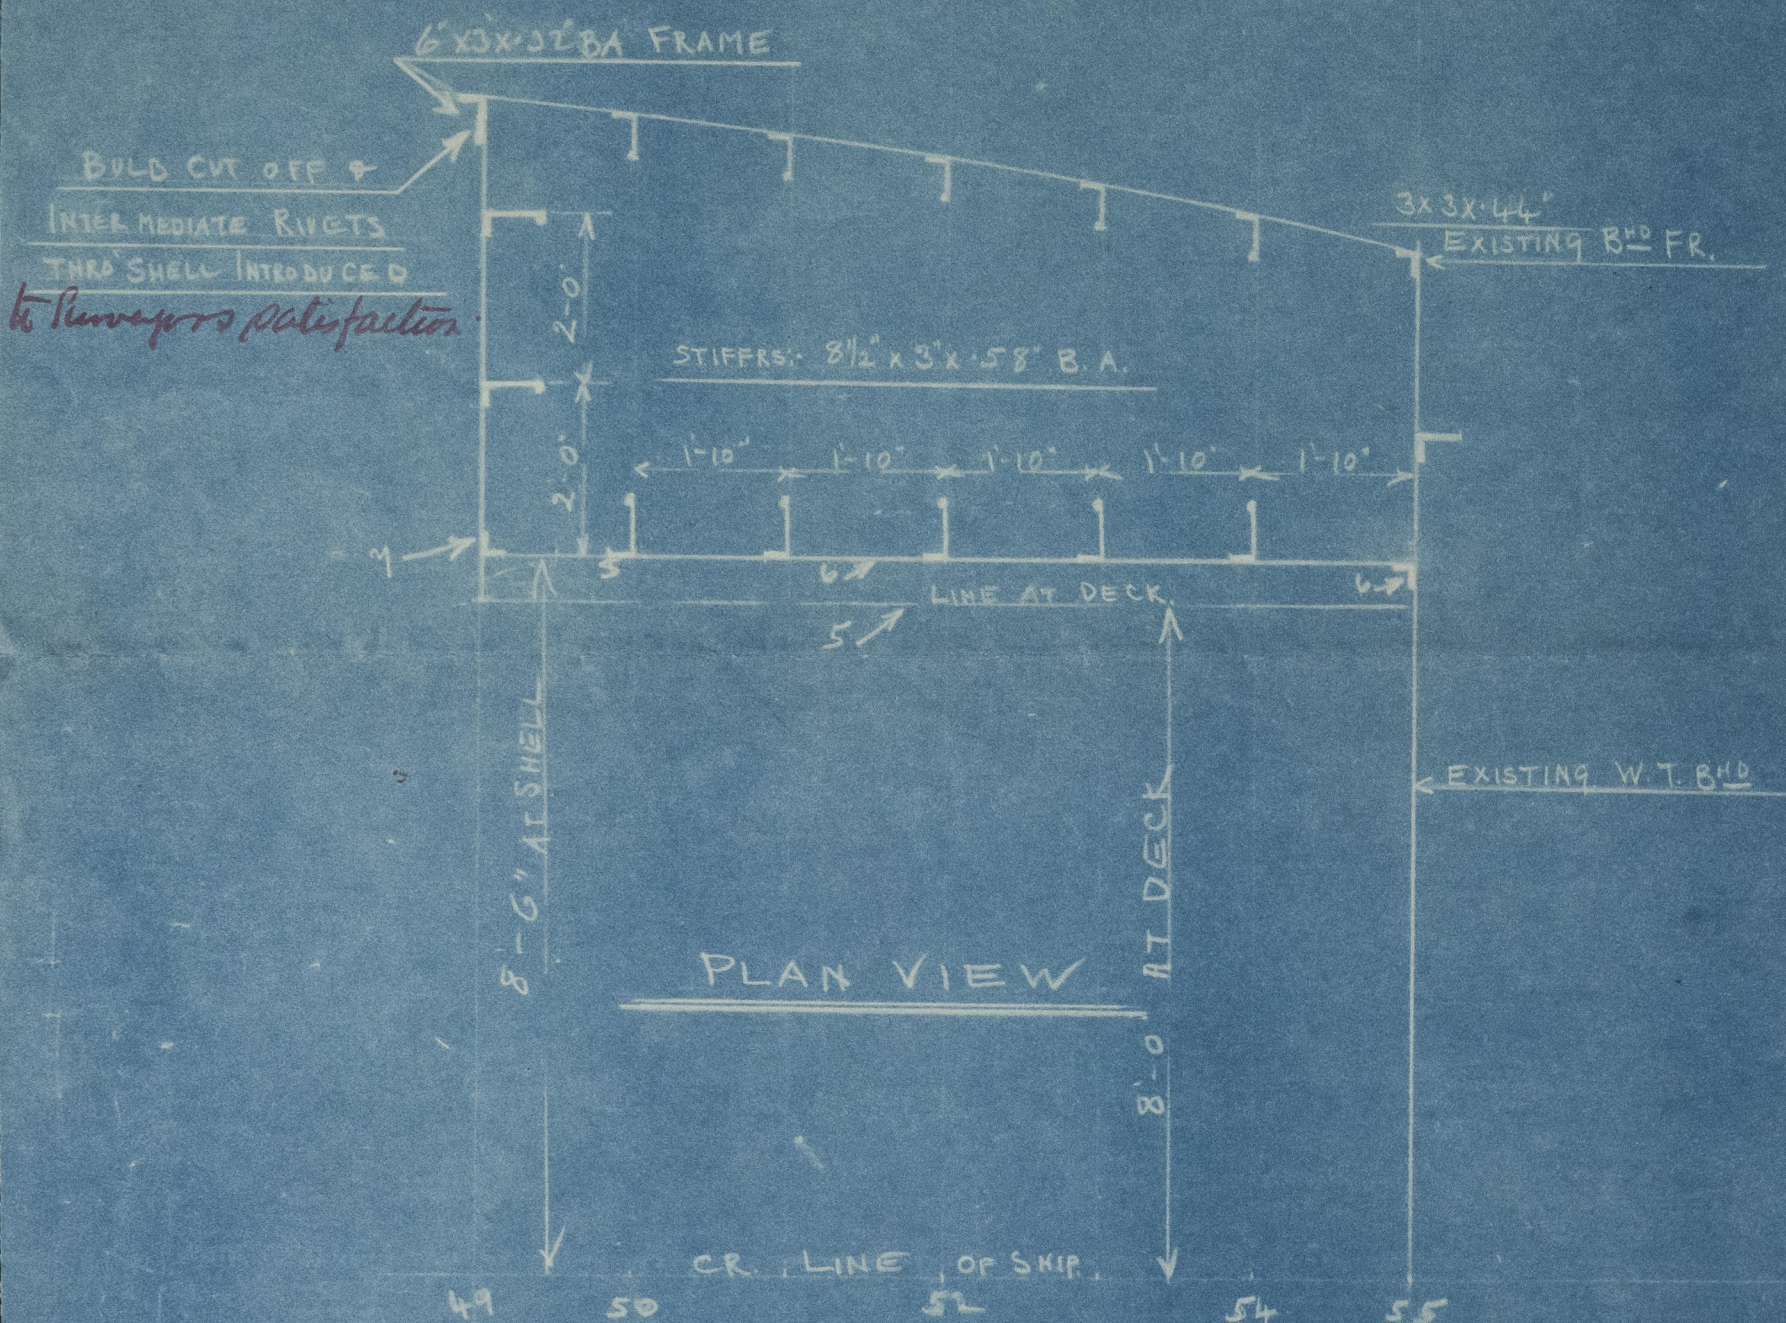

SECTION AT FRAME 49
LOOKING AFT
STARBOARD SIDE SIMILAR

S.T. SI BOTOLPH
SCALE 1/2" = 1 FOOT
FEED WATER TANKS. P & S.

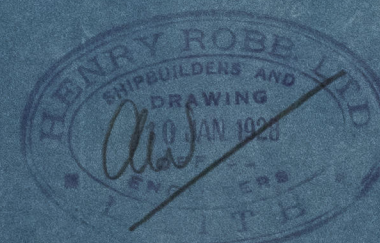

Lloyd's Register
012108-21212-0069

W.S.
11-1-28

S/T ^u "ST BOTOLPH"

Feed Water Tanks P & S



© 2021

Lloyd's Register
Foundation

012108-012112-0069