

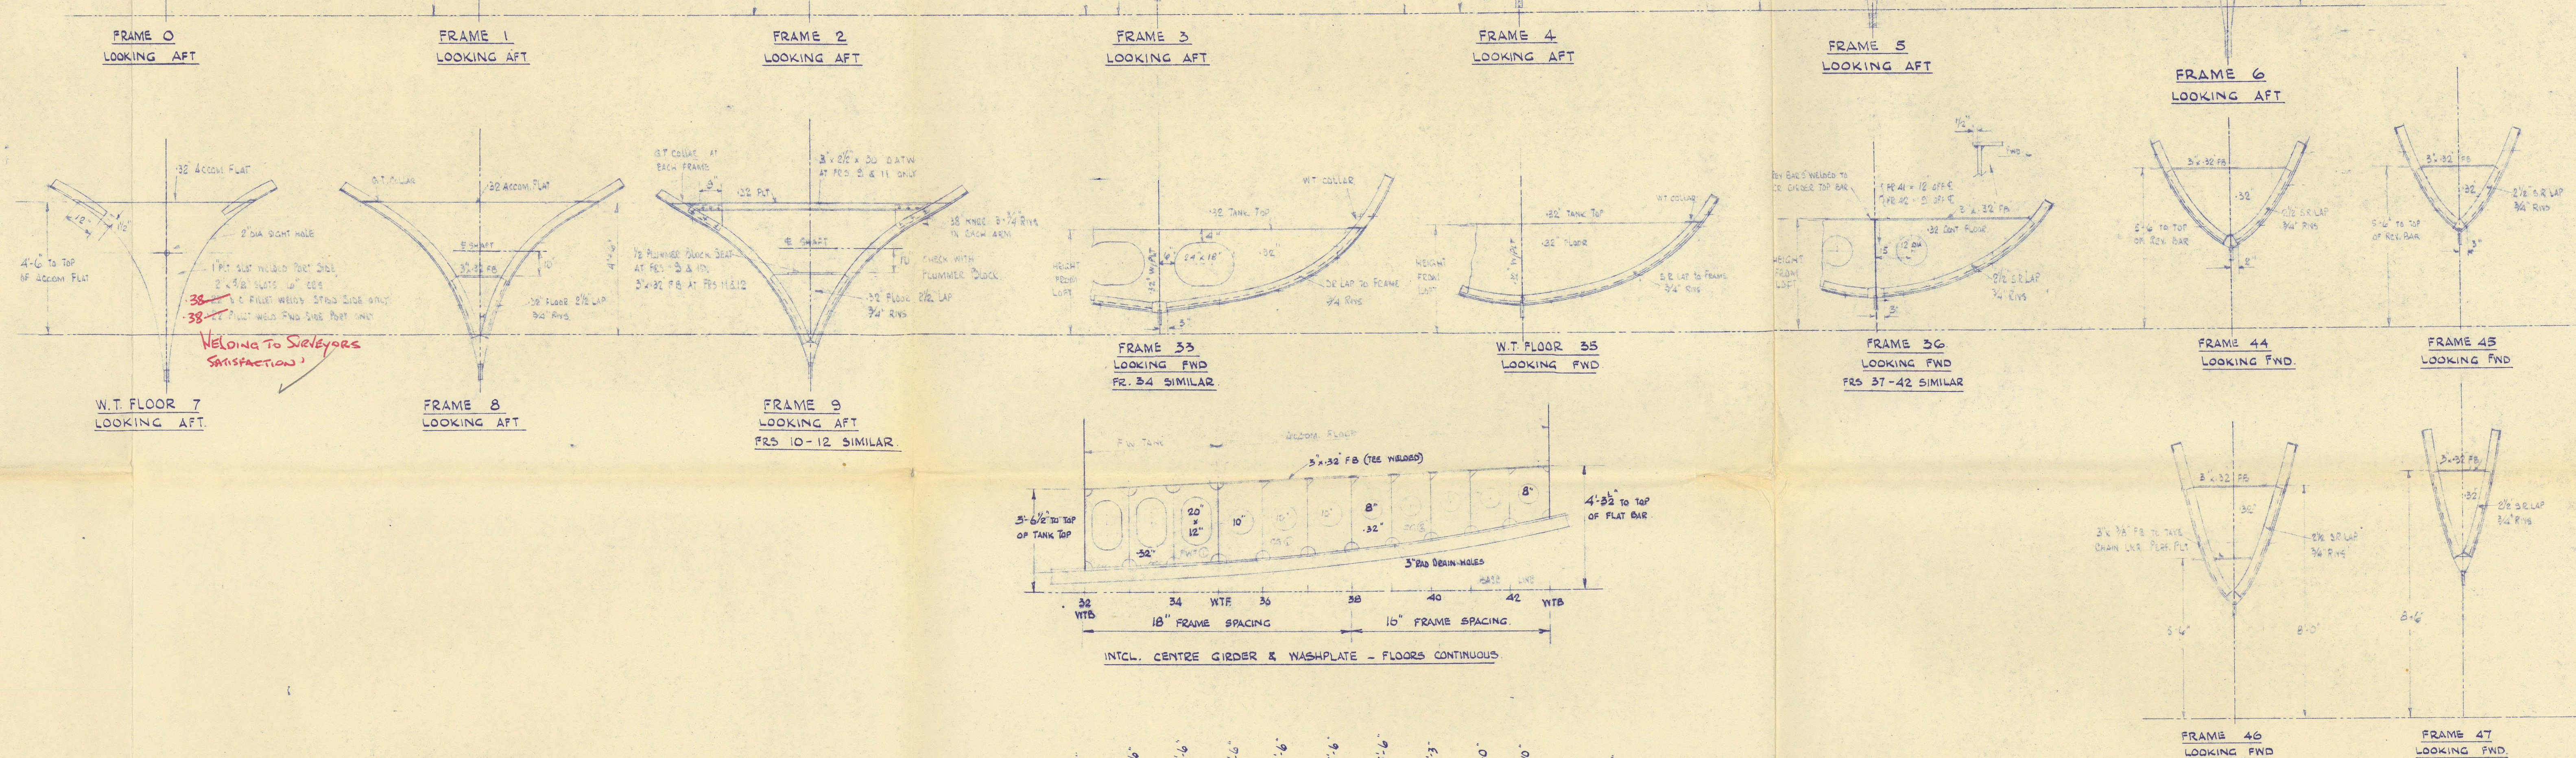


See Bc

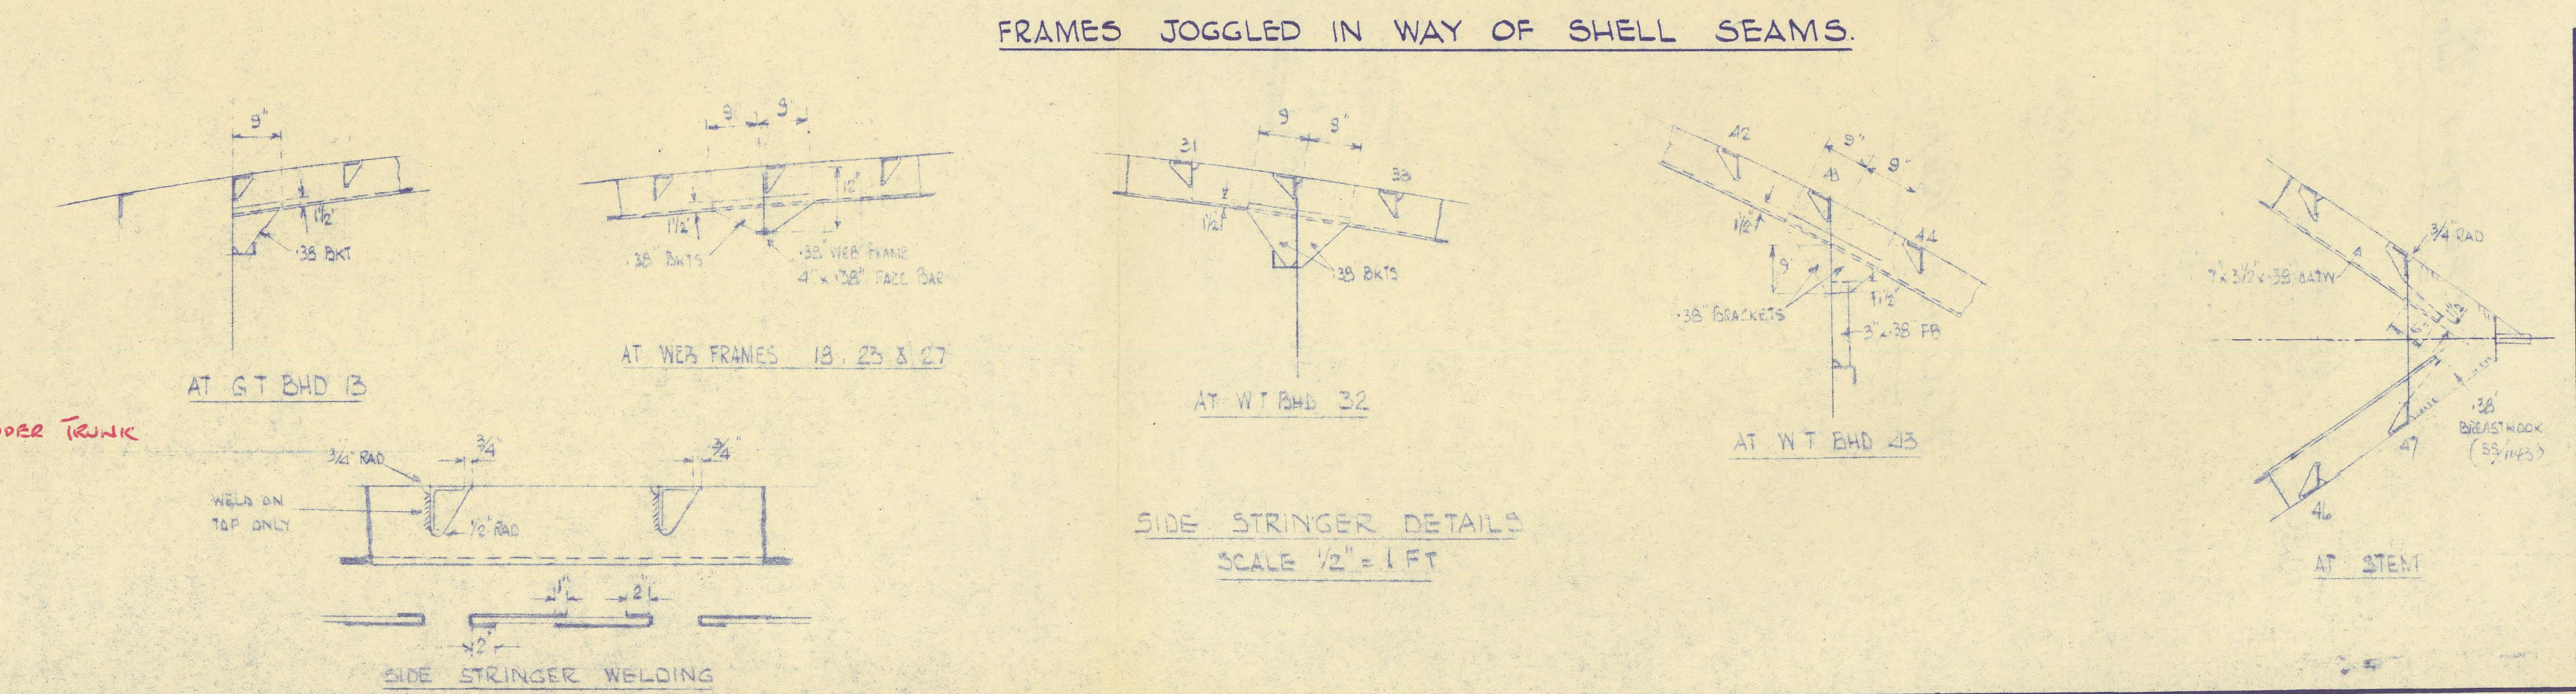

SECTIONS				
REVERSE BARS				
1	15'-4"	3" x 32'	PLAT.	20' 1-2
1	15'-0"	"	"	3-5
1	12'-0"	"	"	8-12
1	10'-7"	"	"	36
1	18'-7"	"	"	37-38
1	14'-0"	"	"	39-40
1	10'-6"	"	"	41-42
1	10'-8"	"	"	44-47
CR GIBBER TOP BAR				
1	11'-3"	3" x 32'	"	C.G.
SIDE STRINGER				
4	17'-0"	7 x 3/4" x 38"	O.A.	55/1
3	15'-0"	"	"	= 2

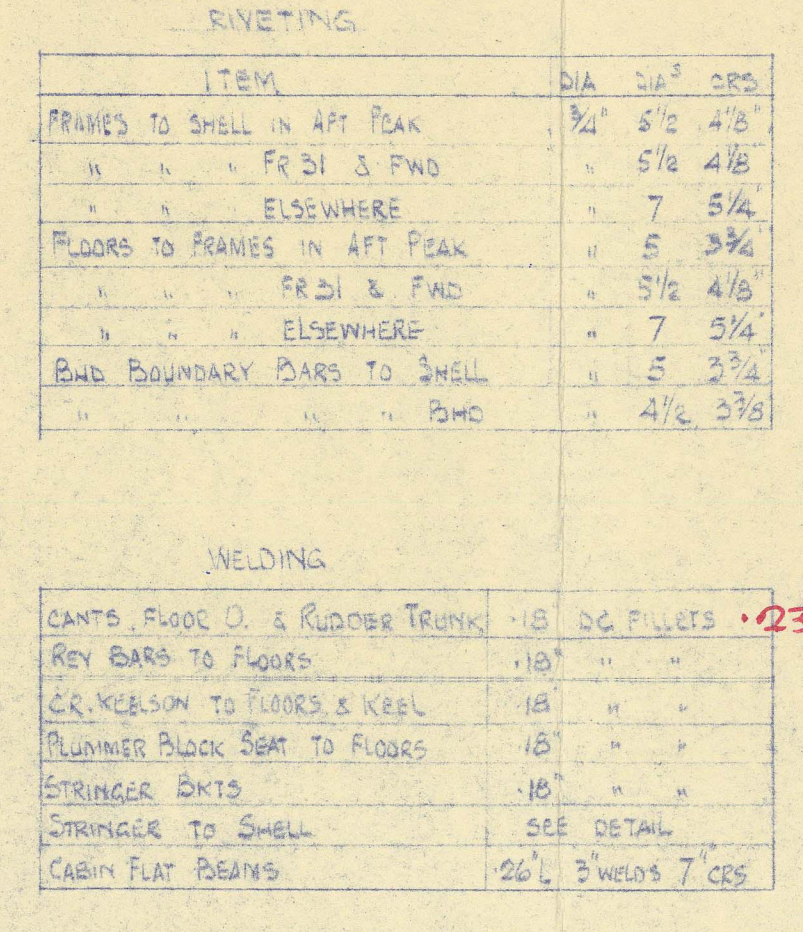

<div>REVISIONS.</div> <div> <div>No.</div> <div>DATE</div> <div>PARTICULARS</div> </div>			<div>DRAWN BY</div> <div>B.K.B.</div>	<div>RICHARD DUNSTON LTD.</div> <div>SHIPBUILDERS,</div> <div>THORNE, YORKSHIRE.</div>
			<div>DATE</div> <div>22-8-63</div>	
			<div>TRACED BY</div> <div></div>	
			<div>DATE</div> <div></div>	
			<div>CHECKED BY</div> <div></div>	
			<div>DATE</div> <div></div>	
<div> <div>This Drawing and the Information it contains are the Property of RICHARD DUNSTON LTD.</div> <div>It is not to be Traced, Copied or Published without their Written Consent, nor is the Information thereon to be misused in any way.</div> </div>				
<div>YARD No.</div> <div>T 1143</div>			<div>DRG. No.</div> <div>7048/9</div>	
<div>TITLE :-</div> <div>FRAMING</div>				
<div>SCALE :-</div> <div> <div>3/8"</div> <div>TO ONE FOOT.</div> </div>				

"FRISTON DOWN."


Richard Dunston Ltd.

Yard No. 11143.


FRAMING PLAN.

HUL. F.E. REPT. No. 70160.

RECORDS DEPT.
LONDON.

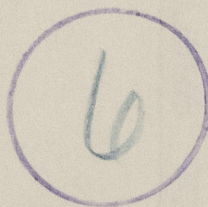

Deviations from approved plan marked
or ringed blue on white, yellow on blue.
Approved by local Surveyor or by

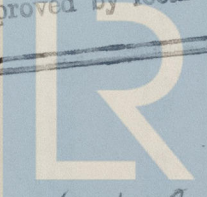

© 2021

Lloyd's Register
Foundation

012108-012112-0166