


SEP 1963

AREA OF RUDDER	- 26.95 sq ft
A x D	26.95 x 17.5 = 47.2
SPEED OF VESSEL	10 KNOTS
DIA ^m OF RUDDER HEAD	- 46" BRIGHT STEEL
" " MAINPIECE	- 54" " "
DIA ^m OF WROUGHT IRON CHAINS	- 1 1/2"
" " RODS	- 3/4"

CASTINGS AND/OR FORGINGS TO BE OF WELDABLE QUALITY CONTAINING NOT LESS THAN 23% CARBON

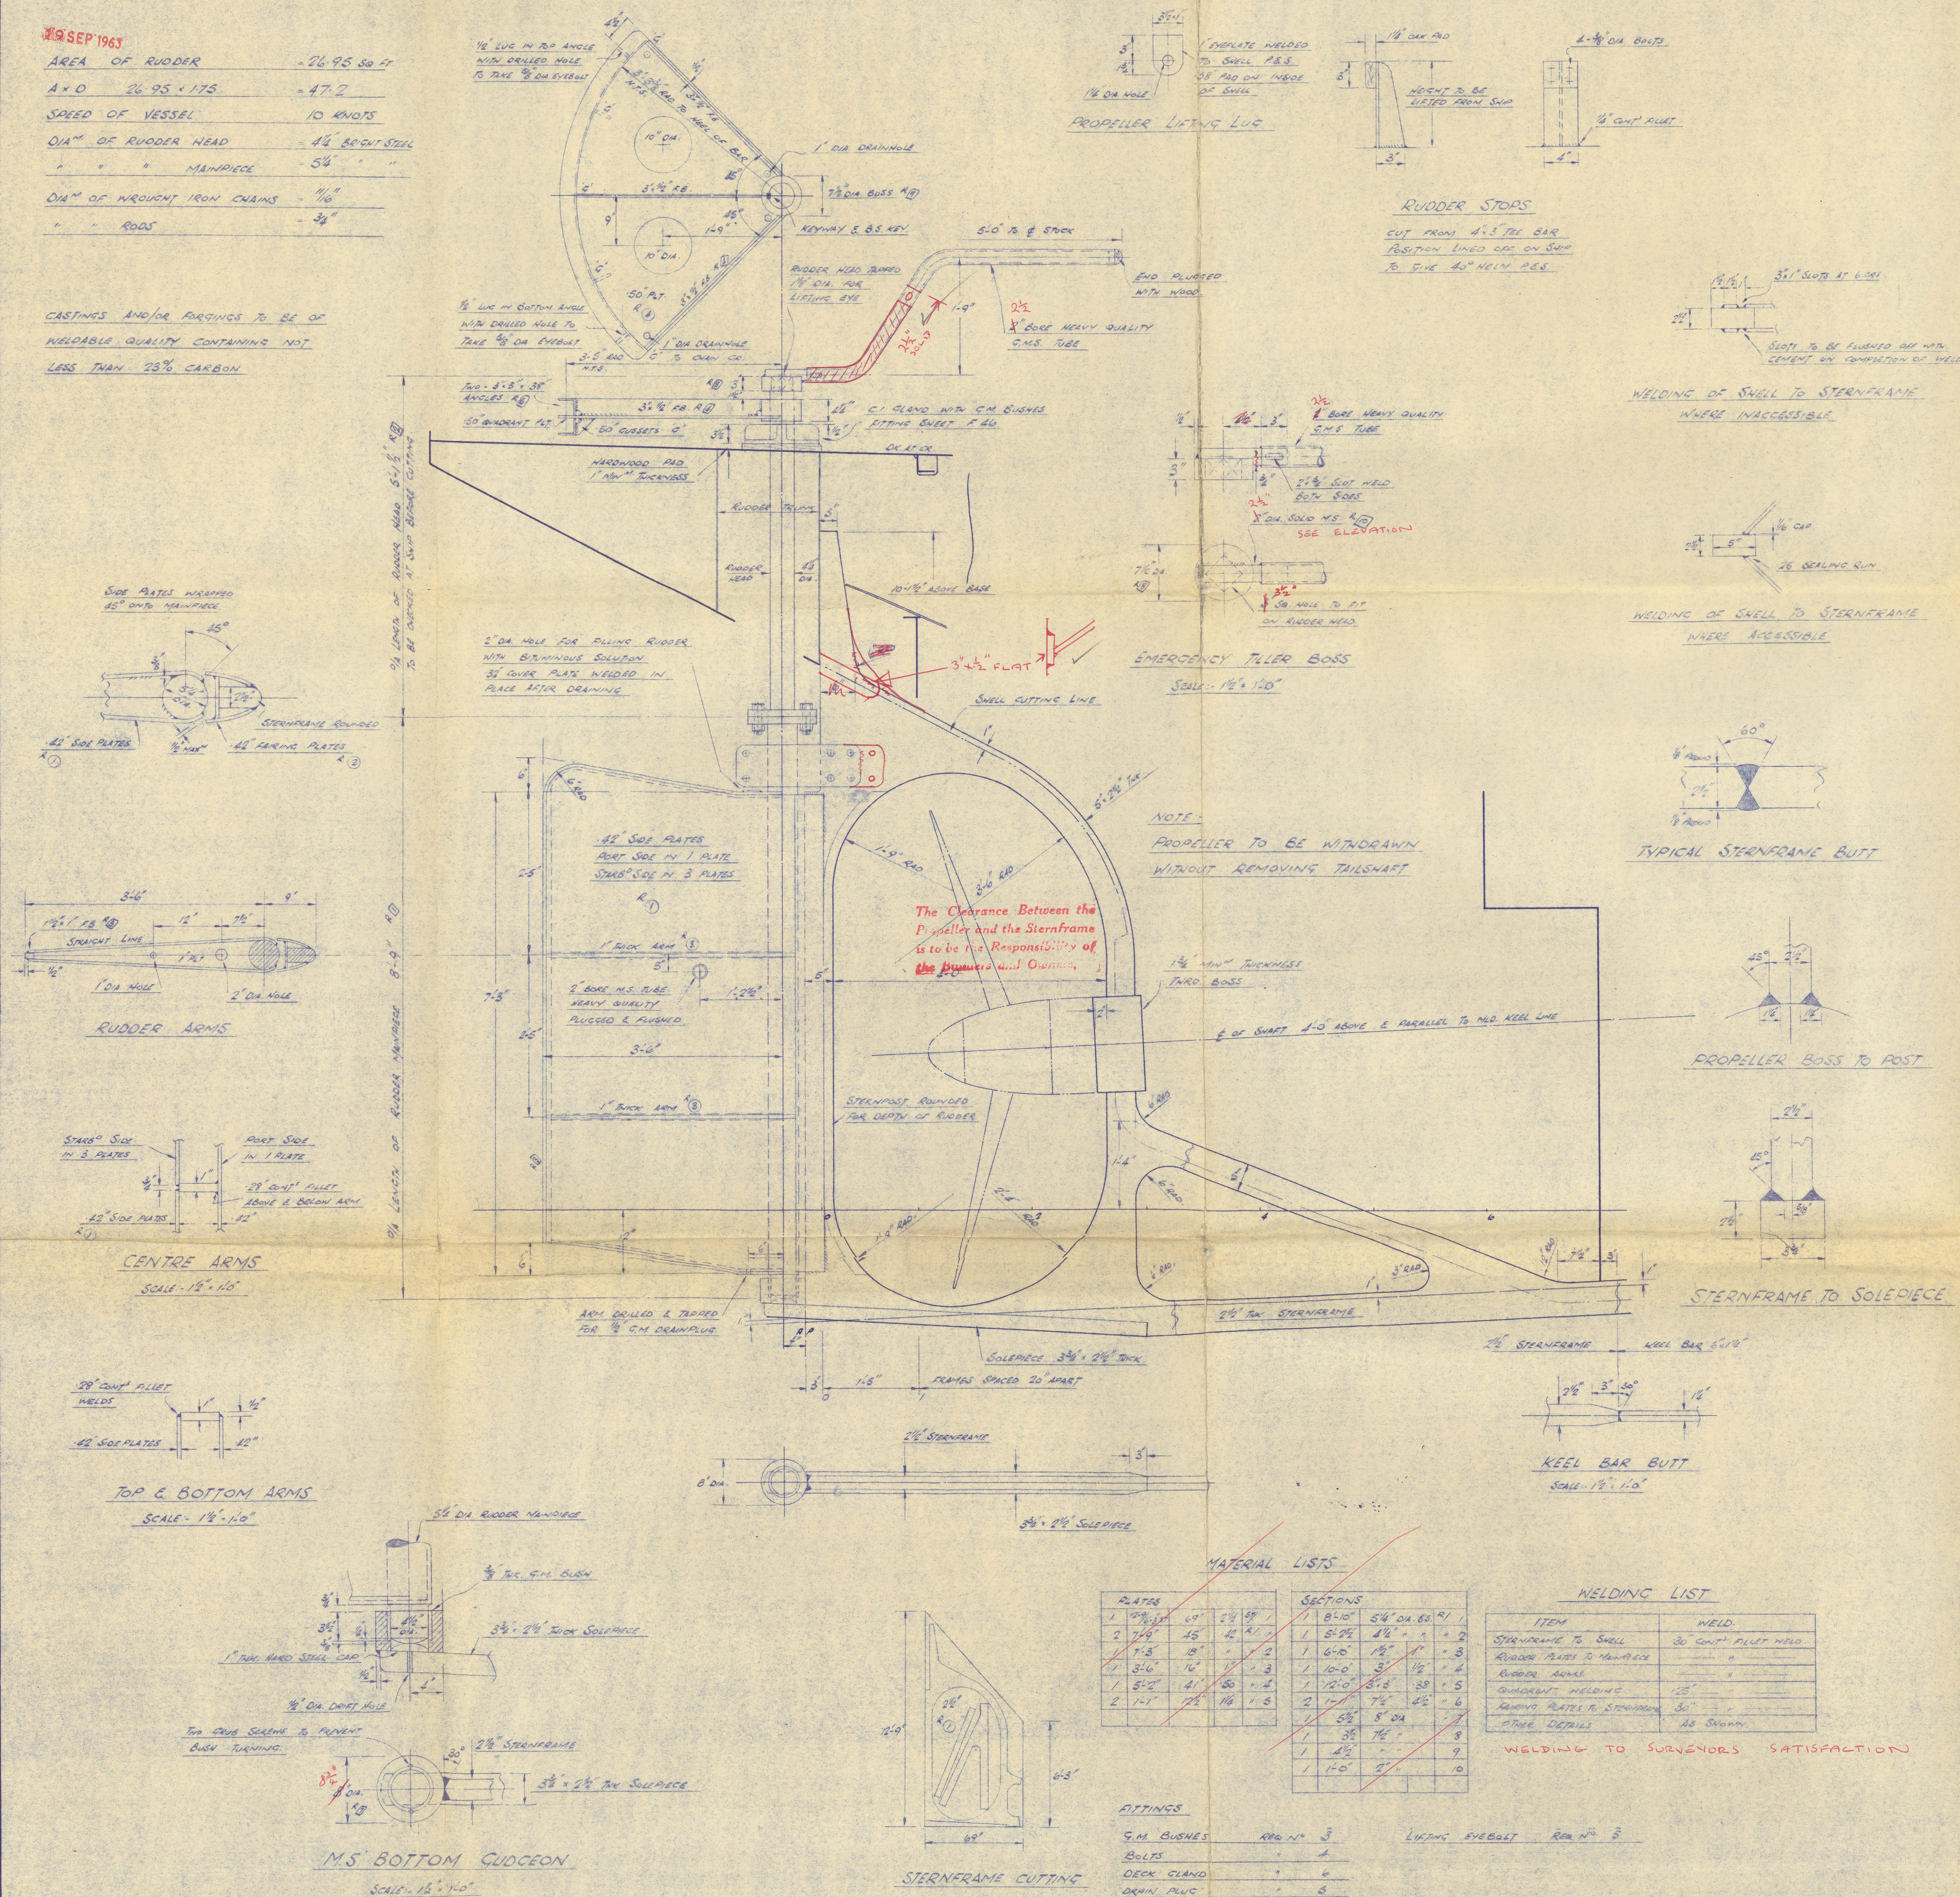

MATERIAL LIST

PLATES	SECTIONS
1 1/2" x 18" x 1/2"	1 8" x 18" x 1/2"
2 1/2" x 18" x 1/2"	1 6" x 18" x 1/2"
1 1/2" x 18" x 1/2"	1 6" x 18" x 1/2"
1 1/2" x 18" x 1/2"	1 6" x 18" x 1/2"
WELDING LIST

ITEM	WELD
STERNFRAME TO SHELL	30 CHIN PILE WELD
RUDDER PLATES TO MAINPIECE	"
RUDDER ARMS	"
QUADRANT WELDING	1/2"
RUDDER PLATES TO STERNFRAME	30"
OTHER DETAILS	AS SHOWN

WELDING TO SURVEYORS SATISFACTION

FITTINGS

S.M. BUSHES	REQ. NO. 3
BOLTS	" 4
DECK GLAND	" 6
DRUM PLUG	" 5
EMERGENCY TILLER	" 6

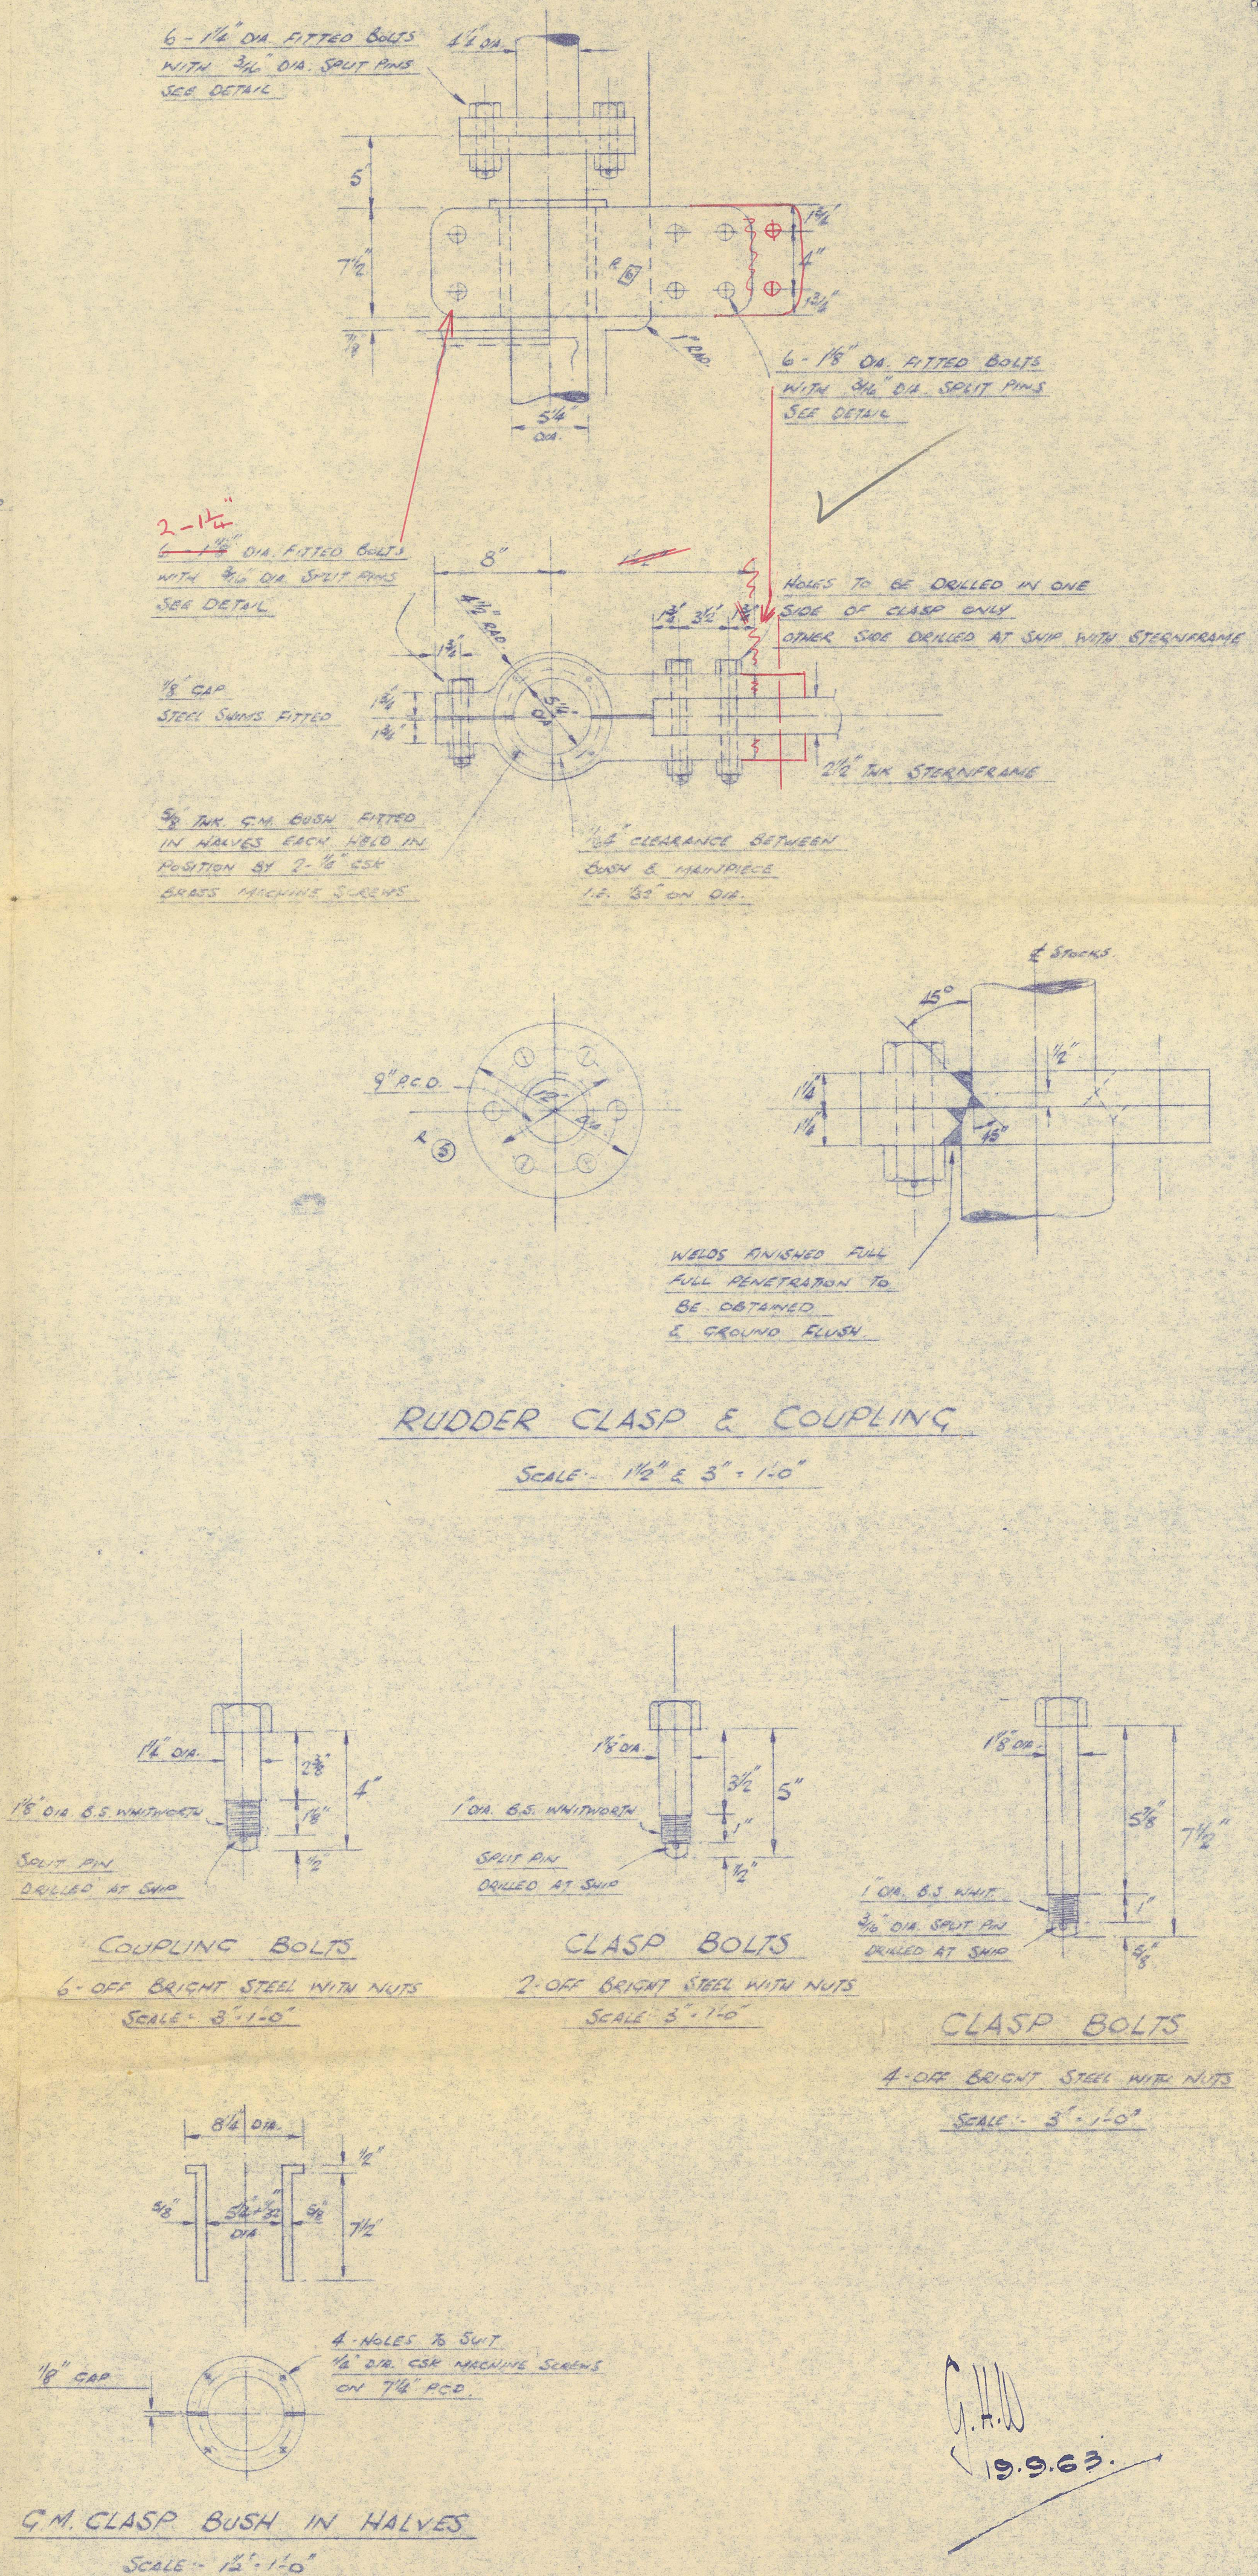

REVISIONS		DATE	BY
No.	DATE	PARTICULARS	
<p>DRAWN BY G.L.O. DATE 3.9.63</p> <p>TRACED BY DATE</p> <p>CHECKED BY DATE</p>			
<p>YARD No. T.1143 DRG. No. 7048/16</p> <p>TITLE: RUDDER & STERNFRAME</p> <p>SCALE: 1" TO ONE FOOT.</p>			

RICHARD DUNSTON LTD.
SHIPBUILDERS,
THORNE, YORKSHIRE.

This Drawing and the Information it contains are the Property of RICHARD DUNSTON LTD. It is not to be Traced, Copied or Published without their Written Consent, nor is the Information thereon to be misused in any way.

012108-012112-01212021

"FRISTON DOWN" ★

R. DUNSTON LTD.

SHIP No. T. 1143...

Rudder - Sternframe

HULL. F.R. REPT. NO. 70160

RECORDS DEPT
LONDON.

7

Deviations from approved plan marked
or ringed blue on white, yellow on blue.
Approved by local Surveyor or by

Lloyd's Register
Foundation
012108-012112-0167