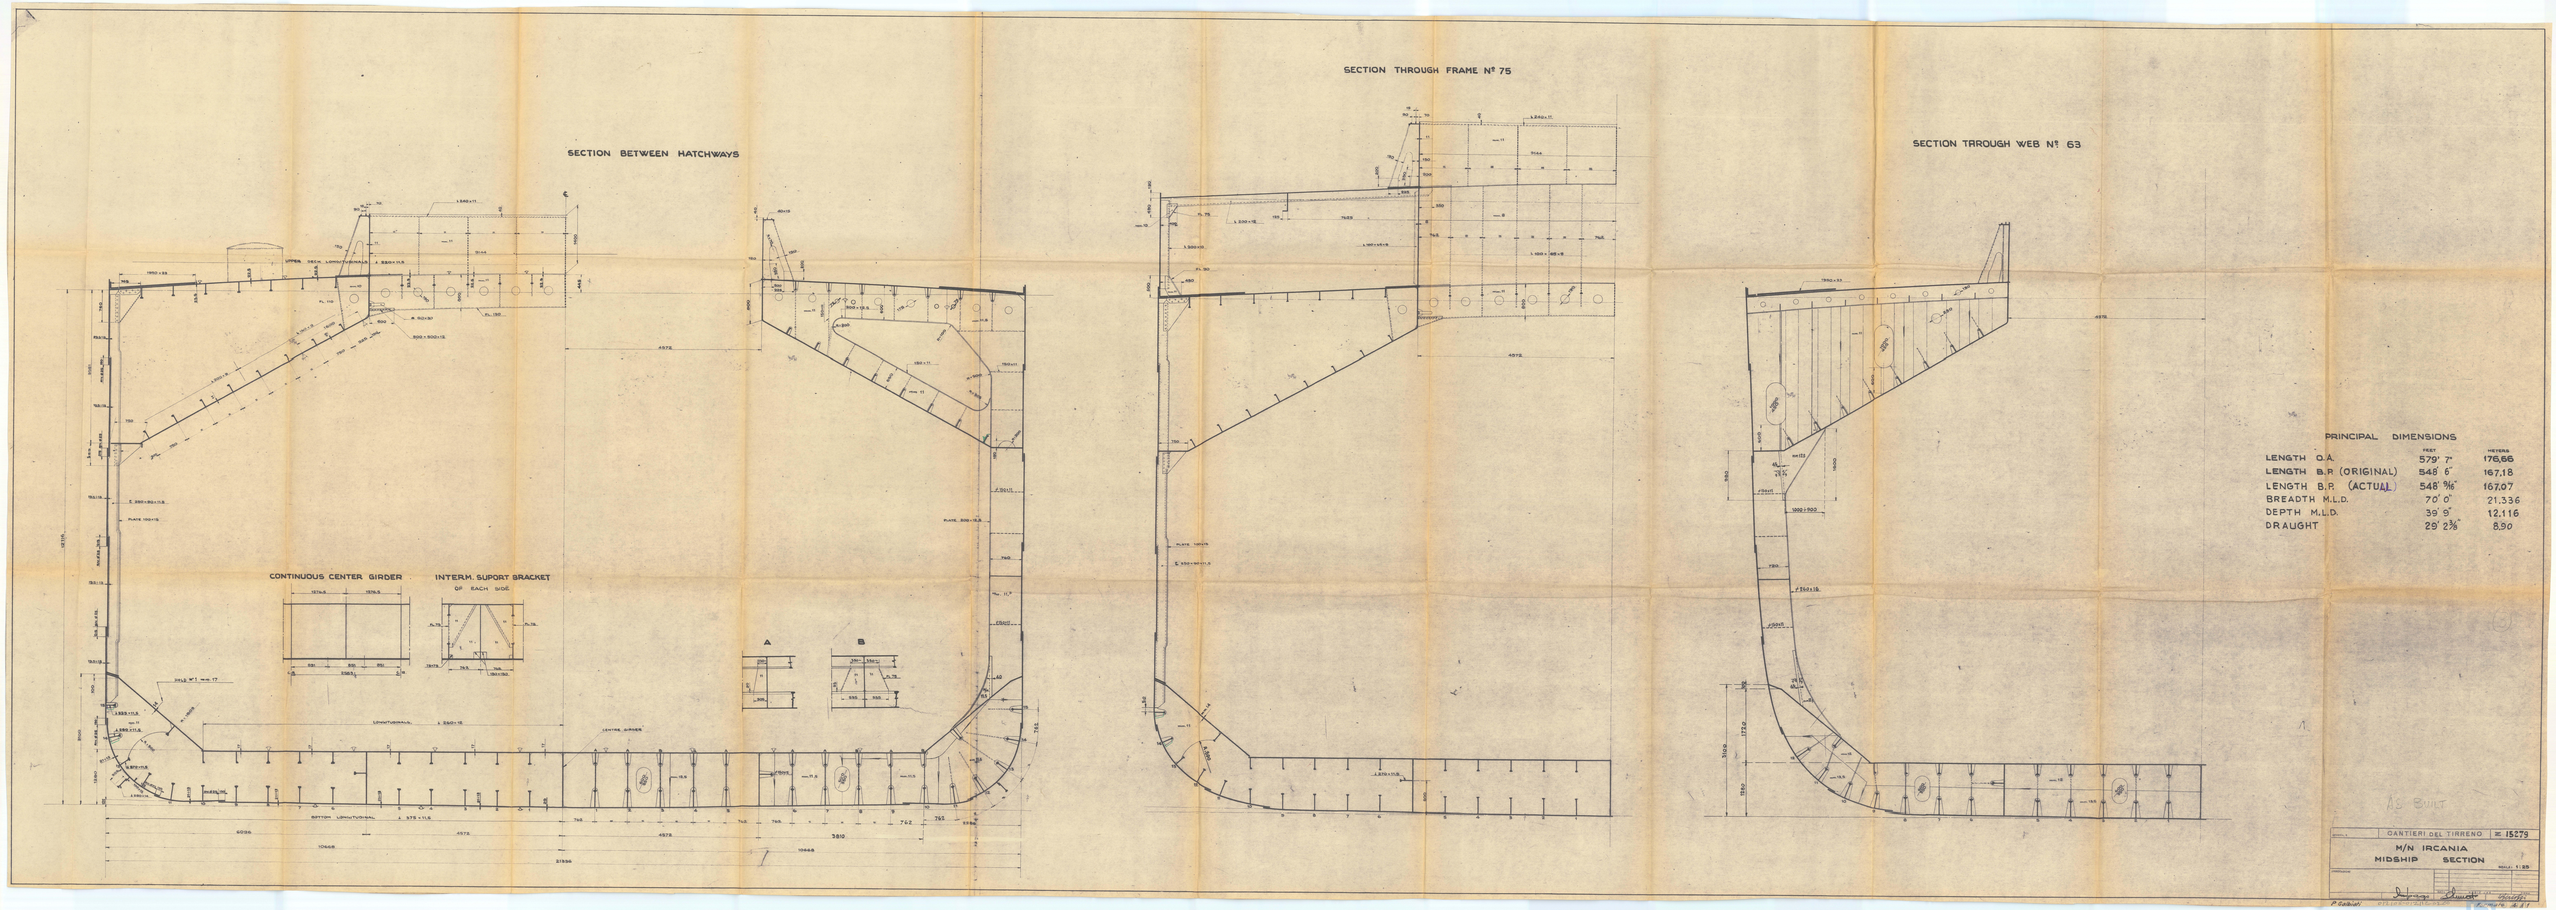
SECTION BETWEEN HATCHWAYS
SECTION THROUGH FRAME Nº 75
SECTION THROUGH WEB Nº 63
CONTINUOUS CENTER GIRDER
INTERM. SUPORT BRACKET
OP. EACH SIDE
A
B
PRINCIPAL DIMENSIONS
FEET METERS
LENGTH O.A. 579' 7" 176,66
LENGTH B.P. (ORIGINAL) 548' 6" 167,18
LENGTH B.P. (ACTUAL) 548' 9 1/16" 167,07
BREADTH M.L.D. 70' 0" 21,336
DEPTH M.L.D. 39' 9" 12,116
DRAUGHT 29' 2 3/8" 8,90
AS BUILT
CANTIERI DEL TIRRENO
15279
M/N IRCANIA
MIDSHIP SECTION
SCALE 1:25
P. Gabrielli

M/S "IRCANIA"

CONVERSION TO BULK-CARRIER

PLAN No. 3

TRANSVERSE SECTIONS.

GENOA RPT. & No. 26239
12/6/61

RECORDS DEPT.
LONDON.

3

© 2021
Lloyd's Register
Foundation

012108-012112-9209