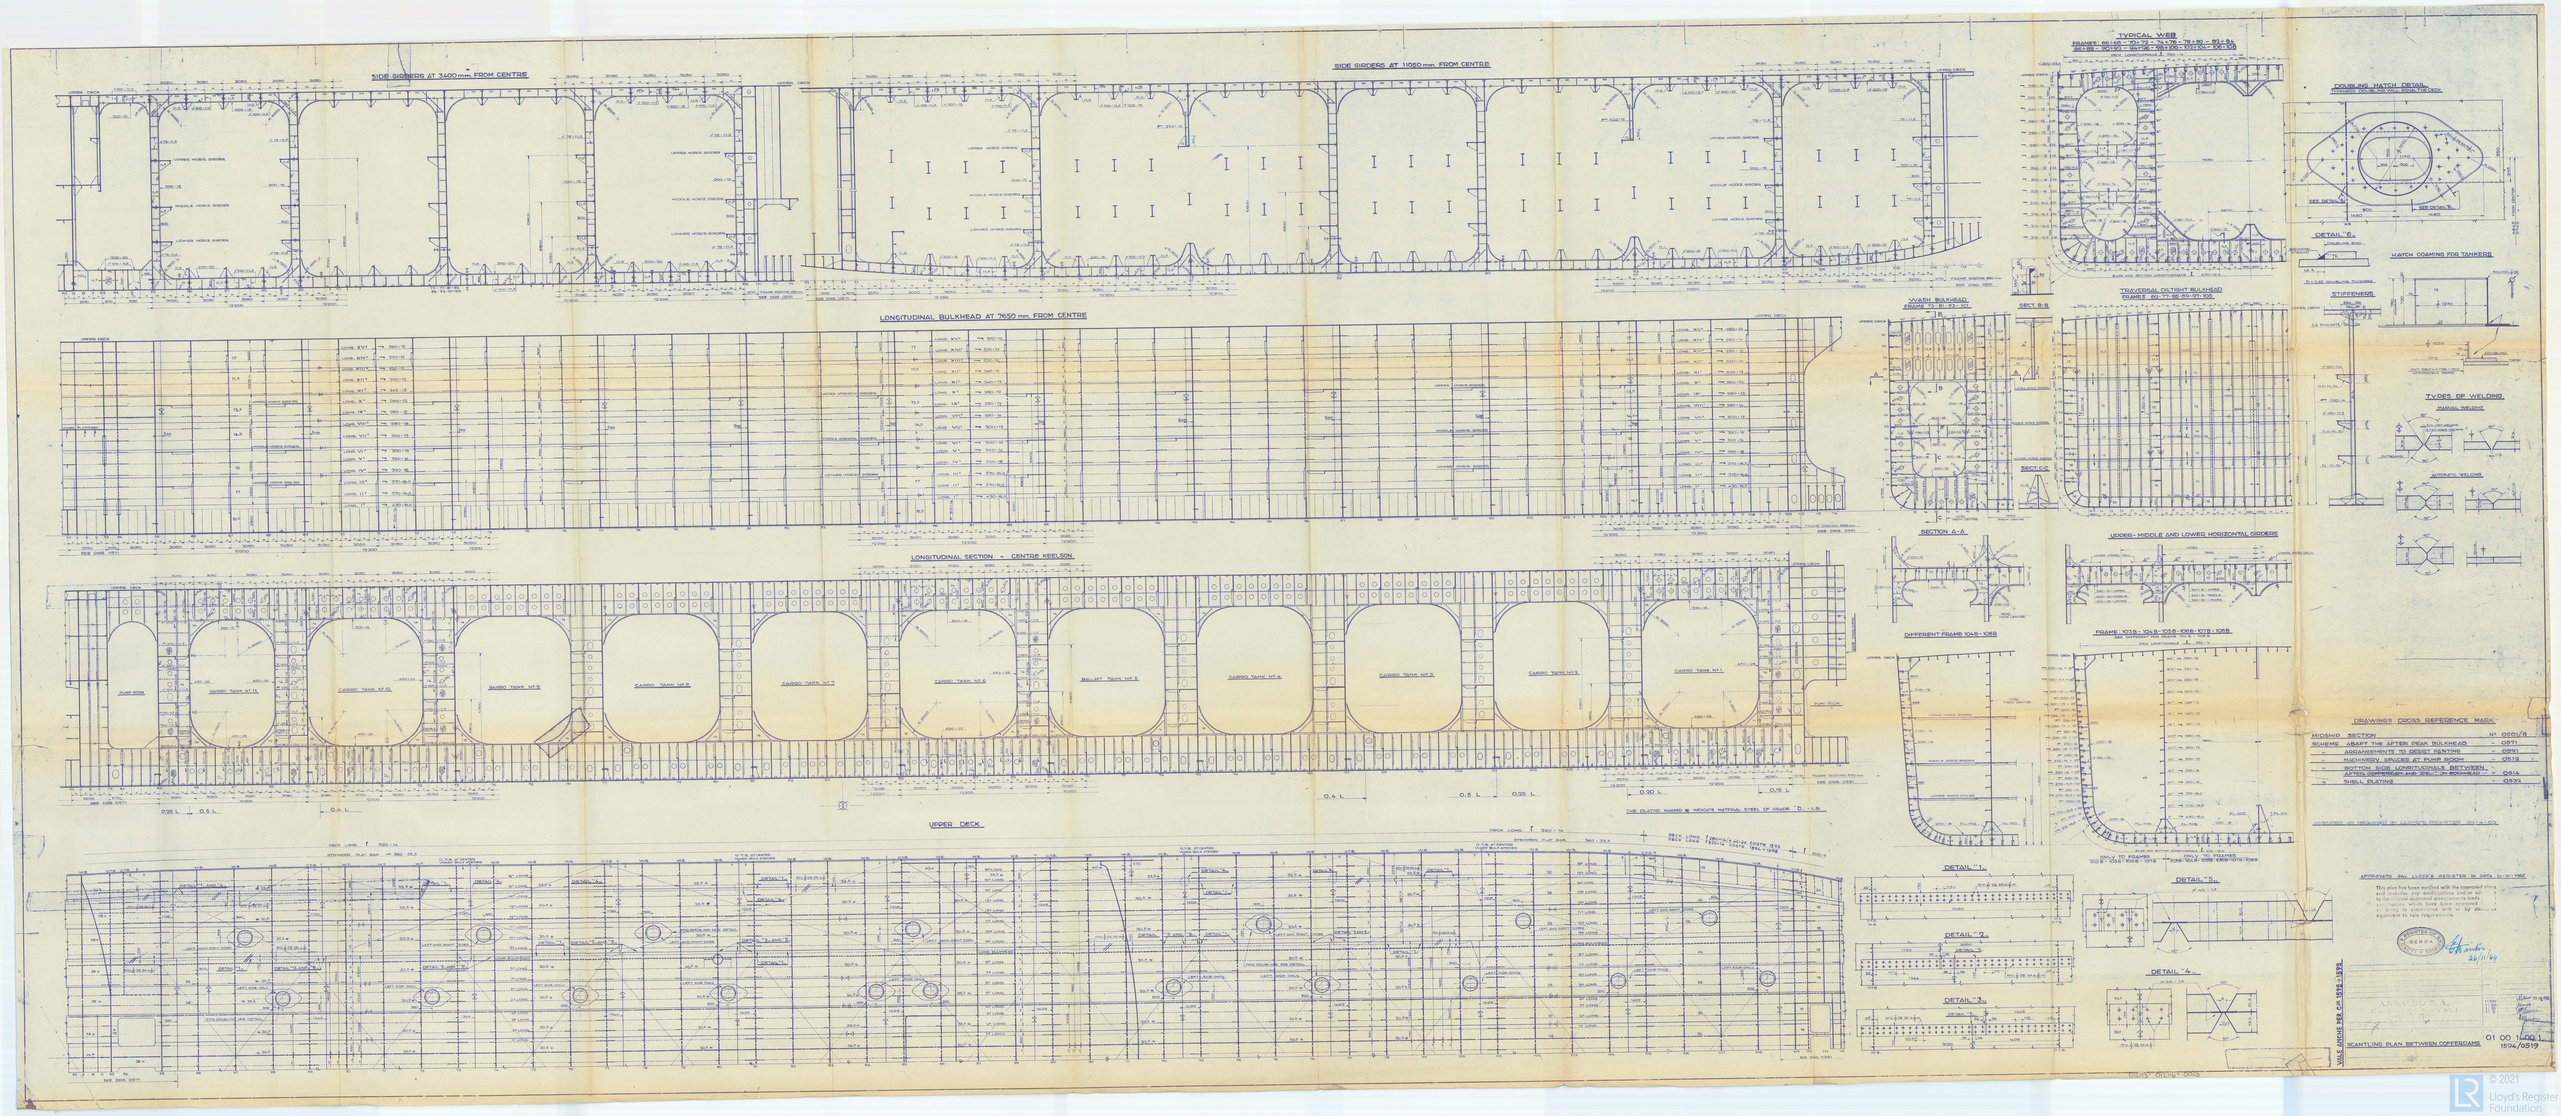

© 2021 Lloyd's Register Foundation

GENOA. F.E. Rpt No 29569

ANSALDO S.p.A. GENOA-SESTRI.

YARD No 1597.

"GIUSEPPE VERDI."

SCANTLING PLAN BETWEEN COFFERDAMS.

RECORDS DEPT.
LONDON.

© 2021
Lloyd's Register
Foundation

012113-012116-0025