






LR

HITACHI S. & E. Co., LD.
INNOSHIMA.


RECORDS DEPT.,
LONDON.

NOS 3777 AND 3778.

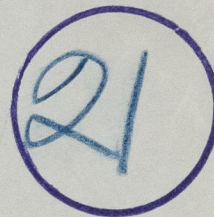

— STERNFRAME —

S.S. "NAESS VENTURER" (Nº 3777) ★

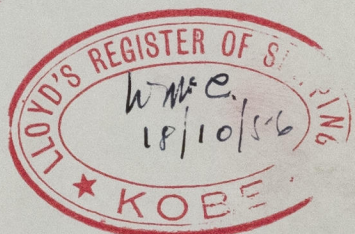

Rpt. F.E. 3494

3495
Kobe RPT. NO. ~~3495~~
DATED. _____



© 2020

Lloyd's Register
Foundation

012124-01212-0005

05/11/2005