

GENERAL ARRANGEMENT.

PROPOSED TOW BARGE


FOR

PRESCOTT - MONTREAL SERVICE.

SCALE $\frac{1}{8}$ " = 1 FOOT.

Tow Barge "Spedchief."

LENGTH OVERALL = 256'-0"
BREADTH MLD = 43'-6"
DEPTH " = 15'-0"

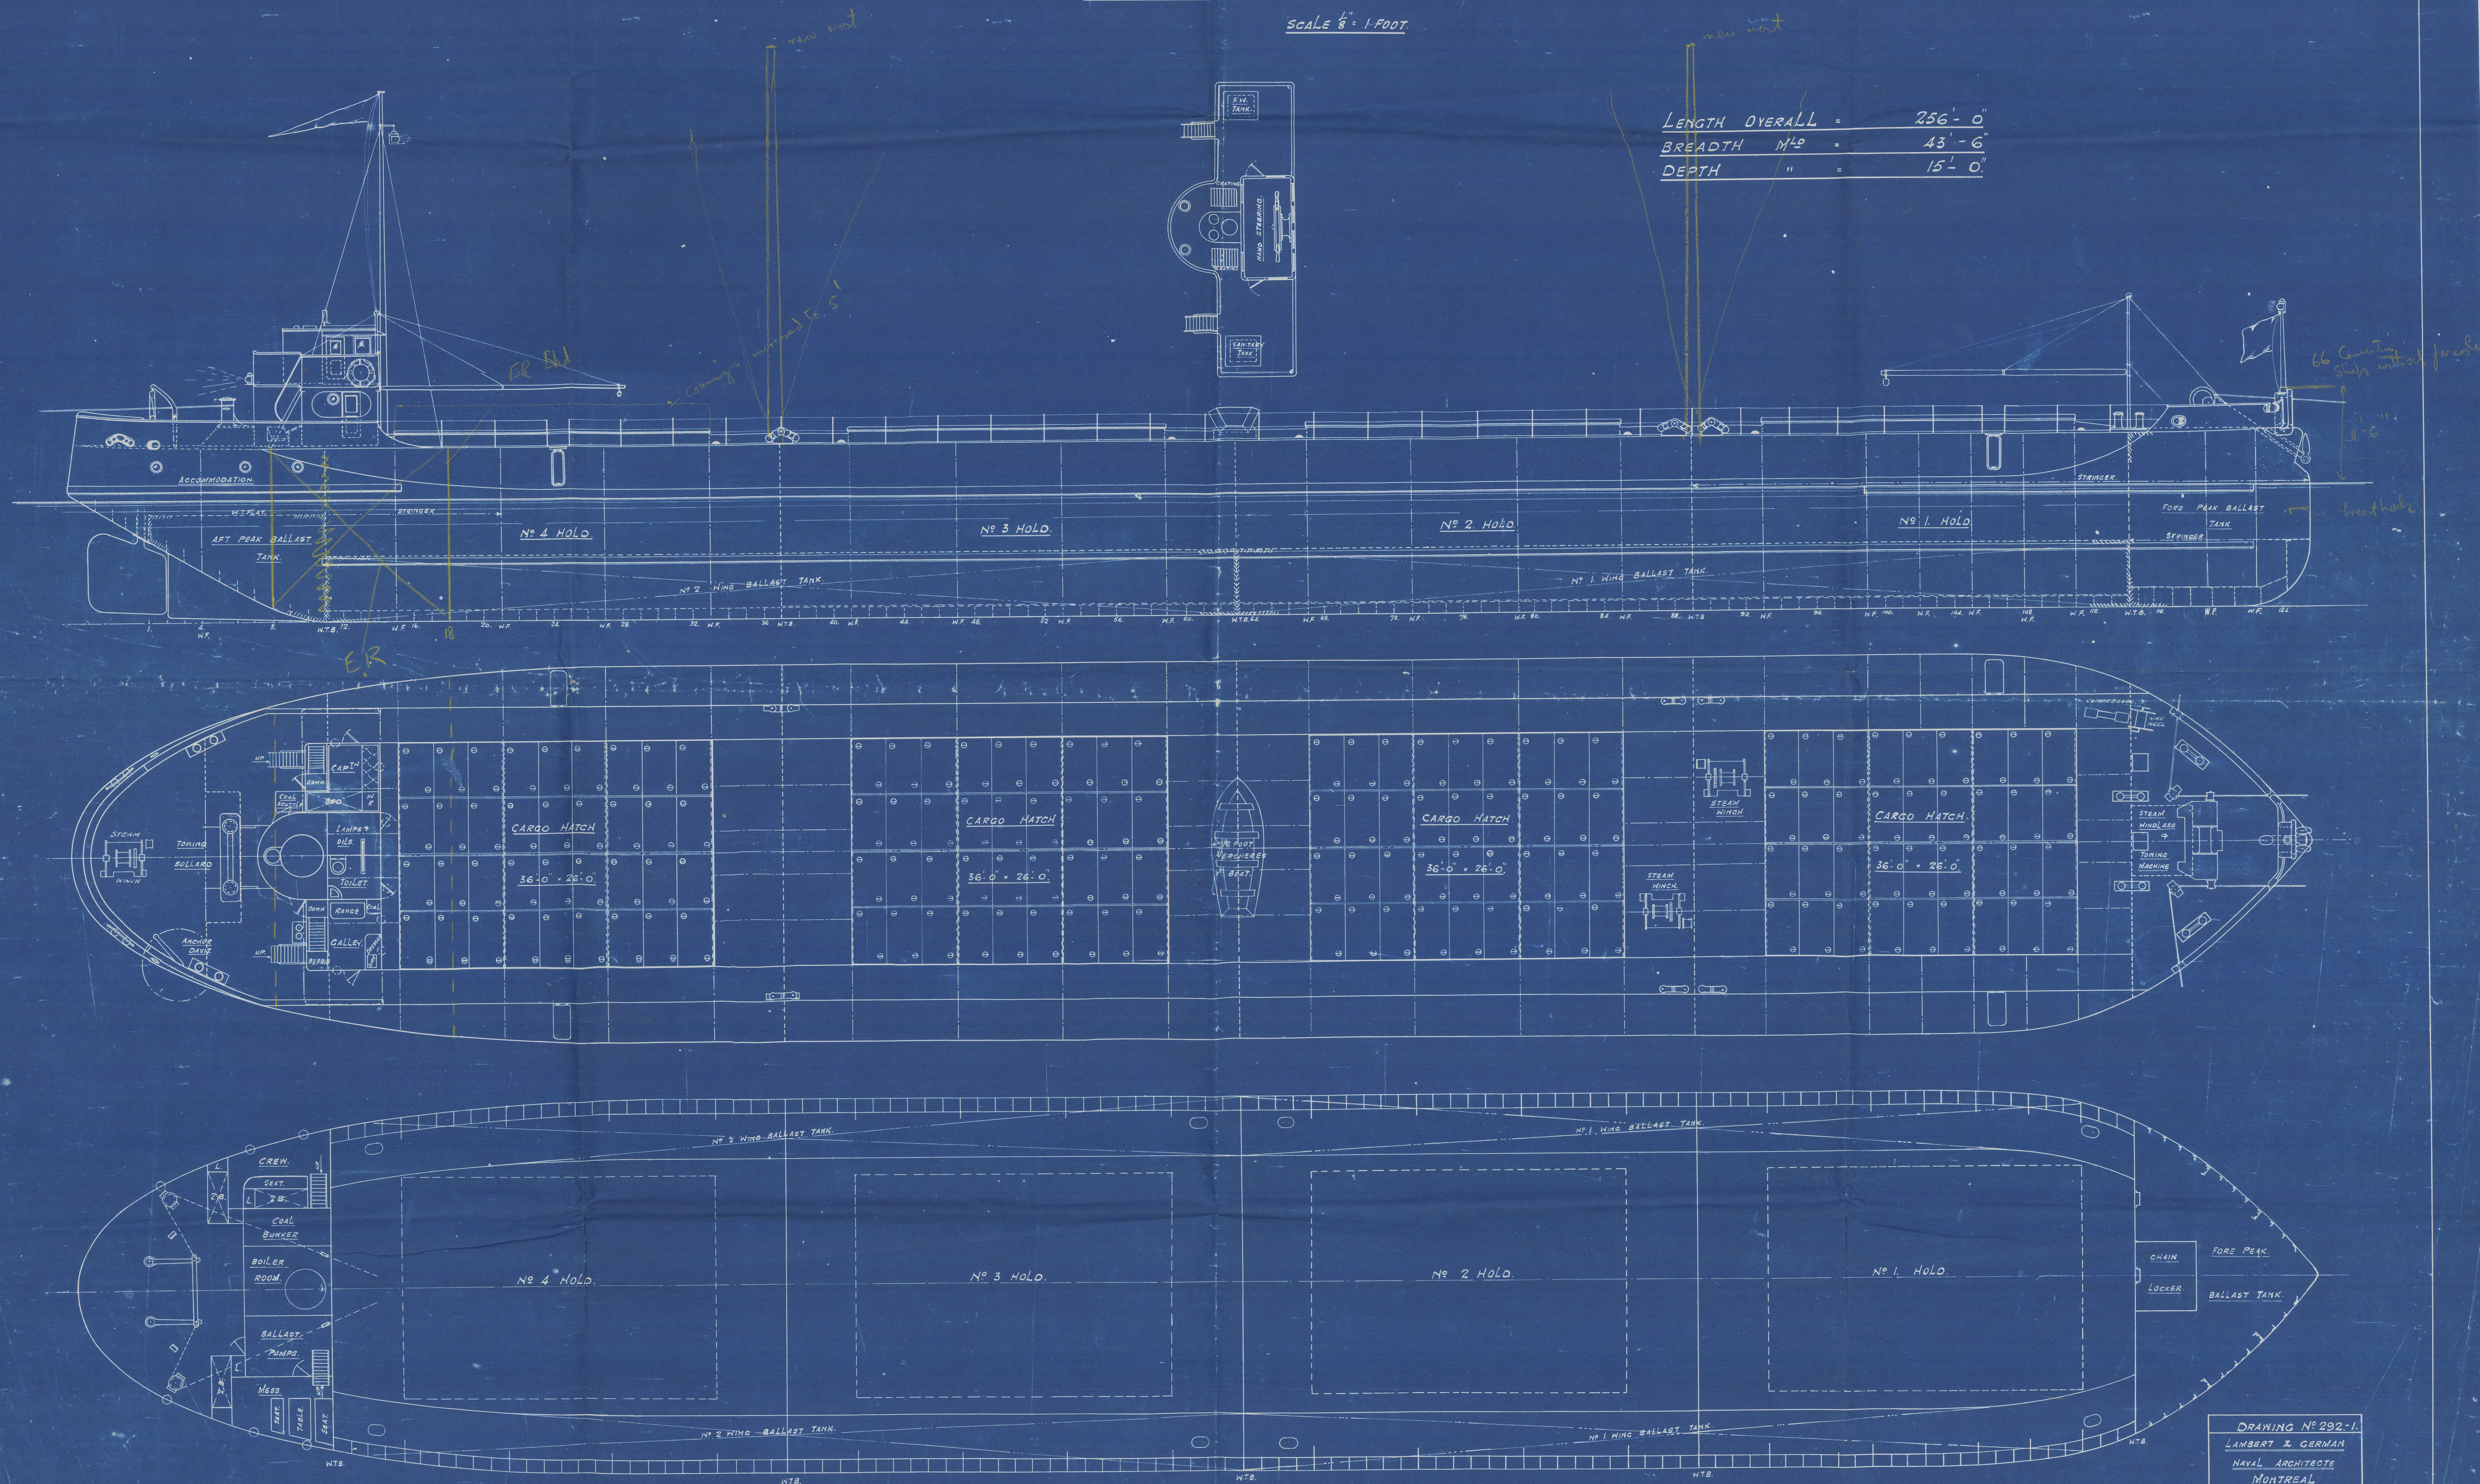


DRAWING NO 292-1.
LAMBERT & GERMAN
NAVAL ARCHITECTS
MONTREAL

Profile and
seats plan
Barges

BLUE RIVER
EX

"Redchief"

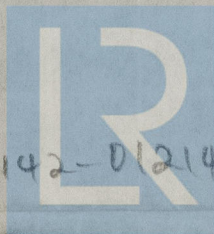

© 2021

012142-012147-014

Lloyd's Register
Foundation