

Rpt. C.11.

Lloyd's Register of Shipping.

SURVEYS FOR FREEBOARD.


(CONDITIONS OF ASSIGNMENT.)

Index No. _____
(For London Office only.)

S 200

Ship's Name "ORIENTAL GIANT" Port of Survey SASEBO, JAPAN
 Official Number 1453 Surveyor's Signature S. Noguchi
 Nationality and Port of Registry LIBERIA, MONROVIA Date of Survey WHILST BUILDING

Disposition and dimensions of superstructures, trunks, deckhouses and machinery casings to be inserted in the diagrams and tabular statement:—

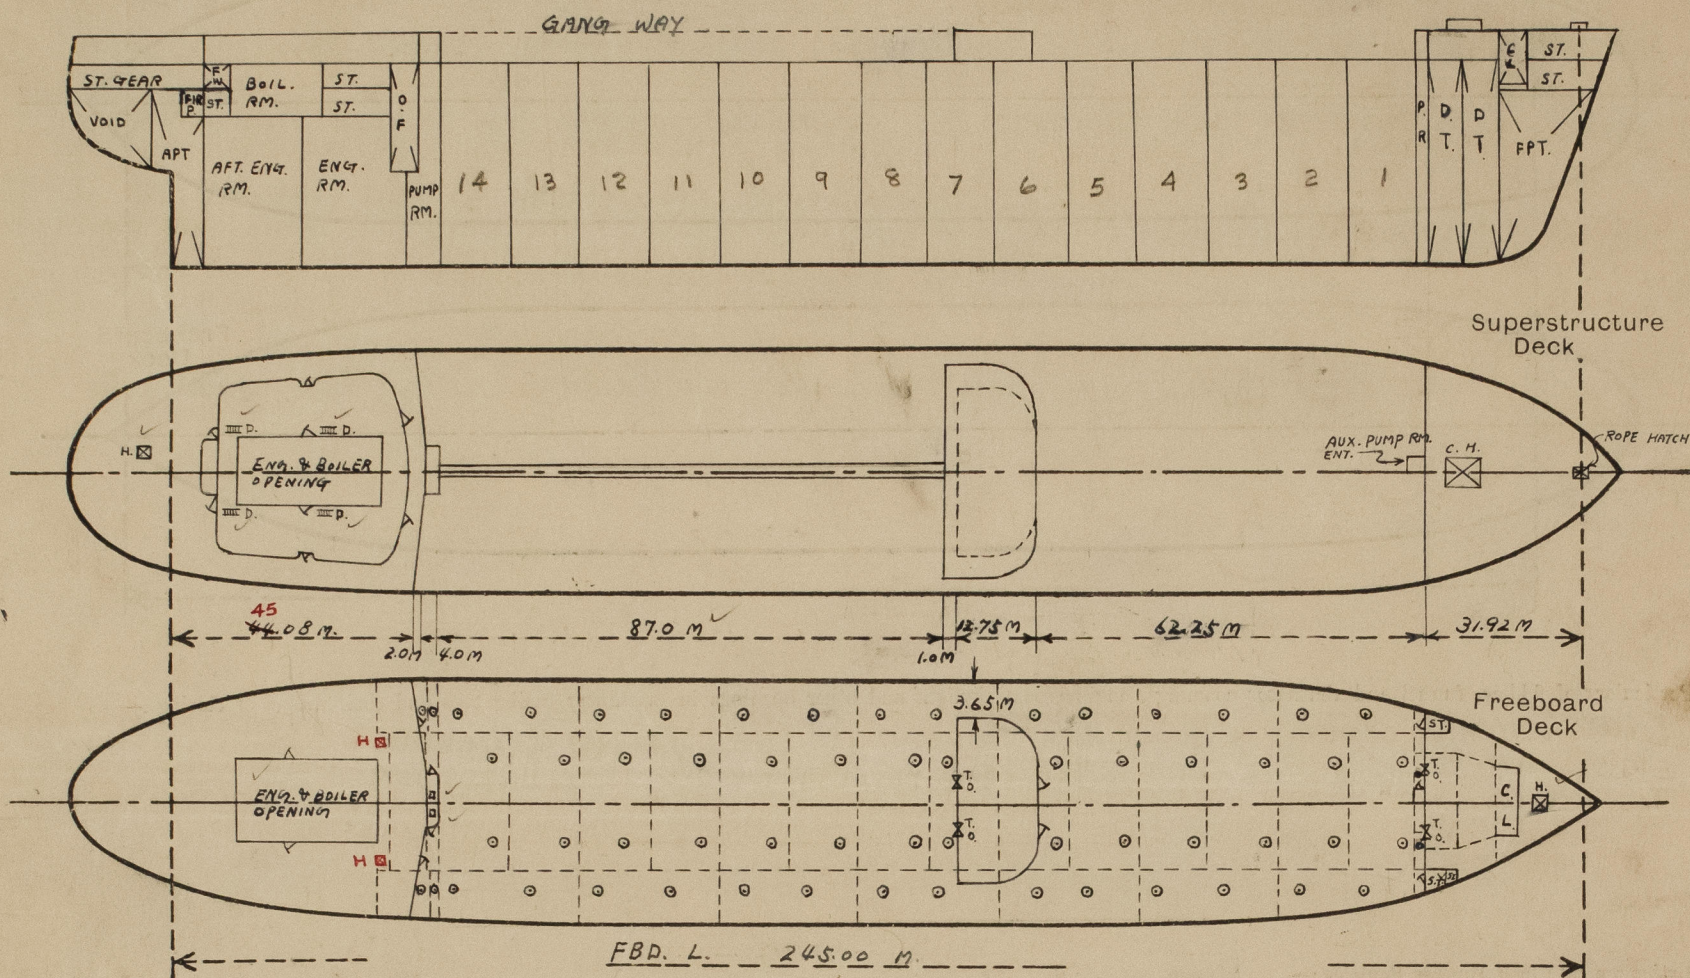



Particulars of Superstructures, Trunks, Casings, Deckhouses.

	Coaming	Plating	Stiffeners	Spacing	End Attachments of Stiffeners	Size of Openings	Height of Sills	Height of Casings
Poop Bulkhead ...	12.5 ✓	12.5 ✓	150x90x9 I	800 ✓	WELDED ✓	700x1200 ✓	460 ✓	2650 ✓
Raised Quarter Deck Bulkhead ...								
Bridge, After Bulkhead ...	9 ✓	9 ✓	125x75x10 I	800 ✓	FREE ✓	1200x1600 ✓	380 ✓	2650 ✓
Bridge, Forward Bulkhead ...	12 ✓	12 ✓	400x100x13/8 I	800 ✓	WELDED ✓	900x1700 ✓	460 ✓	2650 ✓
Forecastle Bulkhead ...	9 ✓	9 ✓	125x75x10 I	800 ✓	FREE ✓	700x1600 920x 420x1600 1220 ✓	380 ✓	3500 ✓
PUMP ROOM ENTRANCE AFT.								
Trunk, Aft ...	12.5 ✓	12.5 ✓	150x90x9 I	800 ✓	WELDED ✓	600x1300 ✓	610 ✓	2650 ✓
Trunk, Forward ...	9 ✓	9 ✓	125x75x10 I	800 ✓	FREE ✓	600x1300 ✓	610 ✓	3500 ✓
Exposed Machinery Casings on Freeboard or Raised Quarter Decks ...								
Exposed Machinery Casings on Superstructure Decks ...								
Machinery Casings within Superstructures not fitted with Class I Closing Appliances ...								
Deckhouses on Flush Deck Ships ...								

Nagasaki C.I. (contd) 5/67

Particulars of Closing Appliances (state if capable of being manipulated from both sides).

Poop Bulkhead ...	HINGED STEEL W.T. DOORS CAPABLE OF BEING OPERATED FROM BOTH SIDES ✓
Raised Quarter Deck Bulkhead ...	—
Bridge, After Bulkhead ...	SLIDING STEEL PLATE COVERS SECURED BY HOOK BOLTS ✓
Bridge, Forward Bulkhead ...	HINGED STEEL W.T. DOORS CAPABLE OF BEING OPERATED FROM BOTH SIDES ✓
Forecastle Bulkhead ...	SLIDING STEEL PLATE COVERS SECURED BY HOOK BOLTS ✓
Exposed Machinery Casings on Freeboard or Raised Quarter Decks ...	—
Exposed Machinery Casings on Superstructure Decks ...	—
Machinery Casings within Superstructures not fitted with Class I Closing Appliances ...	—
PUMP ROOM ENTRANCE FORD.	HINGED STEEL W.T. DOORS CAPABLE OF BEING OPERATED FROM BOTH SIDES ✓
Deckhouses on Flush Deck Ships AFT.	—
POOP DECK HOUSE	—

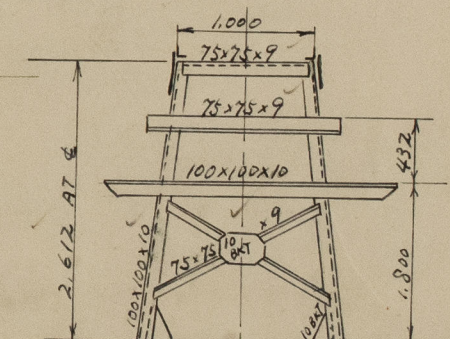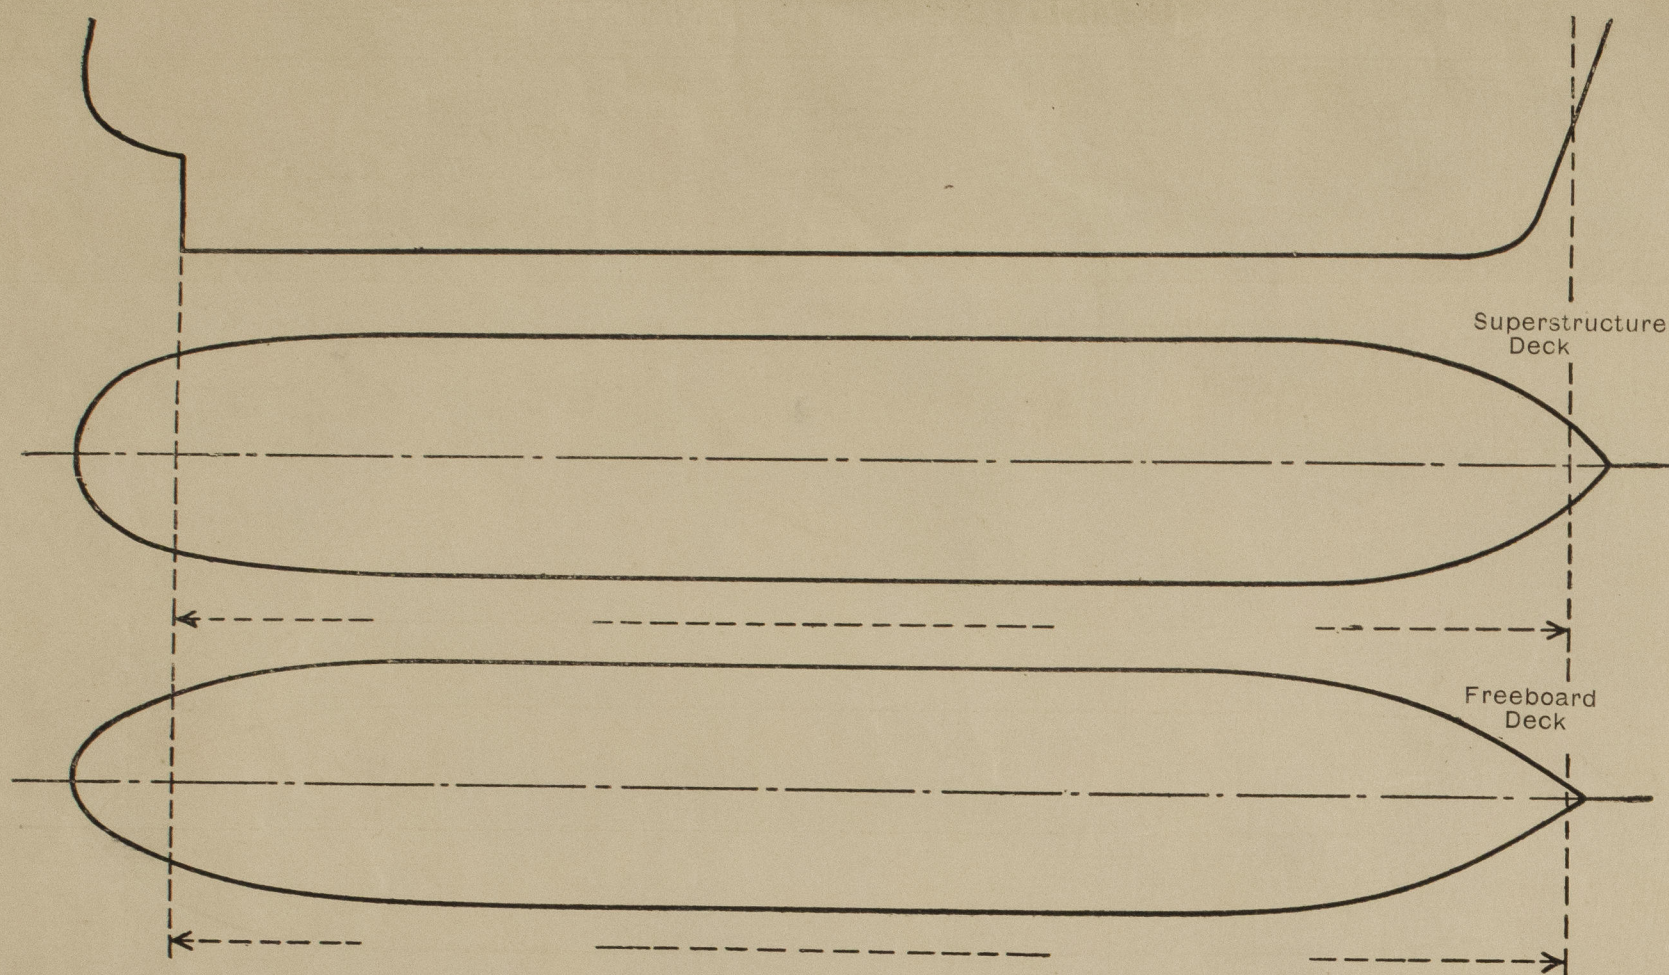

Particulars of Freeing Arrangements.						
	Length of Bulwark	Height of Bulwark	Size of Freeing Ports	Number each side	Area each side	Rule area each side
After Well						
		OPEN RAIL ✓				
Forward Well						
		OPEN RAIL ✓				
State position of each freeing port { After Well :— NONE ✓ (F. and A. position and height above deck edge) { Forward Well :— NONE ✓						
State whether the freeing ports are fitted with shutters, bars, or rails, and give particulars of such :—						
Additional area where sheer is less than standard.						

PARTICULARS OF PROTECTION TO OPENINGS, ETC.

HATCHWAYS ON FREEBOARD AND SUPERSTRUCTURE DECKS.									
		ON FREEBOARD DECK		ON FCL DECK		ON POOP DECK			
Description of Hatchway	...	CARGO OIL TANKS	COFF. AND O.F. TANK	CARGO SPACE	STORES	PROVISION STORE			
Dimensions of Hatchway	...	1000 DIA	600 DIA	4.795x8.000	1220x1220	1120x1120			
COAMINGS	Height above Deck	760 MIN.	760 MIN	760	610	460			
	Thickness	12.5	12.5	12	11	11			
	Stiffeners			HORIZ. 200x90x9/16	11	11			
	Brackets, Stays	-	-	12, FL.60	-	-			
HATCH BEAMS	Number			HATCH COVER STIFFENED BY 250x90x10/15 M/M INVERTED ANGLES E.W. SPACED 740 M/M.					
	Spacing								
	Scantling and Sketch								
	Bearing Surface								
FORE AND AFTERS	Number								
	Spacing								
	Unsupported Lengths								
	Scantling* and Sketch								
HATCH COVERS	Material	STEEL	STEEL	STEEL	STEEL	STEEL			
	Thickness	12.5	8	10	8	8			
	How fitted	O.T. WITH HANDLE JACK	W.T. WITH HANDLE JACK	HINGED W.T. WITH	HINGED W.T. WITH	HINGED W.T. WITH			
	Bearing Surface								
Spacing of Cleats	...	4 CLIPS	4 CLIPS	46 CLIPS	12-CLIPS	12-CLIPS			
Number of Tarpaulins...	...								
*Are wood fore and afters steel shod at all bearing surfaces? - Are battens and wedges efficient and in good condition? - Are tarpaulins in good condition and in accordance with rule requirements? - Are lashings provided in accordance with rule requirements? -									

Particulars of any special features :-

BUTTERWORTH OPENINGS :- EACH 320 MM. IN DIA. CLOSED BY 16 MM BRASS COVERS AND SECURED BY 10 STUD BOLTS. 4-BUTT. OPENINGS FOR EACH CARGO OIL TANK (ALL AS PER APPROVED PLAN) ONE COVER PLATE TO EACH INBOARD CARGO TANK FITTED WITH ULLAGE HOLE WITH BRASS CAP.

HATCHWAYS TO STORES AFT (P.S.) ON FREEBOARD DK. (IN POOP.)

520 M/M X 620 M/M OPENING. 230 M/M X 10 M/M COAMING. HINGED STEEL NON W.T. COVER.

HATCHWAY TO STORES FORWD. ON FREEBOARD DK. (IN FORECASTLE.)

1020 M/M X 1020 M/M OPENING. 460 X 11 M/M COAMING. HINGED STEEL W.T. COVER SECURED BY 12 CLIPS.



© 2021

Lloyd's Register Foundation