

INUI KISEN K.K.

S-31

L.R.

N.K.

INUISAN MARU


MIDSHIP
SECTION

中央切斷

AS BUILT

SCALE $\frac{1}{30}$

FUJINAGATA
SHIPBUILDING CO. LTD.
OSAKA JAPAN
ENGINEERING DEPARTMENT
SHIP DESIGN SECTION

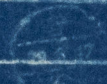CHIEF OF DEPT. 

CHIEF DESIGNER 

CHECKED BY I. Kobayakawa

DRAWN BY

TRACED BY M. Ikeguchi

DATE: JUN. 11 - 1954

DRAWING NO. H-1

TO

Block 12


LLOYD'S REGISTER OF SHIPPING

KOBE TPT. NO. 2170

DATED. _____

★ INUISAN MARU

RECORDS DEPT.

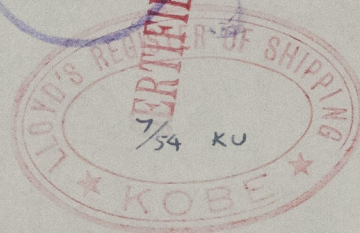

midship section



Lloyd's Register
Foundation

012165-012171-0132

012165-012171-0132