



HOOFDAFMETINGEN

LENGTE L.L.	70. -	M = 229.67
BREEDTE OP SP ^T	11.20 -	= 36.75
HOLTE TOT VRUBOORDEK	4.75 -	= 15.58
- - SHELTERDEK	6.90 -	= 22.64
DIEPGANG	± 4.70 -	= ± 15.42
d/p = 0.682		


KLASSE LLOYDS +100 A 1
FOR EAST ASIATIC SERVICES

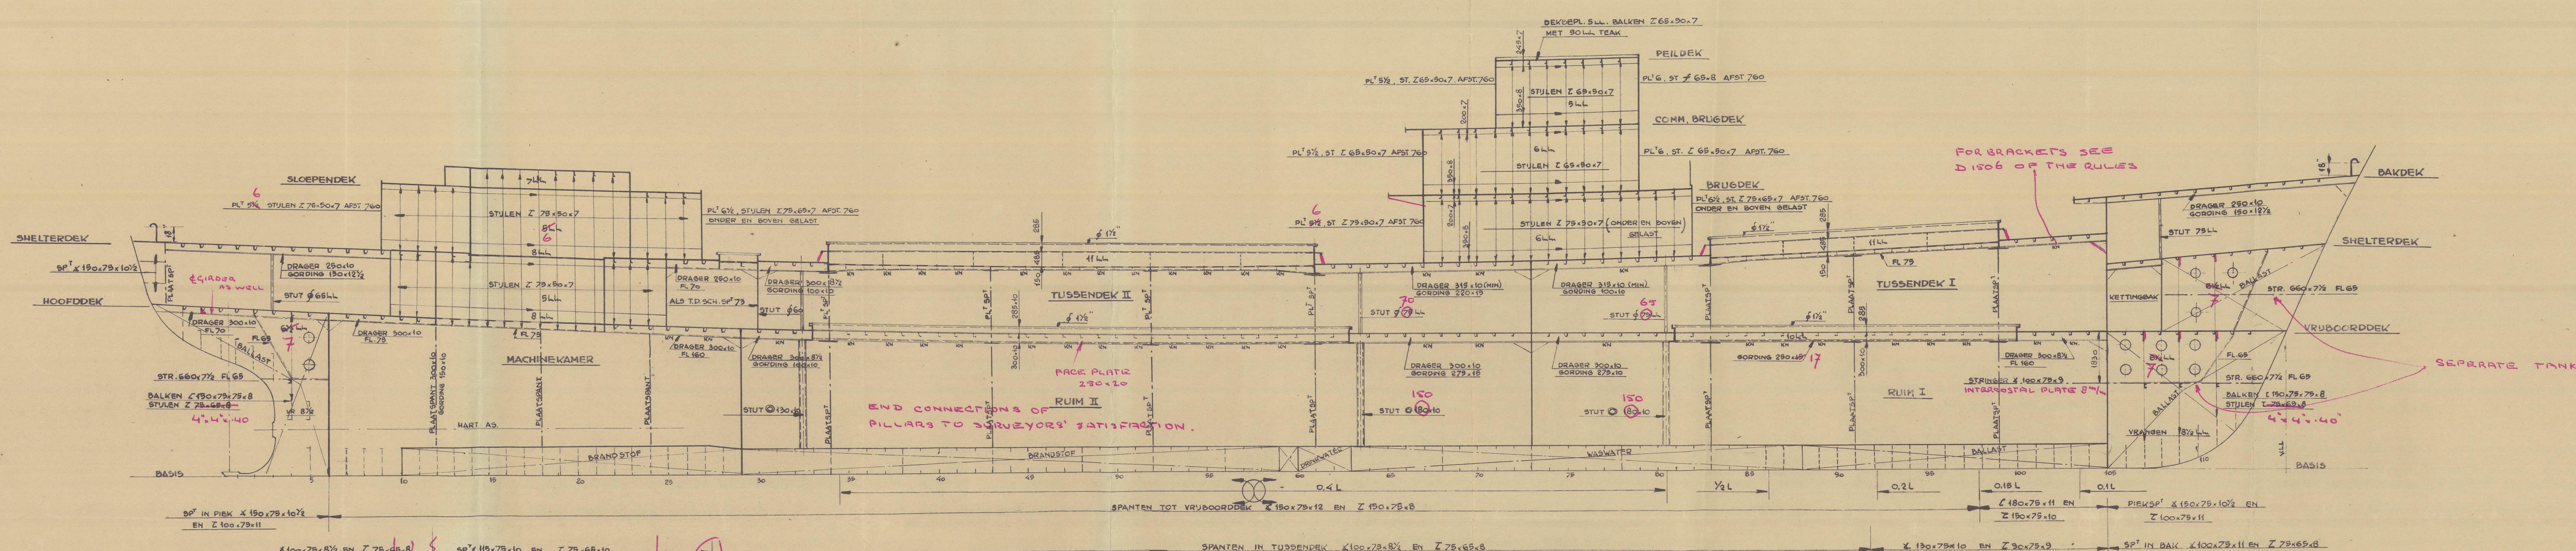


SLOEPENDEK
BEPLATING 5 Lm BALKEN 2 79x68x8
MET TOLLE TRAK

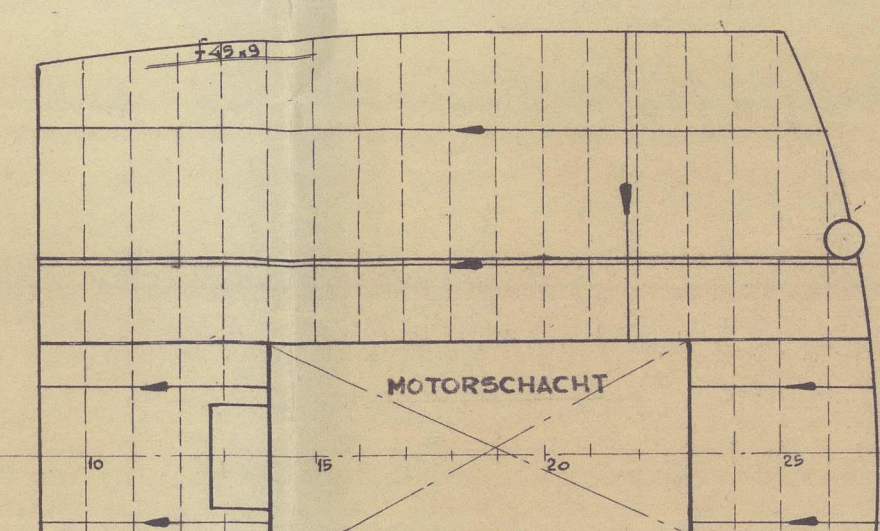





COMMANDO BRUGDEK
BEPLATING SLA BALVEN 179.00.6
NET 50 LL YBAK

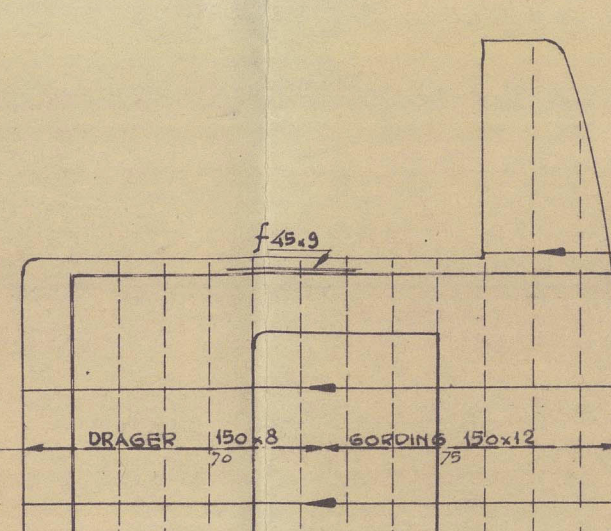


BRUGDE
LAYING 5 hrs
50 Lbs TRAC

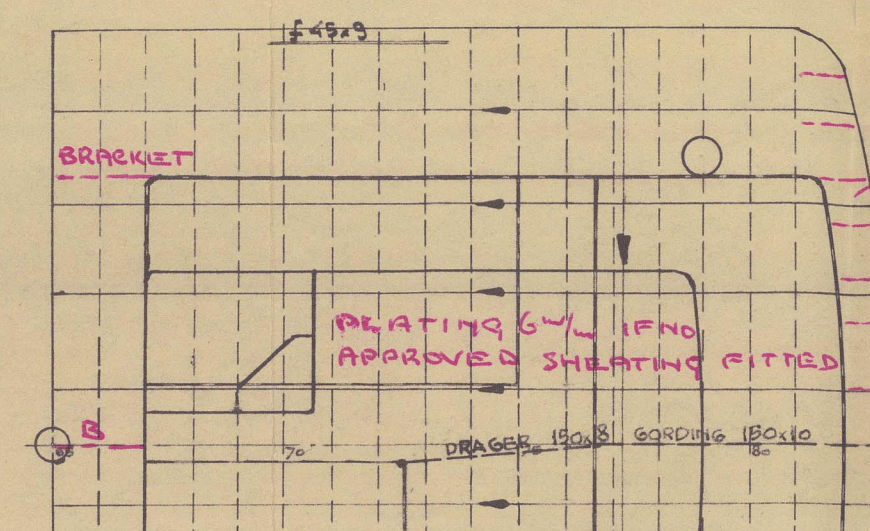





BAKDEK
BEPLATING 62E4m
DALOEN 275x68x8

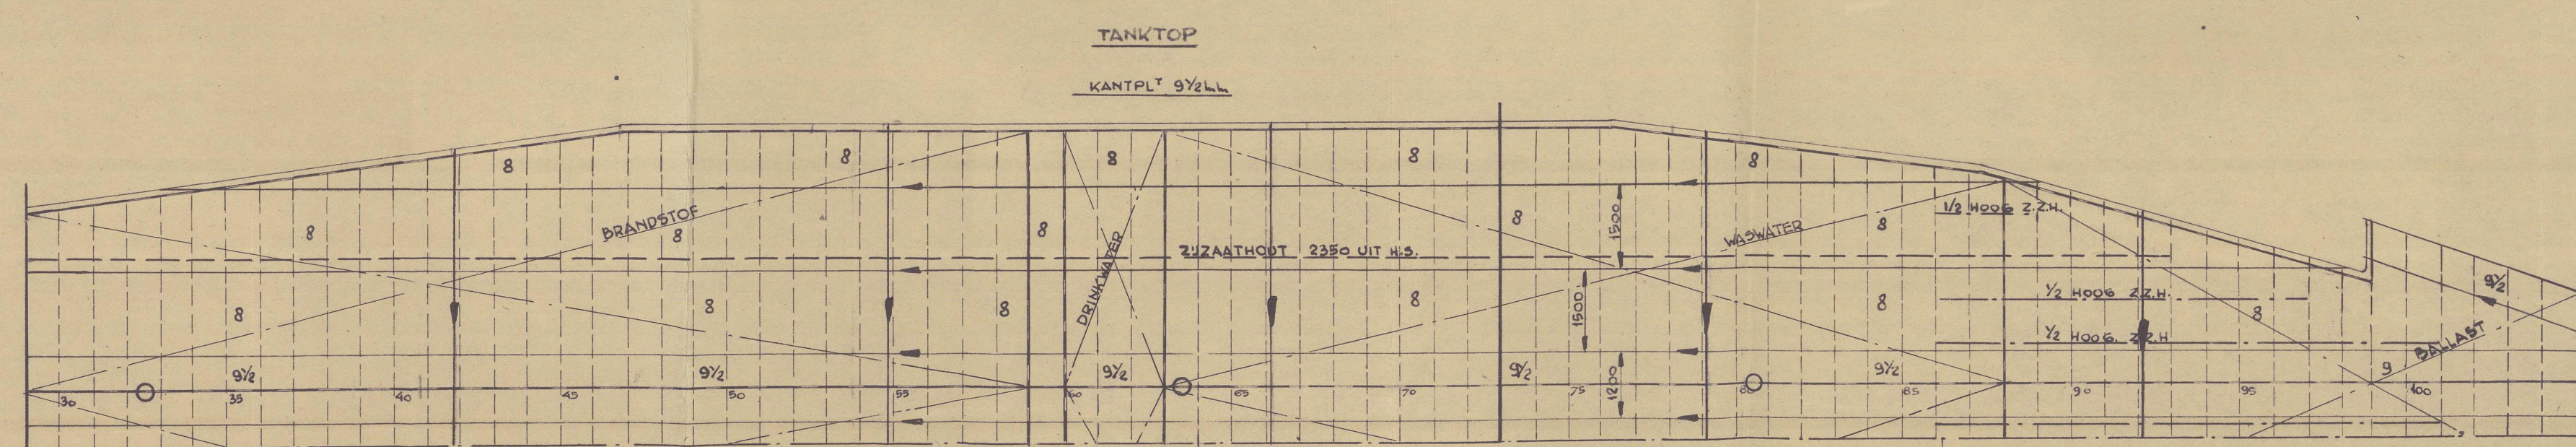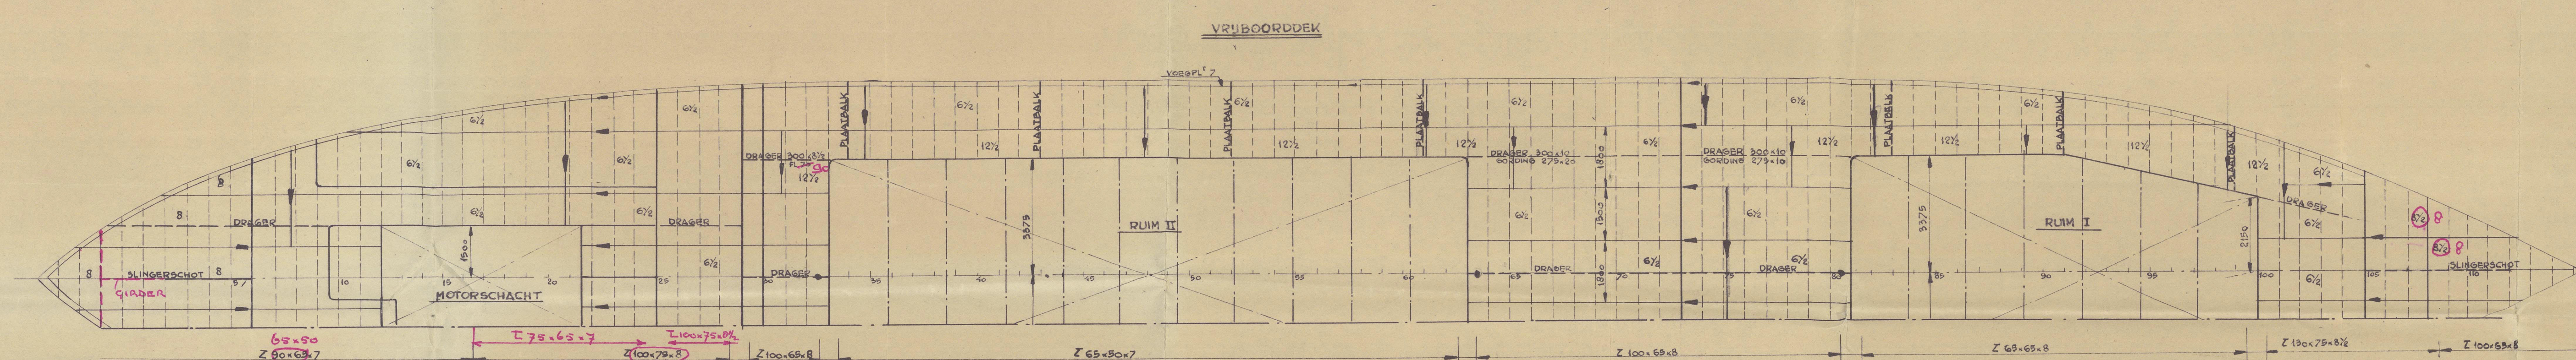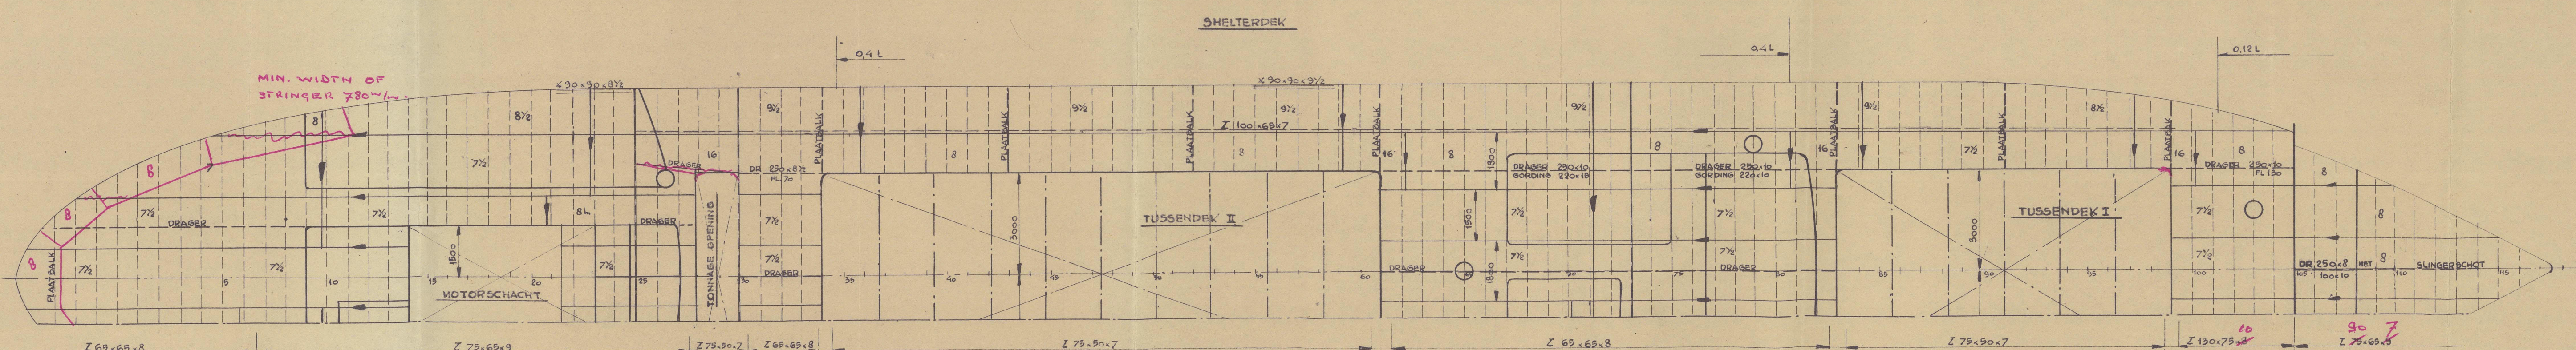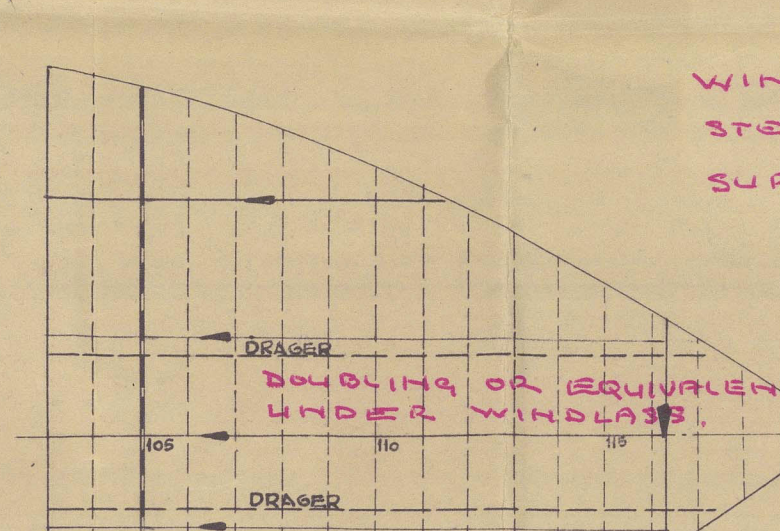

SCHOT SP7105

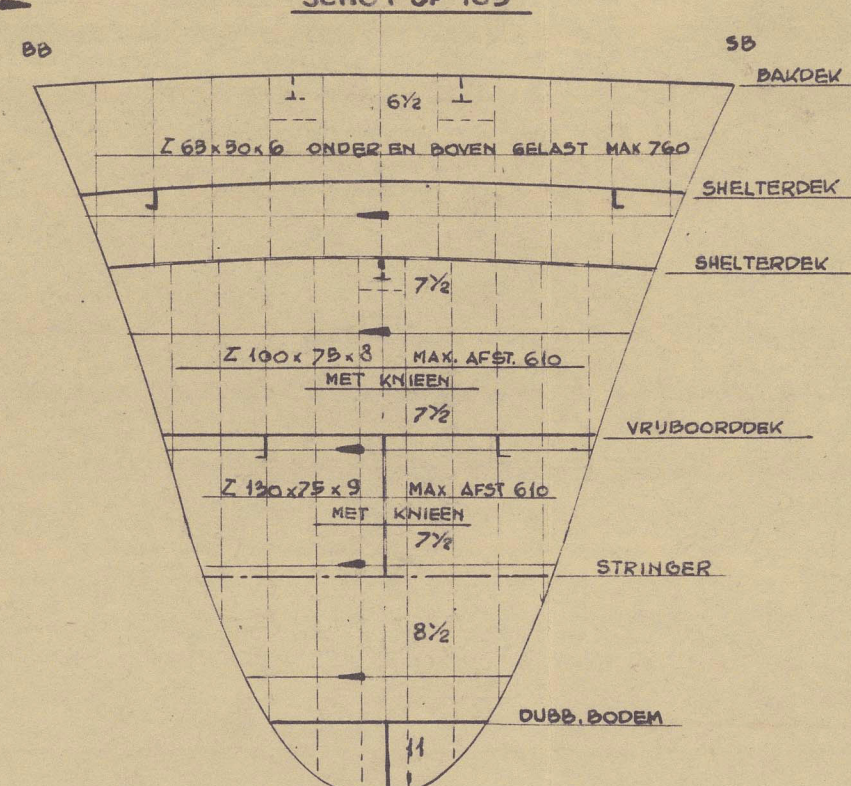

ZEEG

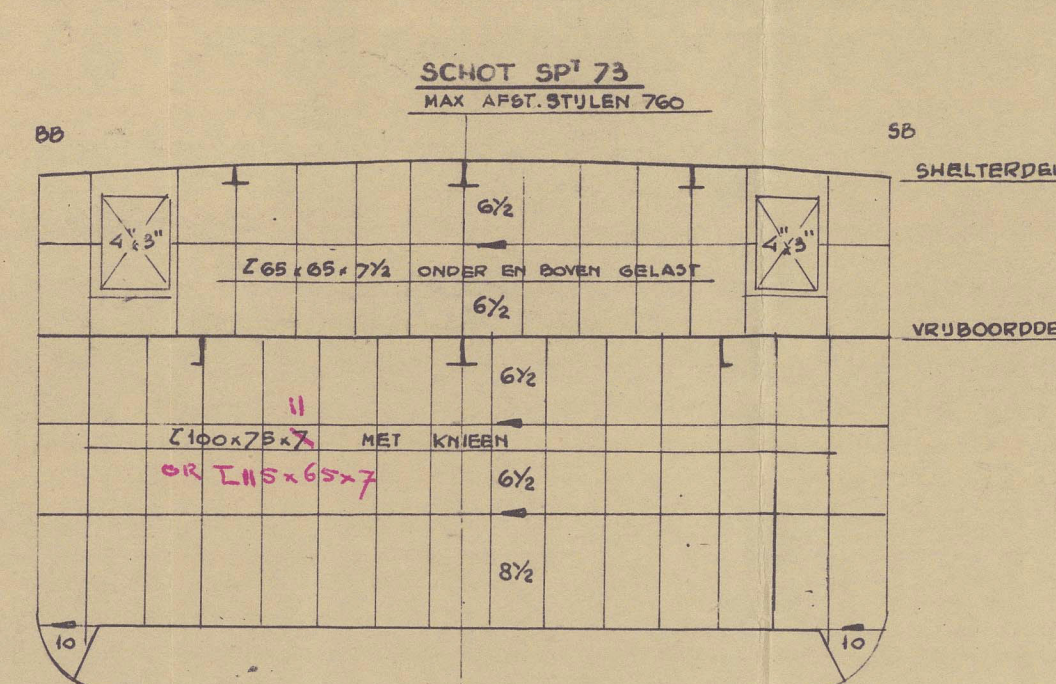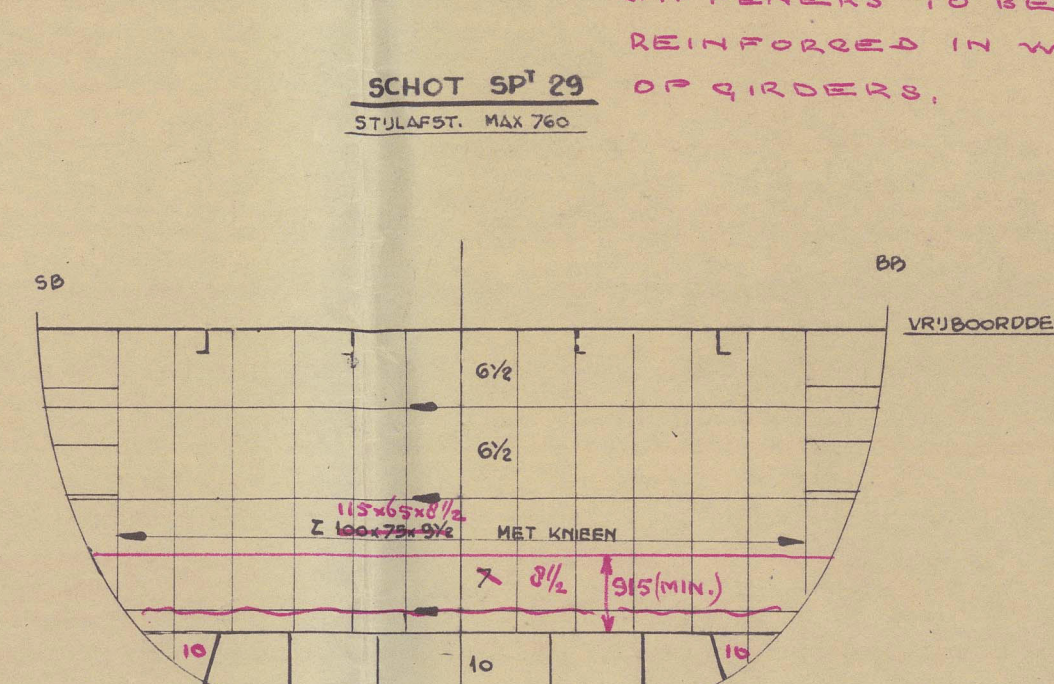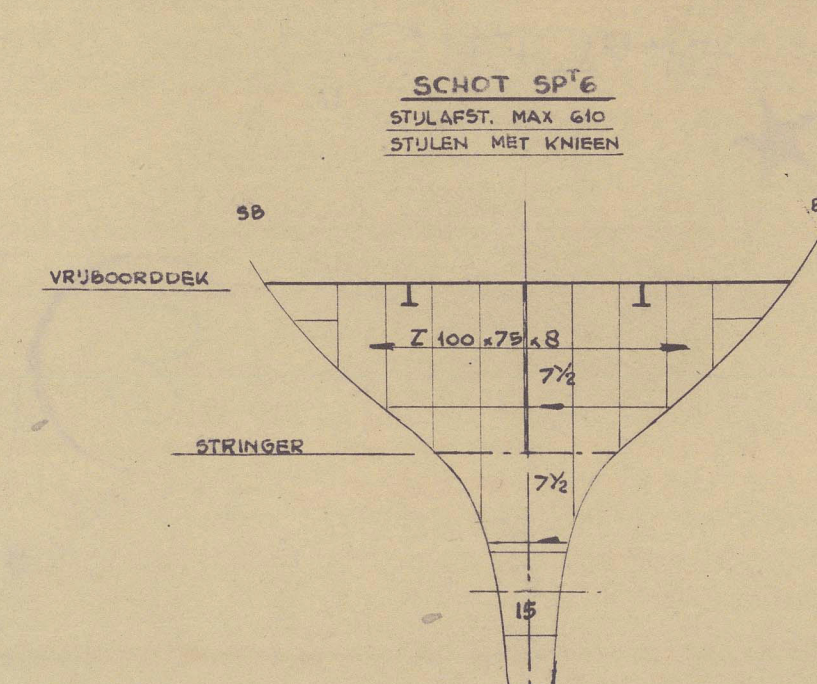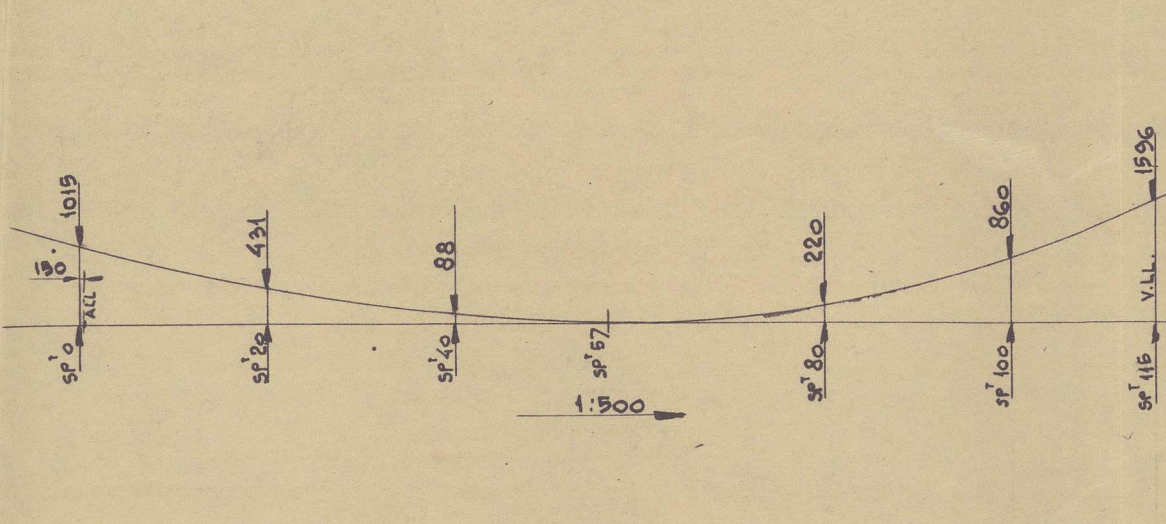

RECORDS DEPT
LONDON

3

" GILI JANG



Profile & Decks.

SCHEEPS 'DE WAAL'

YARD NOS 650-51-52

PROFILE & DECKS.

© 2021

Lloyd's Register
Foundation

012221-012228-0096

MESSRS "DE WAAL"

YARD N^o 650-51-52

LONGITUDINAL SECTION, DECKS
DOUBLE BOTTOM AND
BULKHEADS.