

# Lloyd's Register of Shipping.


## SURVEYS FOR FREEBOARD.

### (CONDITIONS OF ASSIGNMENT.)

Index No. \_\_\_\_\_  
(For London Office only.)

Ship's Name "VARIDA" Port of Survey BOMBAY  
 Official Number \_\_\_\_\_ Surveyor's Signature Tulinthope  
 Nationality and Port of Registry INDIAN Date of Survey WHILST BUILDING.

Disposition and dimensions of superstructures, trunks, deckhouses and machinery casings to be inserted in the diagrams and tabular statement:—

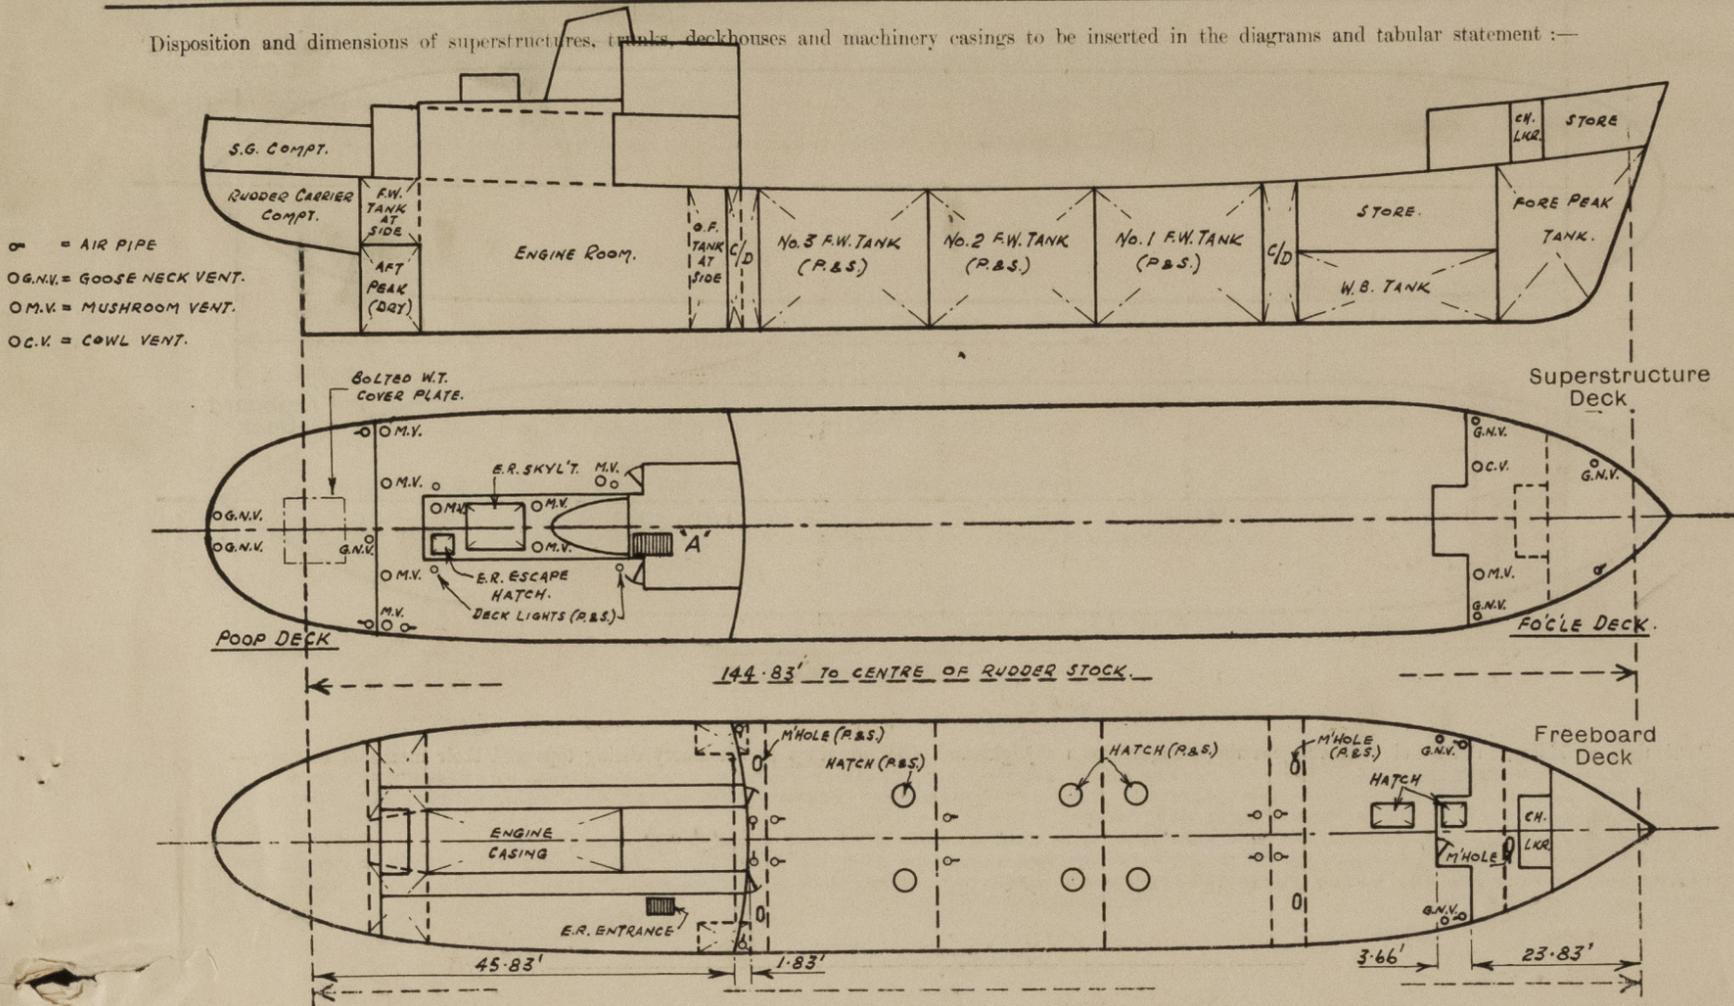


Particulars of Superstructures, Trunks, Casings, Deckhouses.

	Coaming	Plating	Stiffeners	Spacing	End Attachments of Stiffeners	Size of Openings	Height of Sills	Height of Casings
Poop Bulkhead ... ..	5/16" ✓	PART 1/4" ALUMINUM 5/16	6x3 1/2" x 33" B.A. 5" x 3" x 5/16" O.A. TOE WELDED.	30" ✓	WELDED DIRECT. ✓	2 @ 4'-6" x 2'-0"	24" ✓	7'-0"
Raised Quarter Deck Bulkhead ...	—	—	—	—	—	—	—	—
Bridge, After Bulkhead ... ..	—	—	—	—	—	—	—	—
Bridge, Forward Bulkhead ... ..	—	—	—	—	—	—	—	—
Forecastle Bulkhead ... ..	1/4" ✓	1/4" ✓	1 3/4" x 1 3/4" x 3/16" O.A. TOE WELDED.	30" ✓	NONE ✓	1 @ 3'-5" x 2'-0"	24" ✓	6'-0"
Trunk, Aft ... ..	—	—	—	—	—	—	—	—
Trunk, Forward ... ..	—	—	—	—	—	—	—	—
Exposed Machinery Casings on Freeboard or Raised Quarter Decks ...	—	—	—	—	—	—	—	—
Exposed Machinery Casings on Superstructure Decks ... ..	—	—	—	—	—	—	—	—
Machinery Casings within Superstructures not fitted with Class I Closing Appliances ... ..	—	—	—	—	—	—	—	—
Deckhouses on Flush Deck Ships ...	—	—	—	—	—	—	—	—

Particulars of Closing Appliances (state if capable of being manipulated from both sides).

Poop Bulkhead ... ..	HINGED STEEL W.T. DOORS OPERATED BOTH SIDES (CLASS 1) ✓
Raised Quarter Deck Bulkhead ...	
Bridge, After Bulkhead ... ..	
Bridge, Forward Bulkhead ... ..	
Forecastle Bulkhead ... ..	HINGED HARDWOOD DOOR, 2" THICK OPERATED BOTH SIDES (CLASS 2) ✓
Exposed Machinery Casings on Freeboard or Raised Quarter Decks ...	
Exposed Machinery Casings on Superstructure Decks ... ..	
Machinery Casings within Superstructures not fitted with Class I Closing Appliances ... ..	
Deckhouses on Flush Deck Ships ...	

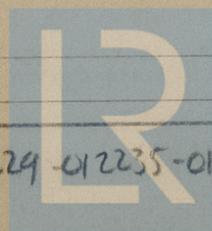



PARTICULARS OF PROTECTION TO OPENINGS, ETC.

HATCHWAYS ON FREEBOARD AND SUPERSTRUCTURE DECKS.						
FREEBOARD DECK						
Description of Hatchway	ACCESS HATCH TO DRY STORE FORWARD	HATCH TO DRY STORE FORWARD	HATCHES TO F.W. TANKS (6 OFF)	MANHOLES TO DEEP C'DAMS (4 OFF)	MANHOLE TO F.P. TANK.	
Dimensions of Hatchway	2'-6" x 2'-6"	4'-6" x 3'-0"	30" DIA.	21" x 15" OVAL	21" x 15" OVAL	
COAMINGS	Height above Deck	9" ✓	24" ✓	24" ✓		
	Thickness	3/8"	3/8"	3/8"		
	Stiffeners	-	-	-		
	Brackets, Stays	-	-	-		
HATCH BEAMS	Number					
	Spacing					
FORE AND AFTERS	Number					
	Spacing					
HATCH COVERS	Material	STEEL 3/8" ✓	STEEL 3/8" ✓	STEEL 3/8" ✓	STEEL 1/2" ✓	STEEL 1/2" ✓
	Thickness					
HATCH COVERS	How fitted	HINGED W.T. WITH 8 TOGGLES	HINGED W.T. WITH 10 TOGGLES	HINGED W.T. WITH 4 TOGGLES	SECURED W.T. BY 20 STUDS	SECURED W.T. BY 20 STUDS
	Bearing Surface					
Spacing of Cleats	-	-	-	-	-	
Number of Tarpaulins	-	-	-	-	-	

\*Are wood fore and afters steel shod at all bearing surfaces? —  
 Are battens and wedges efficient and in good condition? —  
 Are tarpaulins in good condition and in accordance with rule requirements? —  
 Are lashings provided in accordance with rule requirements? —

Particulars of any special features:—

POOP DECK:-  
 1- 7'-0" x 5'-6" ACCESS OPENING CUT IN DECK PLATING OVER STEERING GEAR CLOSED BY STEEL COVER PLATE SECURED W.T. BY 5/8" DIA. BOLTS ✓  
 SPACED 2 3/4" APART.  
 4- 9" DIA. GLASS LIGHTS, 1/4" THICK, IN DECK OVER PASSAGeways IN POOP ACCOMMODATION. (2 PORT & STARBOARD). ✓