


M. V. Nos 131 & 132.

STERN FRAME & BALANCED REACTION RUDDER.

CLASS LLOYD'S 100 A.1.

SPEED 9 KNOTS.

SCALE: 1" = 1 FOOT.

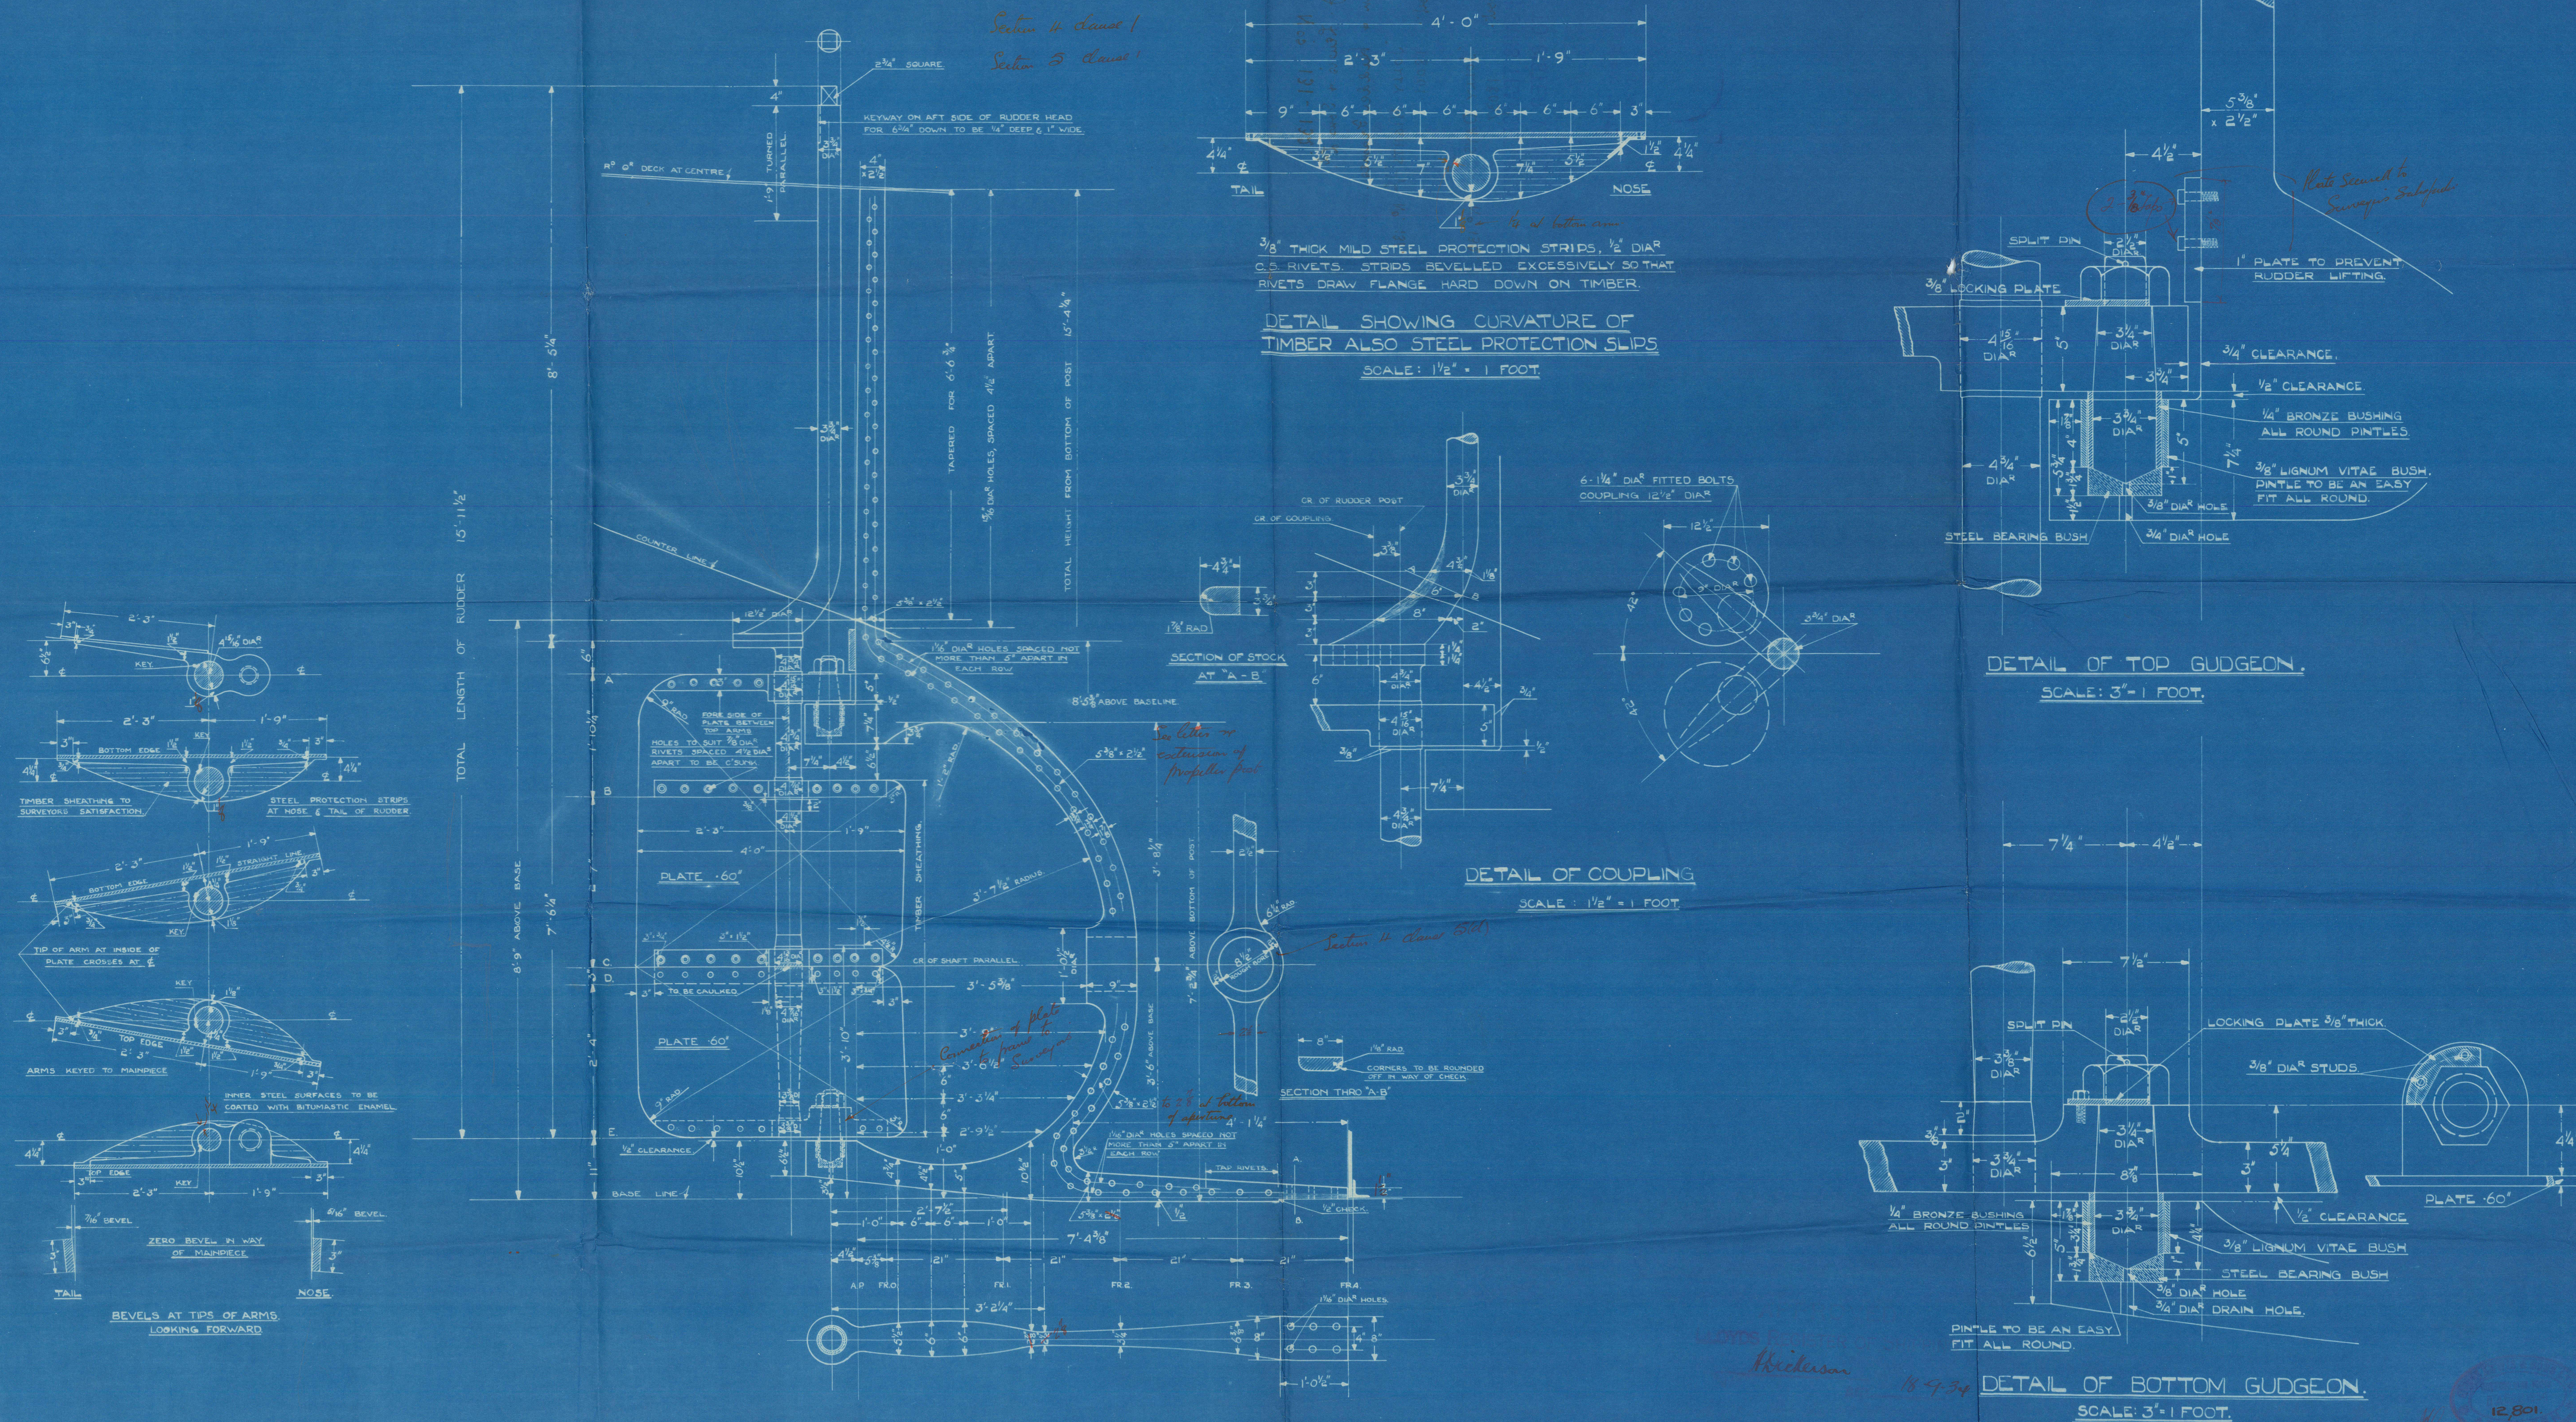

N^{os} 131 - 132.

J. Lewis & Sons Ltd.

Stein & Rudder Frames ^{n.n.} "CRANBORNE" "JEABANK"

S.S. "JOLLY NIGHTS" ^{EX} ★ N^o. 131.
abu. Report. 18001.

S.S. "JOLLY DAYS" N^o. 132.
abu. Report. 18037.

PLANS TRANSFERRED
TO SISTER VESSEL

Gene N/A

RECORDS DEPT
LONDON.



© 2021

Lloyd's Register
Foundation

012229-012235-0149