





15/4/18.

N° 1115. PROFILE AND DECK PLANS.

SCALE $\frac{1}{4}$ = 1 FOOT.

TO CLASS 100.A.I. LLOYDS.

DIMENSIONS 157' 2" x 26' 0" M.D. x 12' 0" M.D.

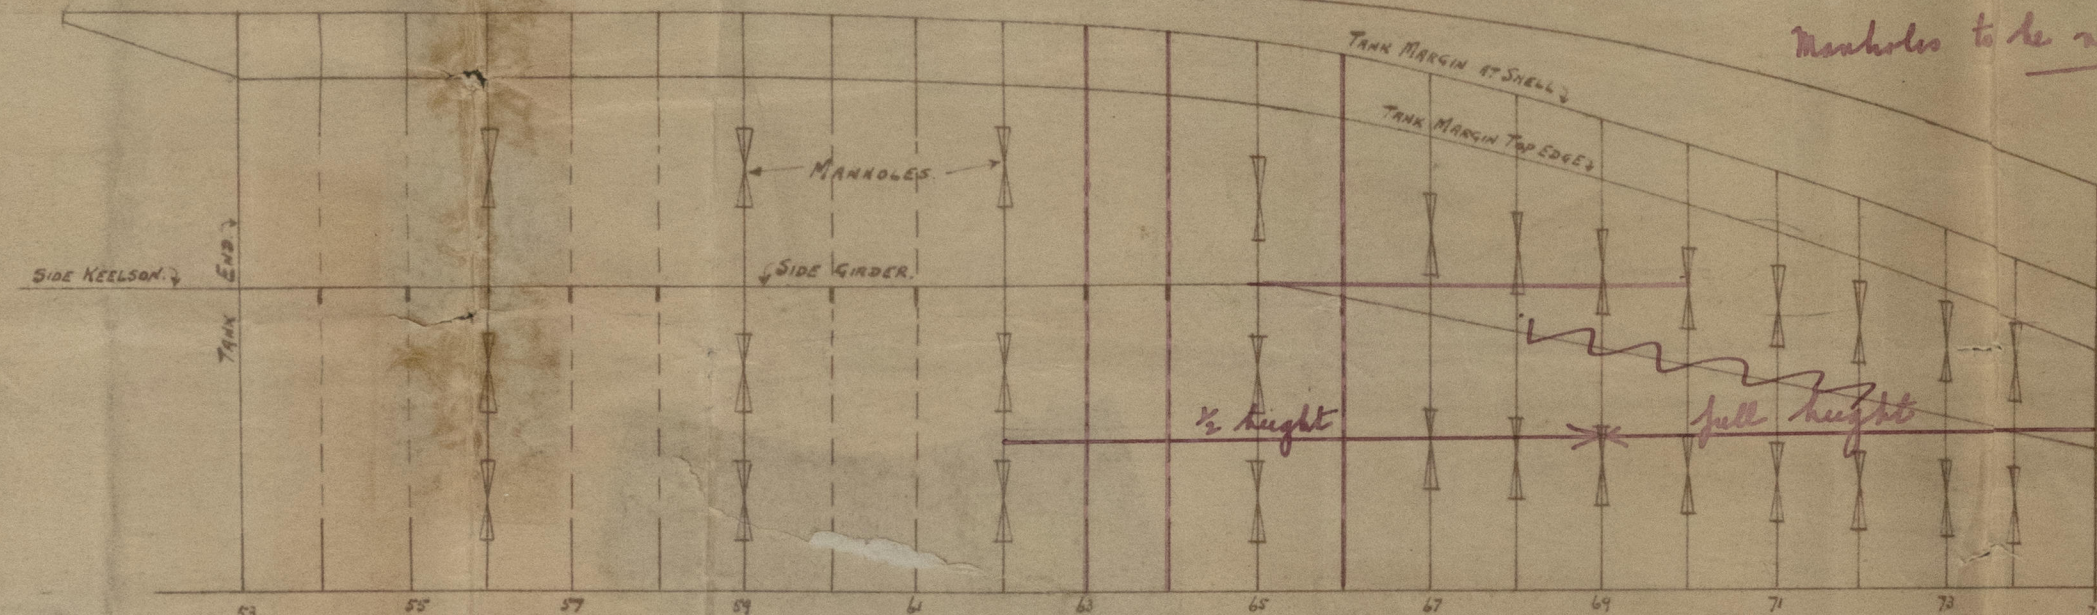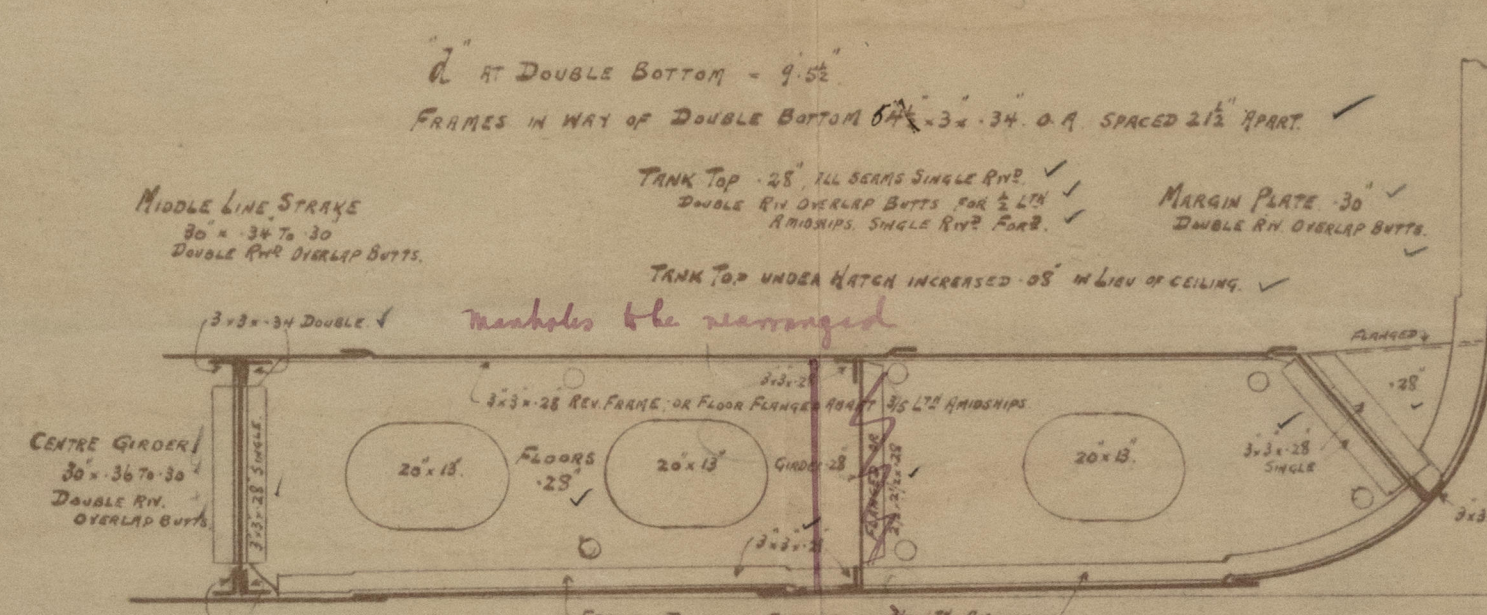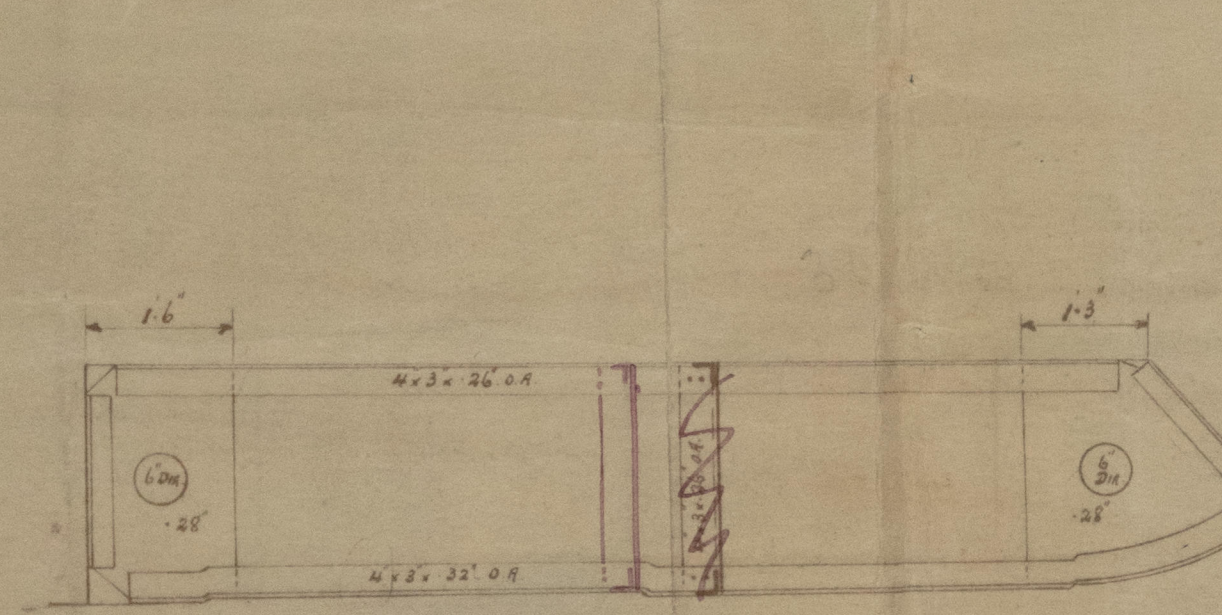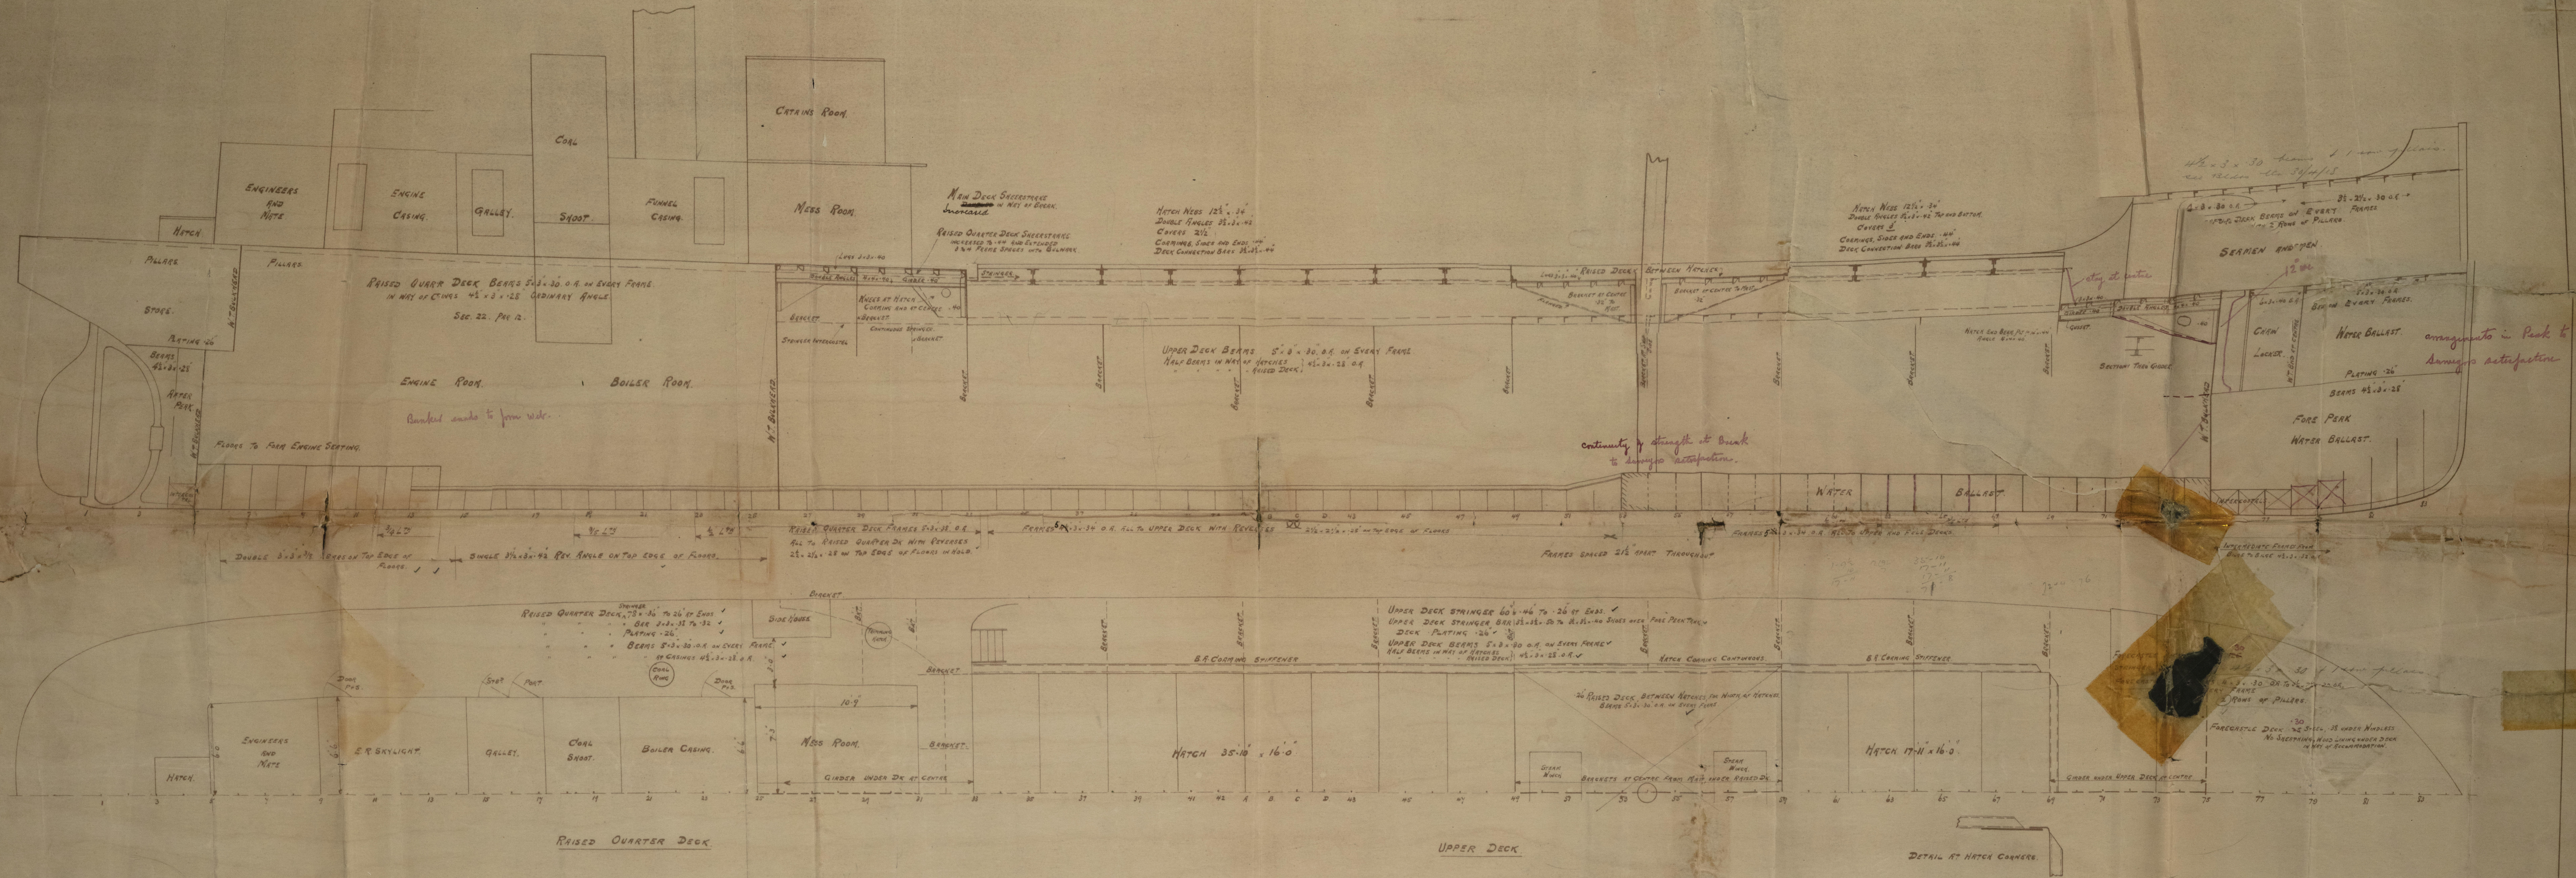

3-A-18

No. 2

SWAN HUNTER & WIGHAM RICHARDSON LTD.



SS No 1115

STANDARD C.S. TYPE

Profile and Decks
1/11 "Kung Sing"

S. S. WAR TAMAR
NEWCASTLE ON TYNE.

Report No. 41 840.

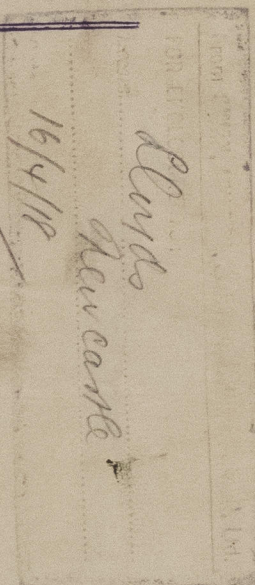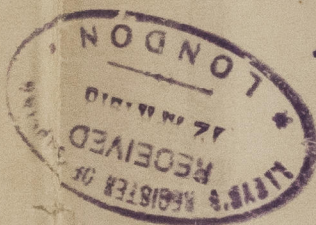

© 2021

Lloyd's Register
Foundation

L100-547210-922710