




DOORSNEDE A-A.

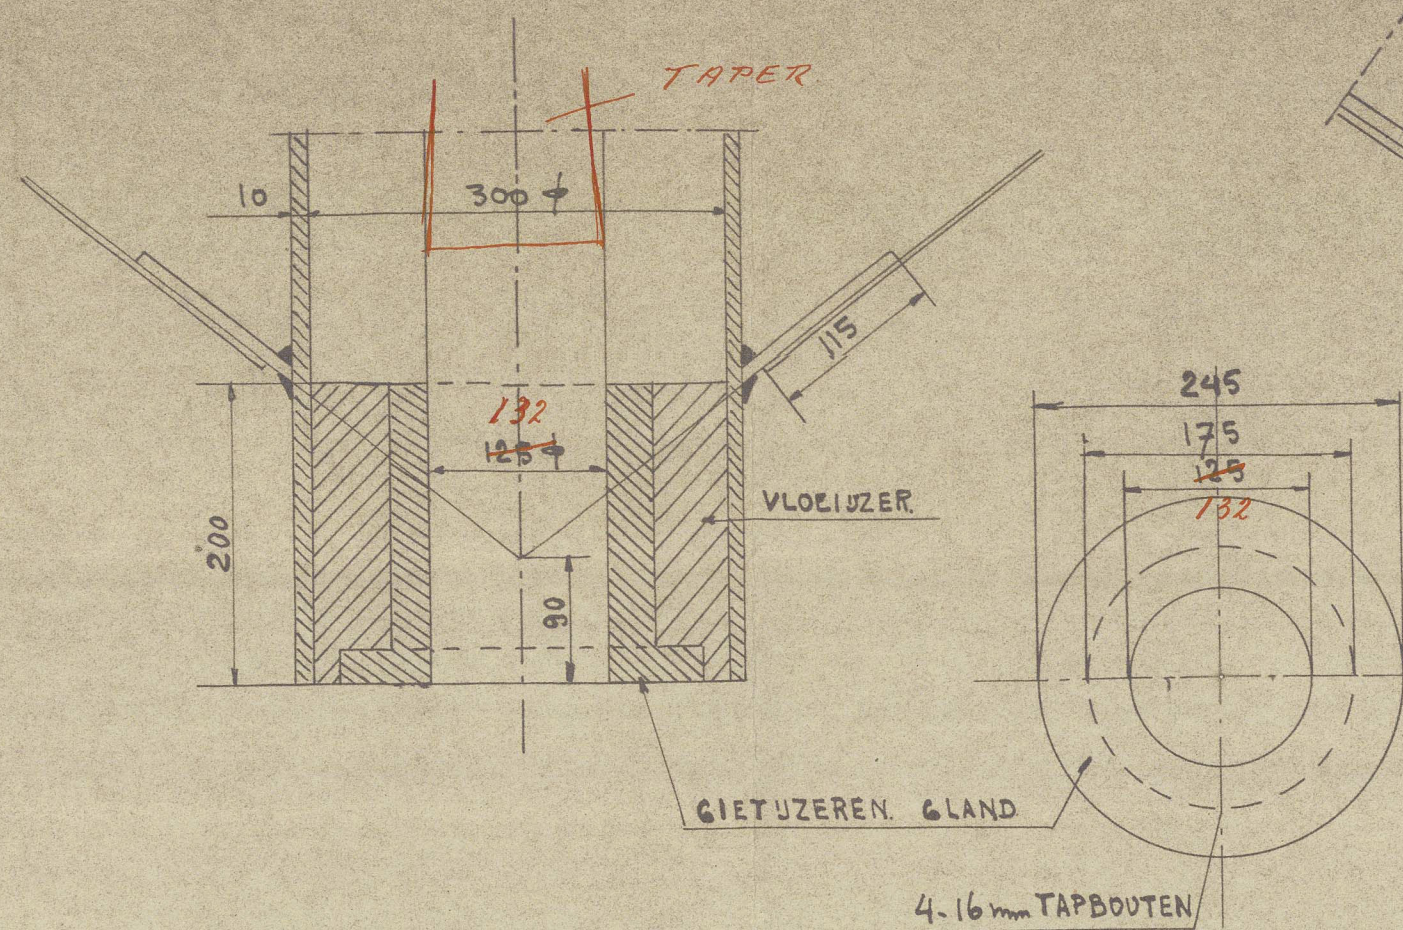


SPANT O

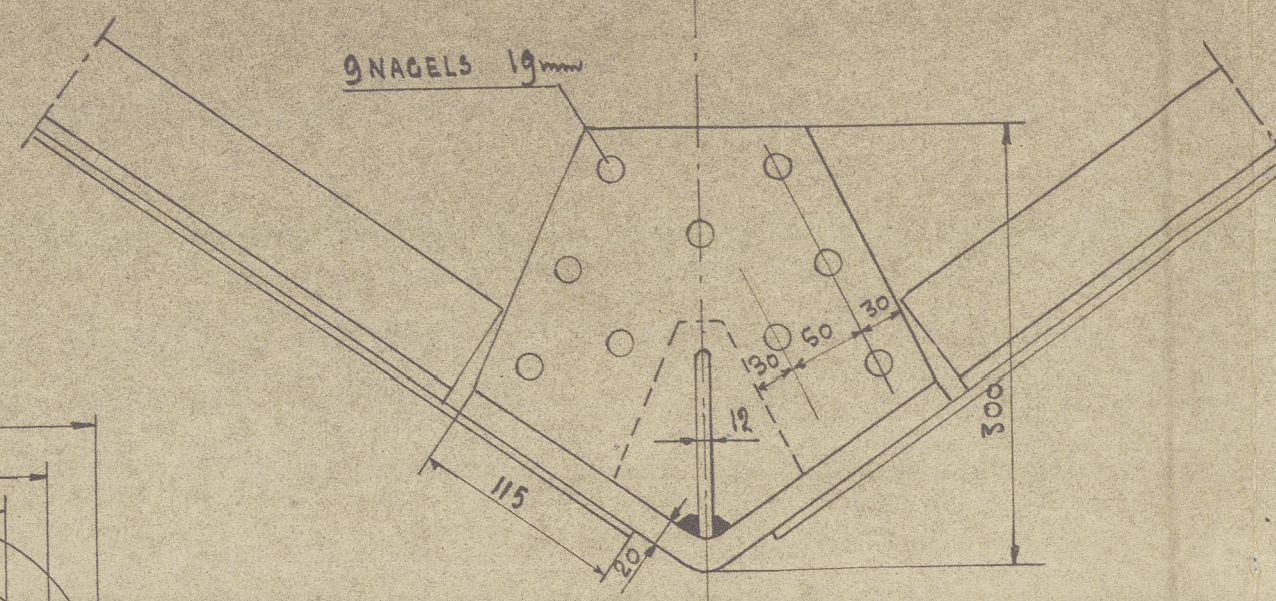


SPANT 1

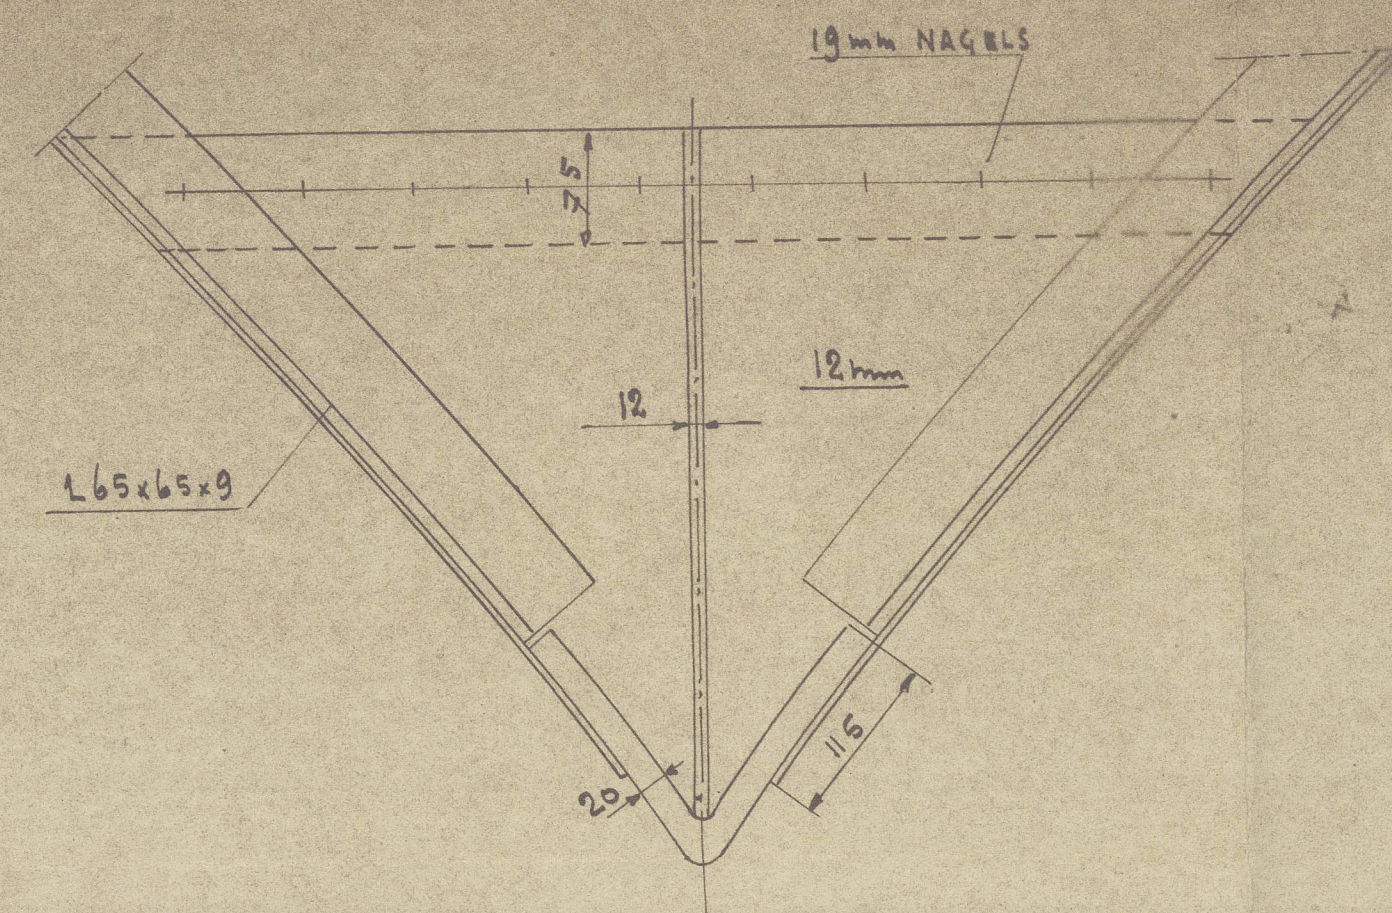


DEZE MATEN ZIJN OP BUITENKANT PLAAT

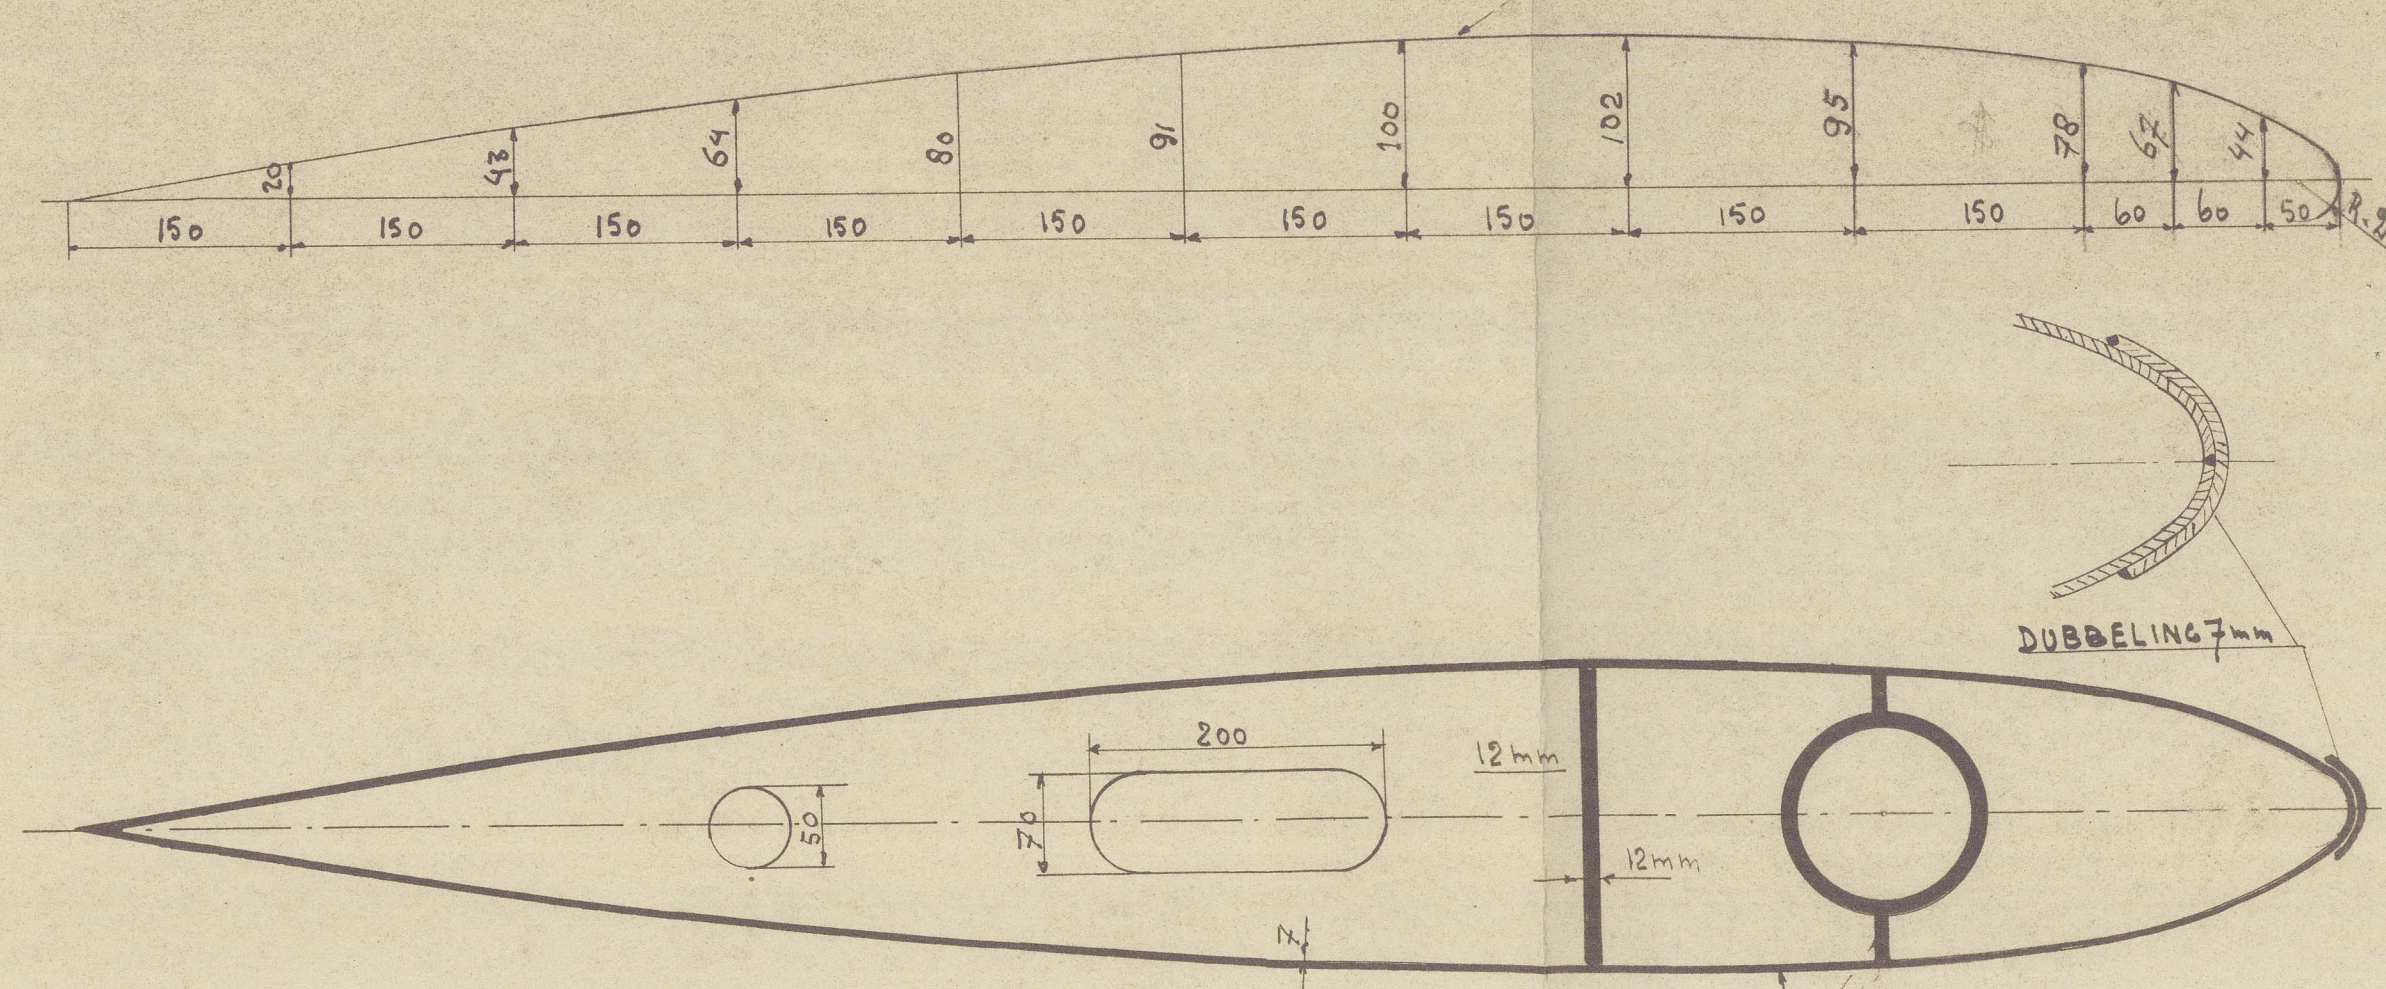

DOORSNEDE I-I

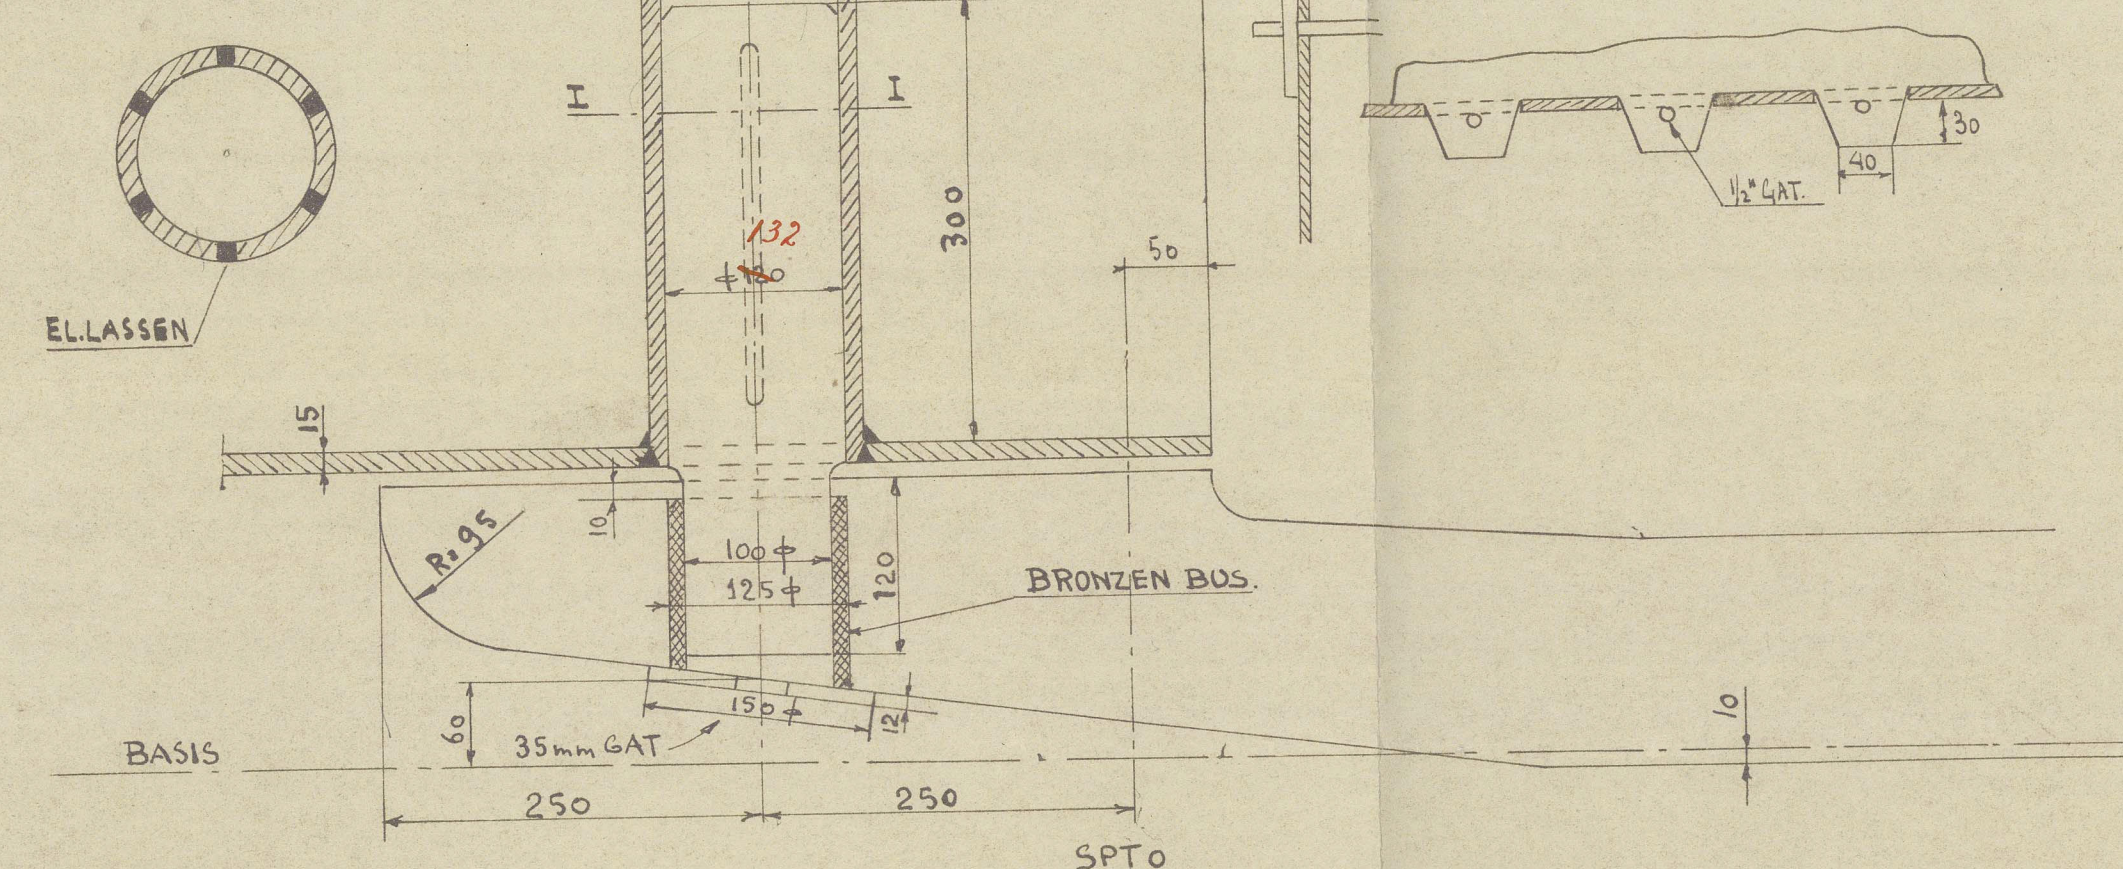

35
~~32~~ mm BOUTEN.

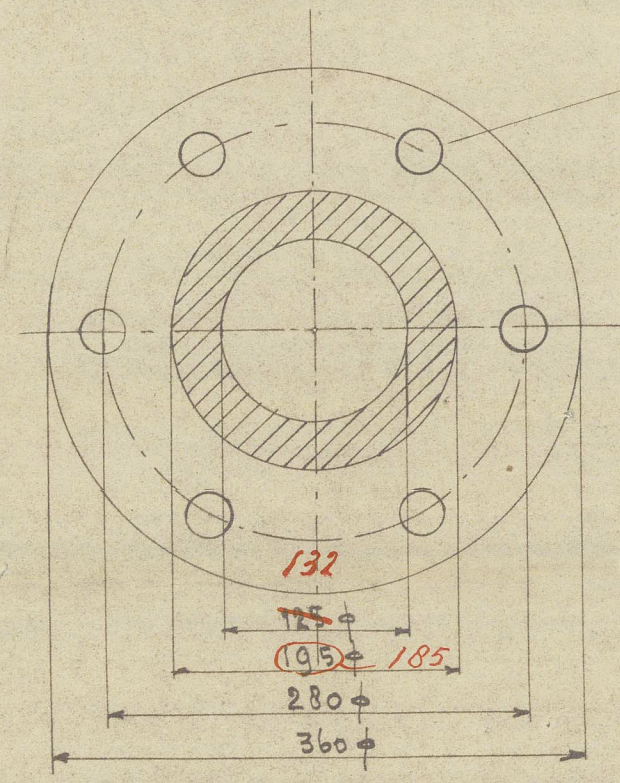

100 A x D = 173

SPEED NOT EXCEEDING 12 KNOTS.

THE REMAINING REQUIREMENTS OF
SECTION 33 OF THE RULES TO BE
COMPLIED WITH WHERE APPLICABLE



RECORDS DEPT.
LONDON

"PRINSENGRACHT



15

ZAA^NLANDSCHE SCHEEPS.

YARD NO. 448. & 451

Lloyd's Register

STERNFRAME & RUDDER

3

N.V. ZRAANLANDSCHE

SCHEEPSBOUW M.Y.

YARD No 448

STERNFRAME AND RUDDER



© 2021

Lloyd's Register
Foundation