
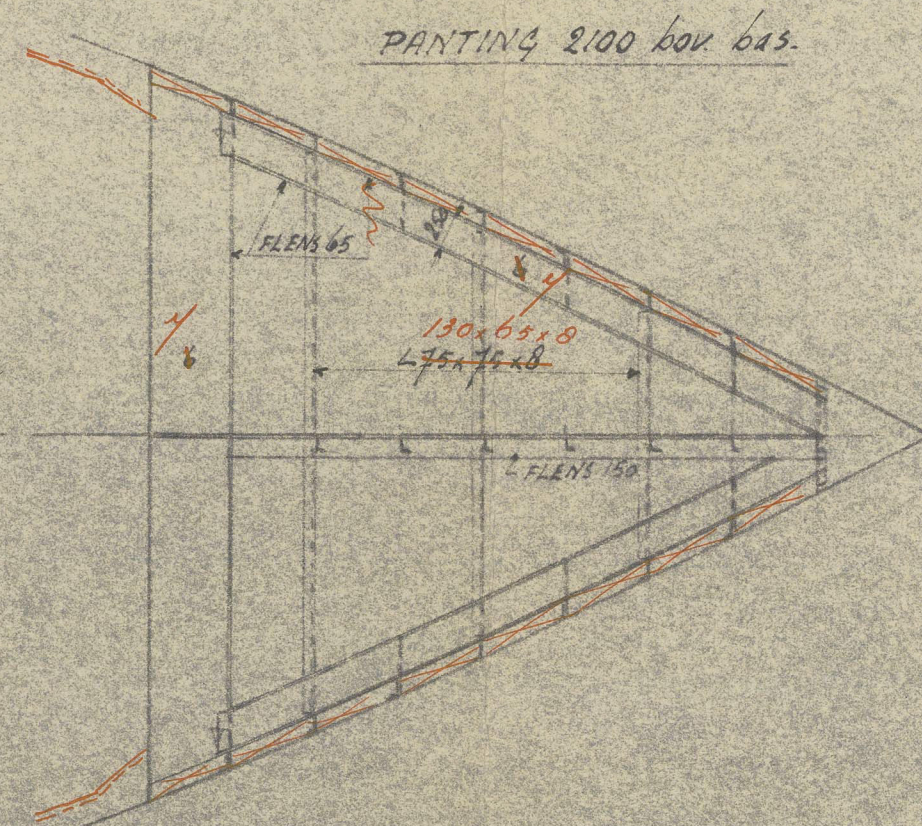
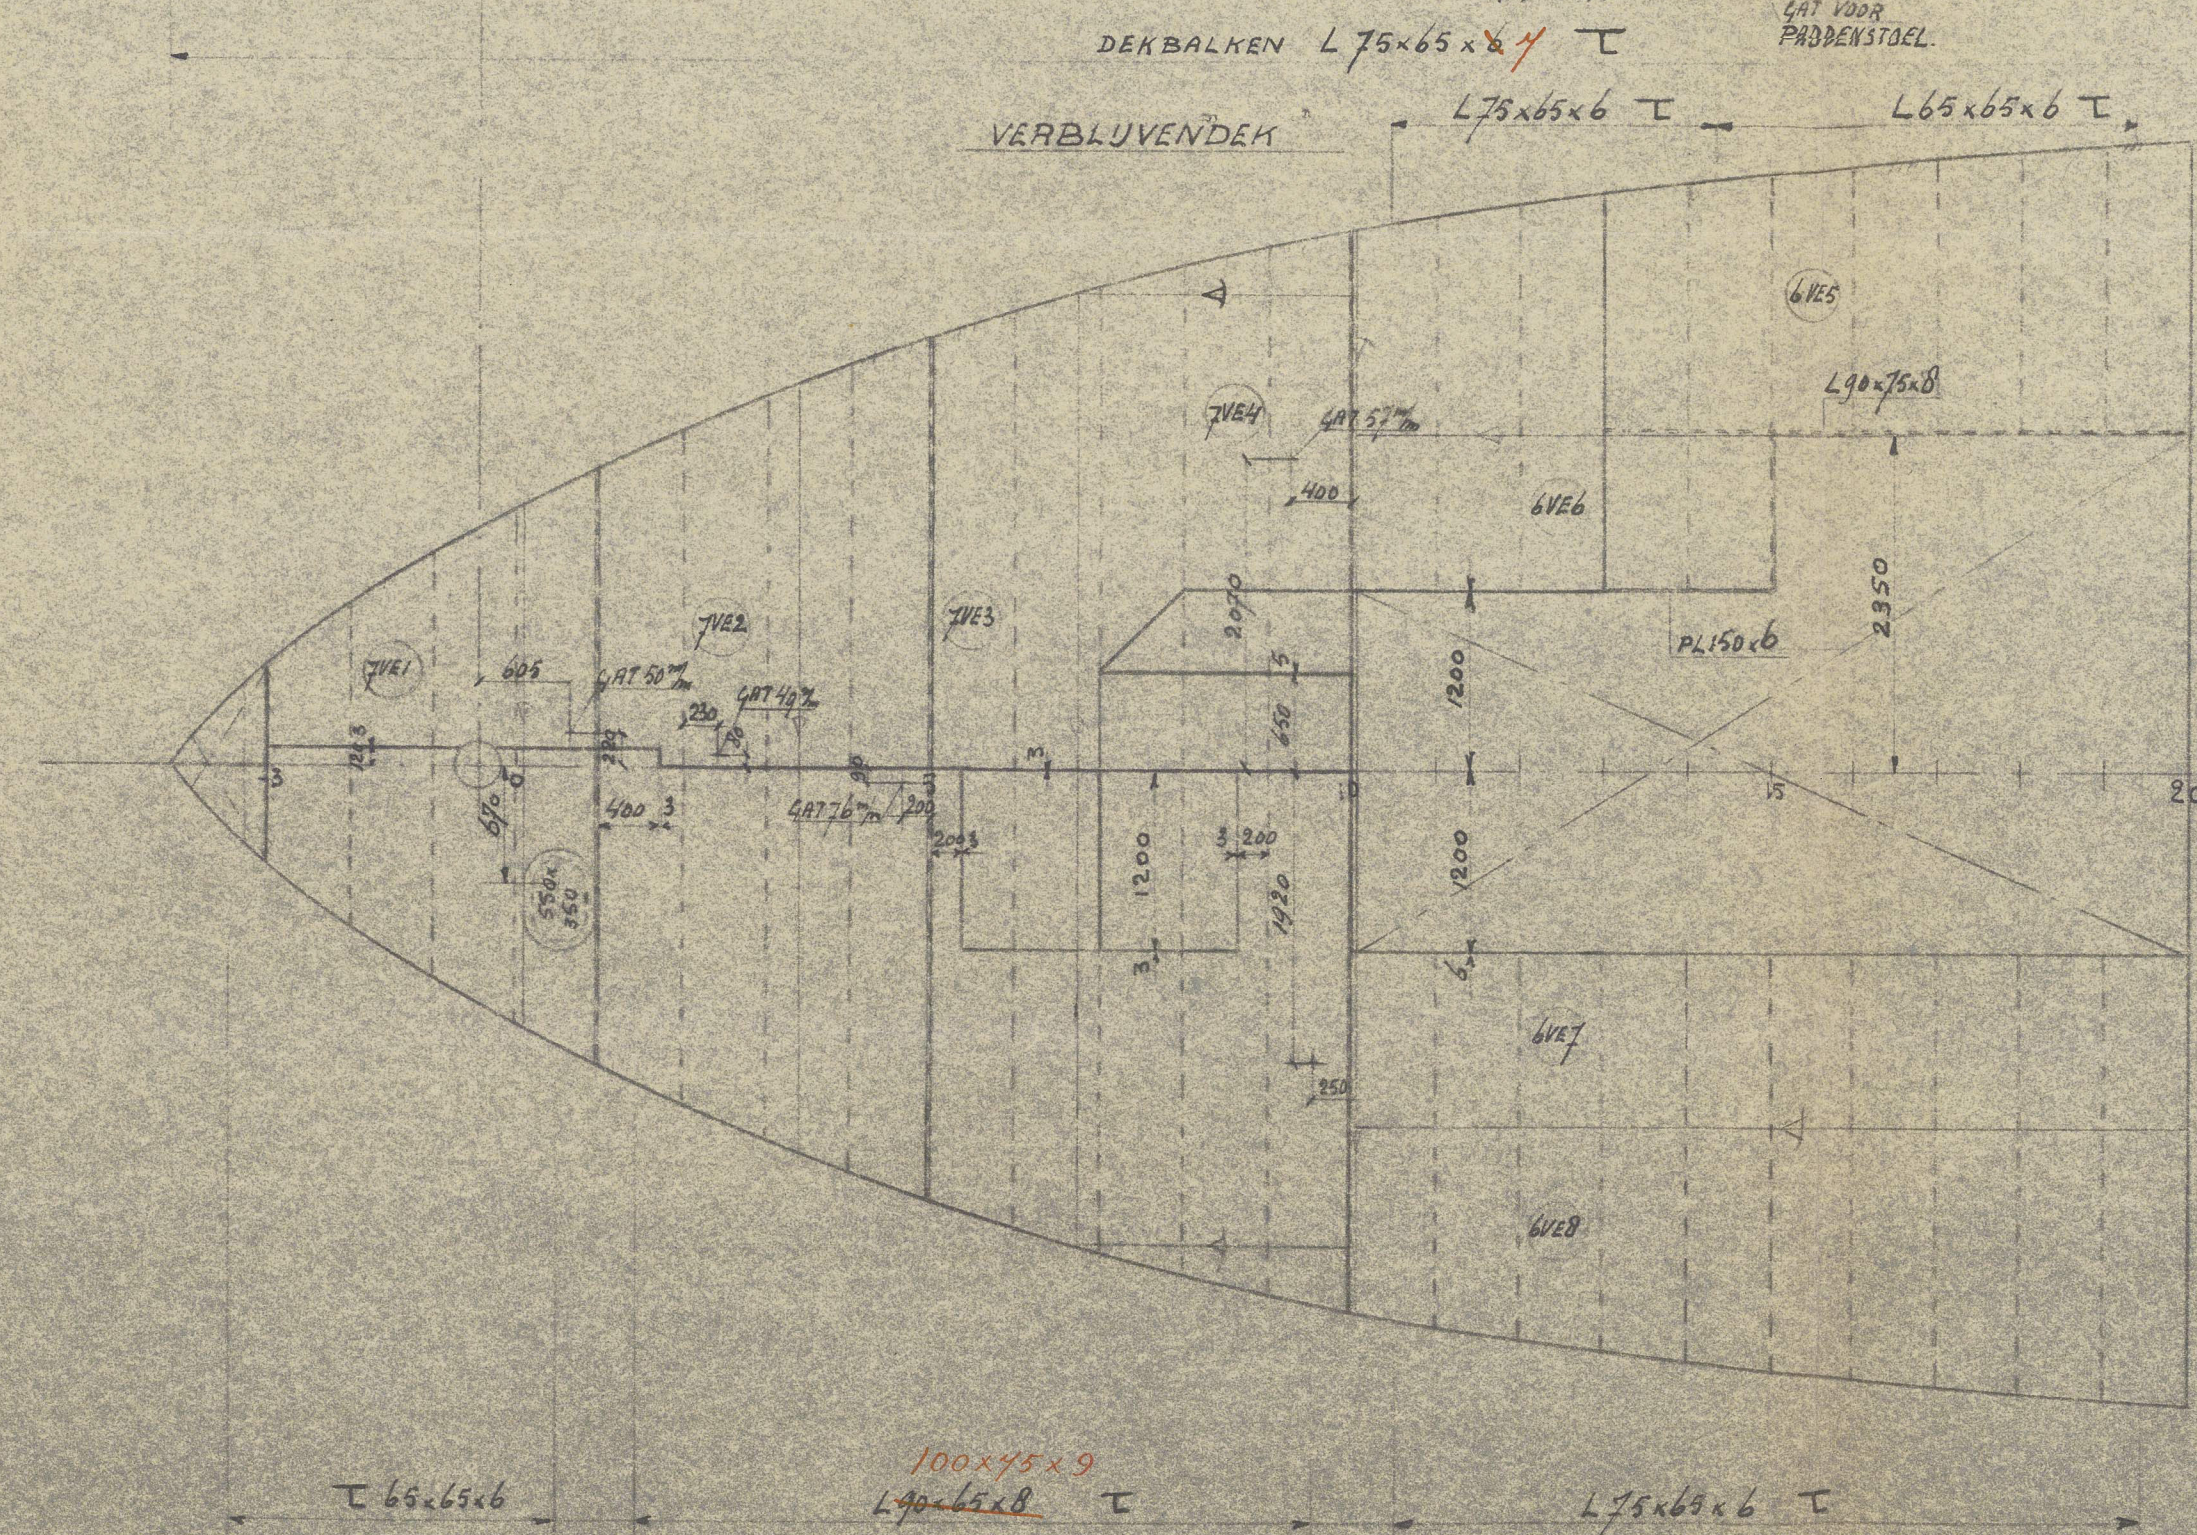
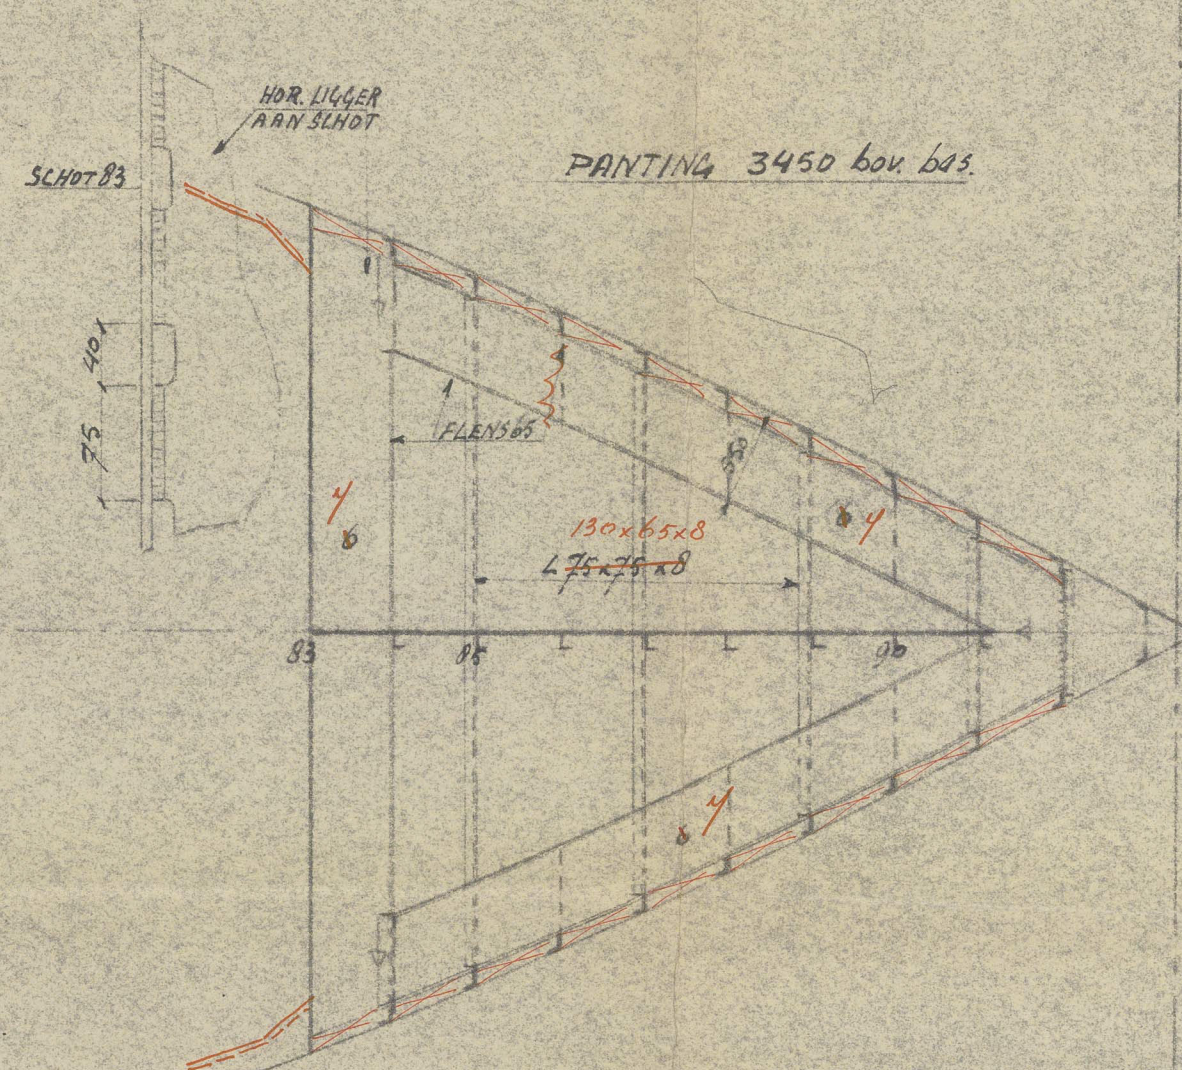
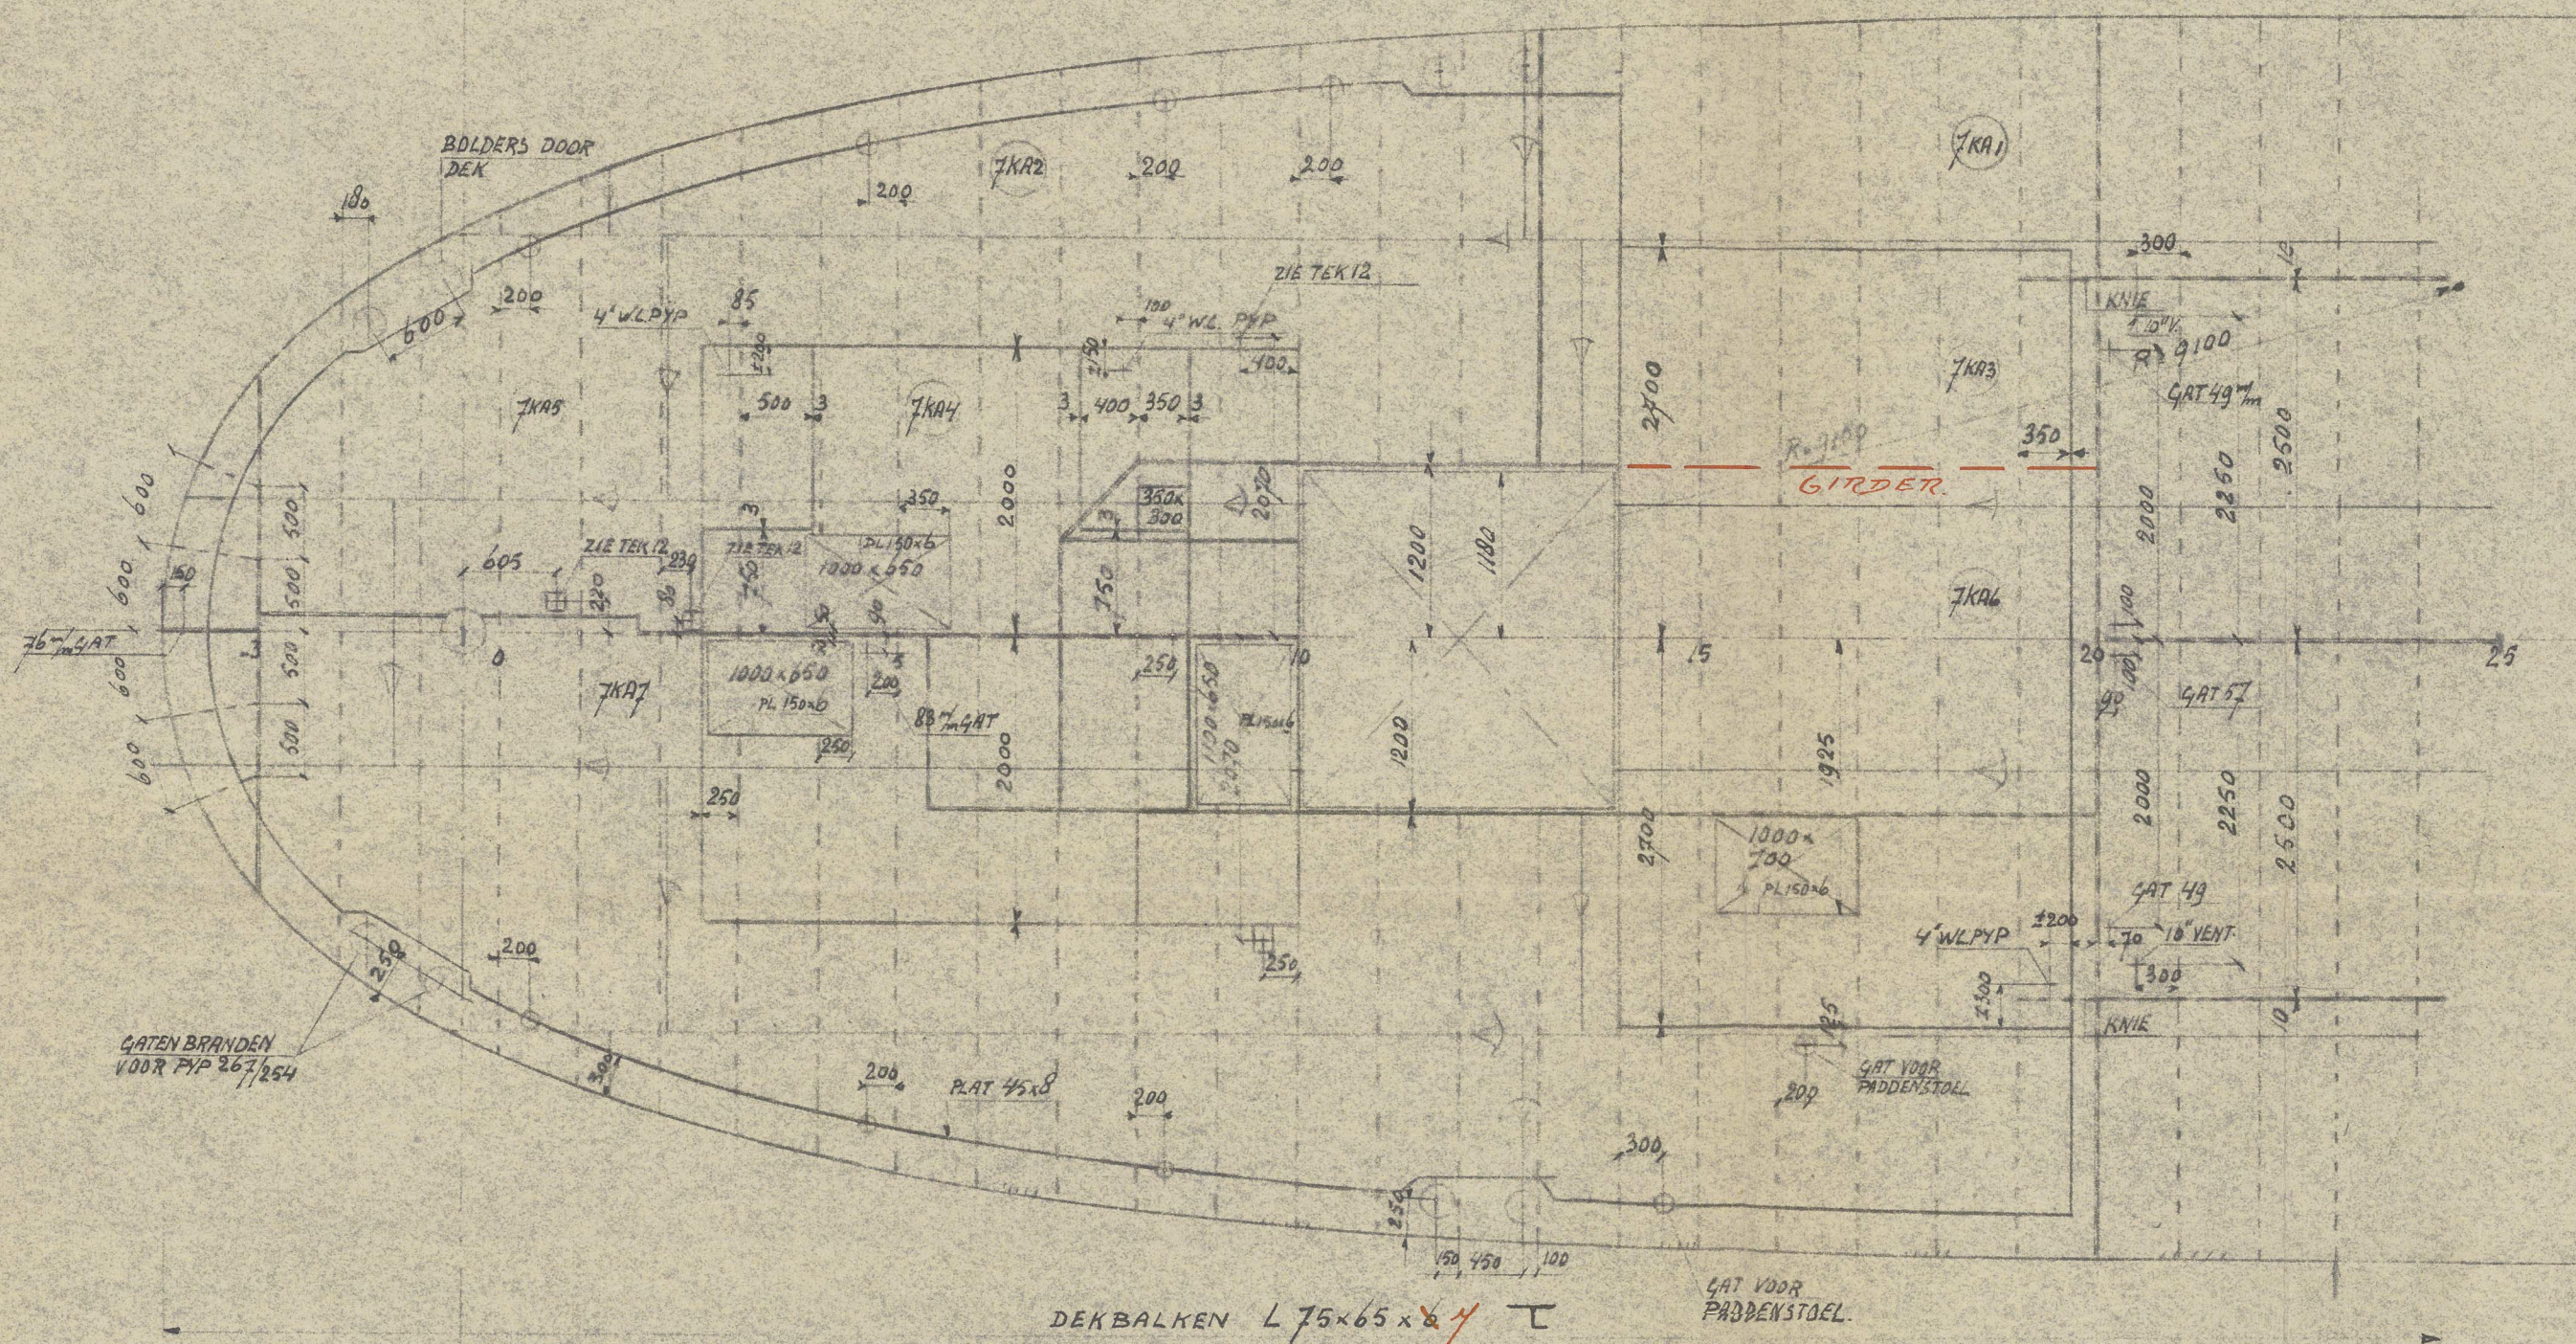
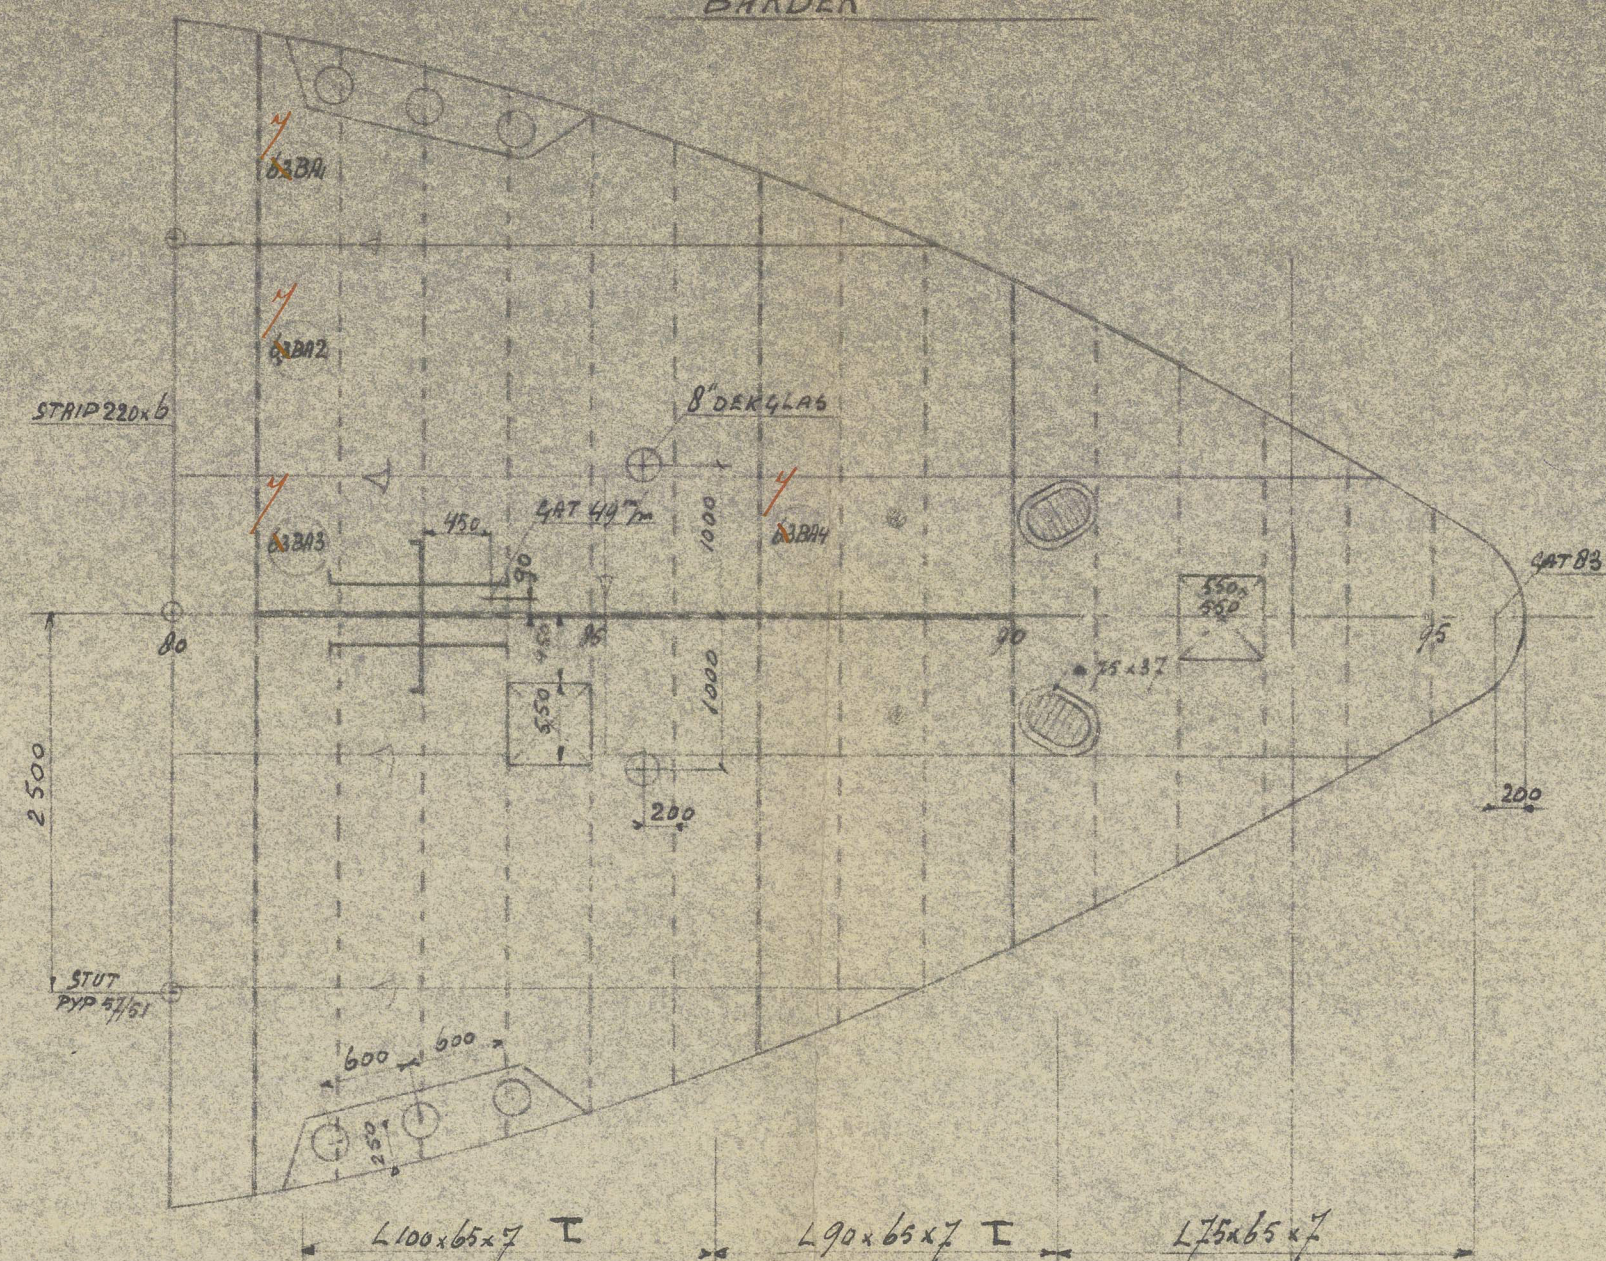


BAKDEK

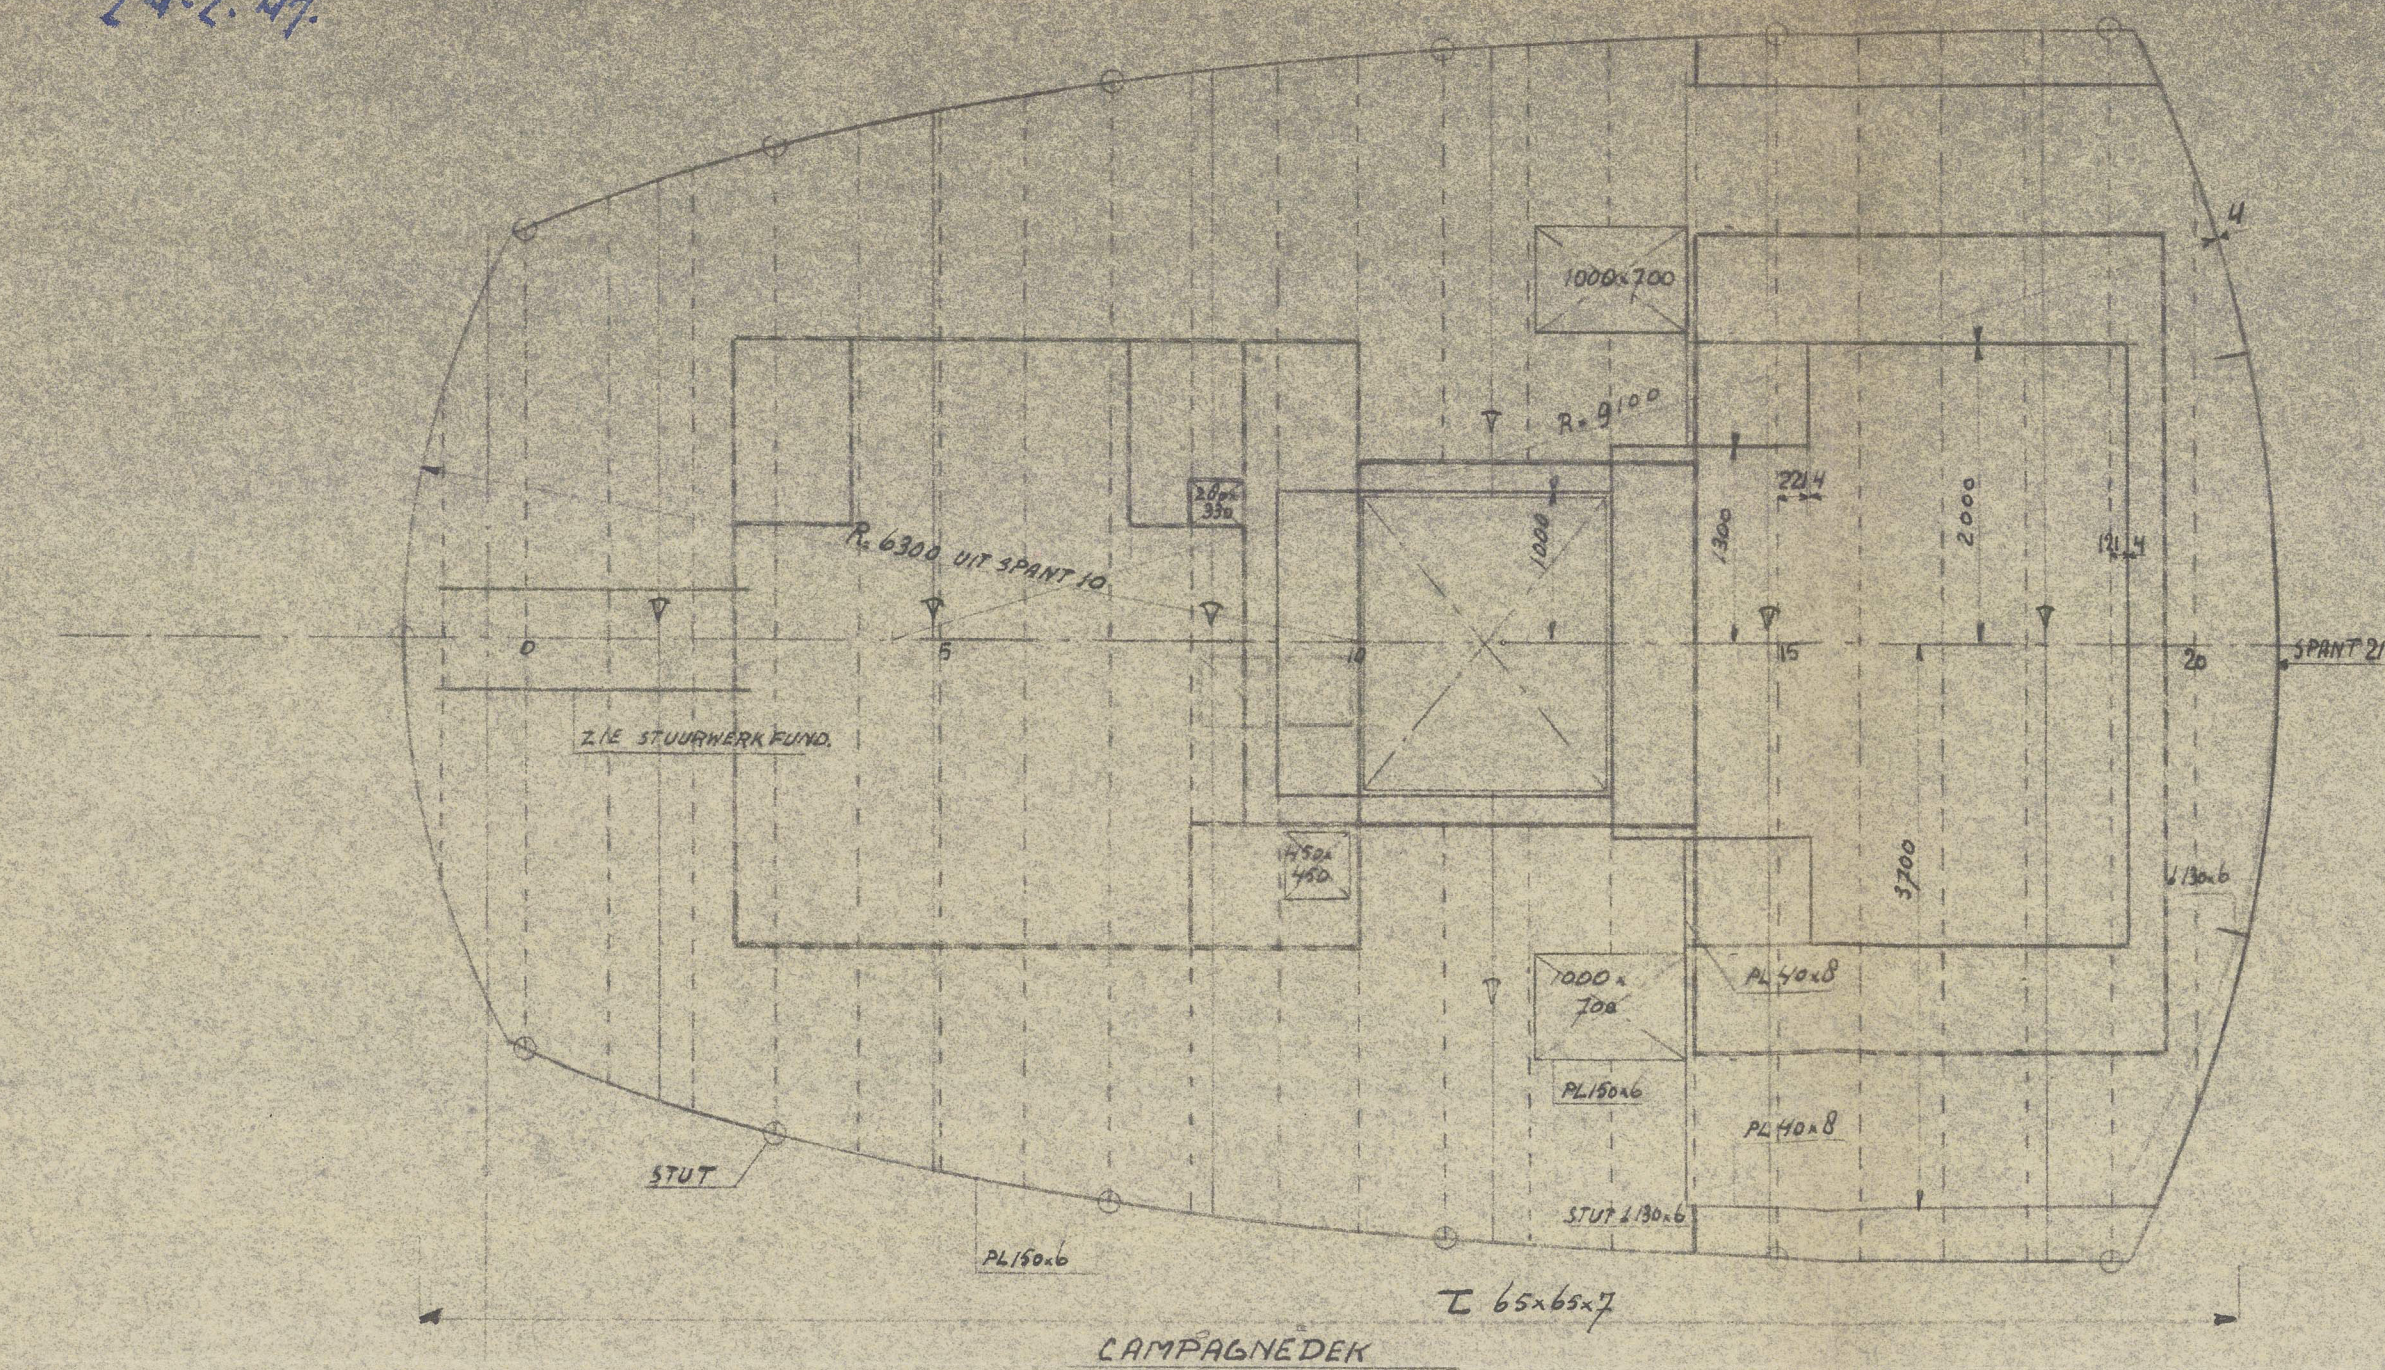

24.2.47.

2:50  
X Le Long 23/1/48  
12/2/48


MOTORCOASTER 835 ton d.w.

CONSTRUCTIEPLAN III (DEKKEN)

N.V. ZAAANLANDSCHE  
SCHEEPSB.MIJ. - ZAAANDAM

448-7  
Lloyd's Register  
Foundation



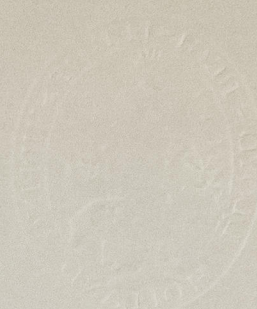

RECORDS DEPT.  
LONDON

14

"PRINSENGRACHT" ★

ZAANLANDSCHE SCHEEPS.

YARD NO. 448 & 451

DECKS



© 2021

Lloyd's Register  
Foundation



LONDON

14

"PRINSENGRACHT" ★

ZAANLANDSCHE SCHEEPS.

YARD NO. 448. & 451

DECKS

ZAANLANDSCHE  
SCHEEPS  
YARD  
DECKS



© 2021

Lloyd's Register  
Foundation