

# MIDSHIP | SECTION.

N<sup>o</sup> 313.

SCALE  $\frac{1}{2}$ " = 1 FOOT

DIMENSIONS:- 123'-4" BP x 22'-9" EX. x 13'-1" MLO

CLASSED 100A.1.

STEEL

STEAM TRAWLER.

## LLOYDS NUMBERS.

$$\underline{\underline{L}} = 123.33 \checkmark$$
$$\underline{B+O} = 35.71 \checkmark$$
$$\underline{d} = 11.75 \checkmark$$
$$\underline{L \times (B+D) = 4404.11 \checkmark}$$
$$\frac{0.17}{10} = 9.42 \text{ V}$$

NUMERAL FOR RUDDER = 54.02. ✓

— ANCHORS & CHAINS. —

1. STOCKLESS ANCHOR 7 CWT.

1. 4 11  $\frac{1}{b_4}$  4


L. ROGERS      2<sup>3</sup>/<sub>4</sub> - Ex. Stock

105 FTHMS. 1 1/16" STUD LINK CABLE

60 6 HAWSER

60 " 4½ WARP.

27.4.14

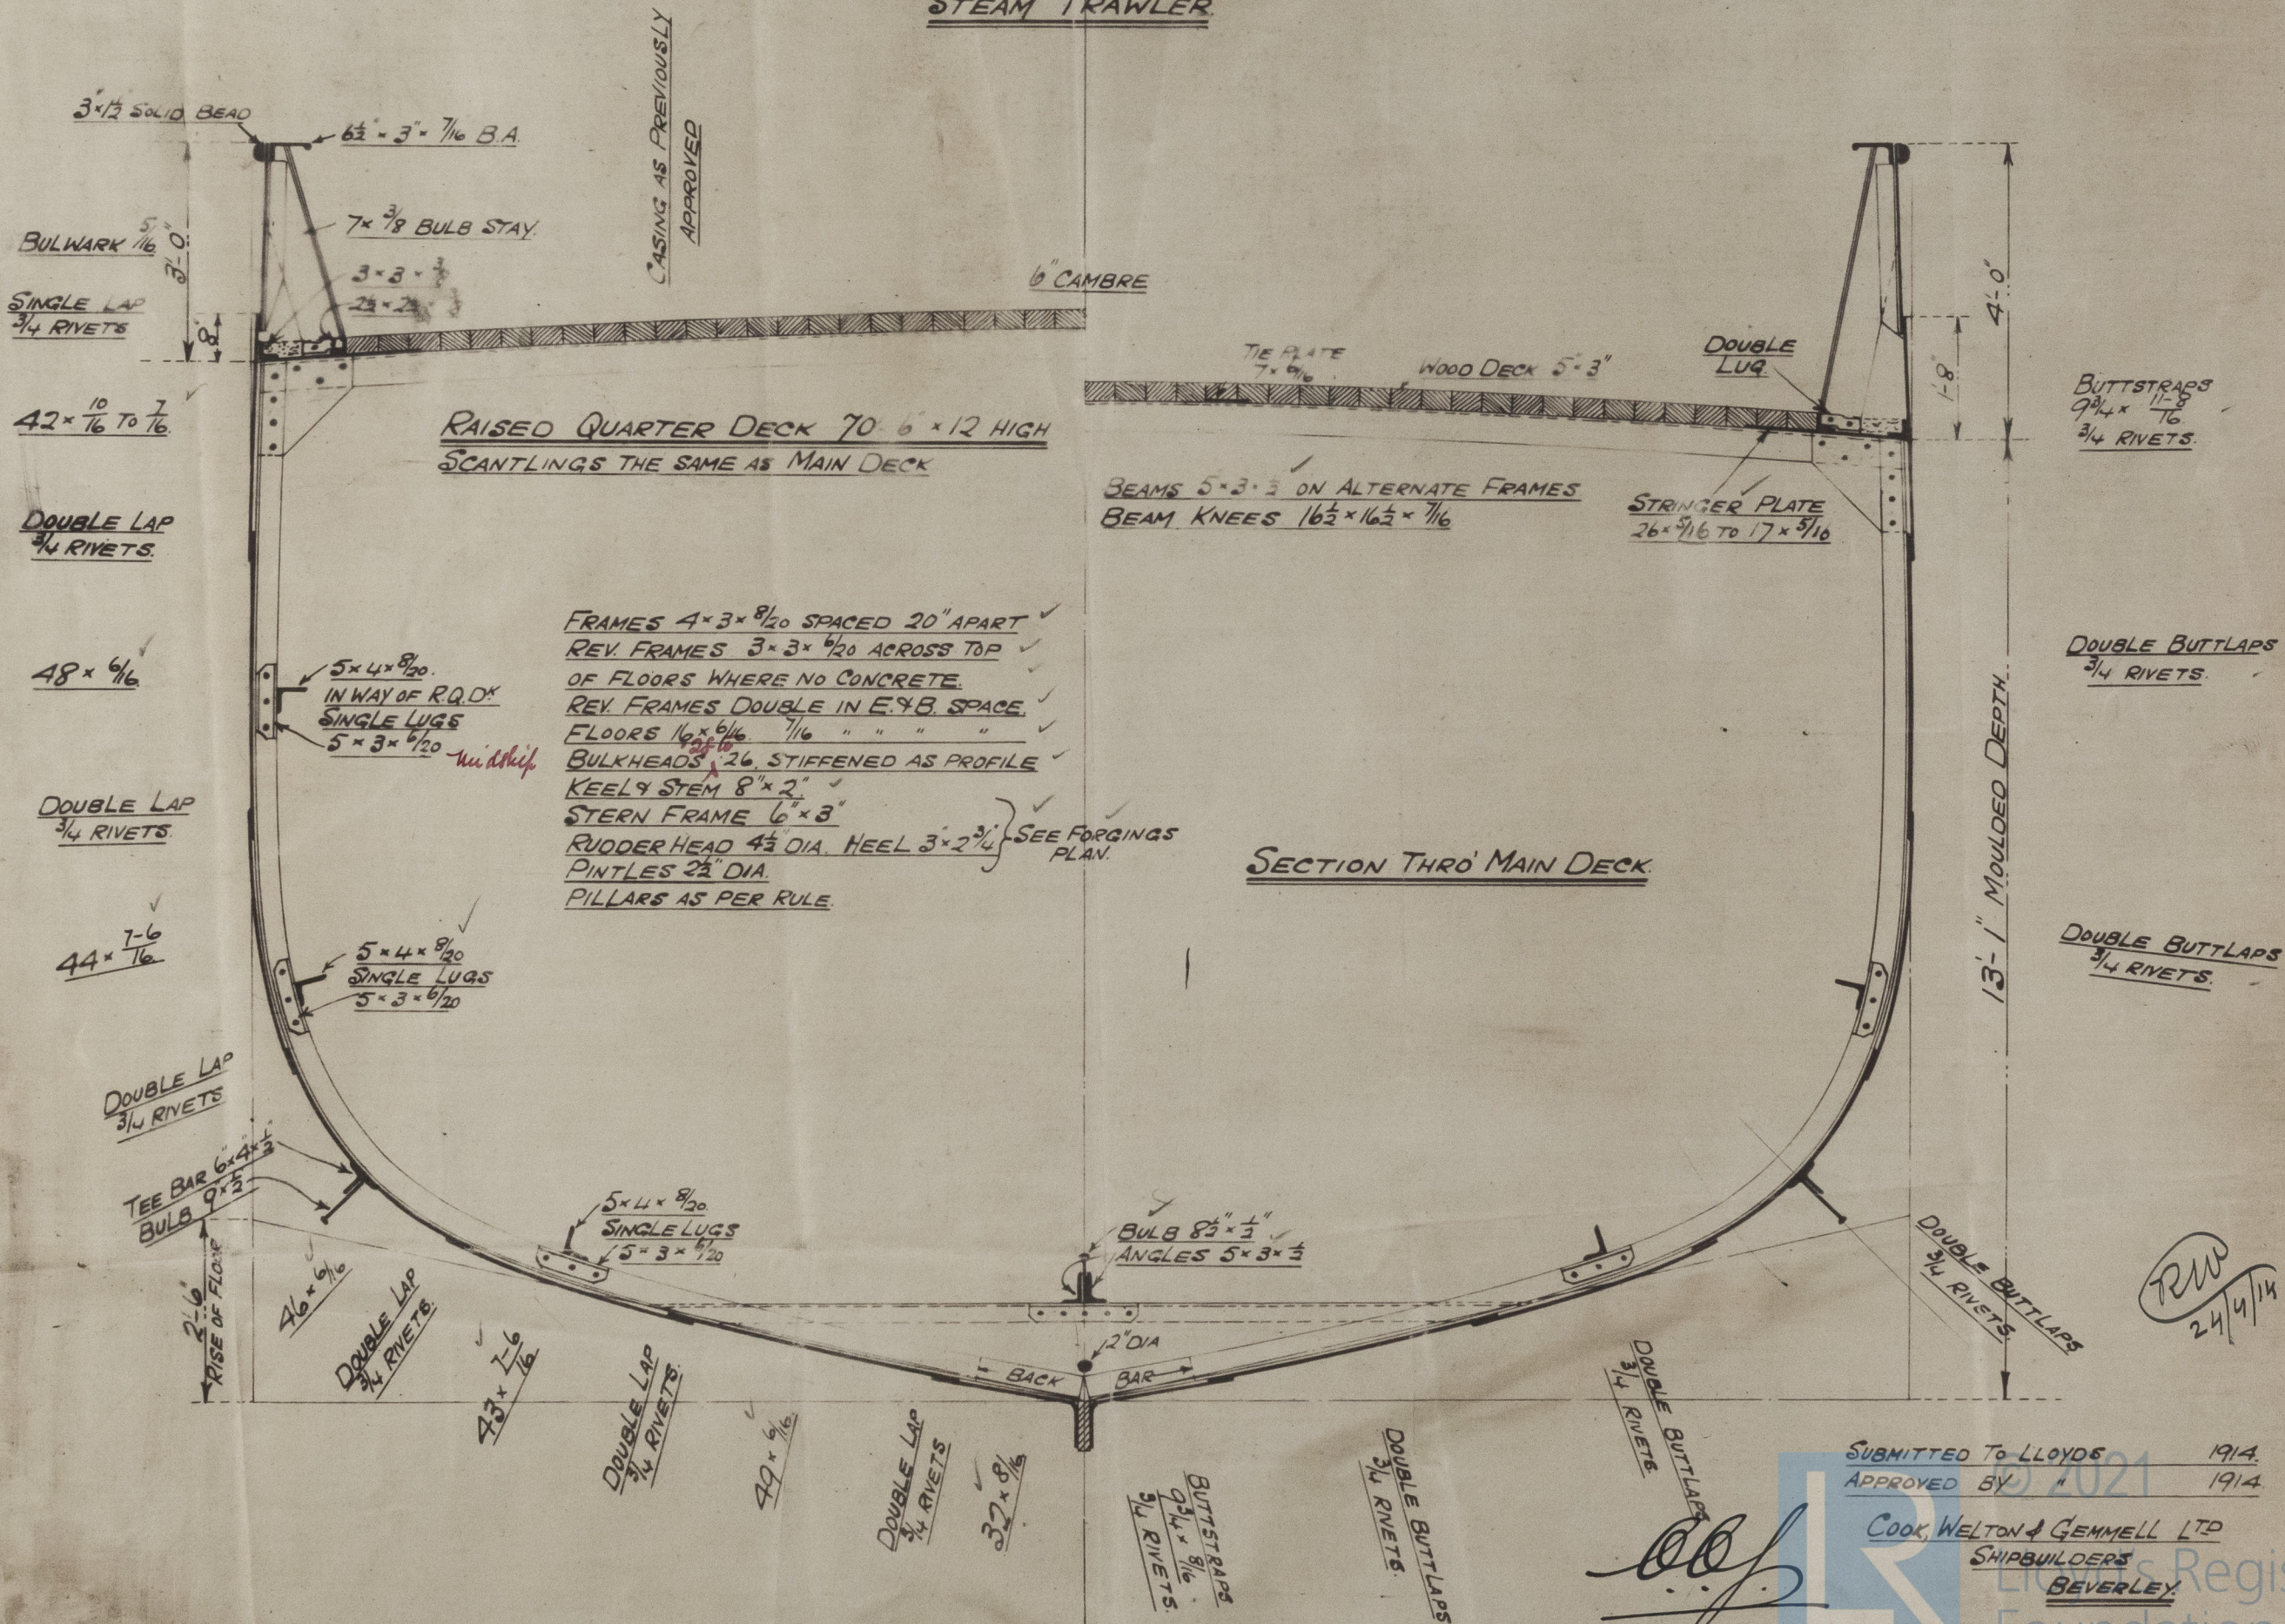

SUBMITTED TO LLOYDS 1914.

APPROVED BY " 1914

COOK, WELTON & GEMMELL LTD

SHIPBUILDERS

BEVERLEY.


Foundation

012358-012364-0001





Cook Melton & Gemmels  
No 313

Midship Section.

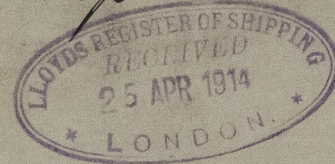

S.S. Forward Ho "Hull Rpt. No.  
28594

Row Luthemell

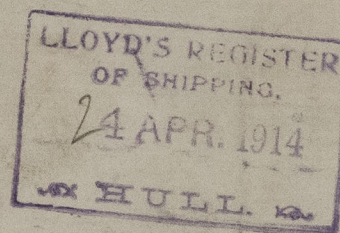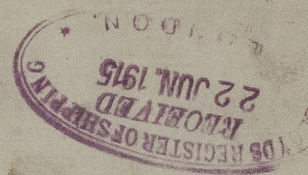

012358-012364-0001



© 2021

Lloyd's Register  
Foundation