





# RUDDER.

SCALE  $\frac{3}{4}'' = 1 \text{ FOOT}$

HOLES PITCHED 5<sup>1</sup>/<sub>2</sub>" APART  
<sup>3</sup>/<sub>16</sub>" HOLES FOR <sup>3</sup>/<sub>4</sub>" RIVETS  
 NUMERAL FOR RUDDER <sup>60</sup>~~50~~%. SPEED <sup>10</sup>/<sub>12</sub> KNOTS.  
 SIDE PLATES - 26 ✓

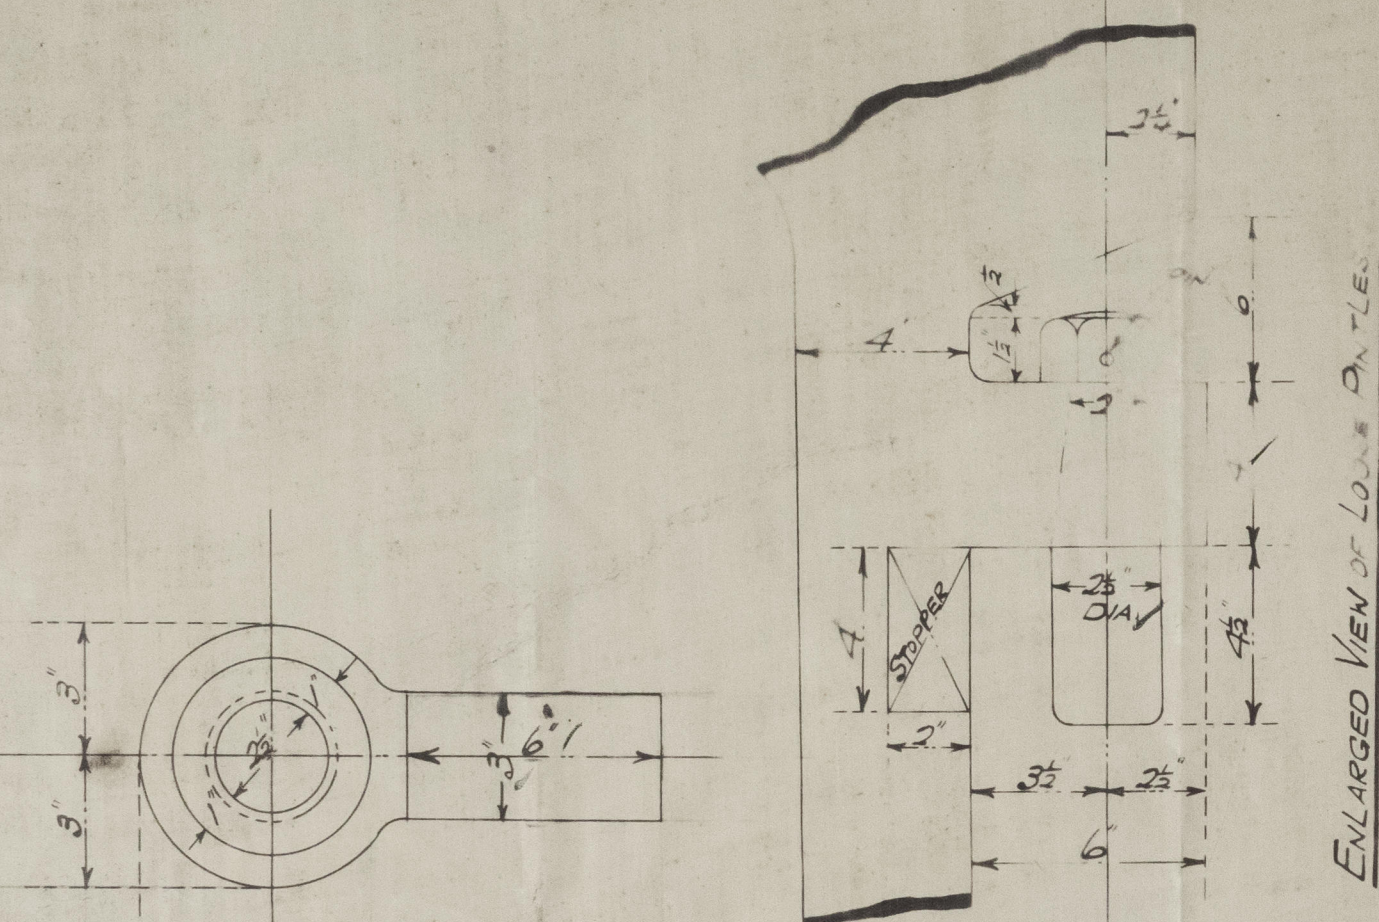

NOTE:- CARE TO BE TAKEN THAT CENTRES OF PINTLES IN RUDDER ARE IN LINE WITH CENTRES OF HOLES IN GUDGEONS OF STERN POST

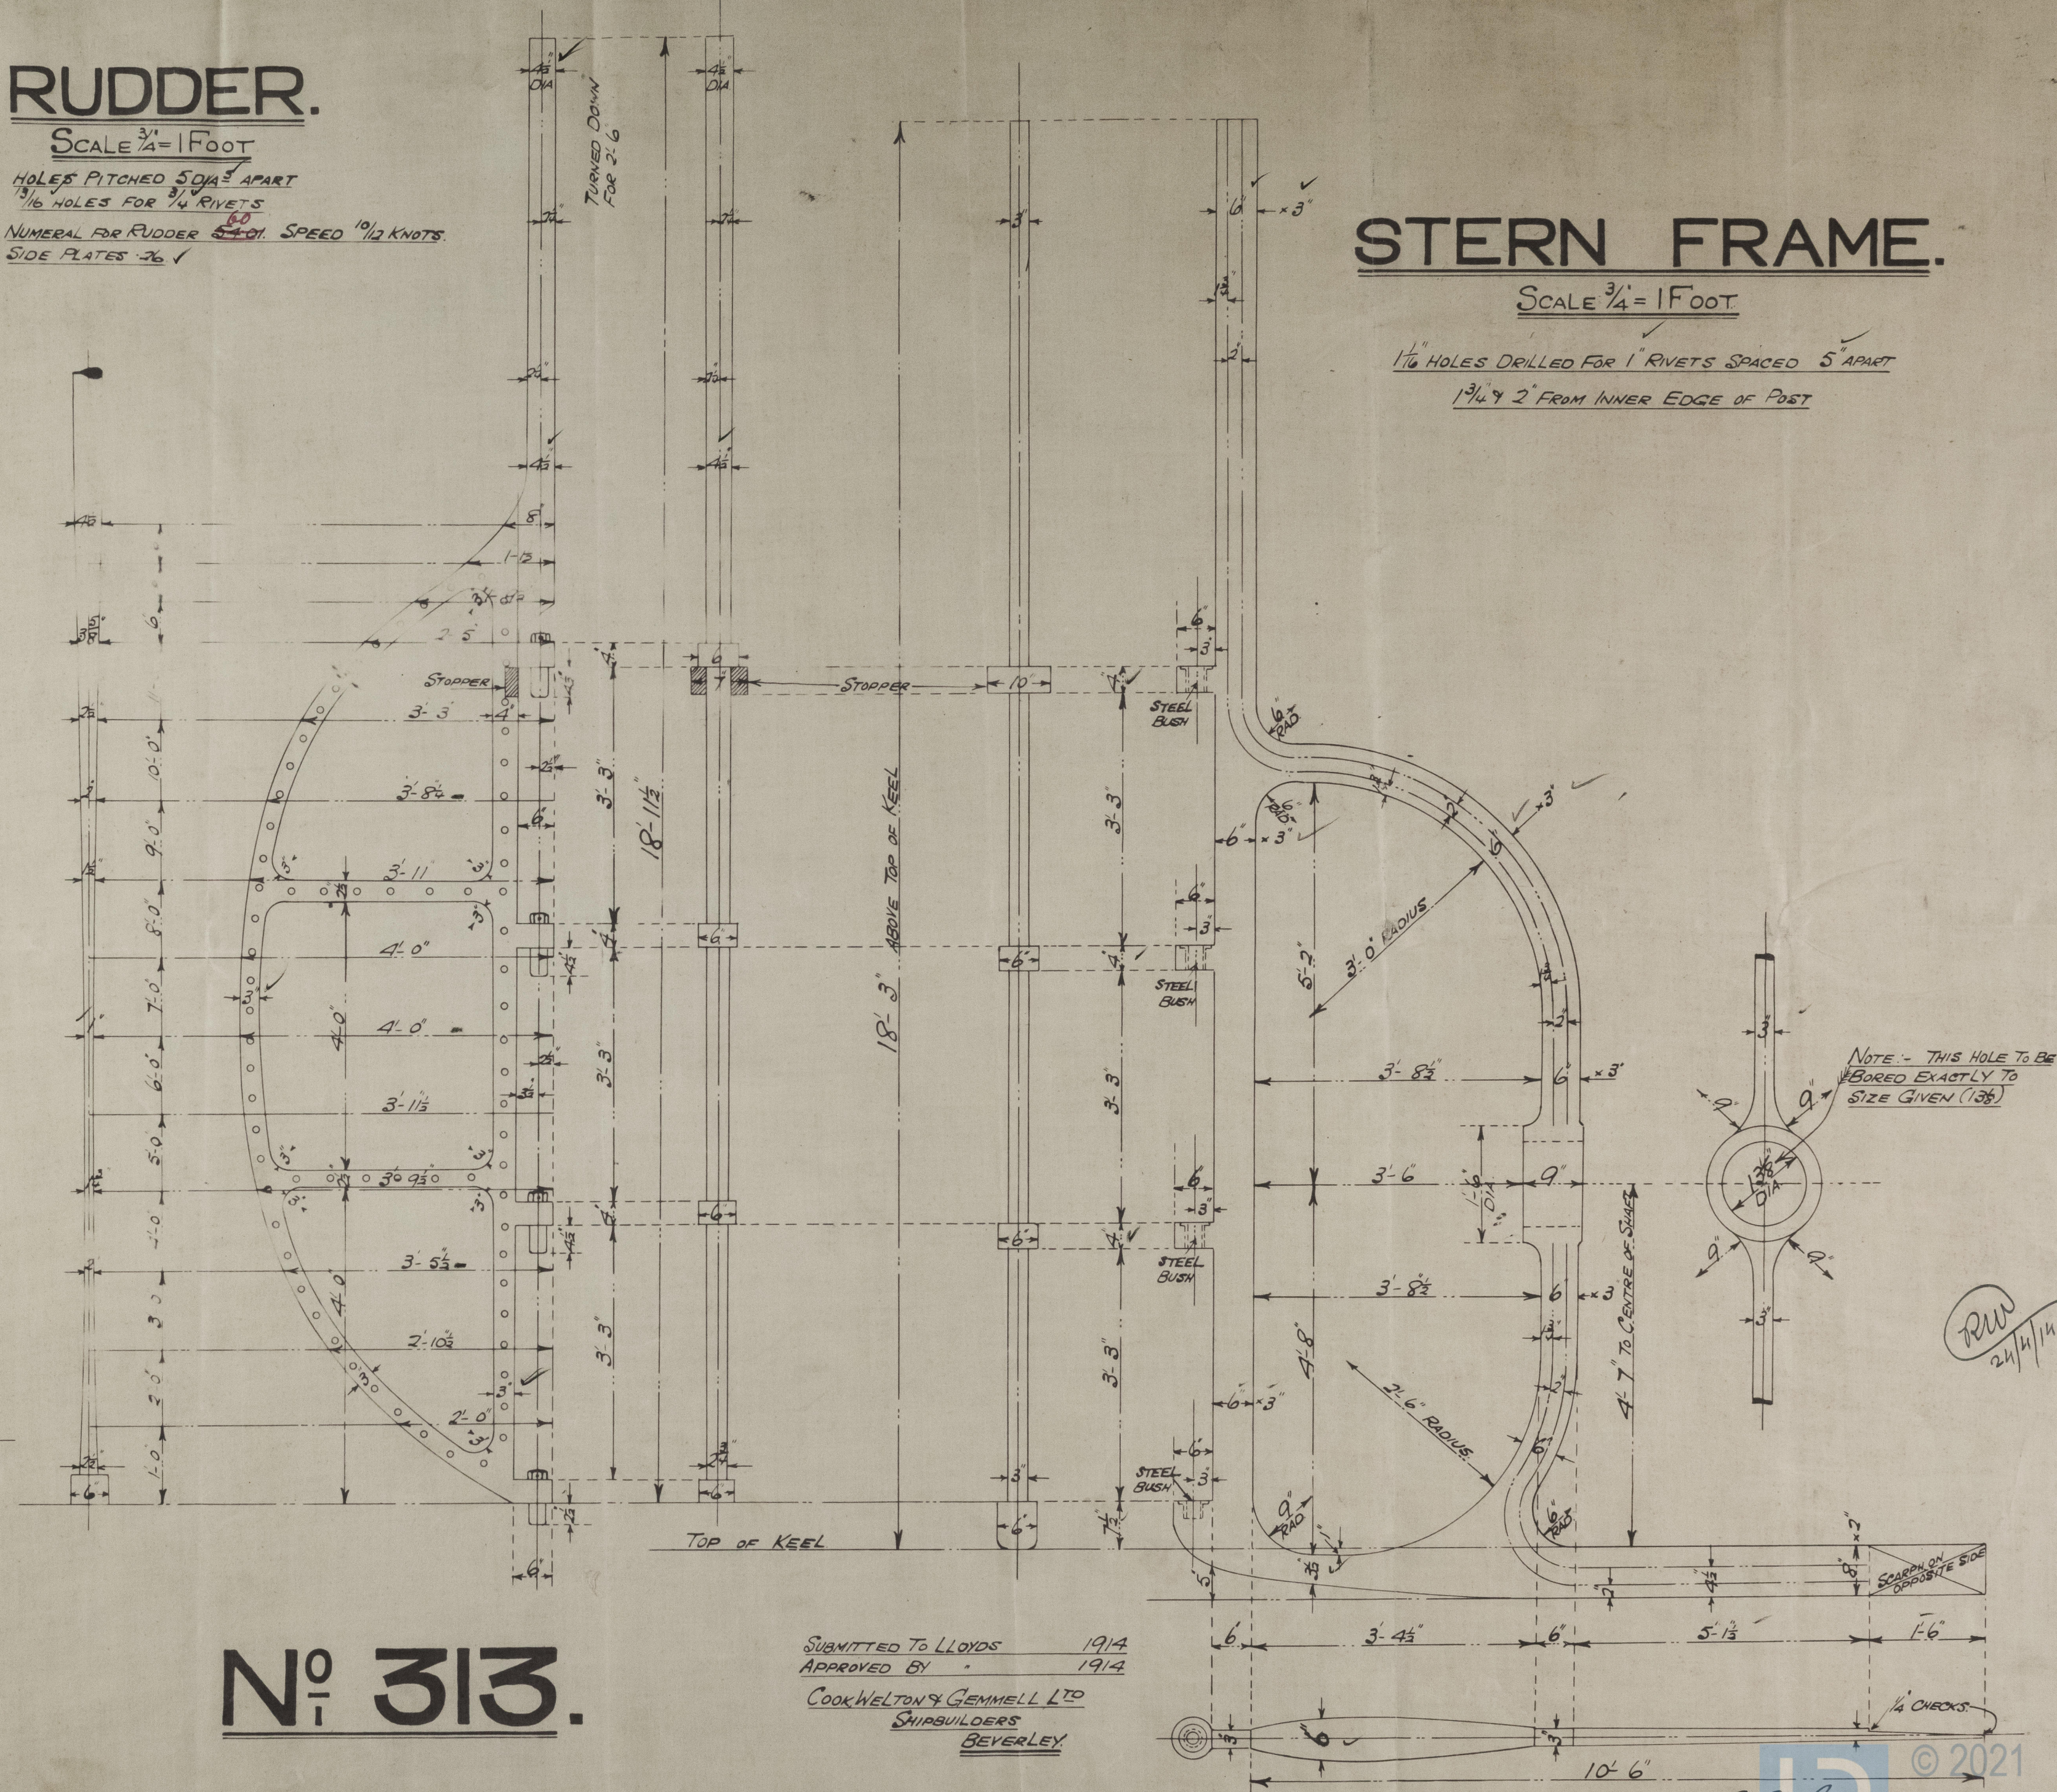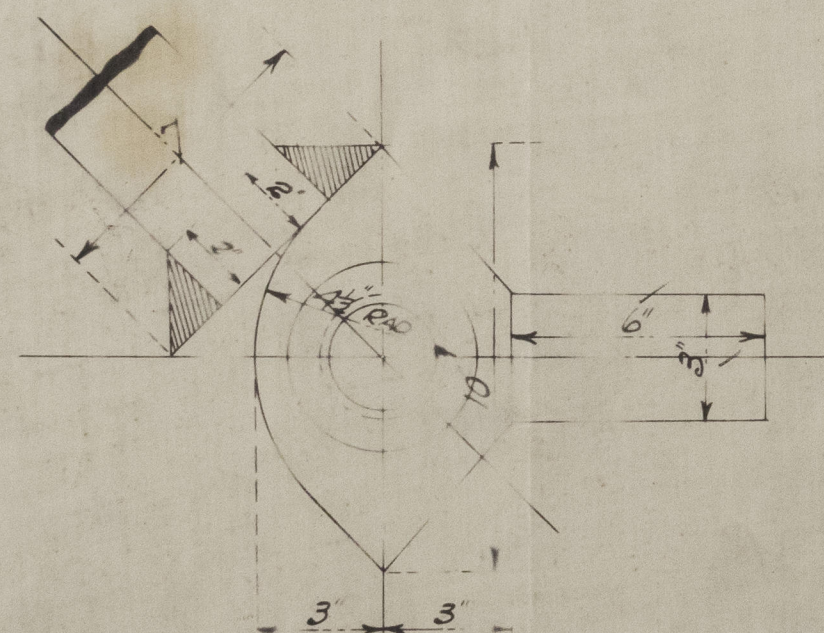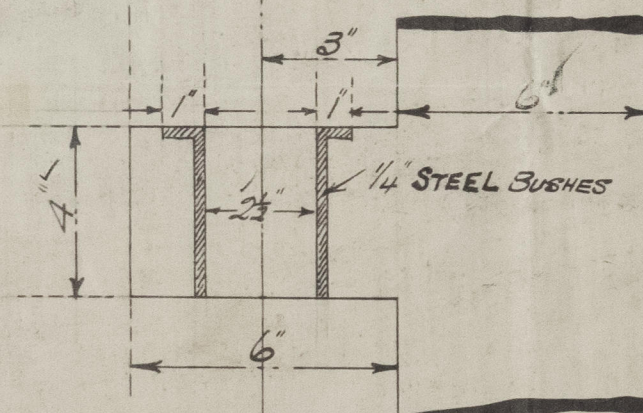




Cook, Welton & Gemmels  
No 313  
Stern Frame & Rudder




S.S. "Forward Ho" Hull Rpt No  
28594.

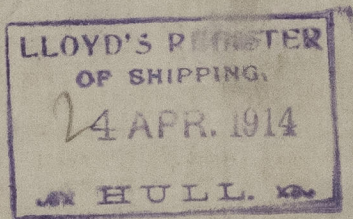

012358-012364-0002

0002

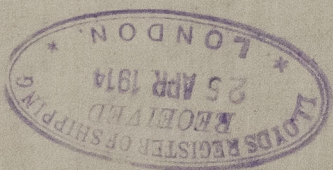

© 2021  
Lloyd's Register  
Foundation