


27.4.14

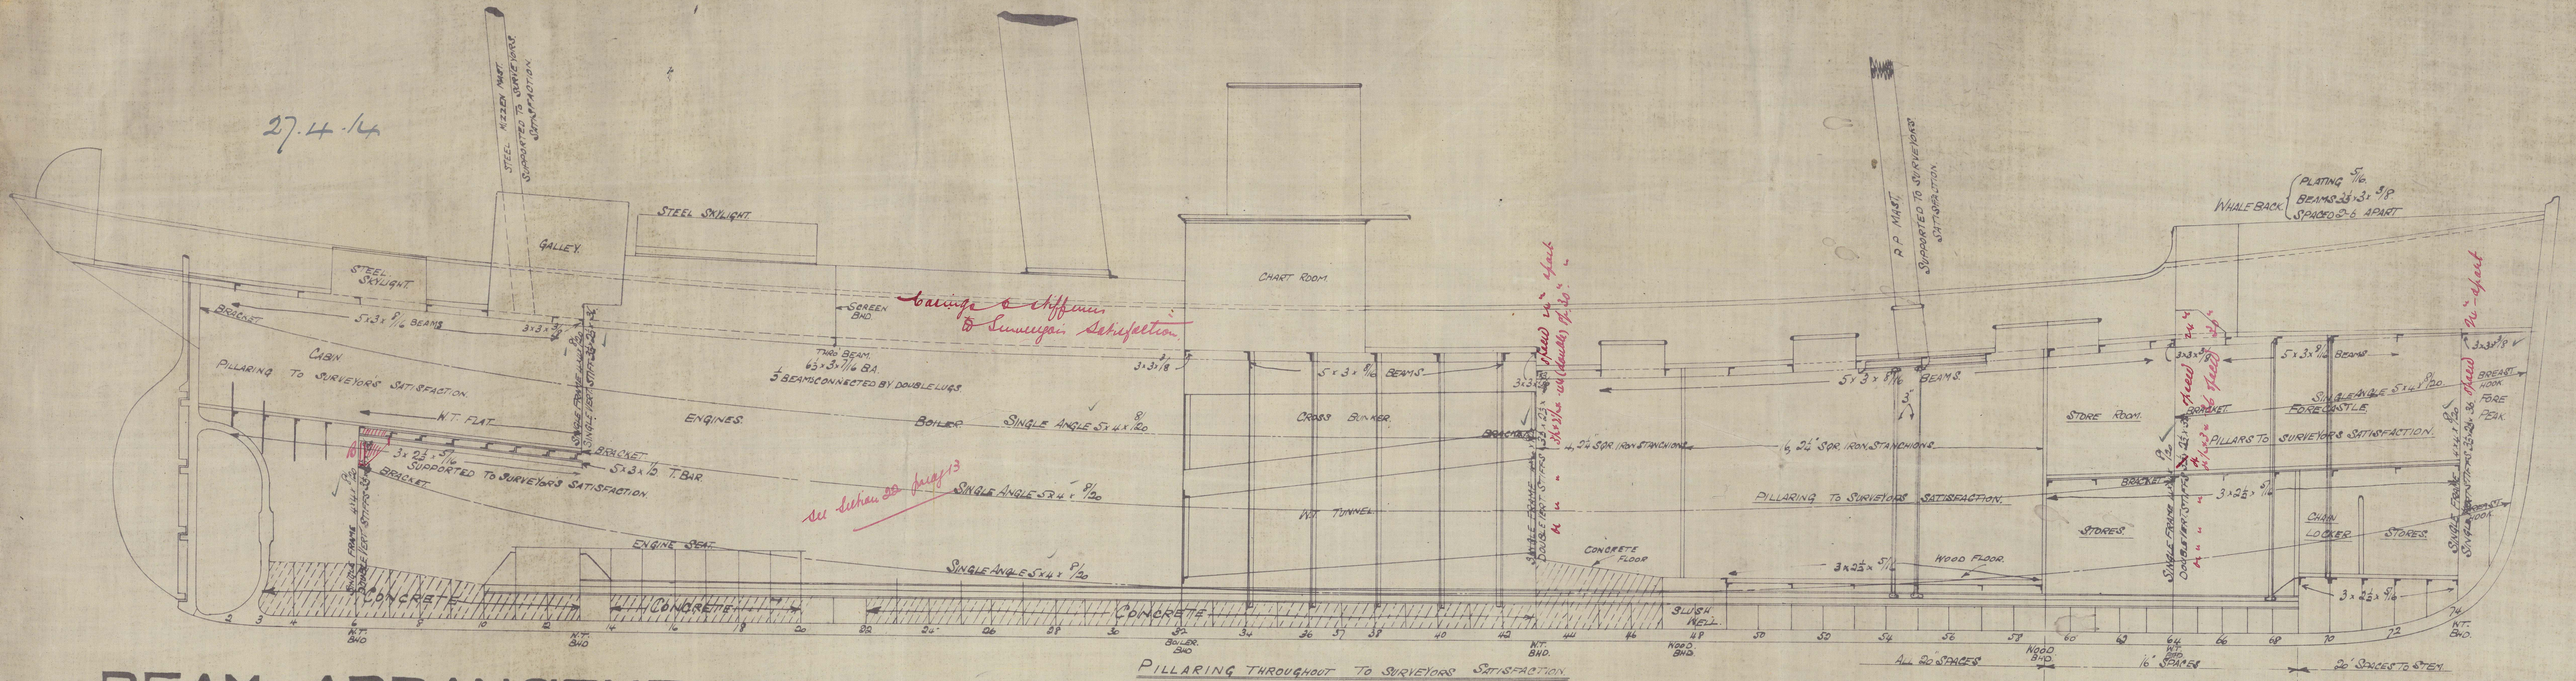

BEAM ARRANGEMENT.

PILLARING THROUGHOUT TO SURVEYOR'S SATISFACTION.


SCALE 1/4" = 1 FOOT.

DIMENSIONS: 123'-4" BP x 22'-9" EX x 13'-1" MID.

N° 313


COOK, NELTON, & GEMMELL, LTD.
SHIPBUILDERS

DATE SUBMITTED 1914
APPROVED

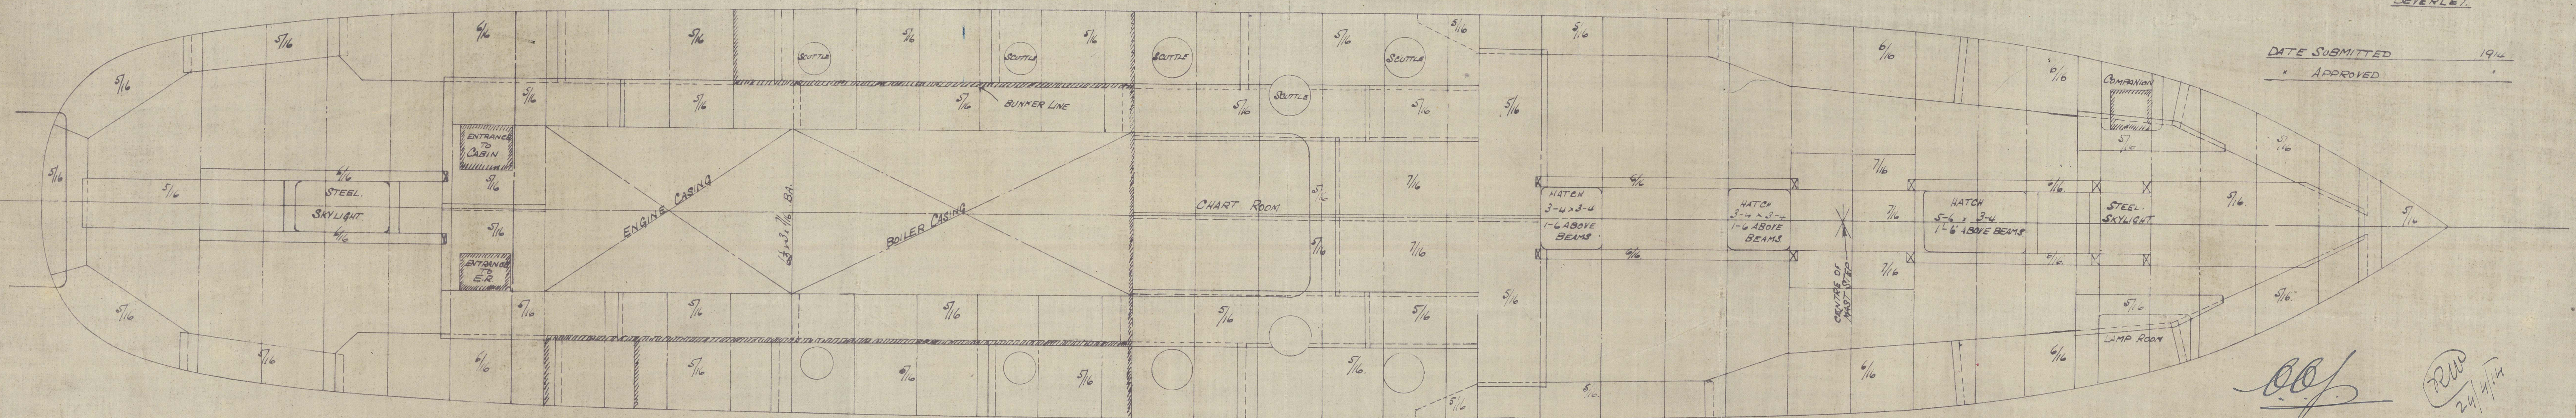

27.4.14

look, Melton & Gemmels
No 313
Profile & Deck.

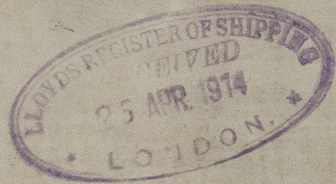

S.S. "Forward Ho." Hull Rpt No.
28594
Row "Sutcliffe"

28) 30
S.S.
No 313



012358-012304-0003



© 2021

Lloyd's Register
Foundation