


POOP DECK

TOP OF TRUNK

FORECASTLE DECK

MAIN DECK

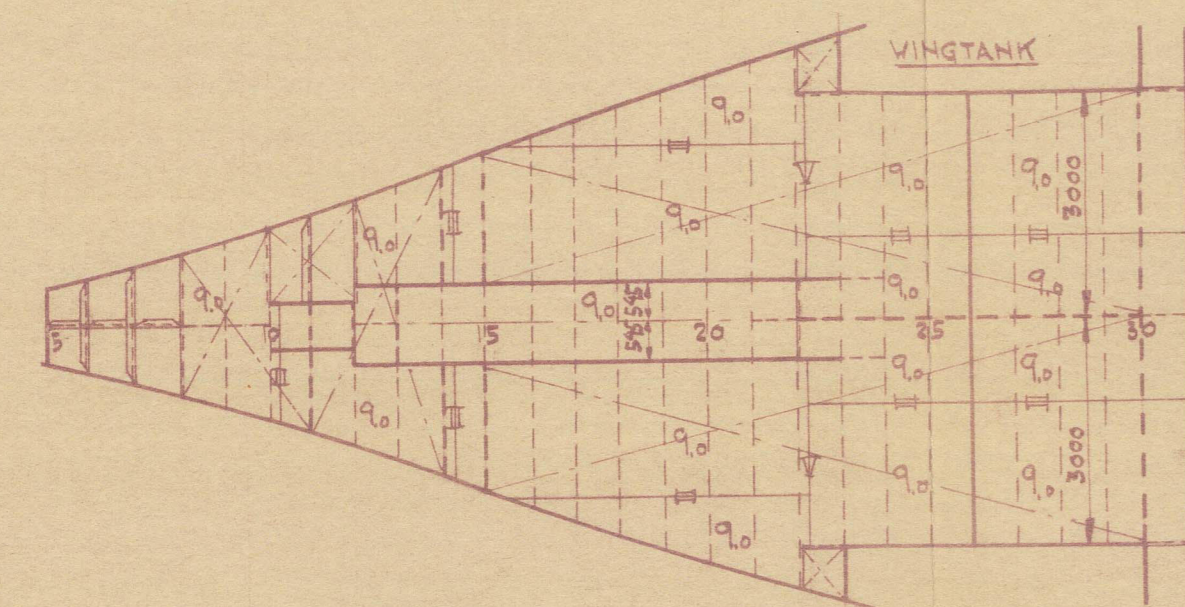

TANKTOP

DIMENSIONS

LENGTH BETW. P.P.	204'-0"	62.18 M
BREATH	34'-0"	10.36 M
DEPTH MOULDED TO MAINDECK	14'-10"	4.52 M
HEIGHT OF POOP	7'-3"	2.2 M
HEIGHT OF FORECASTLE	6'-10"	2.1 M

APPROVED BY LLOYD'S REGISTER 2-10-50

AB NORRKÖPINGS VARV & VERKSTAD
NORRKÖPING

135-2
M/ 135-138, 139, 140

LONGITUDINAL SECTION


RIT. AV	GR. AV	SKALA	1:100
KOP. AV	G.D.K. AV	DATUM	19-9-50
LITT.	RIT. No	135-11	

012370-012376-0026

'IRISH' ★

Longitudinal Section. (as built).

RECORDS DEPT.
LONDON

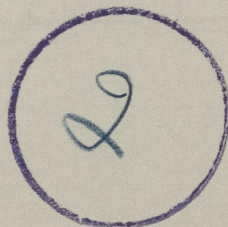

© 2021

Lloyd's Register
Foundation

012370-012376-0026