

No. 1418. FRAMING PROFILE.

DIMENSIONS:- 460'-0" B.P. x 59'-0" x 34'-10" M.L.P.

SCALE:- 1/8" = 1 FOOT.


No. 1373 & 83 TO CLASS LLOYDS 100 A1.*
CARRYING PETROLEUM IN BULK.

No. 1380, 81 & 92 TO CLASS N.V.I.A.I. (BULK OIL CARRIER).

LONGITUDINAL FRAMING AT BOTTOM & AT DECK.

ALL SECTIONS ARE TO NEW BRITISH STANDARD.

BULB PLATES ARE Q.B.S.

 

As fitted
12/12/50
10.12.48
LLOYD'S REGISTER
MARITIME & OIL
CLASSIFICATION

42396

3 ✓

HARLAND & WOLFF LTD.
BELFAST

No. 1418

TITLE. Examining People

DATE APPROVED 10/12/48

As fitted. verified 12/12/50

Belt. Rpt. No. 15109

. hagenfeld




df

X

Belfast Freehold. Report No. F. 133.

RECORDS DEPT.,
LONDON

5

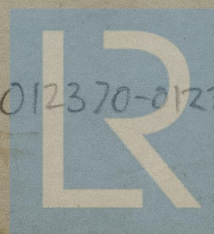

© 2021

012370-012326-0197

Lloyd's Register
Foundation