
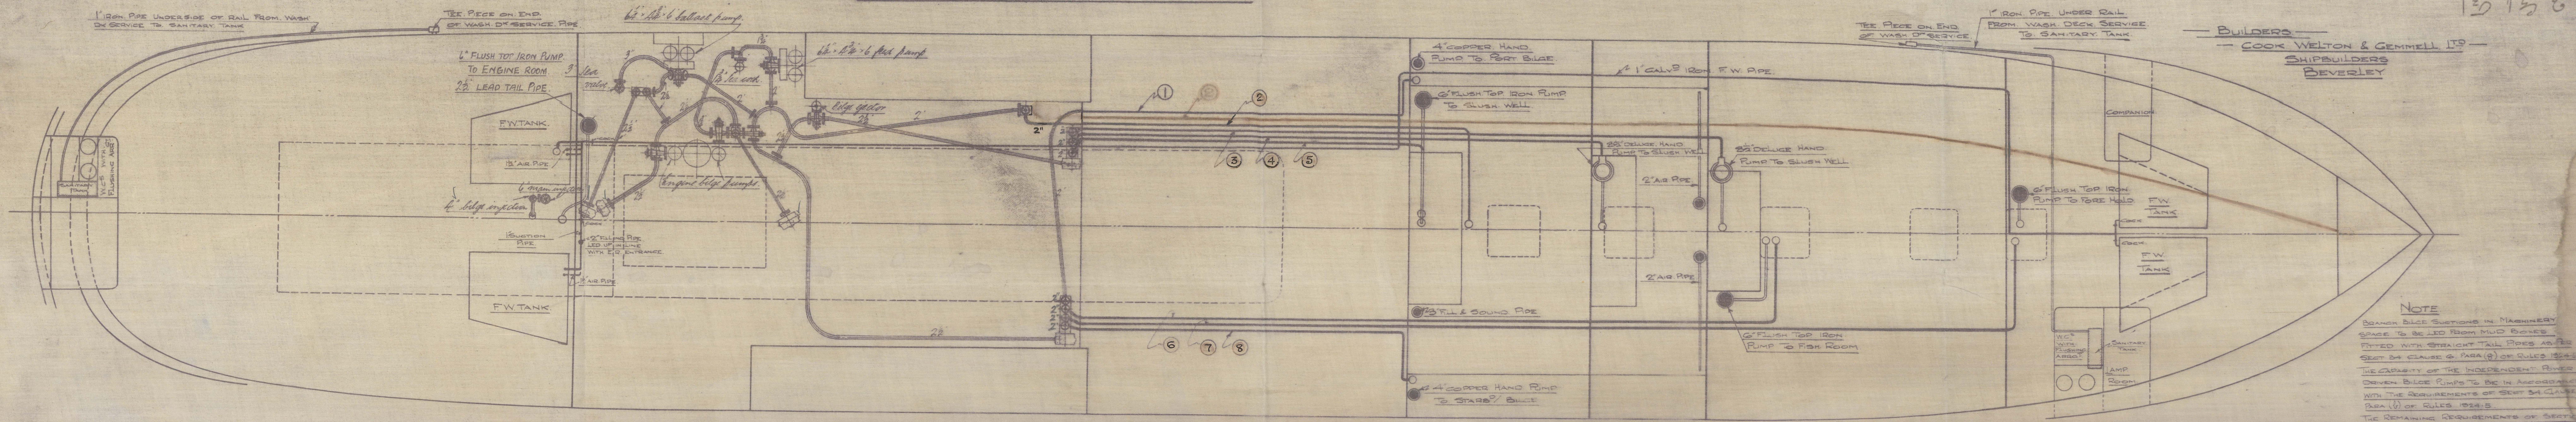


PUMPING PLAN No 476

SCALE 1/4" = 1 FOOT.

DIMENSIONS: 147' 0" BP x 25' 6" MP x 14' 6" MB

7/7/25

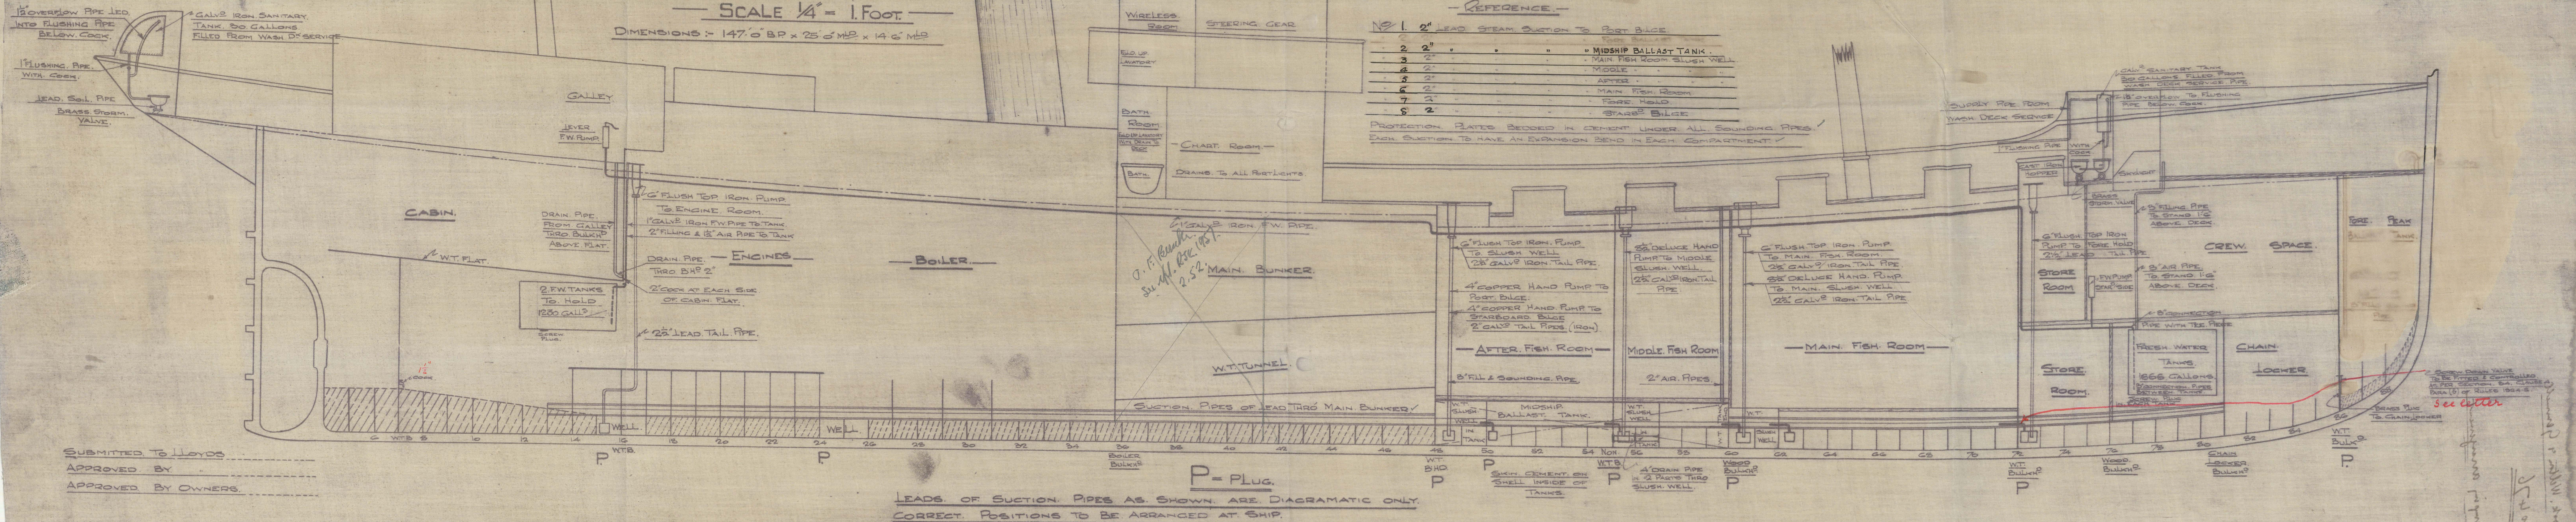

012377-012385-0144

Cook, Wilton & Gemmell

No 476

Pumping arrangement

⁵/₅ Jupiter.

Hull Report No. 36584.



© 2021

Lloyd's Register
Foundation

012377-012385-0144