


NO. 476.

PROFILE & DECKS.

SCALE. $\frac{1}{4}'' = 1 \text{ FOOT}$

DIMENSIONS: 147' 0" B.P. x 25' 0" MLD x 14' 6" MLD.

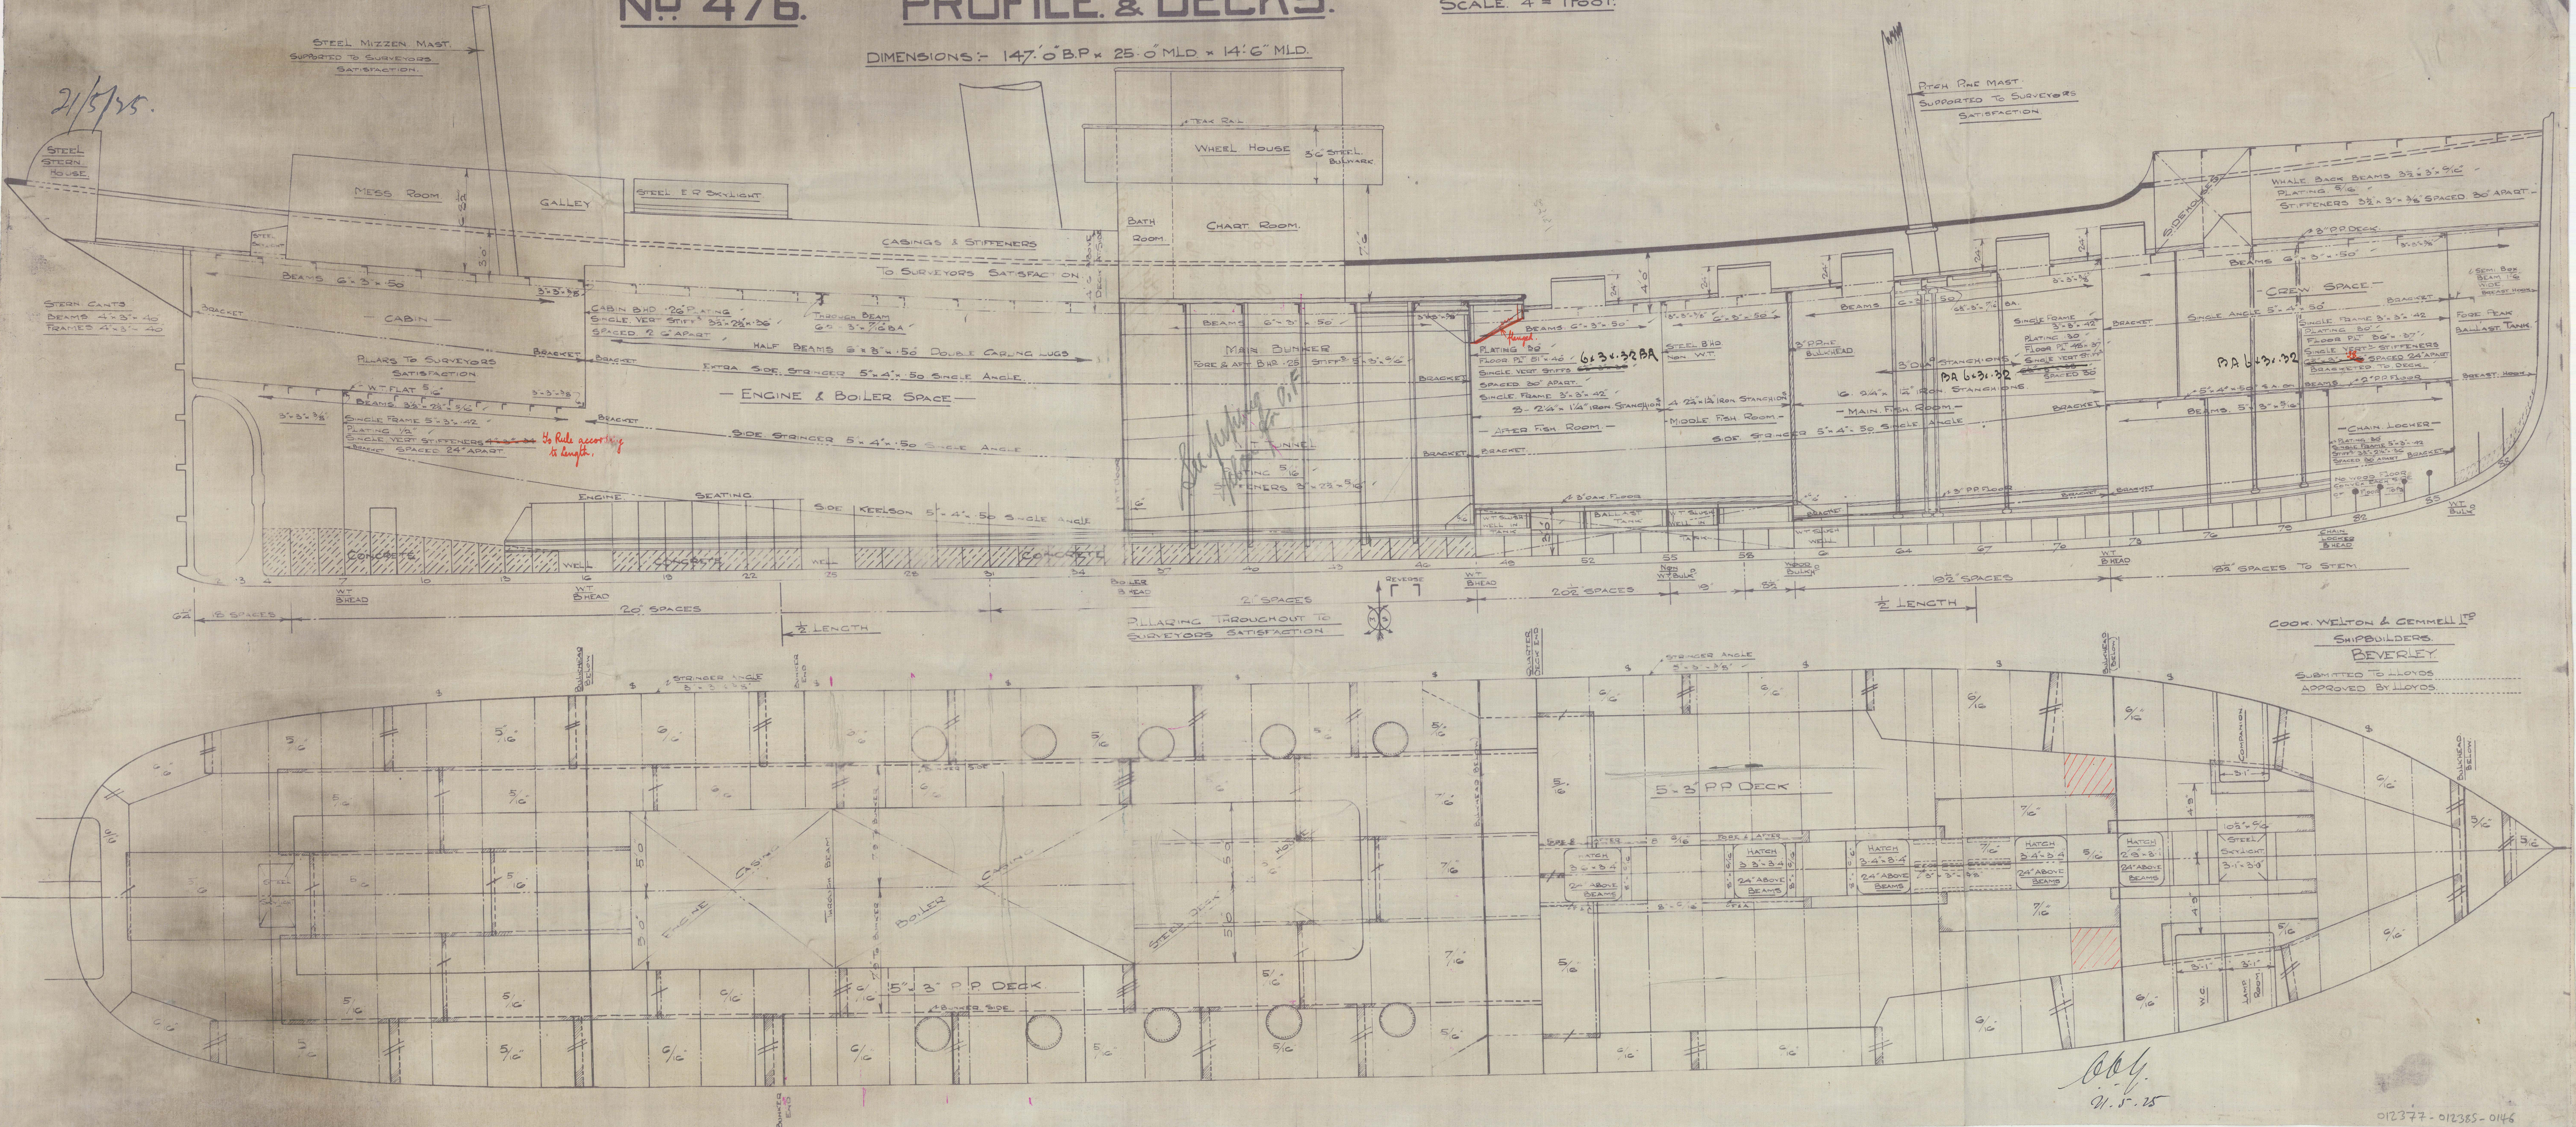

COOK, WELTON & GEMMELL LTD
SHIPBUILDERS.
BEVERLEY.
SUBMITTED TO LLOYD'S
APPROVED BY LLOYD'S.

Ady.
21.5.15

Amended plan of Profile
+ Wecks for Good, Nelson
Symmell's No 446.

⁵/₅ Jupiter ^{NW} GUDMUNDUR
Hull Report No. 36587.
JUNI.



© 2021

Lloyd's Register
Foundation

012377-012385-0146