

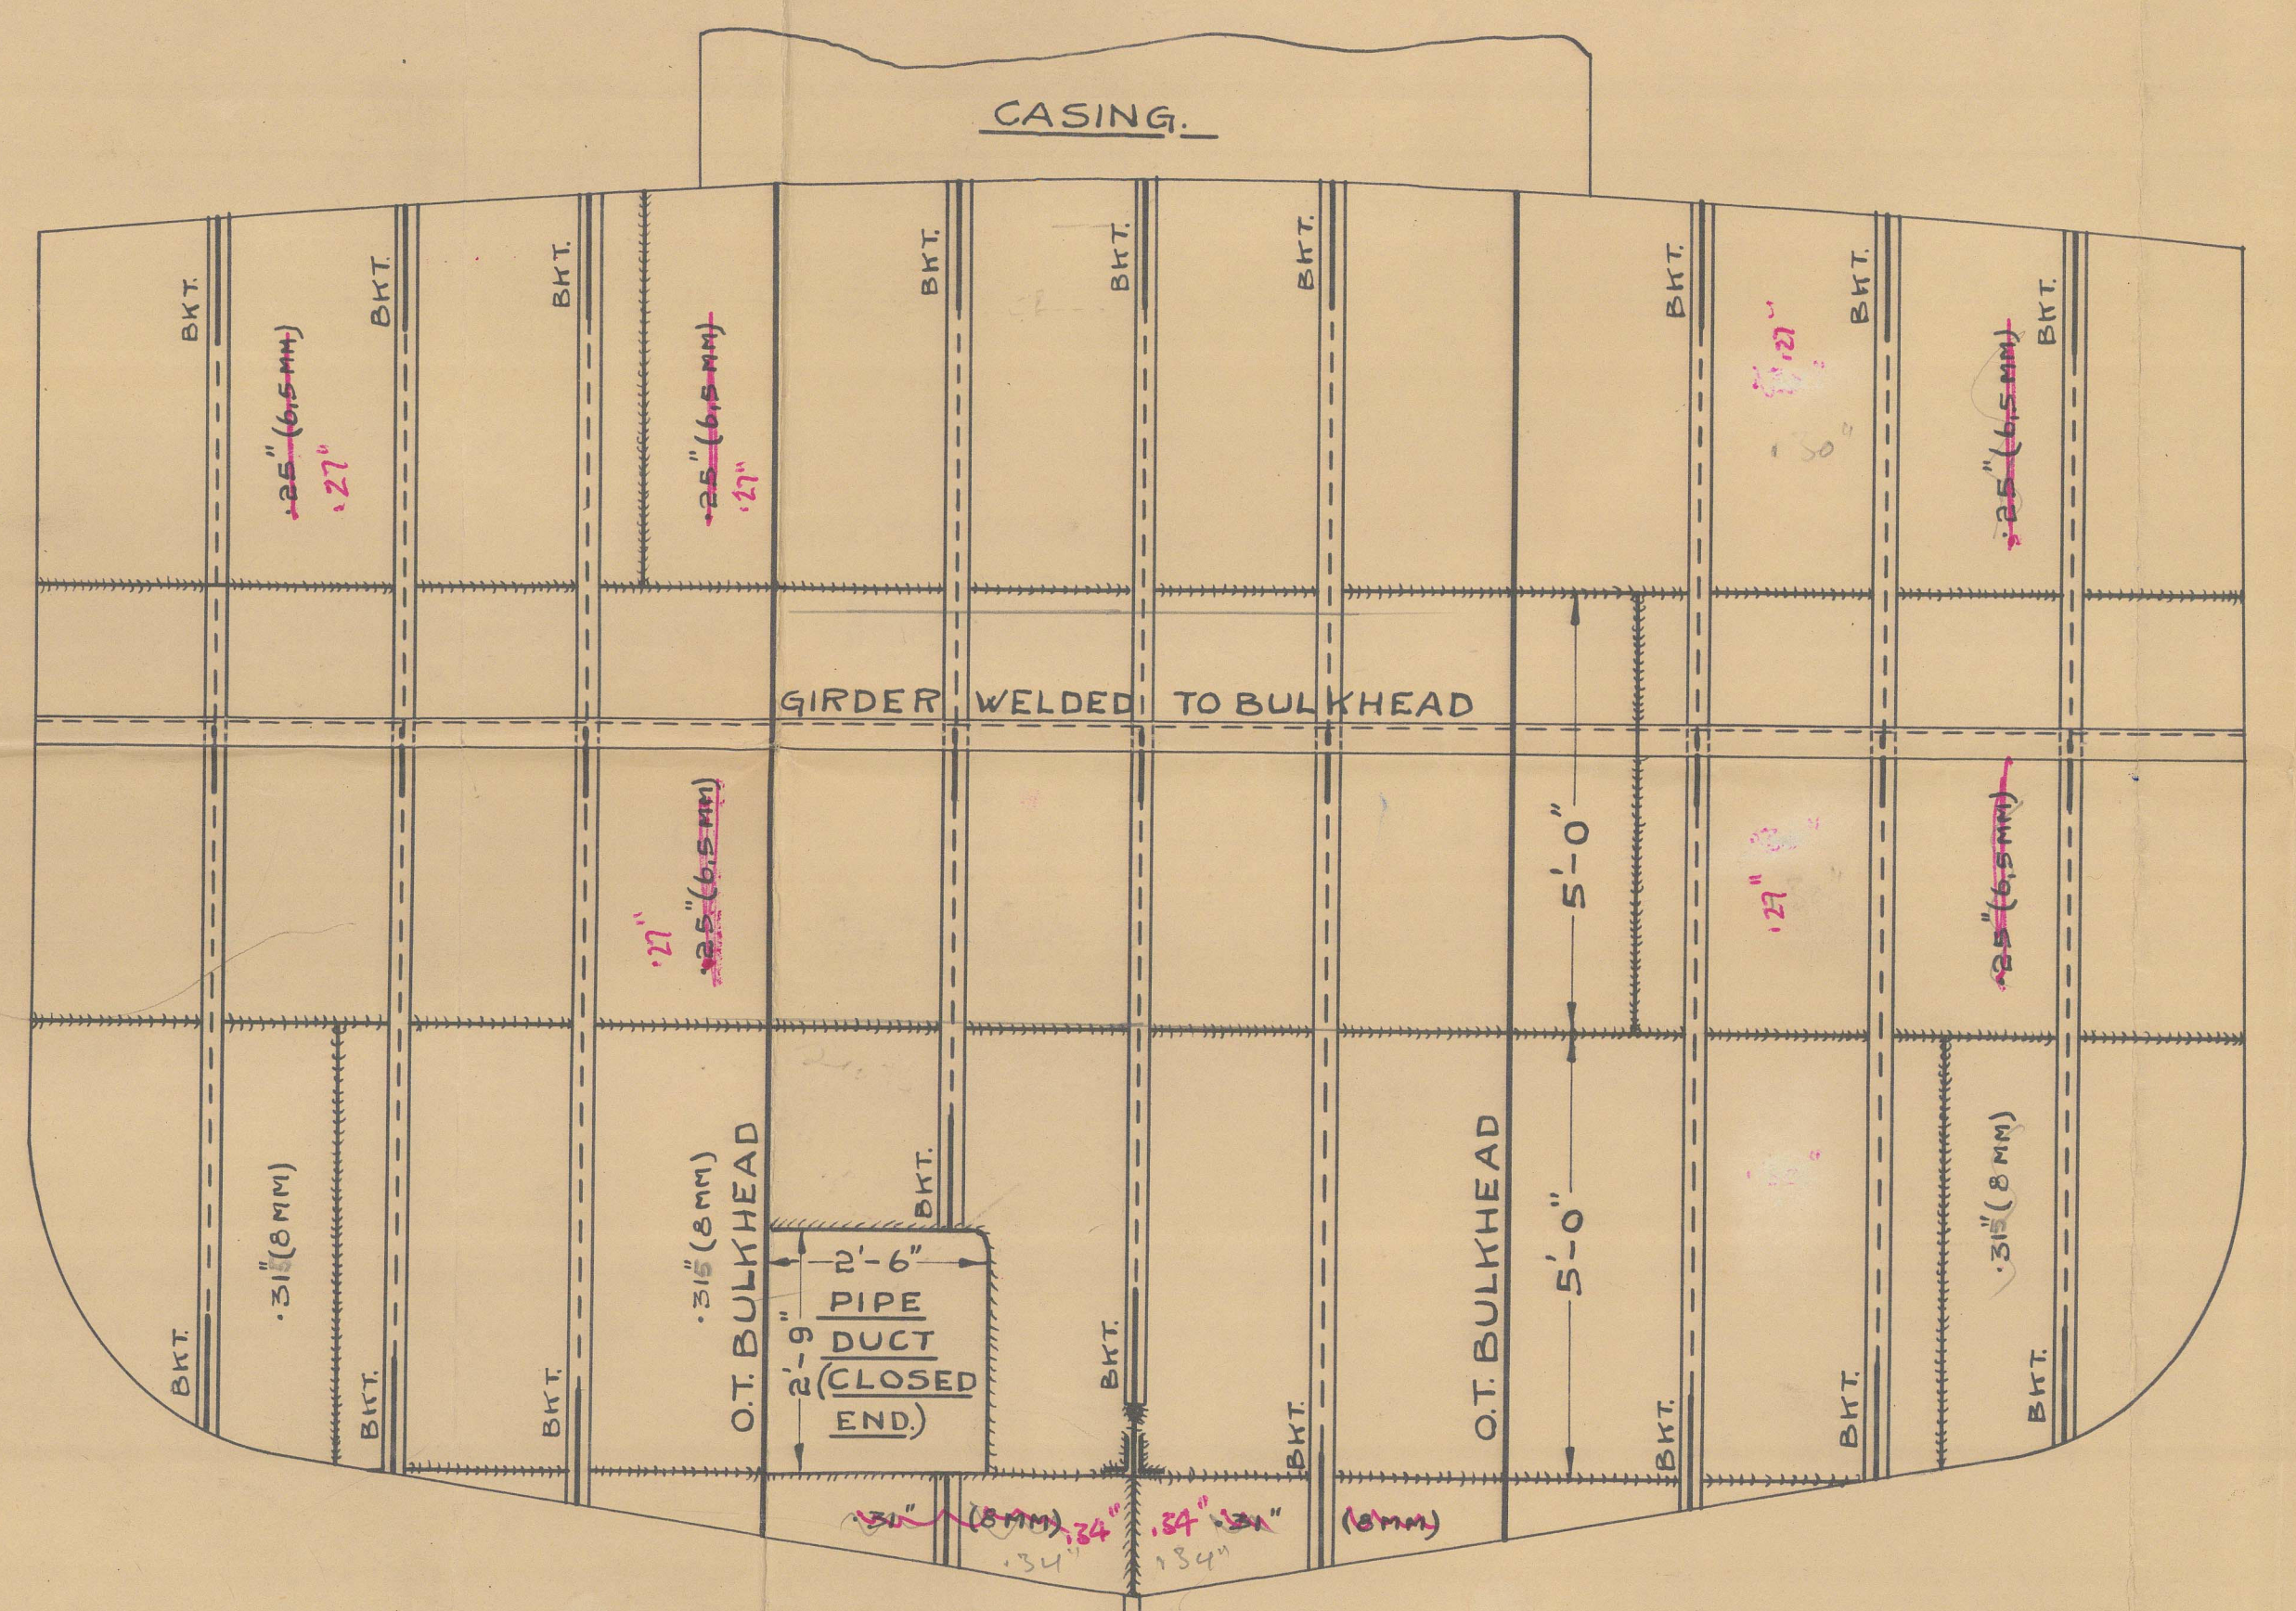
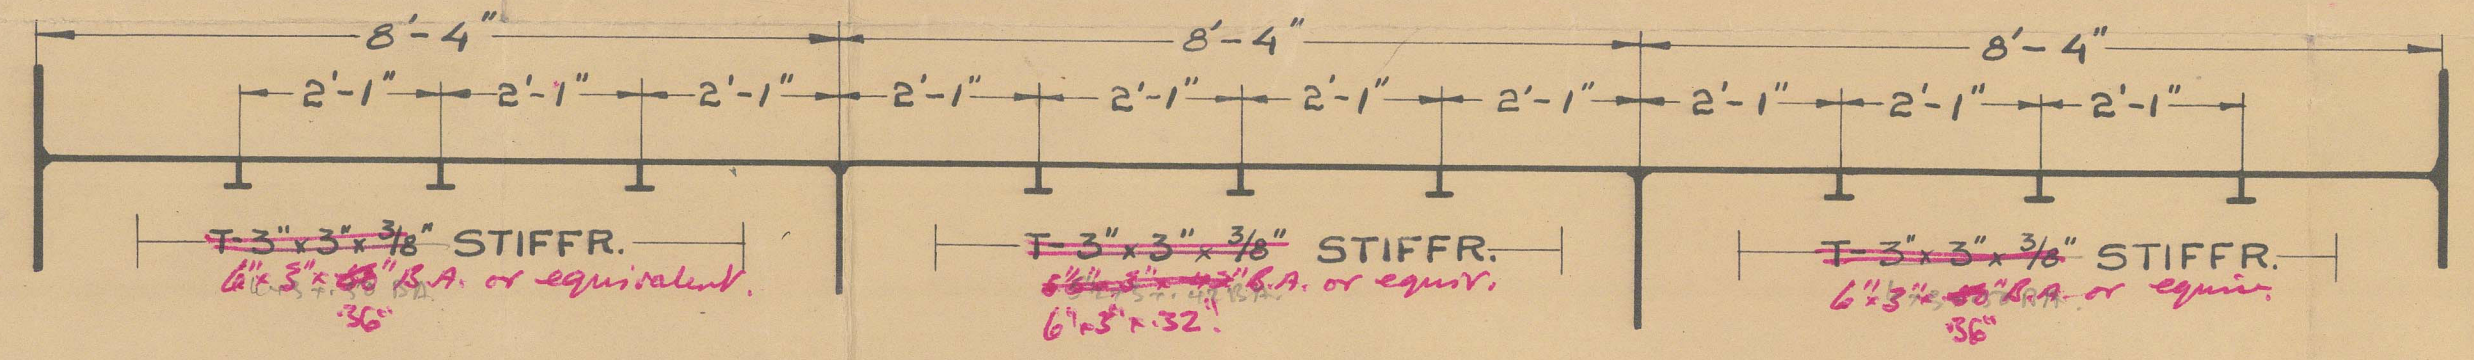
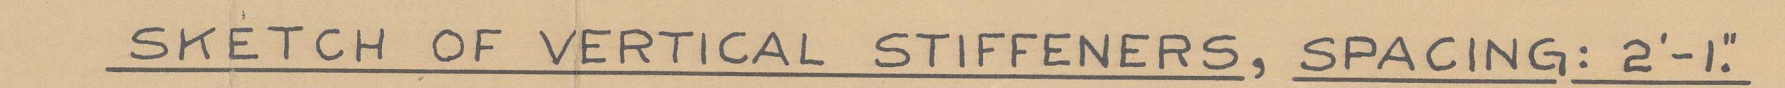
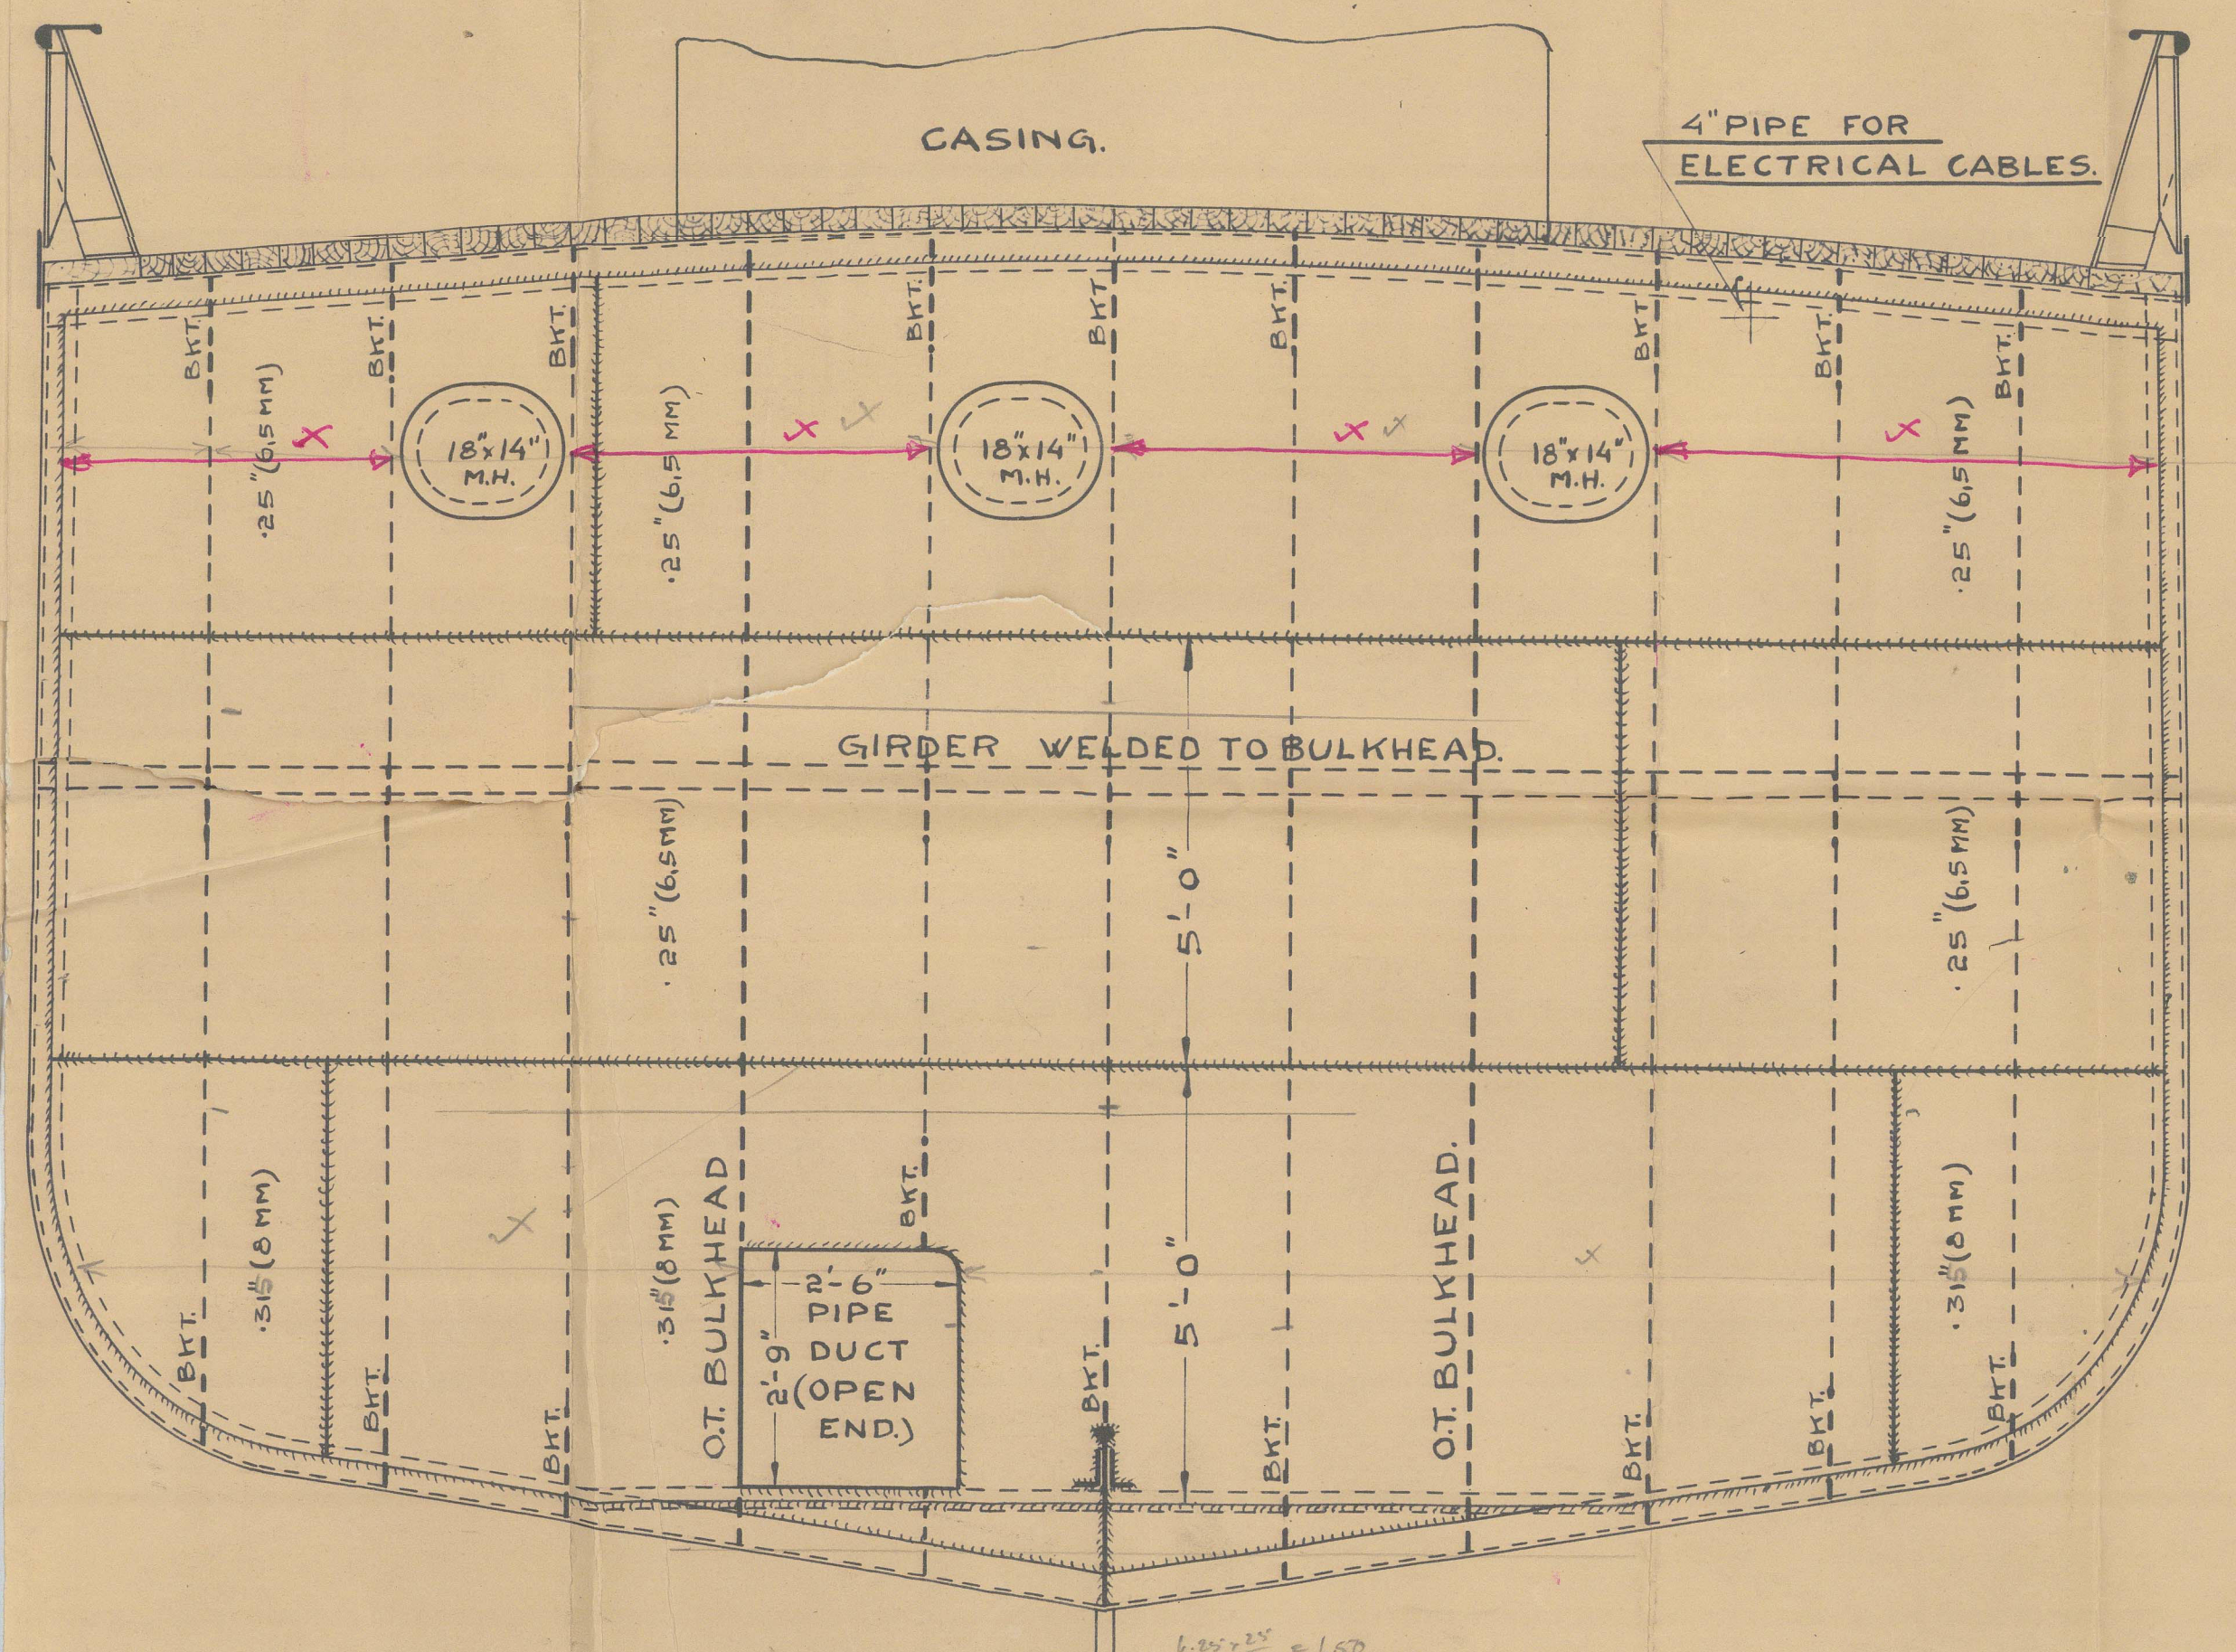


Overflow assumed 30" above  
Rained Quarter's deck.

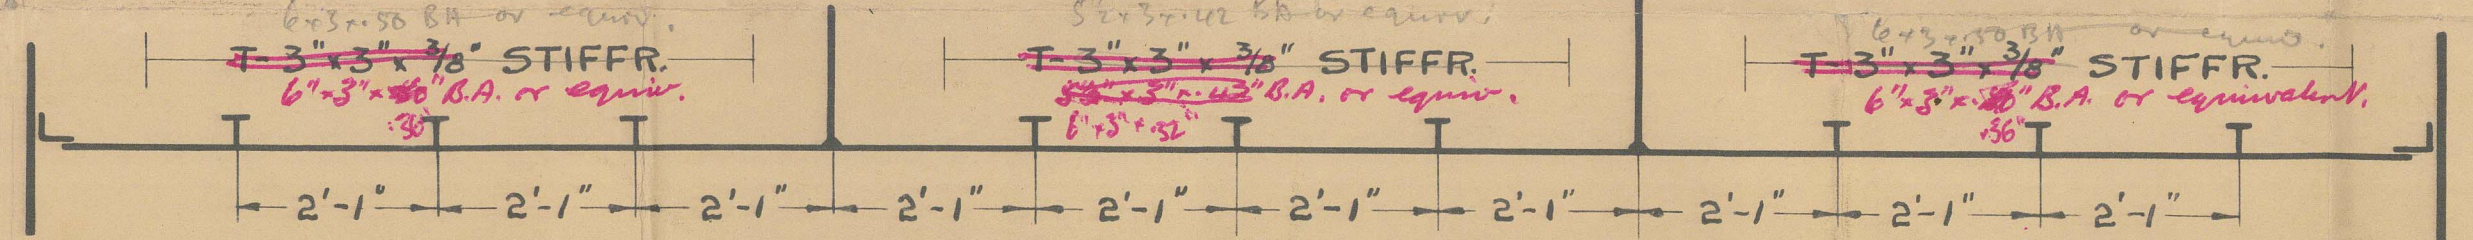

Office Copy  
J. 20/6/51

DAQ	BREYTING	DAQ	BREYTING
STÅLSMIDJANF		MELING 18-10 REINH TEIKN ATH.	
REYKJAVIK OIL BUNKERS. IN SS. JUPITER. (ALTERNATION FROM COAL FIRED TO OIL FIRED SHIP)		SIGN DAQ 18-10 REINH TEIKN ATH.	
		TEIKN.NR.122-51	

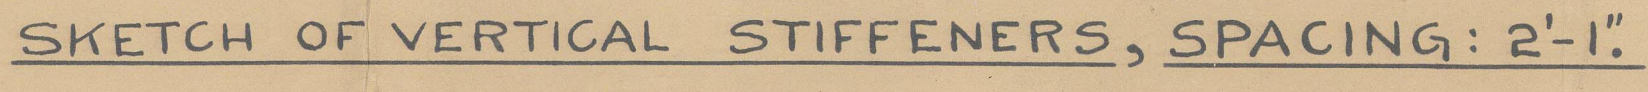

"Jupiter"

Rji 1957



© 2021

Lloyd's Register

012377-012385-0148  
Foundation



SS. JUPITER

---



© 2021

Lloyd's Register  
Foundation

012377 - 012385 - 0148