


S.T. MEITAI MARU


GENERAL ARRANGEMENT

SCALE


1/200

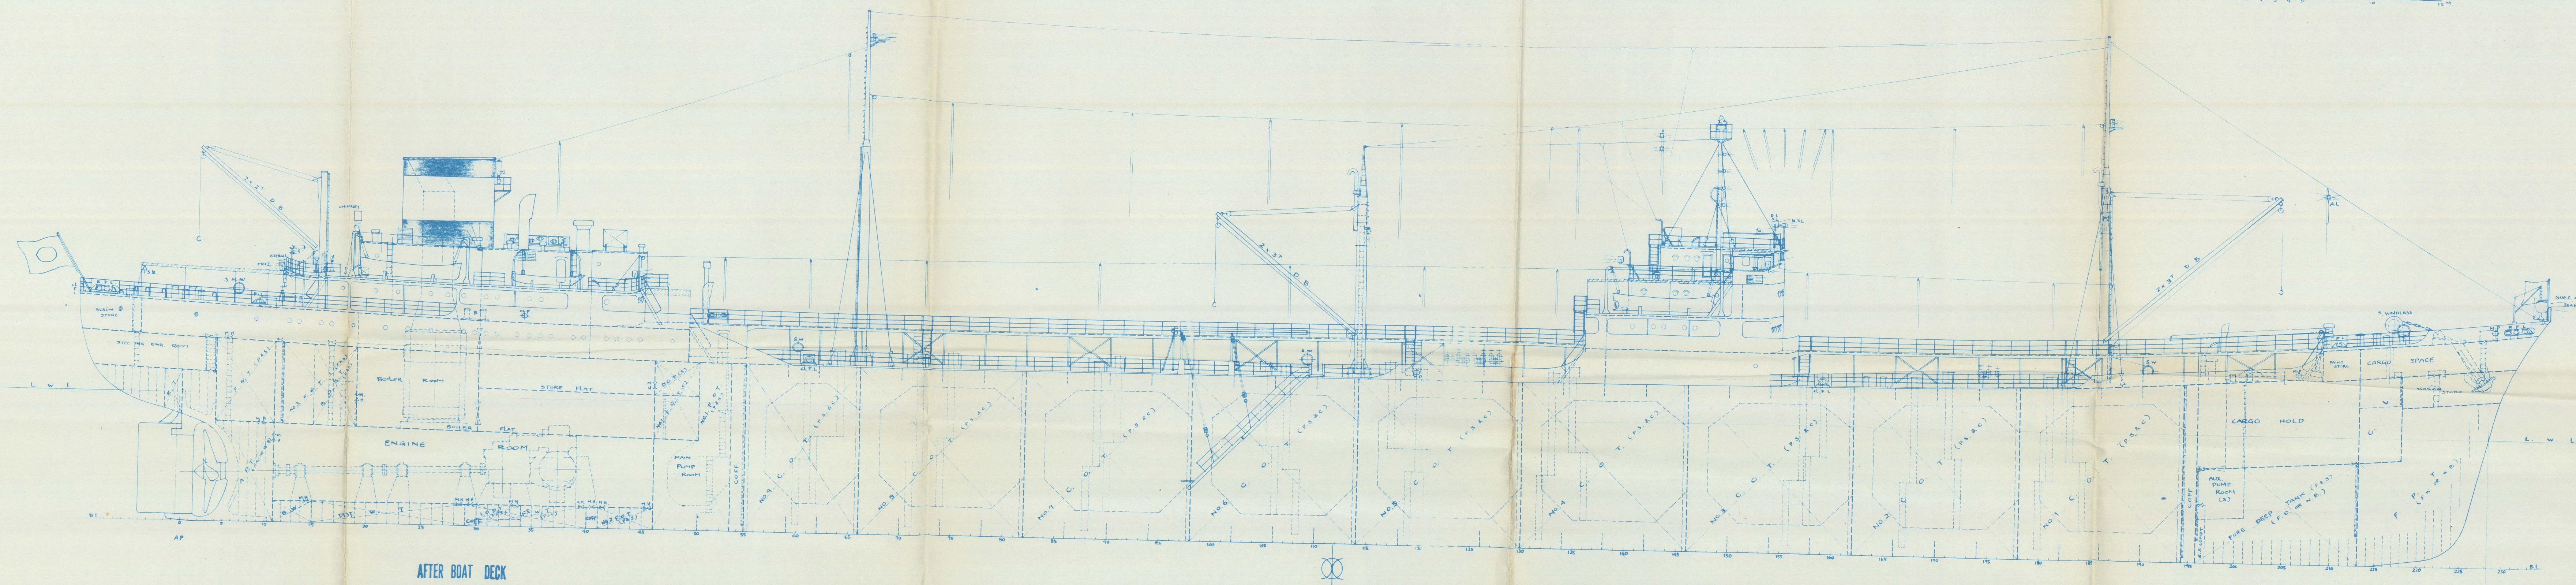

CASING TOP

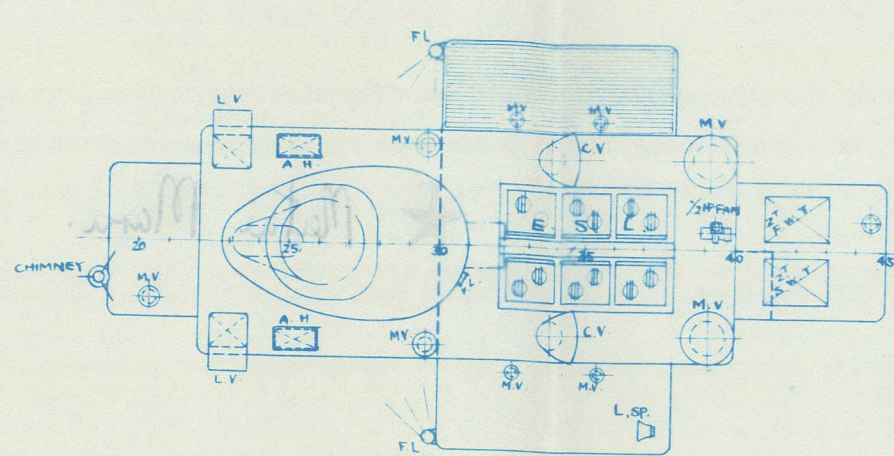

AFTER BOAT DECK

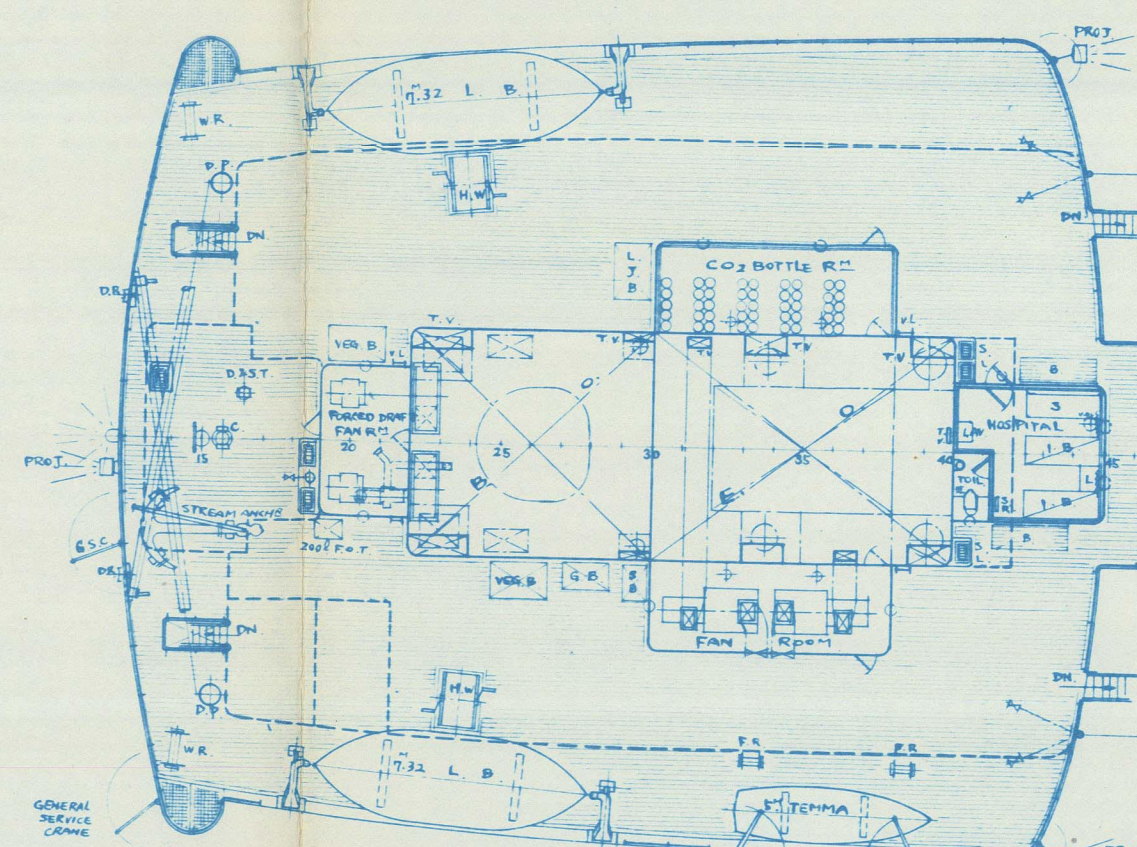


PRINCIPAL PARTICULARS	
L F.P.	151'00"
B (max)	22'00"
D (max)	12'20"
A (average)	9'516"
G.T.	12482.28
N.T.	9358.53
D.W.	26111.77
D.T.	27210.47
TOTAL SPEED	15.53


CLASS	
LR 3	100 A1
+LMC	
NSM	
NKK	
F.P.A. 331.55H	

COMPLEMENT			
DECK	ENGINE	PIESER	
CAPTAIN	1 V/ENG	1 VOP	
1 OFF	1 V/ENG	1 PIESER	
2 OFF	2 V/ENG	2 PIESER	
3 OFF	3 V/ENG	3 VOP	
4 OFF	1 V/ENG	1 VOP	
5 OFF	1 V/ENG	1 VOP	
FORE BOAT DECK

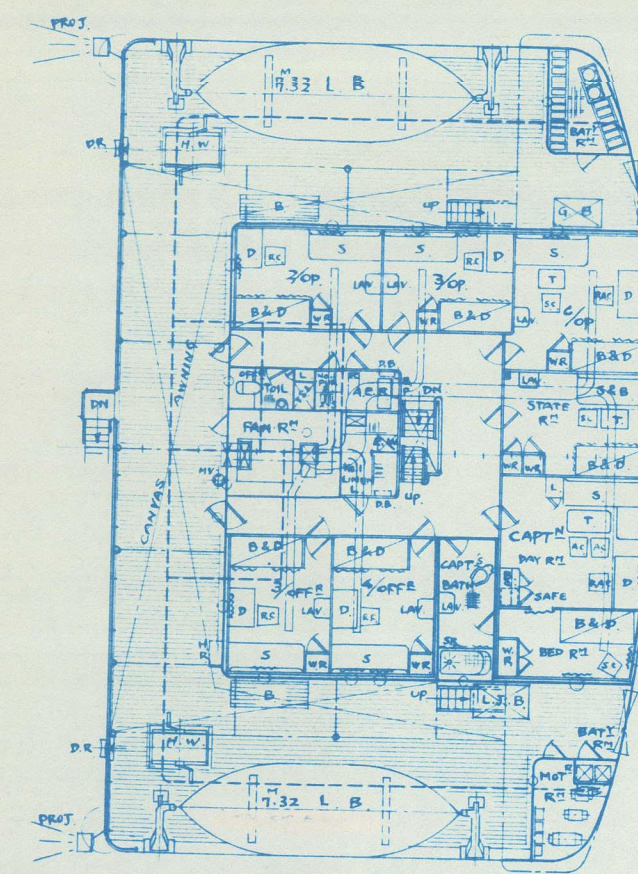


NAVIGATION BRIDGE DECK

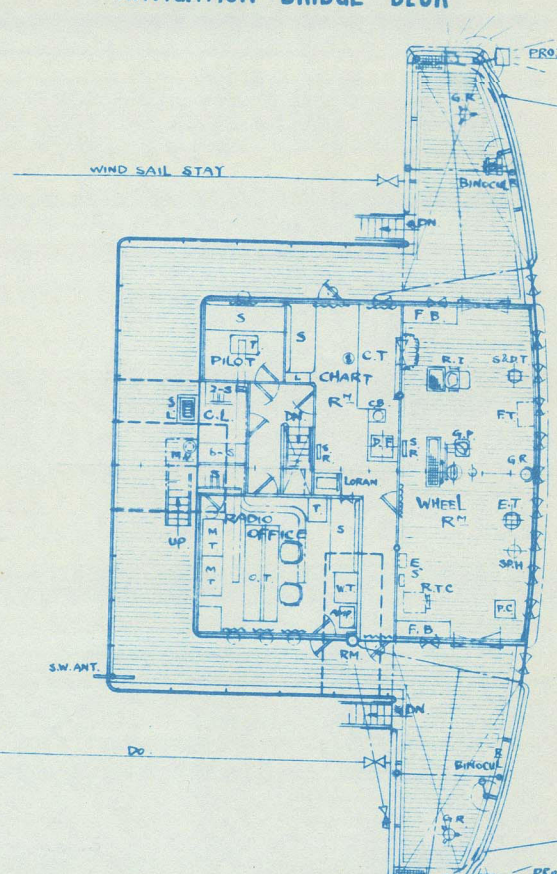


COMPASS BRIDGE DECK

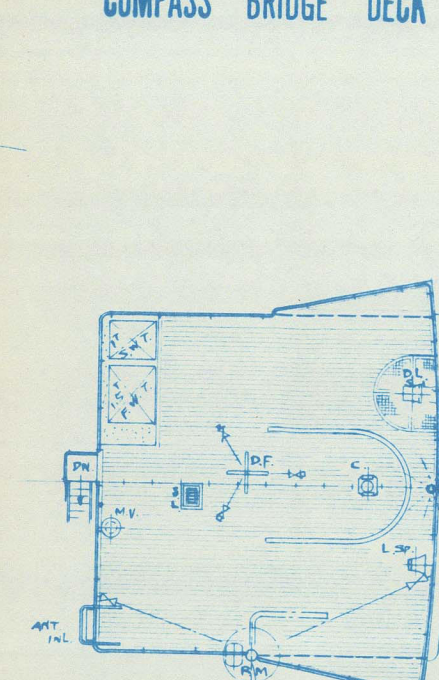


BRIDGE DECK

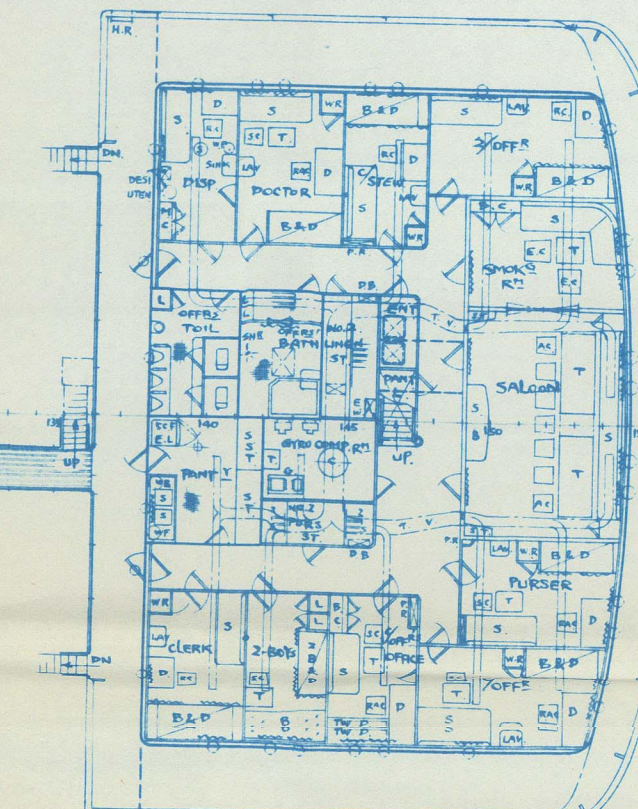


FORECASTLE DECK

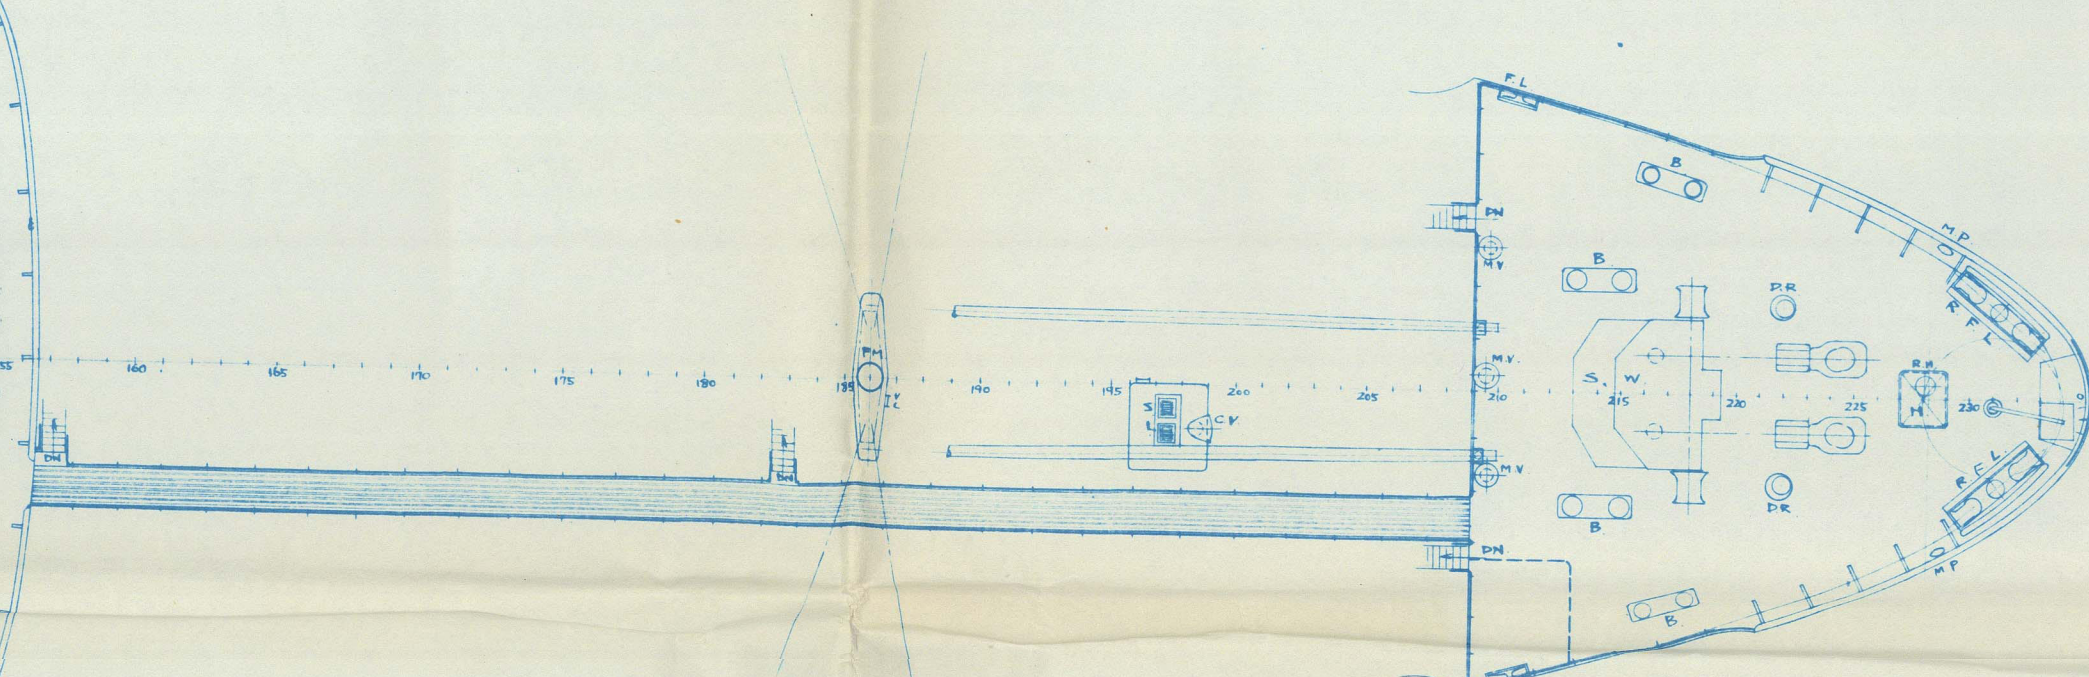



POOP DECK

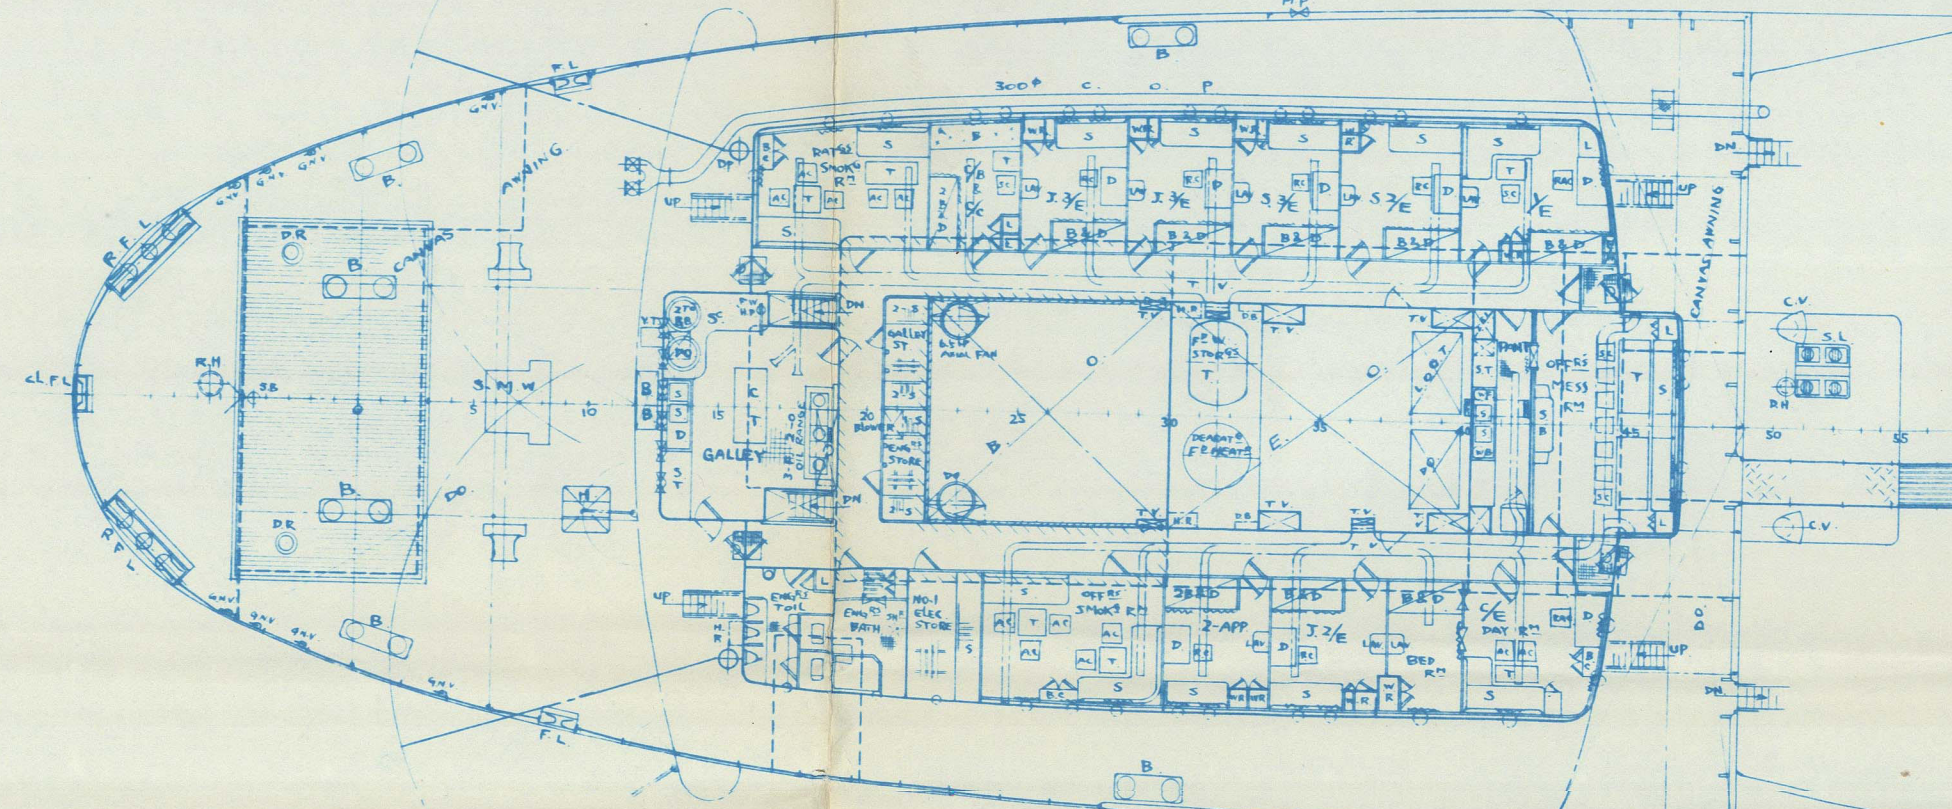

BOILER FLAT

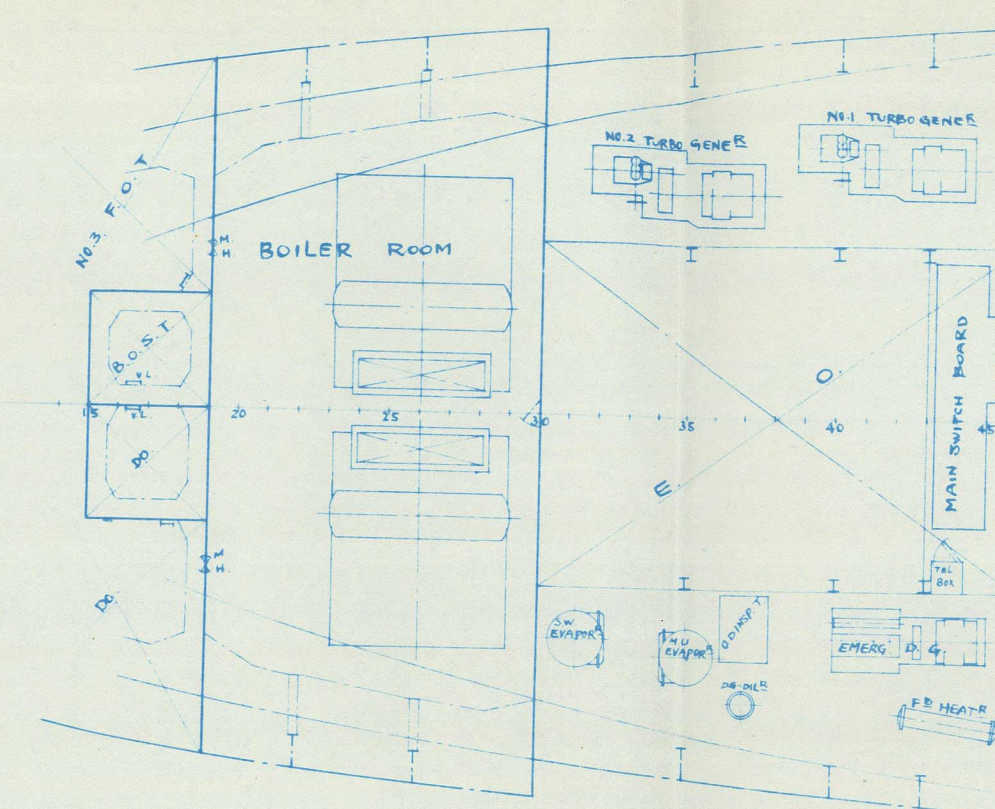

DOUBLE BOTTOM

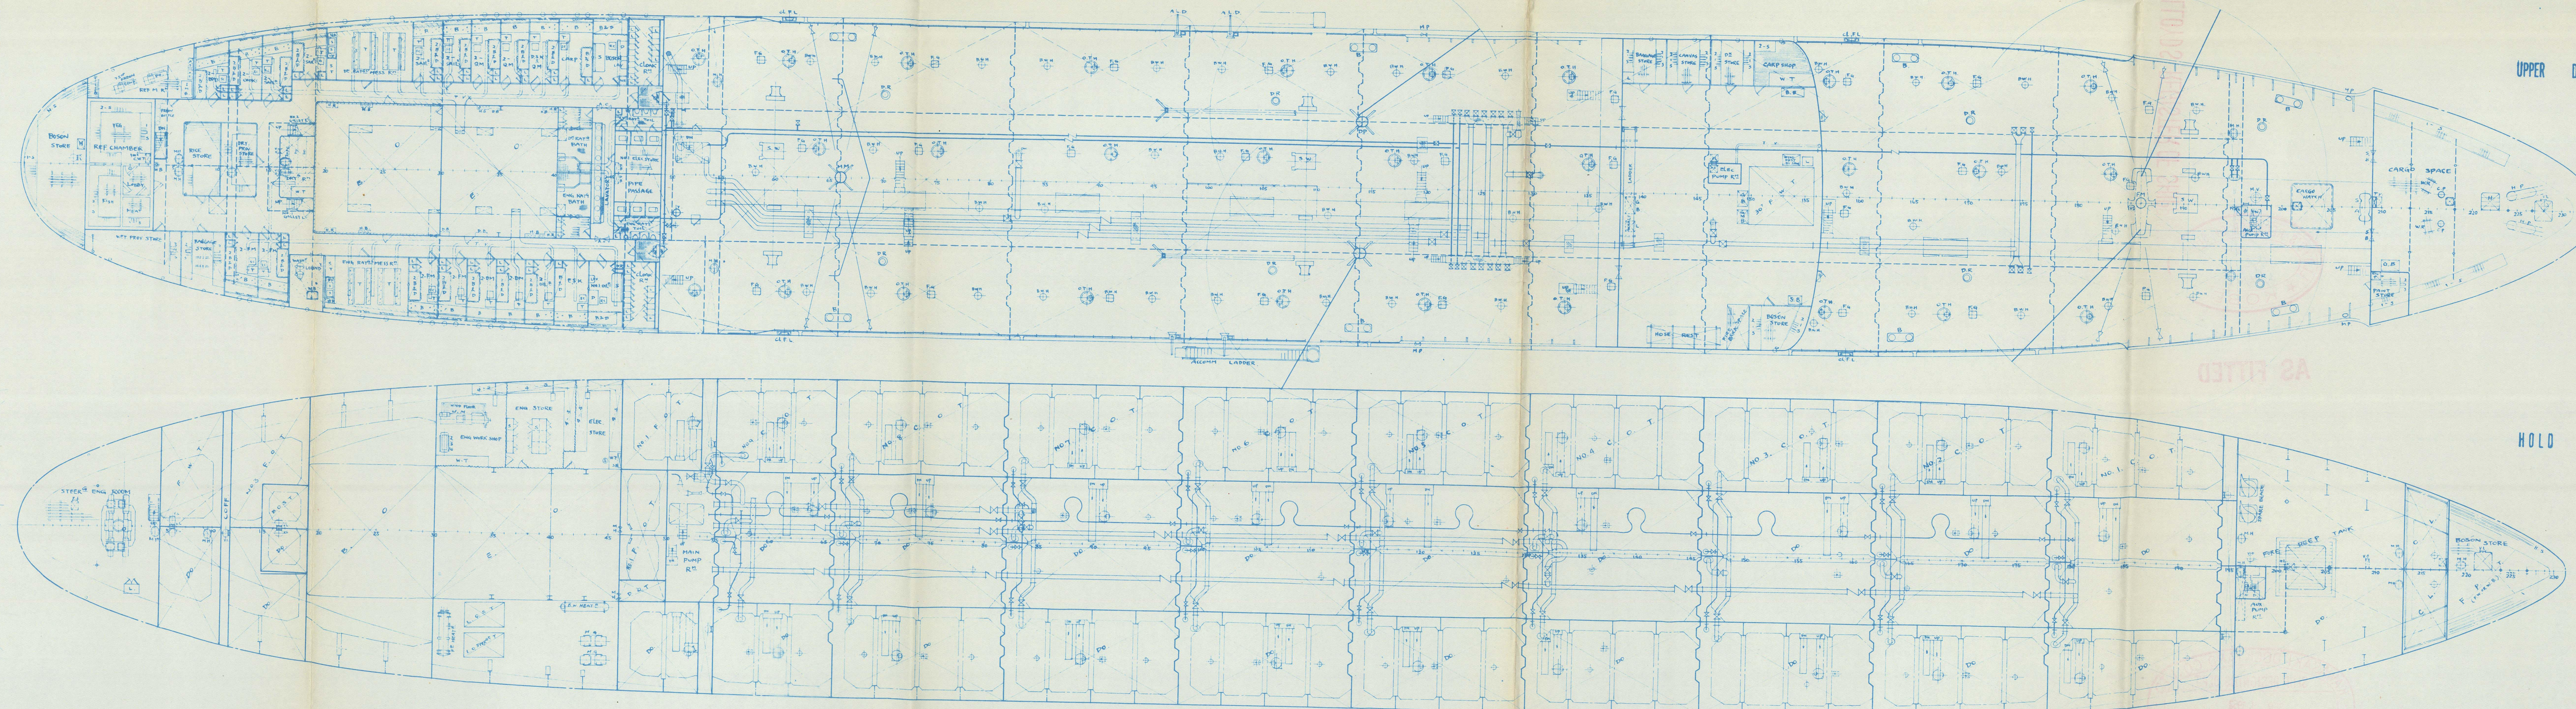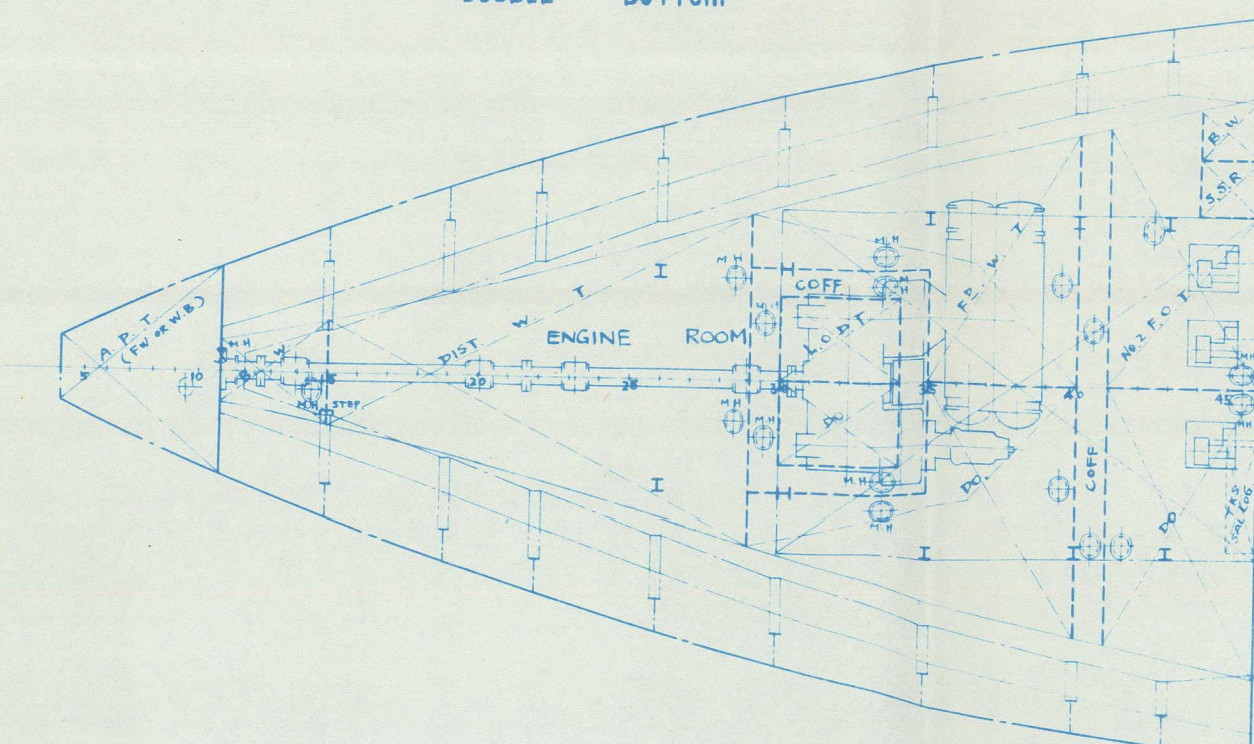

UPPER DECK

HOLD

FINISHED PLAN

MEITAI MARU

TITLE

GENERAL ARRANGEMENT

SCALE

KAWASAKI DOCK YARD CO., LTD.

KOBE JAPAN

SHIPDESIGNING DEPARTMENT

CHIEF OF DEPARTMENT

CHIEF OF SECTION

CHECKED BY

DRAWN BY

DATE

DRAWING NO. A-2

012377-012385-0123

© 2021


Lloyd's Register

Foundation

General arrgt.

★ Meitai Maru.


RECORDS DEPT..
LONDON

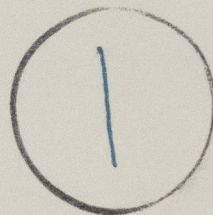


© 2021

Lloyd's Register
Foundation

TO LLOYD'S REGISTER OF SHIPPING

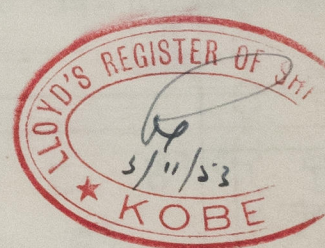

AS FITTED

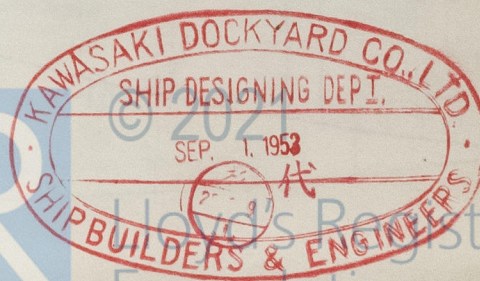

Lloyd's Register
Foundation

012377-012383-0305