



DAVENPORT & CO. LTD.
 LONDON
 10, FINE ST.
 10, FINE ST.
 10, FINE ST.

No 927.
"STEEL OIL BARGE."
STERNFRAME & RUDDER
 SCALE $\frac{3}{4}$ " 1 FOOT.
 MAY 1926.



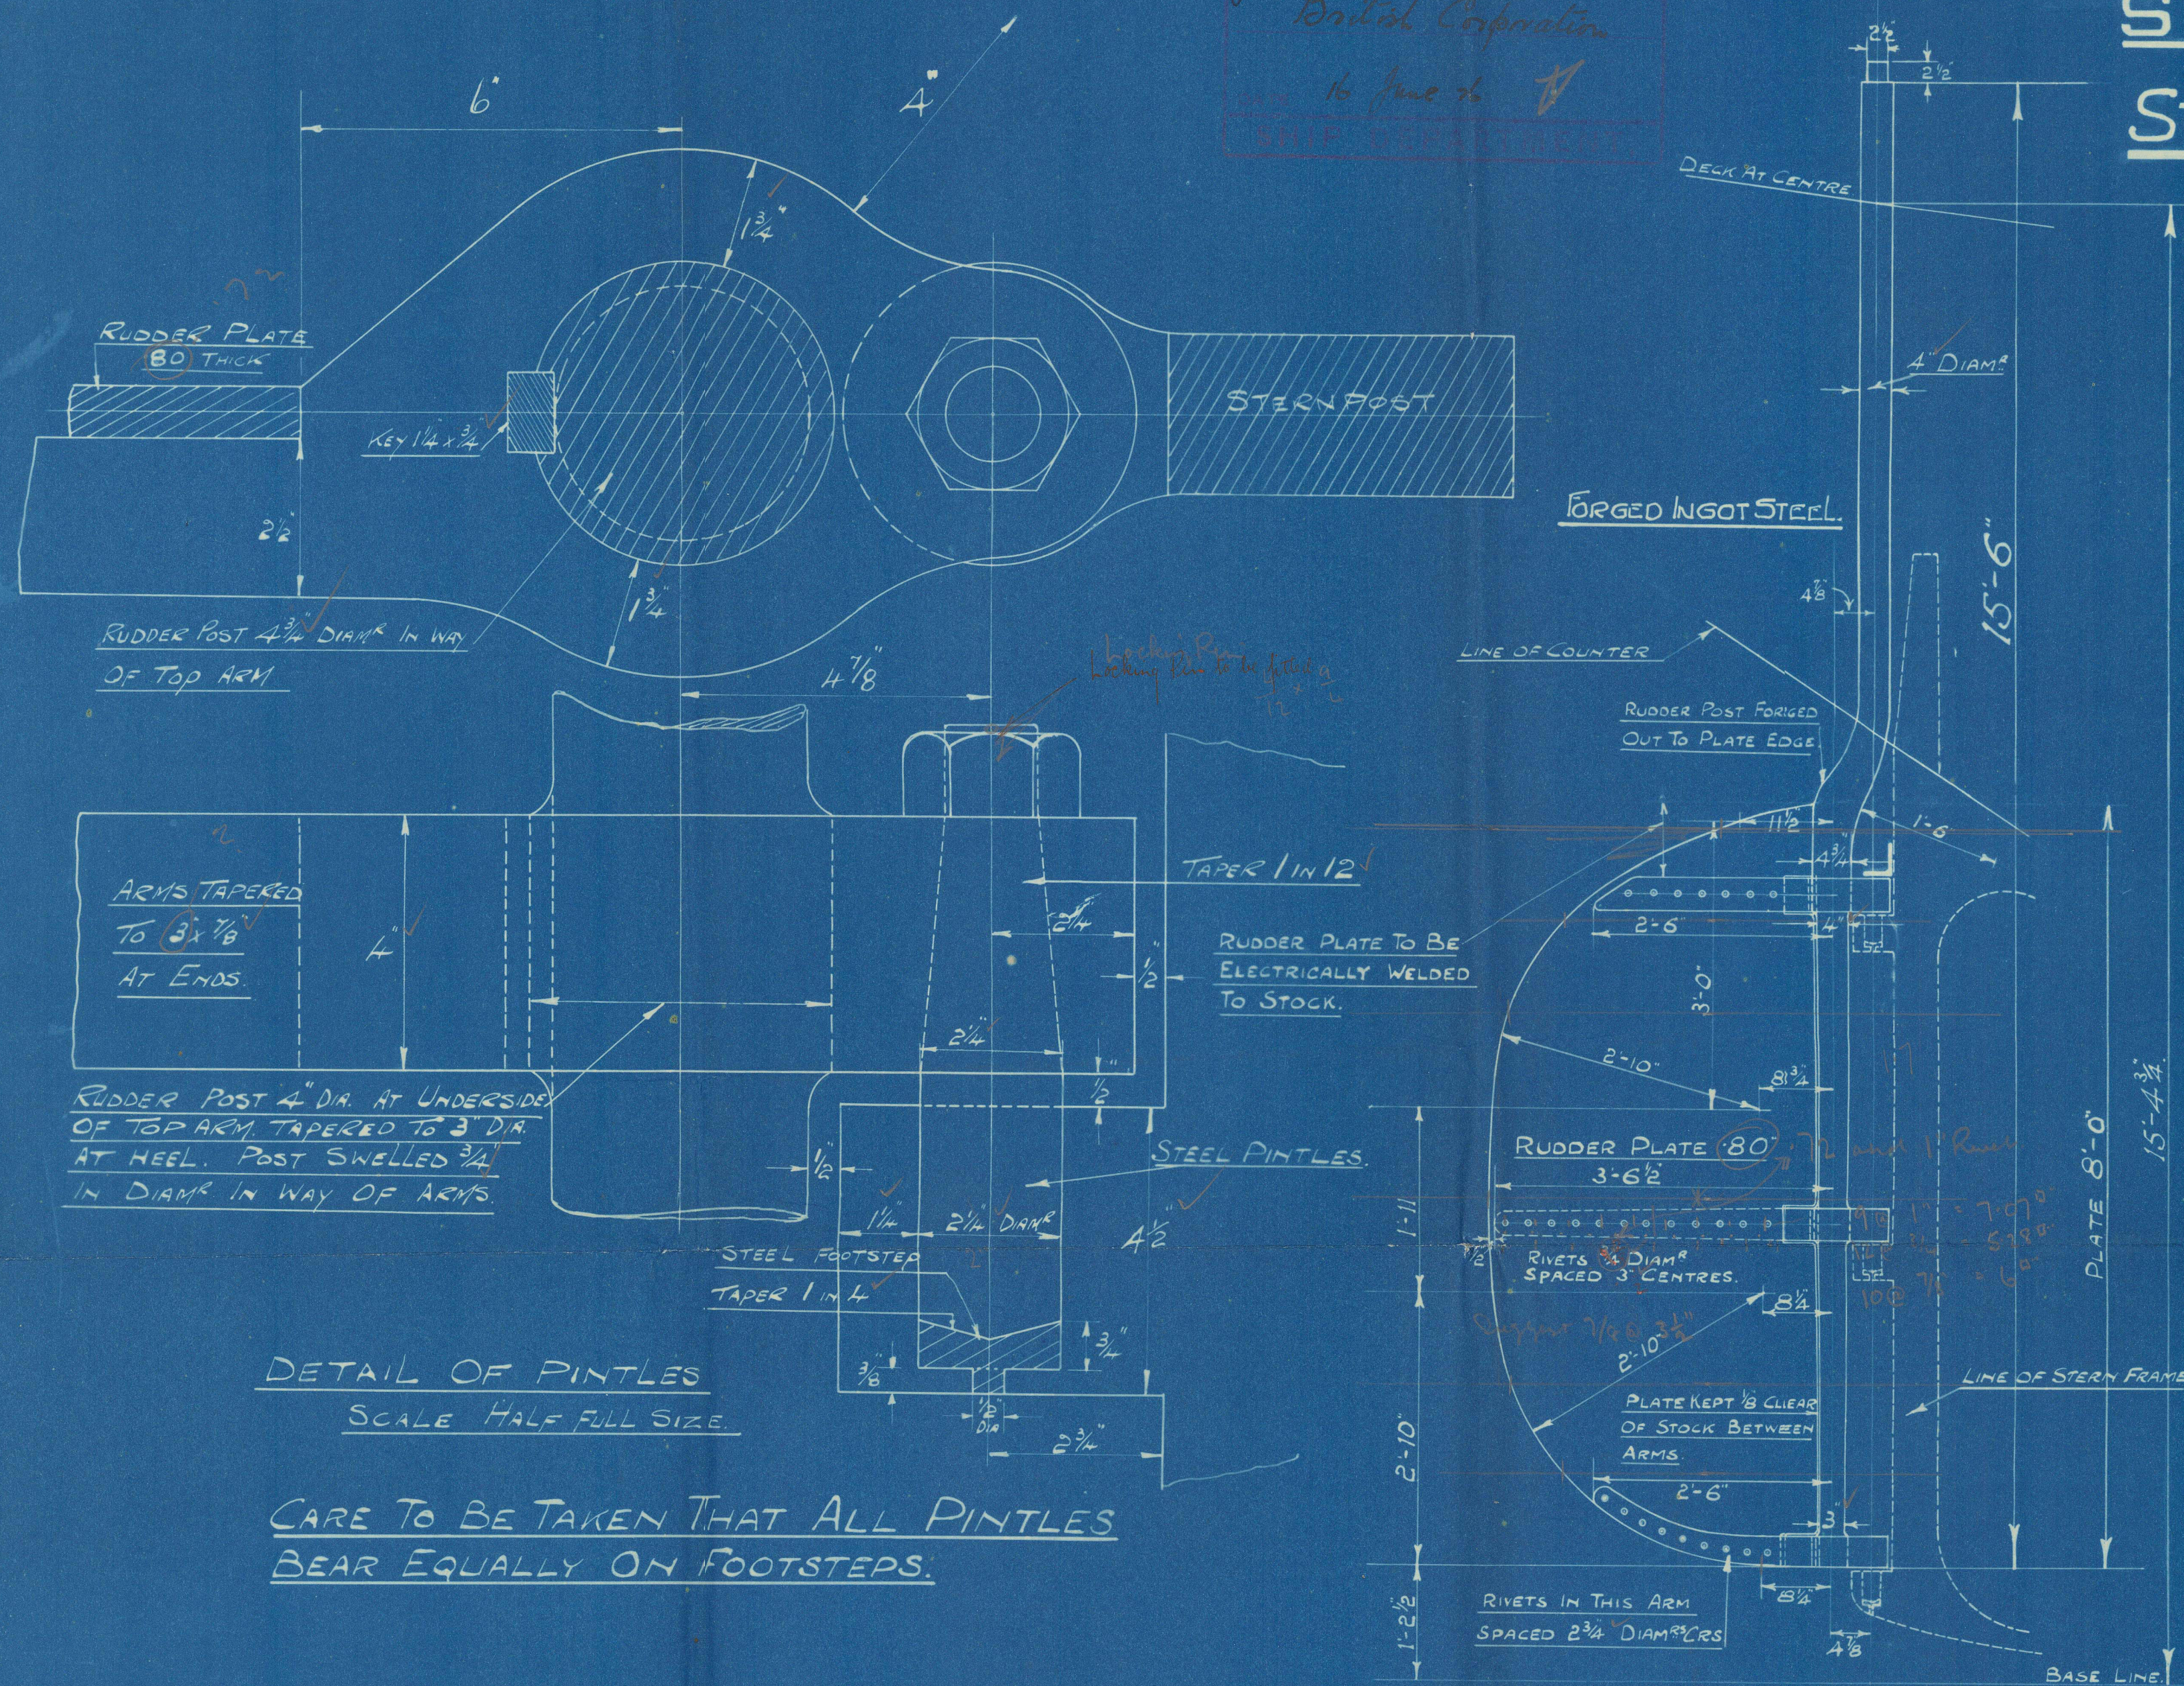


DETAIL OF PINTLES
 SCALE HALF FULL SIZE.


CARE TO BE TAKEN THAT ALL PINTLES
 BEAR EQUALLY ON FOOTSTEPS.

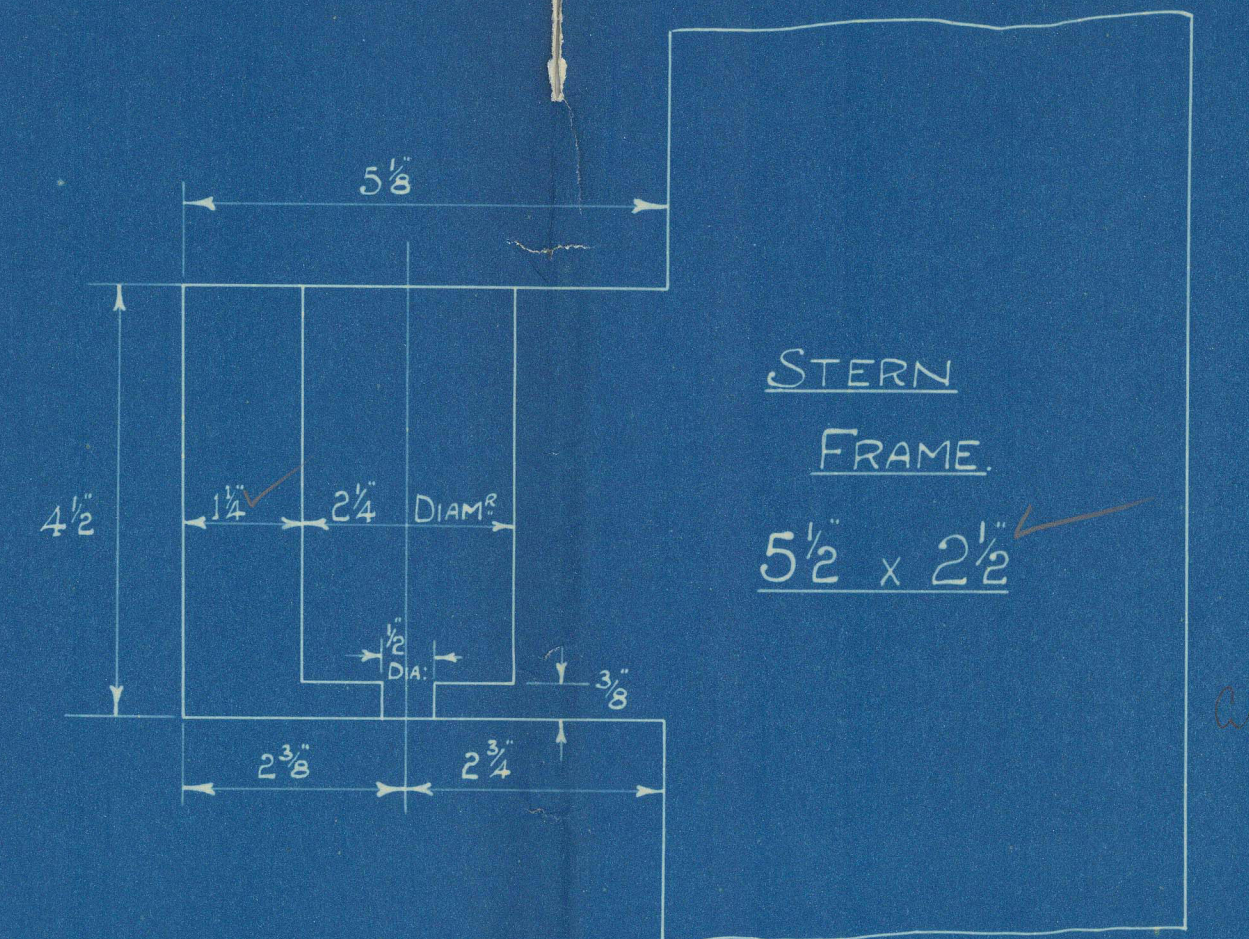

SCALE. HALF FULL SIZE.

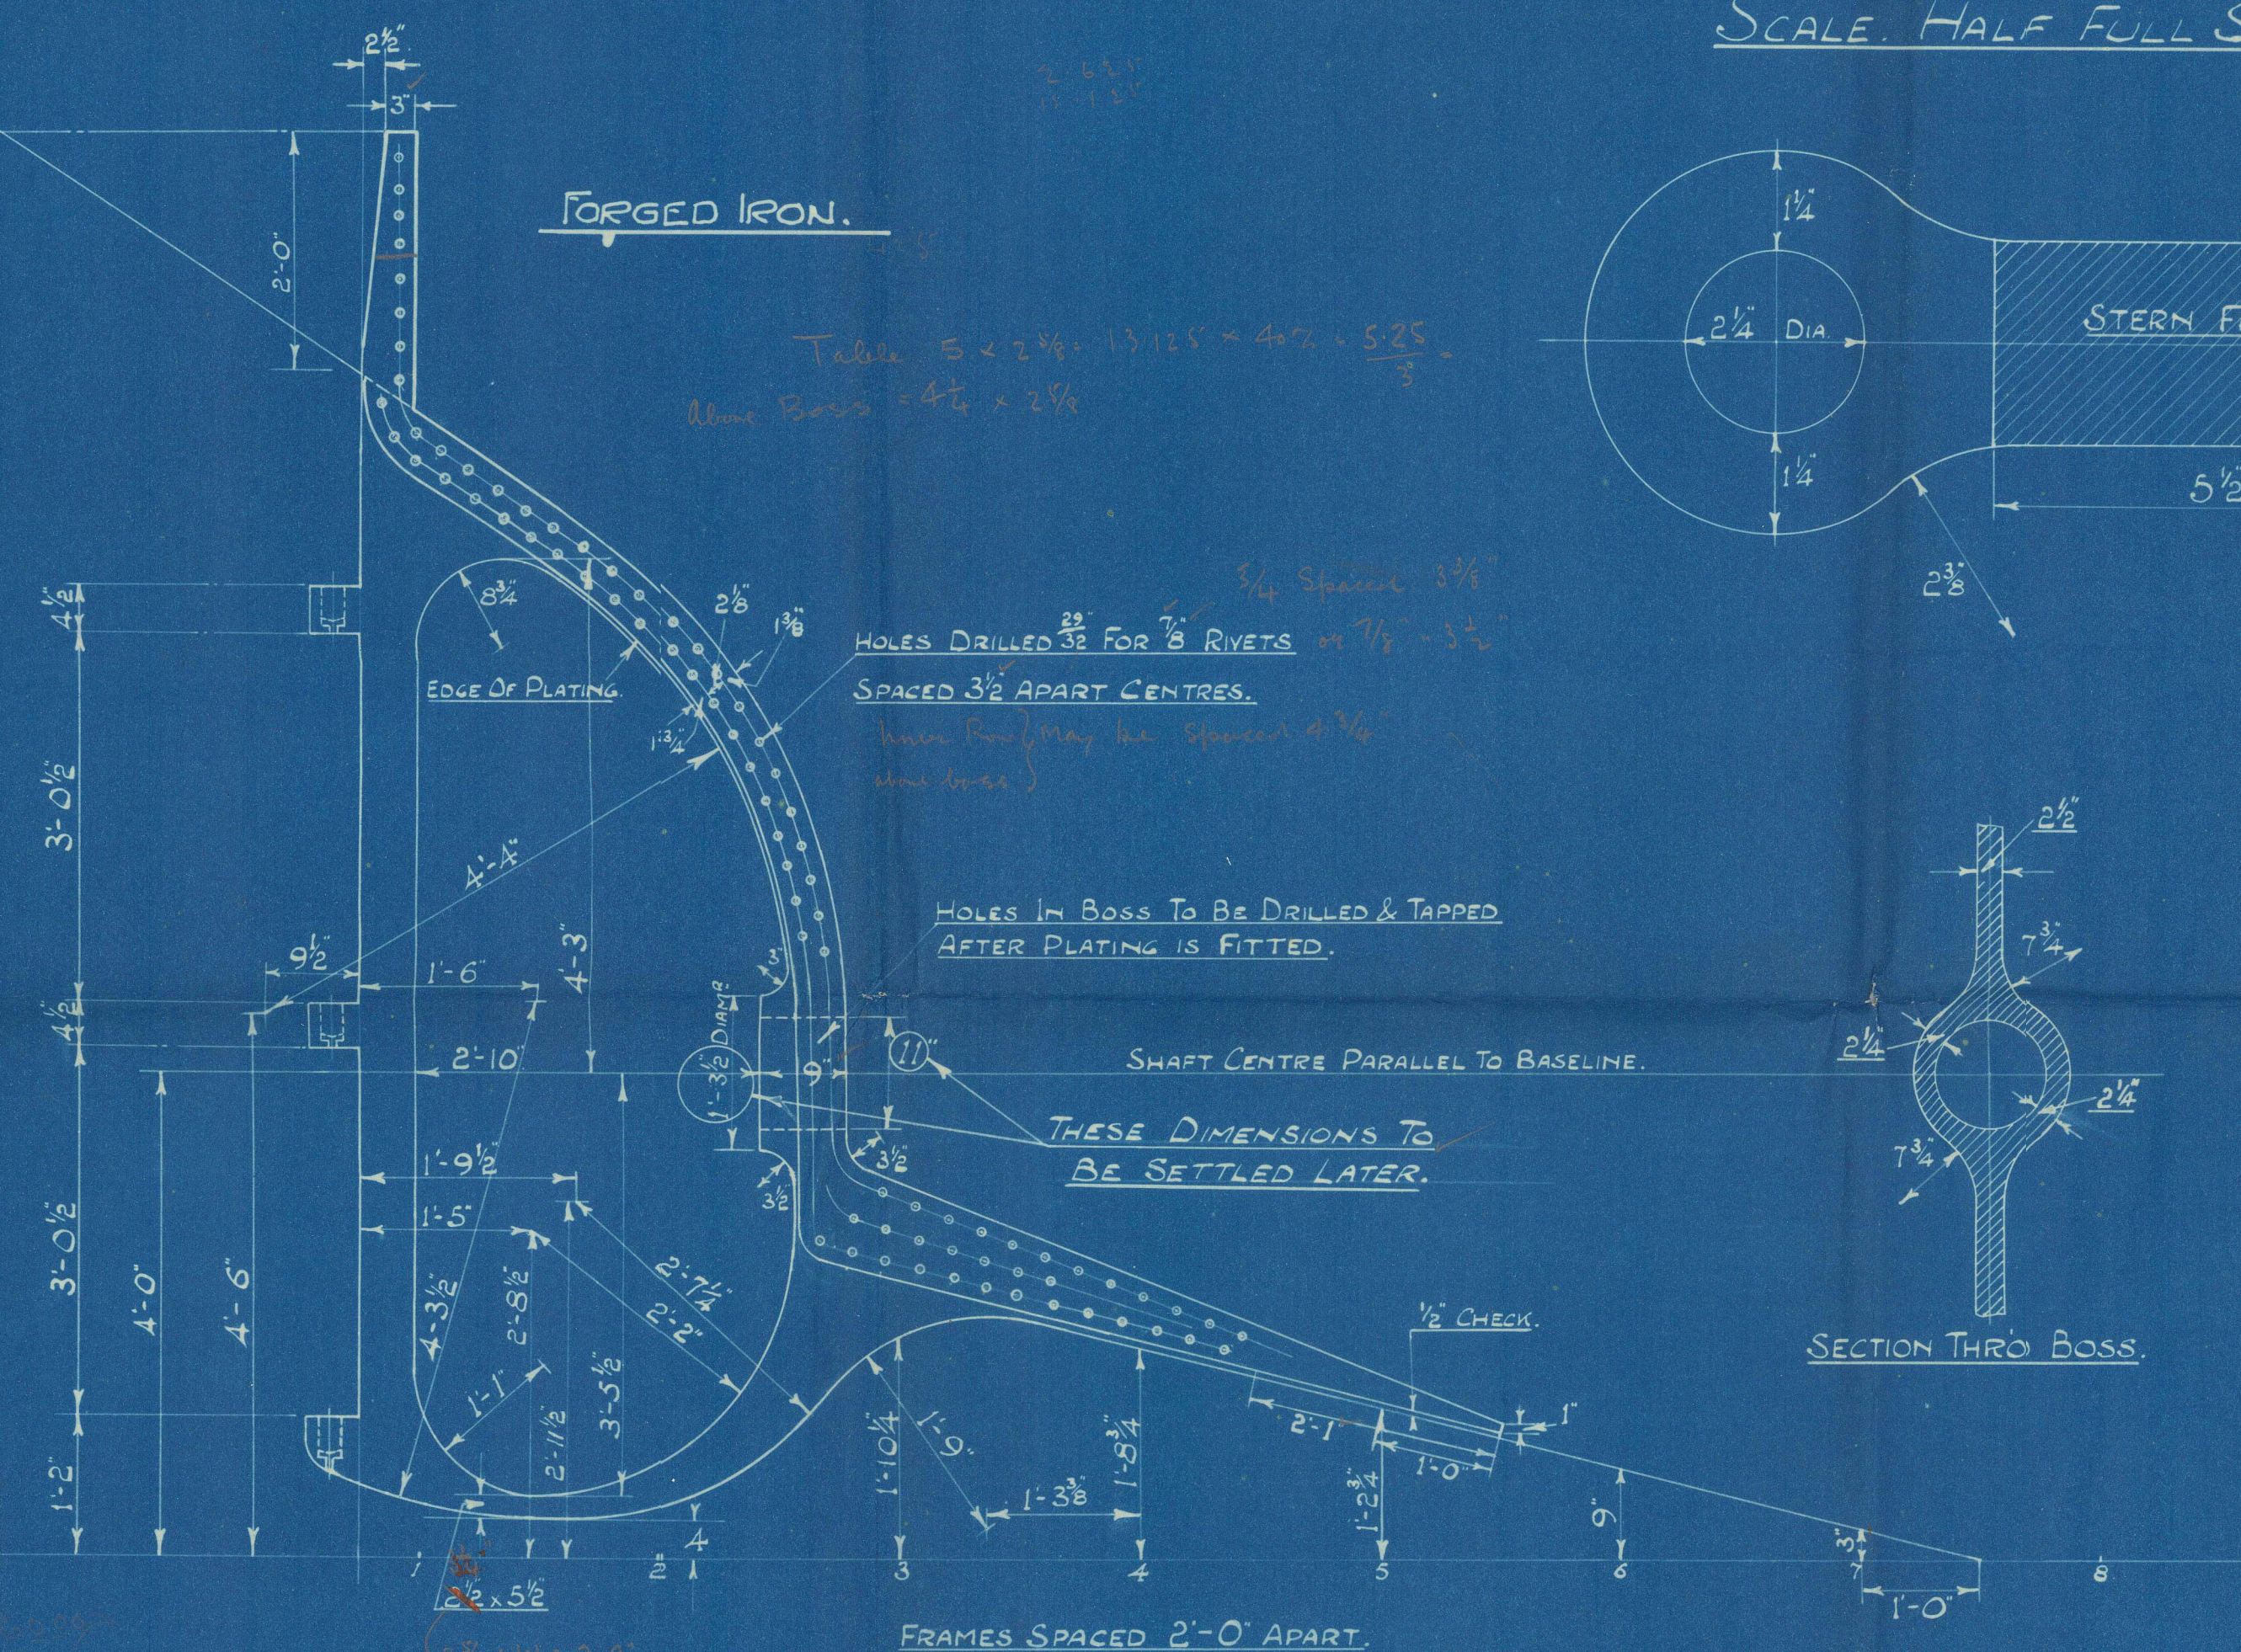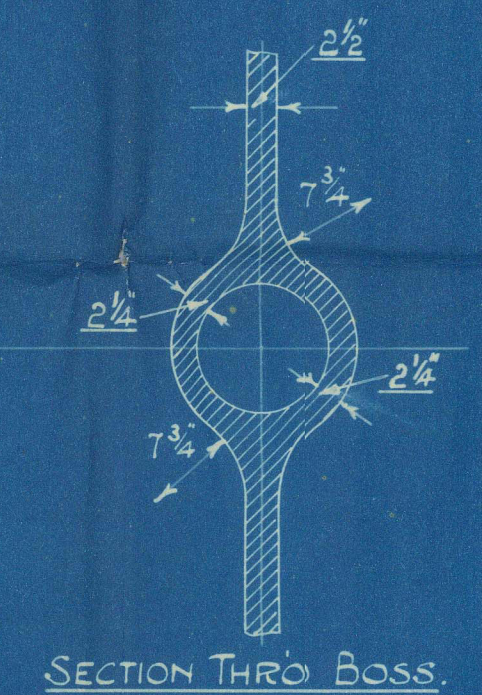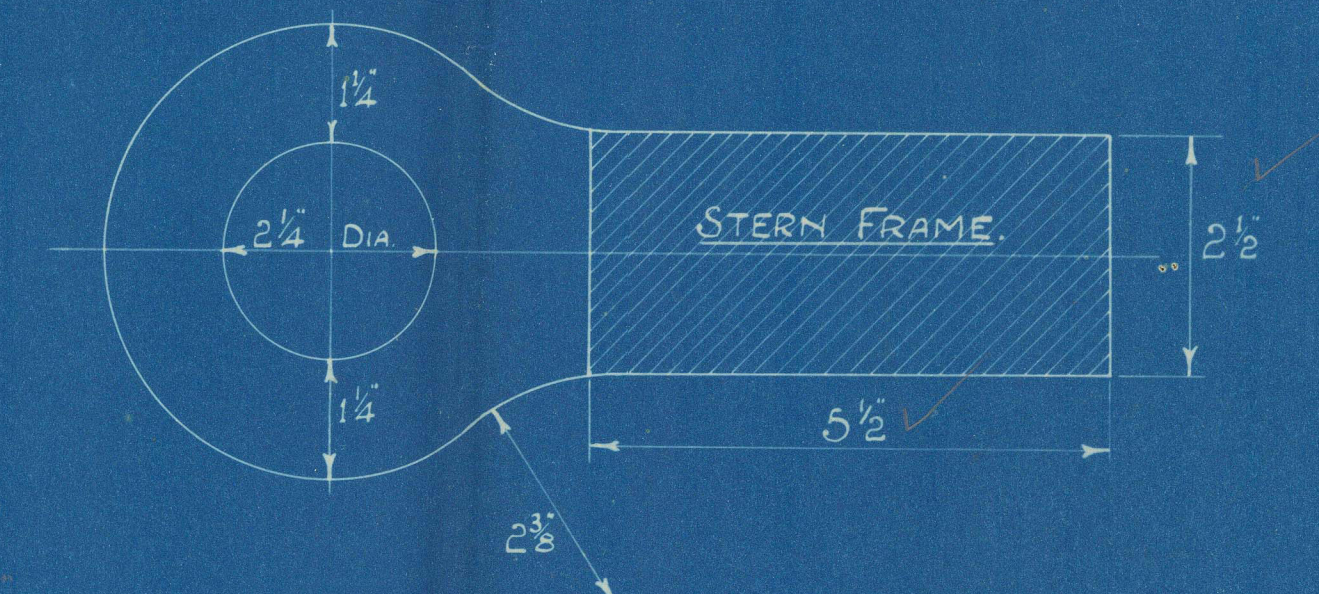

FRAMES SPACED 2'-0\"/>

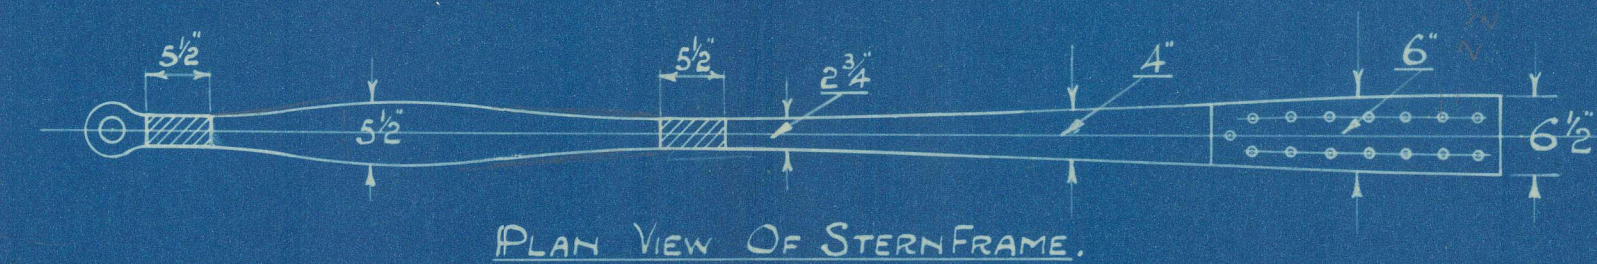

2.

Rudder & Sternframe

Cammell Laird & Co.

Nº 924.

23 - 6 - 26.

"Xanthus"

Bay.