


## PROFILE & DECK PLAN

CLASS:- 100 A 1. WITH FREEBOARD CORRESPONDING TO A

SUMMER MOULDED DRAUGHT OF 6'-9" - "SURVEY VESSEL".

SCALE -  $\frac{1}{8}'' = 1 \text{ FOOT.}$

MASTS WINDLASS CAPSTAN STEERING GEAR ETC  
SUPPORTED TO SURVEYORS SATISFACTION.

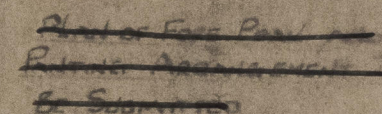



GEO. BROWN & CO. (MARINE) LTD.

S.S. "BARBOSA"

YARD No. 212

PROFILE & DECK PLAN.

(AS BUILT.)

GRK. 1<sup>st</sup>. ENTRY RPT. No. 20448.



© 2021

Lloyd's Register  
Foundation

012343-012400-0219