
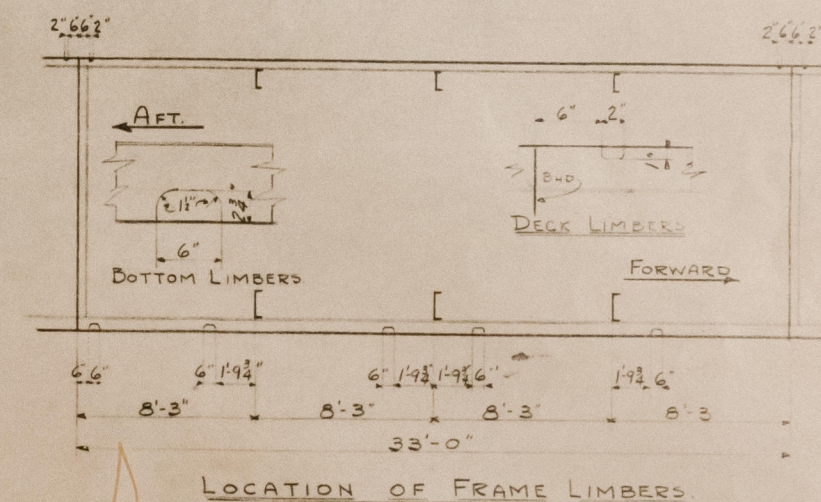
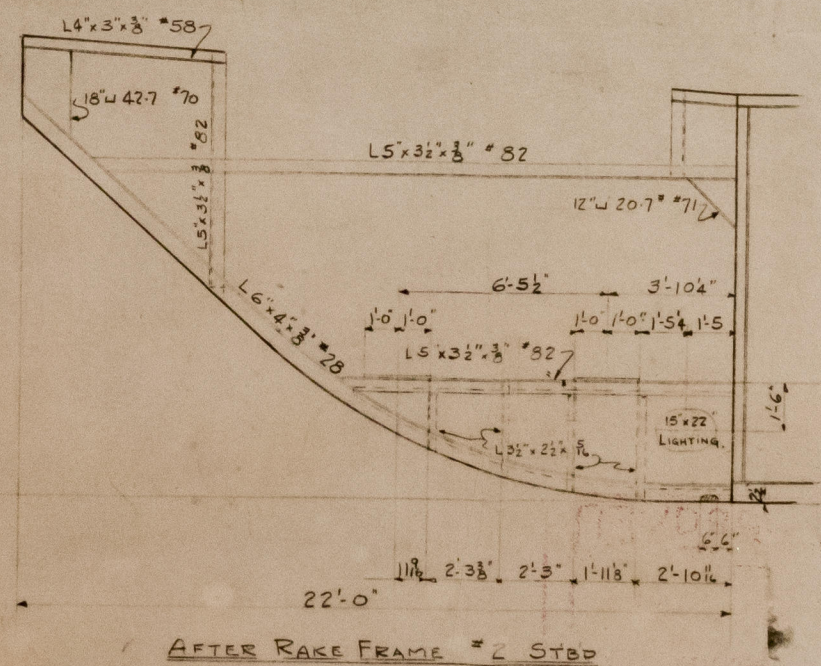
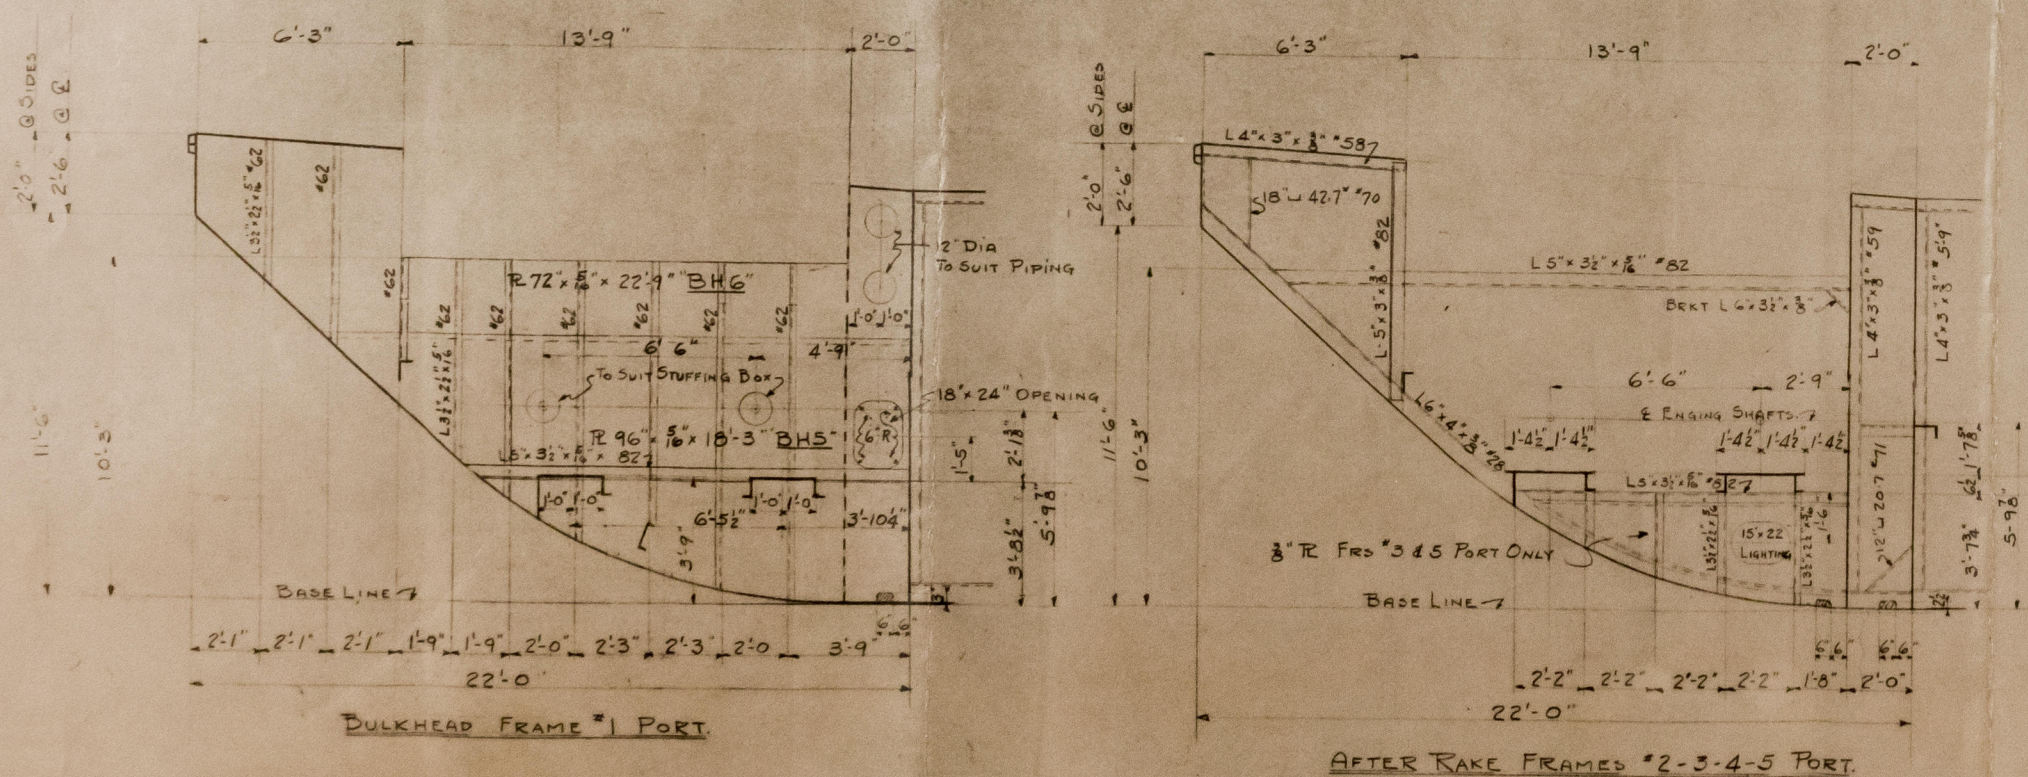
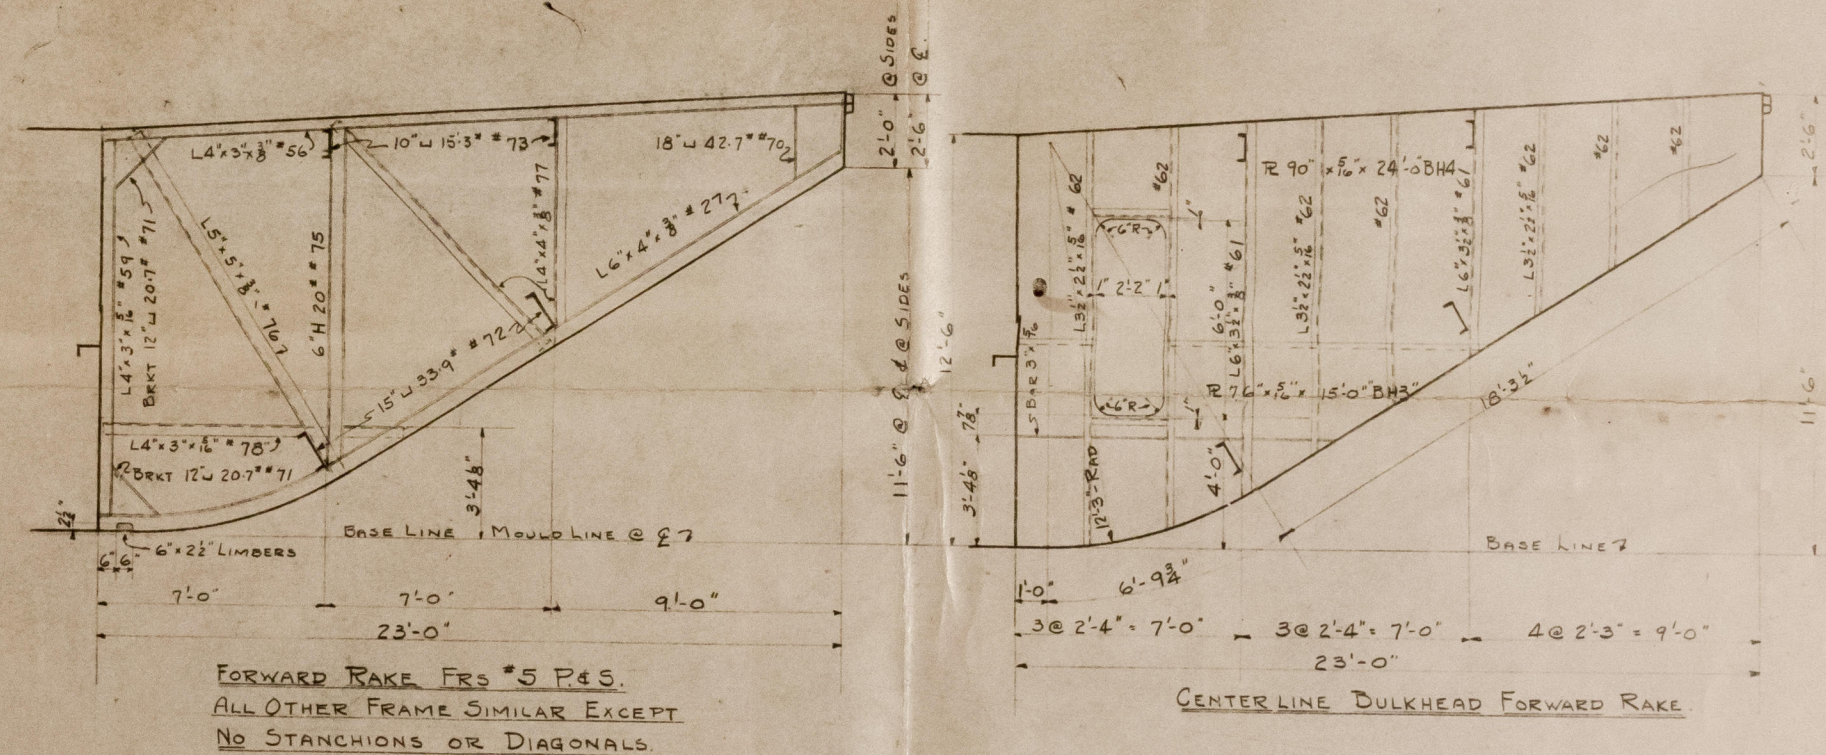
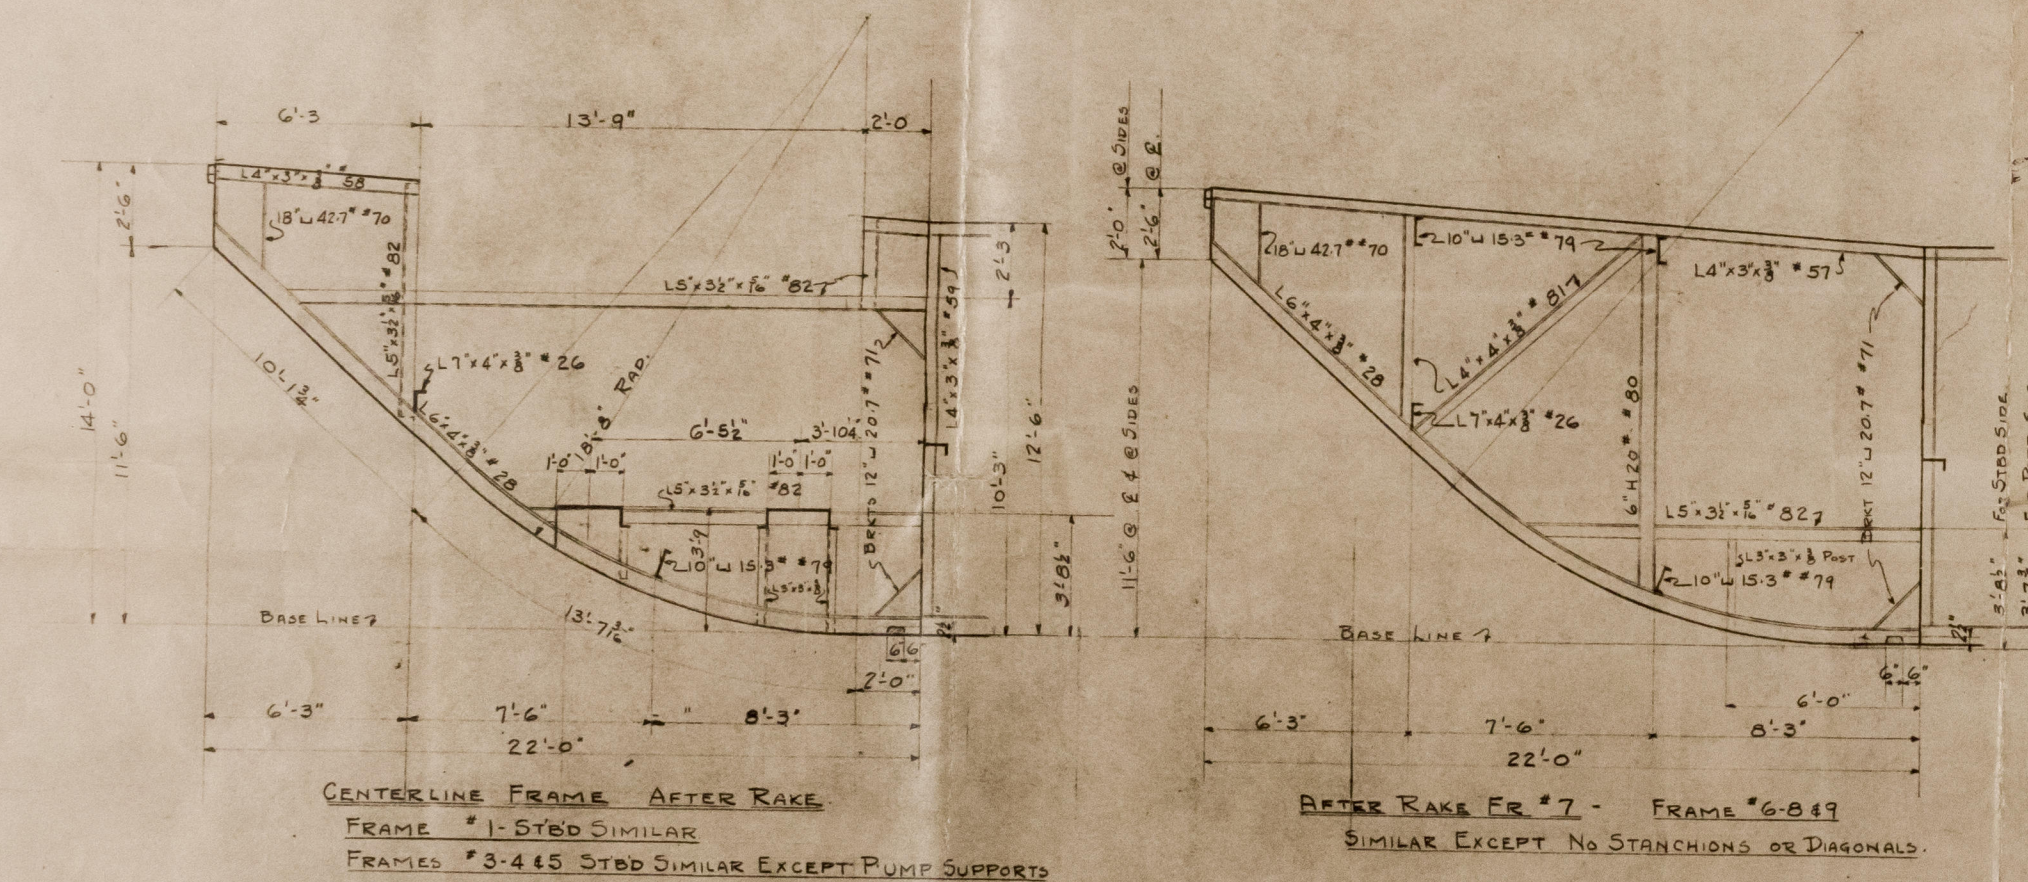
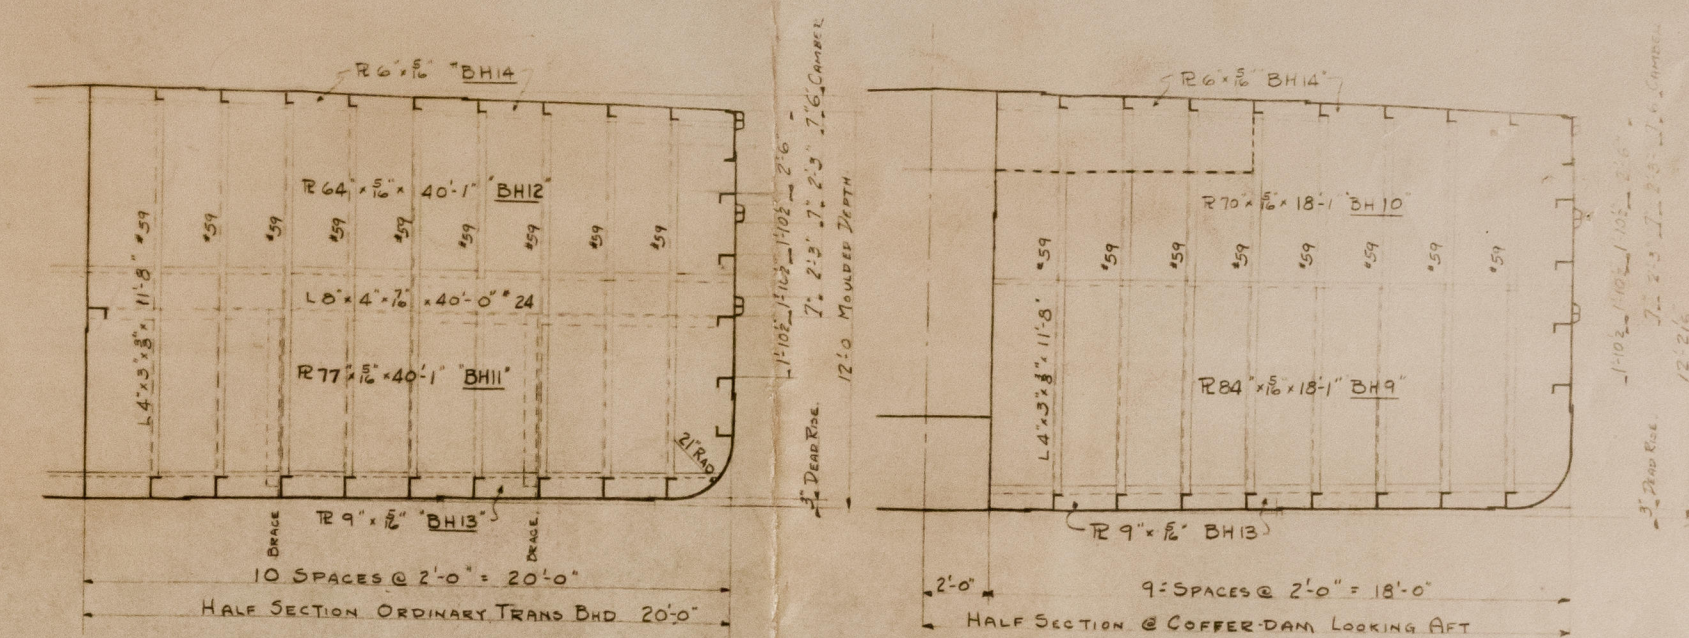


396-7-8

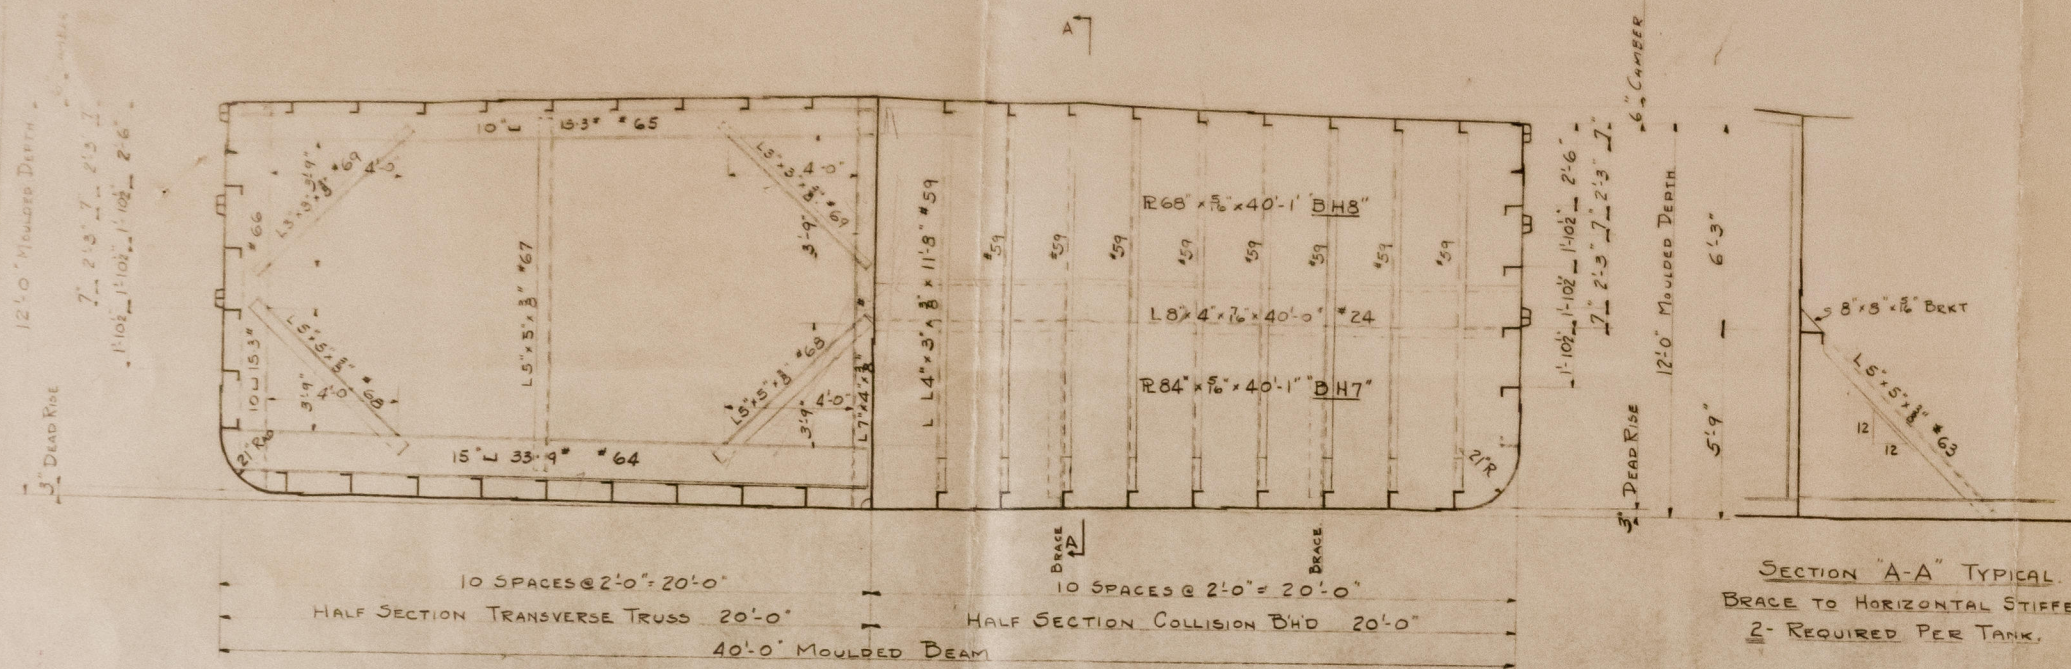

APPROVED
JAN 15 1937
LLOYD'S REGISTER OF SHIPPING
NEW YORK

HULL NO 66,67168 MD NO 2187
210'x40'x12' STEEL OIL BARGE
HULL DETAILS
ELECTRIC ARC WELDED CONSTRUCTION
DESIGNED BY J. H. G. & S. J. G.
CHECKED BY J. H. G. & S. J. G.
DATE FEB 12 1936
PENNSYLVANIA SHIPYARDS INC.
BEAUMONT TOWNSHIP DR NO 3-647