

30/1/29
Nos 944-5.

DIMNS 415'-0" B.P x 60'-0" MLD. x 32'-9" MLD. TO UPPER DK.


GENERAL ARRGT ELEVATION AND TOP DKS.

SCALE. 1/8" = 1 FOOT.

CAMBER 12" IN 60 FEET ON ALL DECKS.

TUMBLE HOME: UPPER DECK-NIL, BRIDGE DECK-3", PROM. DECK-12";
SHIPS SIDE IS STRAIGHT FROM TOP OF PROM. DECK SHEERSTRAKE
TO 17" INSIDE MLD. LINE AT BOAT DECK.

SHEER FORWARD 8'-0". AFT 4'-6".

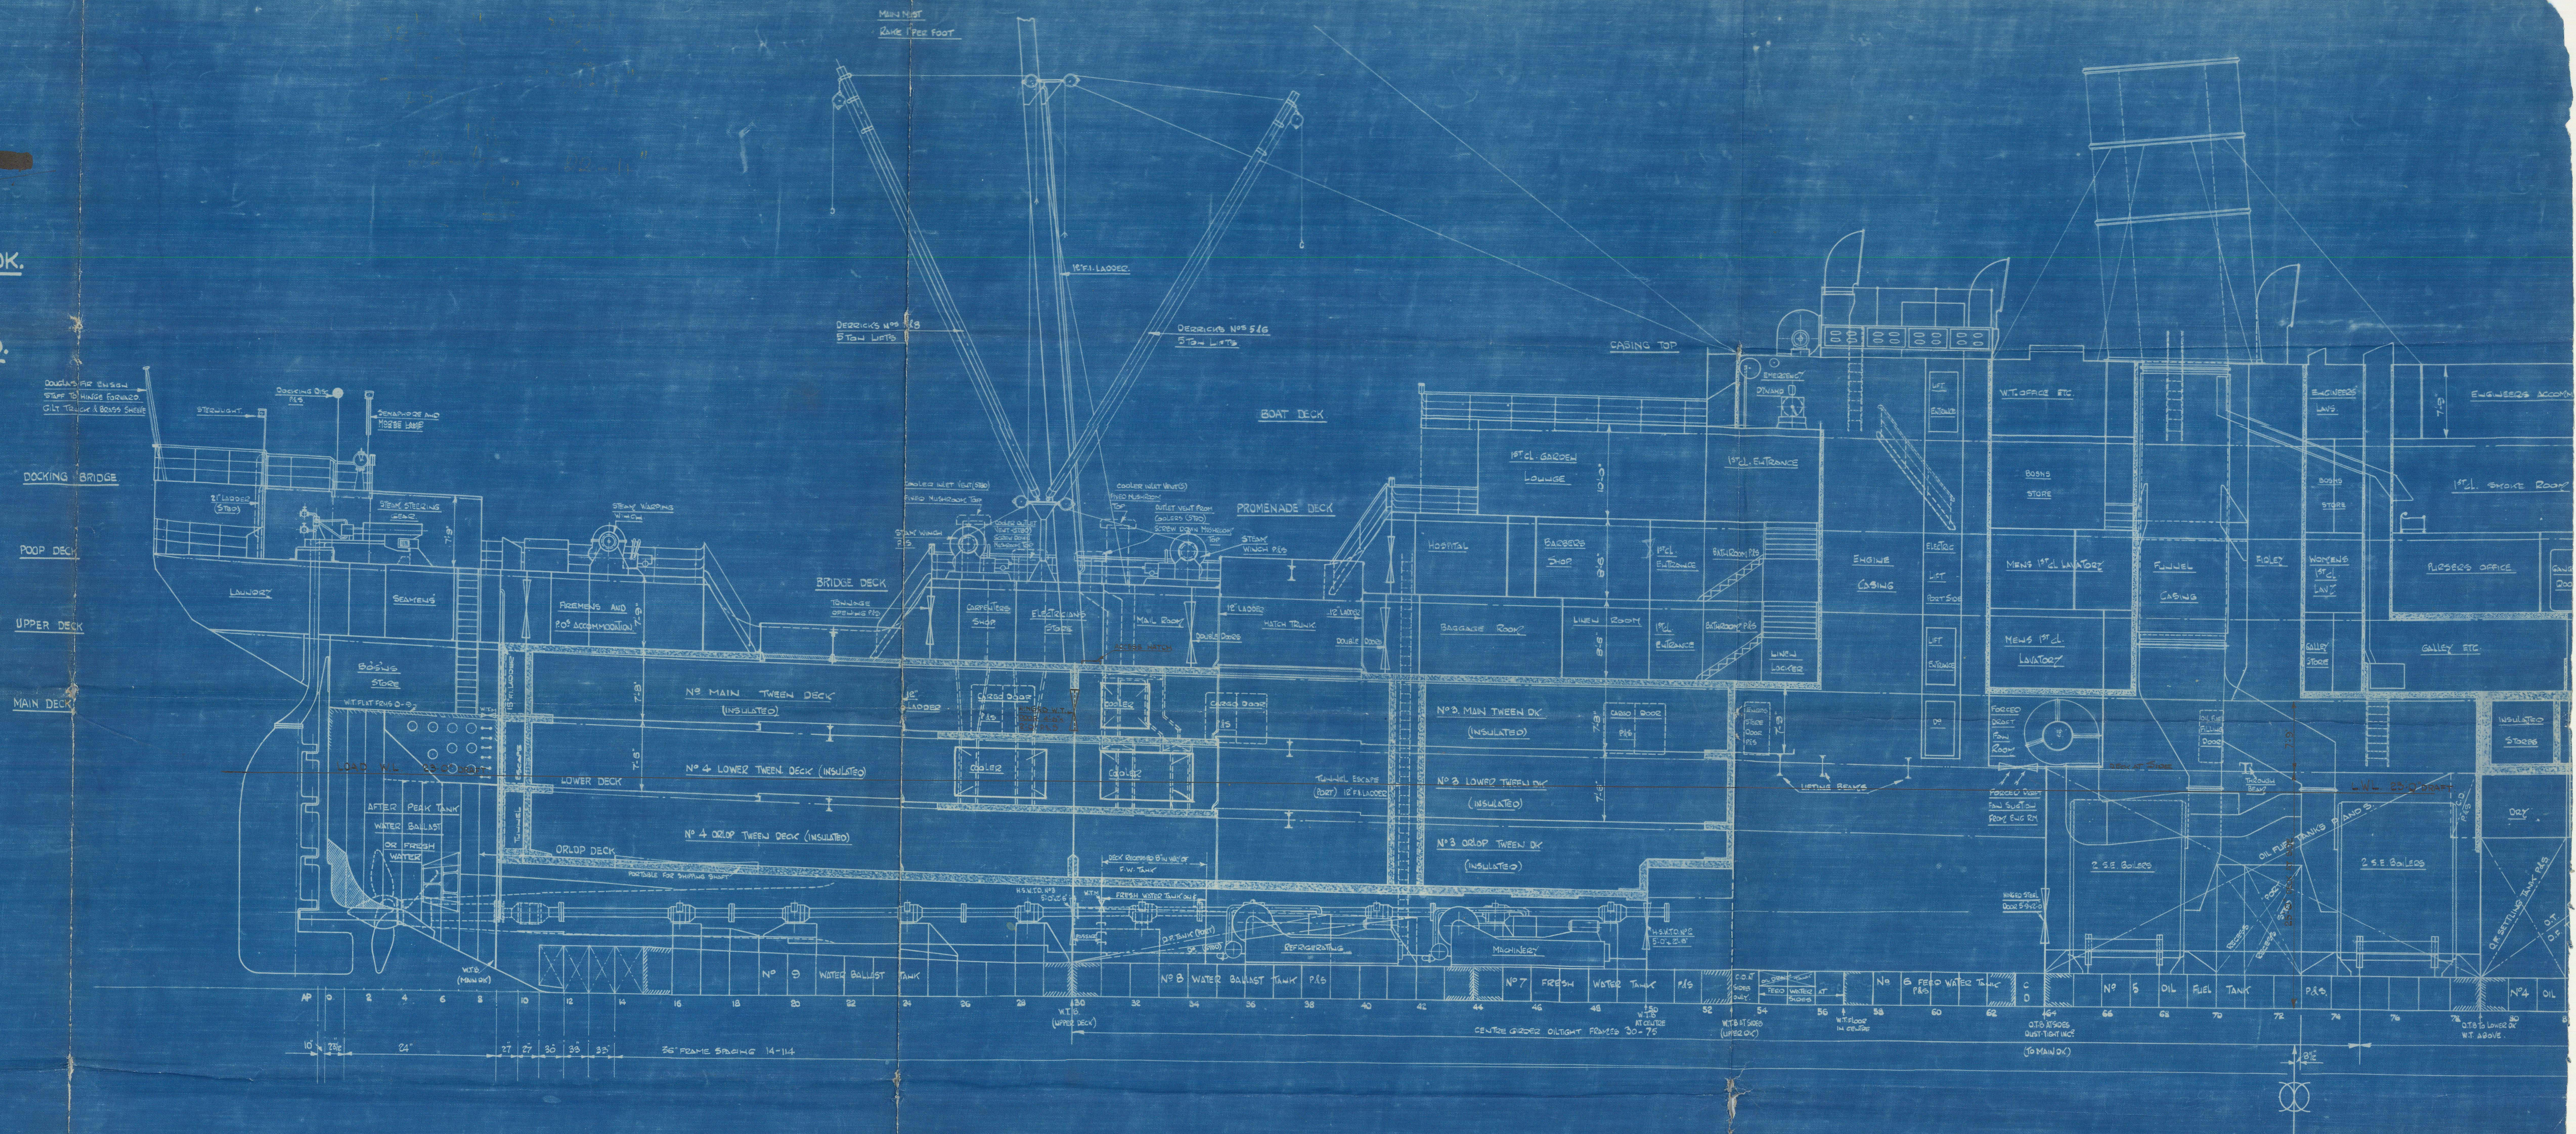

Approved for hullhead doors only.


W.S.
30.1.29

Thin 141 (not raw)

Cammell Laird & Co's

944/5

General arrangement
elevation and top decks

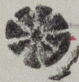 S. S. *Lady Somers*

LIVERPOOL

Report No. *95129*

D/S

754

S. S. *Lady Rodney*

LIVERPOOL

Report No. *95252*

PLANS TRANSFERRED
TO SISTER VESSEL

* MECCA *



Lloyd's Register
Foundation

012423-012430-0130