


COOK WELTON & GEMMELL, LTD
SHIPBUILDERS.
BEVERLEY.

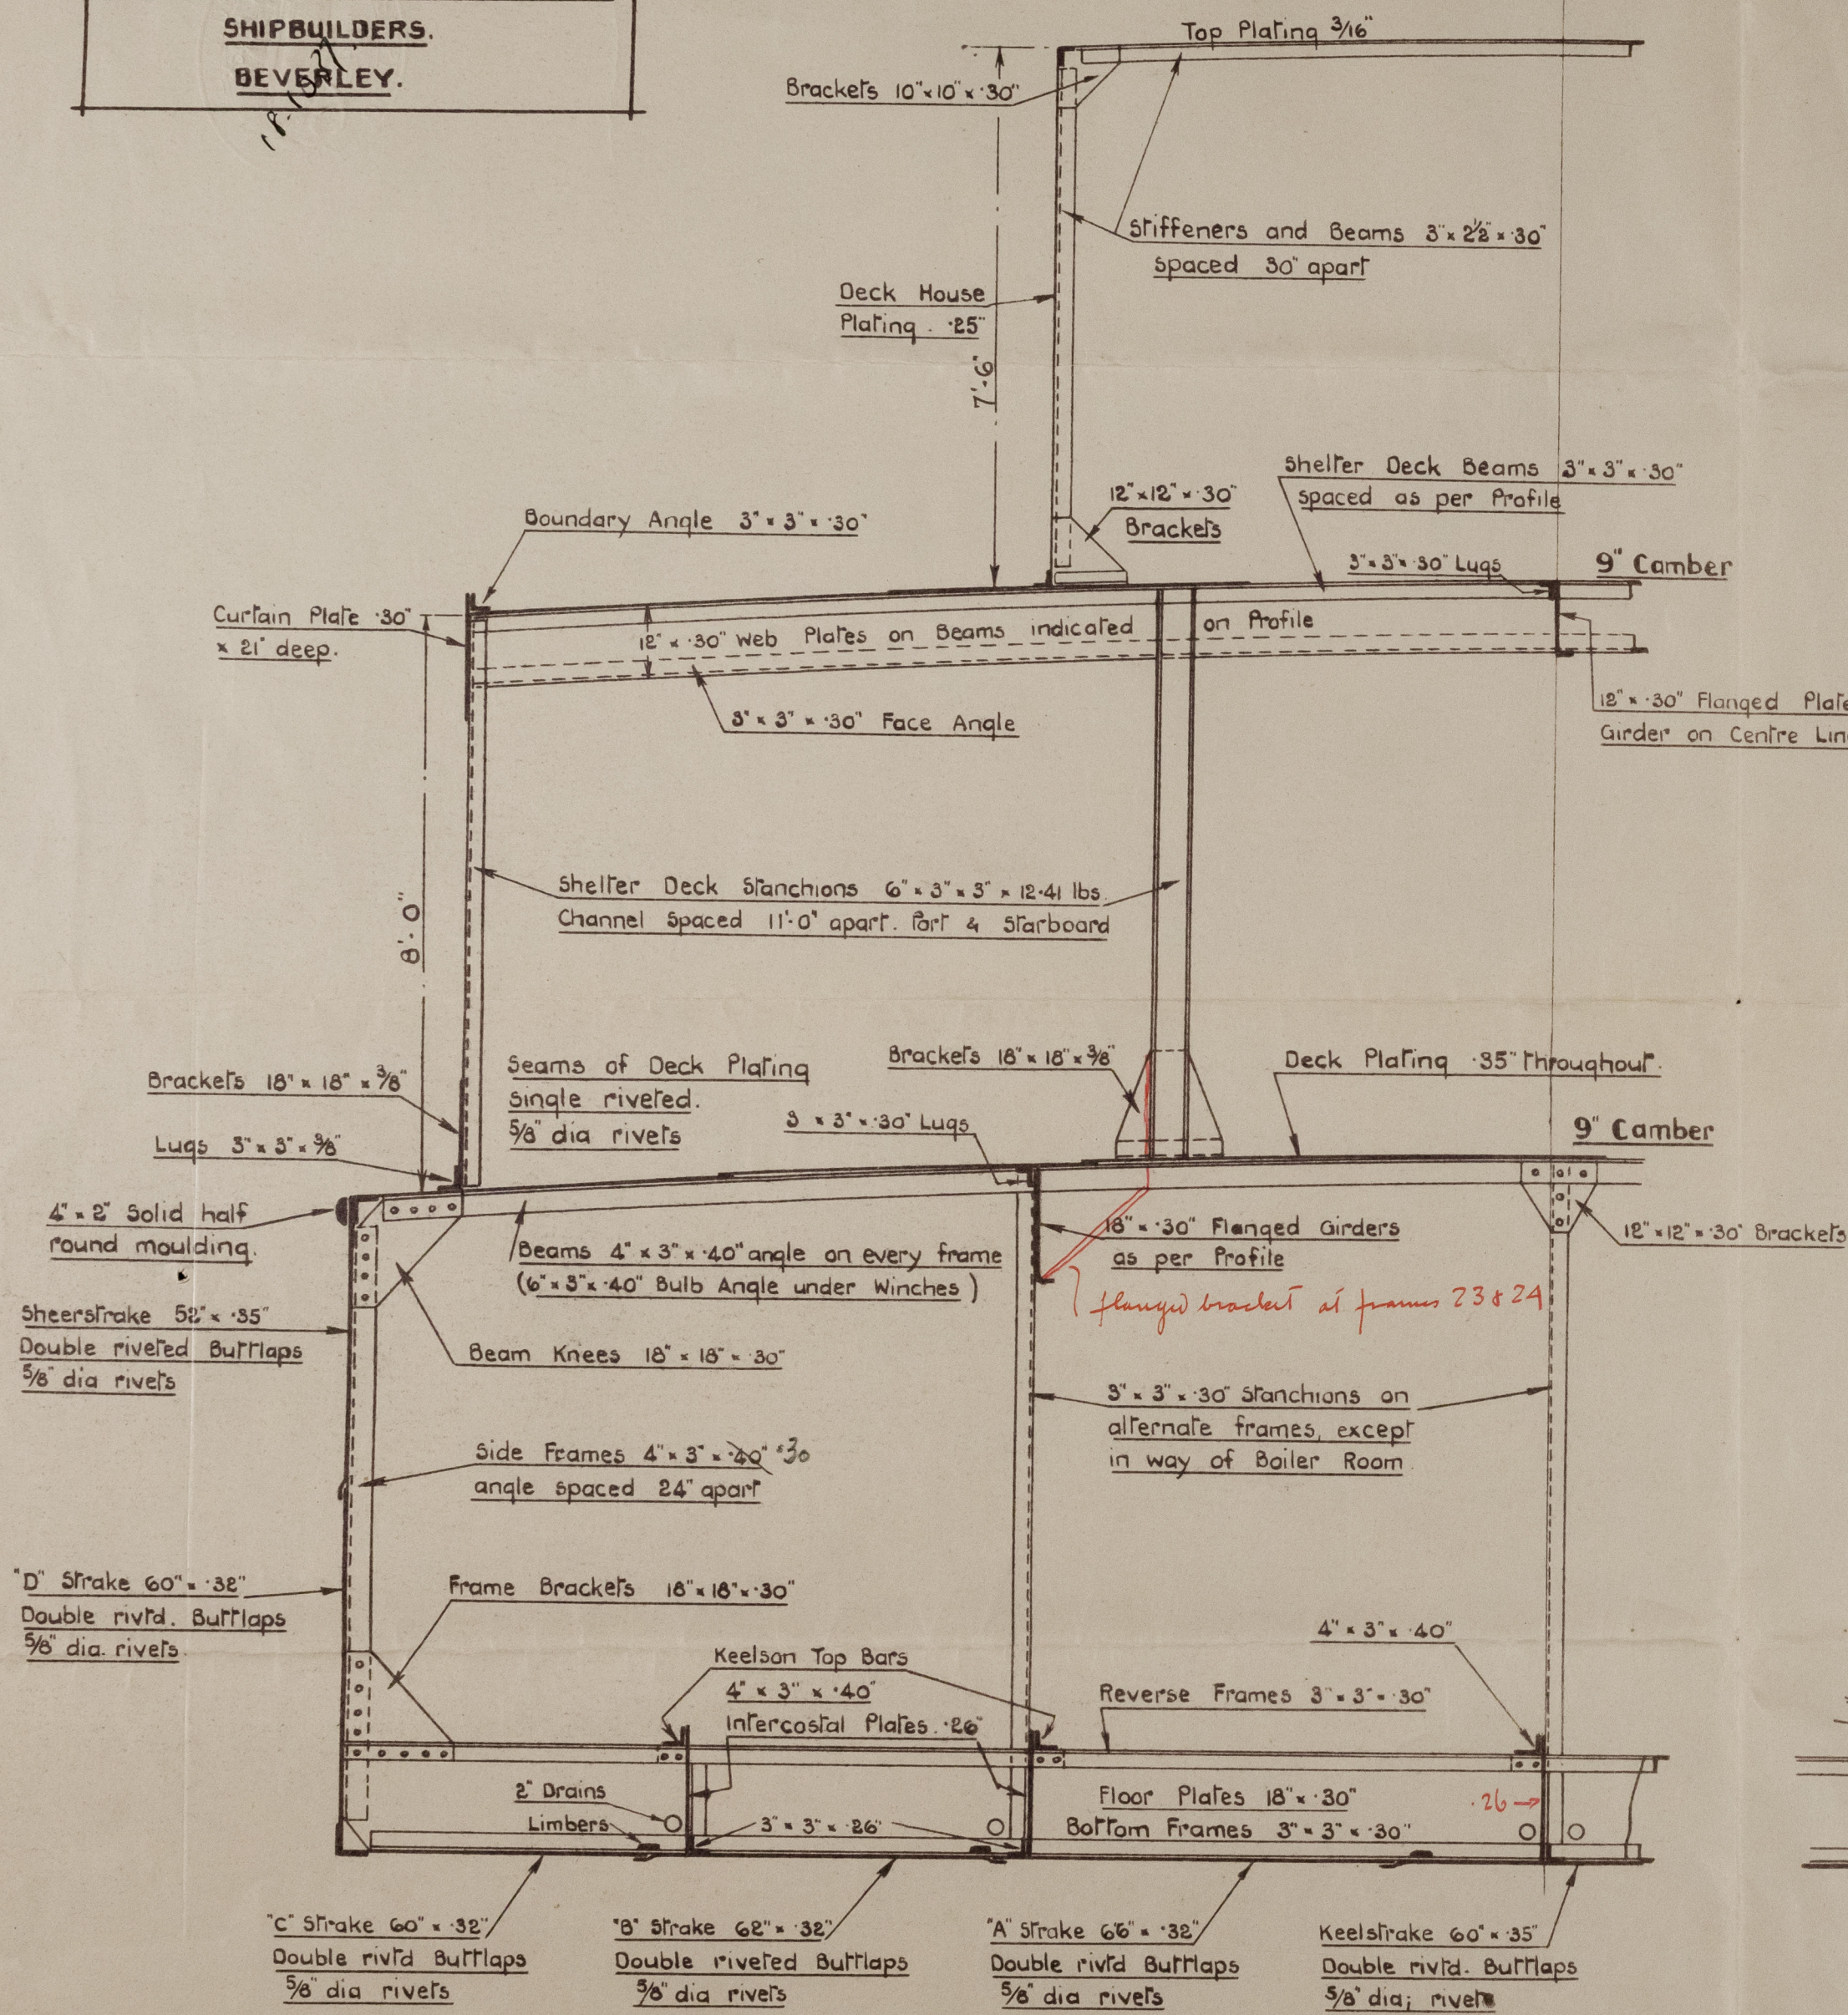

SECTION THRO' STORE


YARD No. 643. ROCKBREAKER PONTON. MIDSHIP SECTION.

100 A — "Pontoon Barge" with notation "Rockbreaker"
 CLASS. LLOYDS * 100 A.I. ROCKBREAKER

DIMS 105'-0" B.P. x 33'-0" B.M.L. x 9'-0" D.M.L.

SCALE $\frac{1}{2}" = 1$ Ft.

Equipment to be submitted

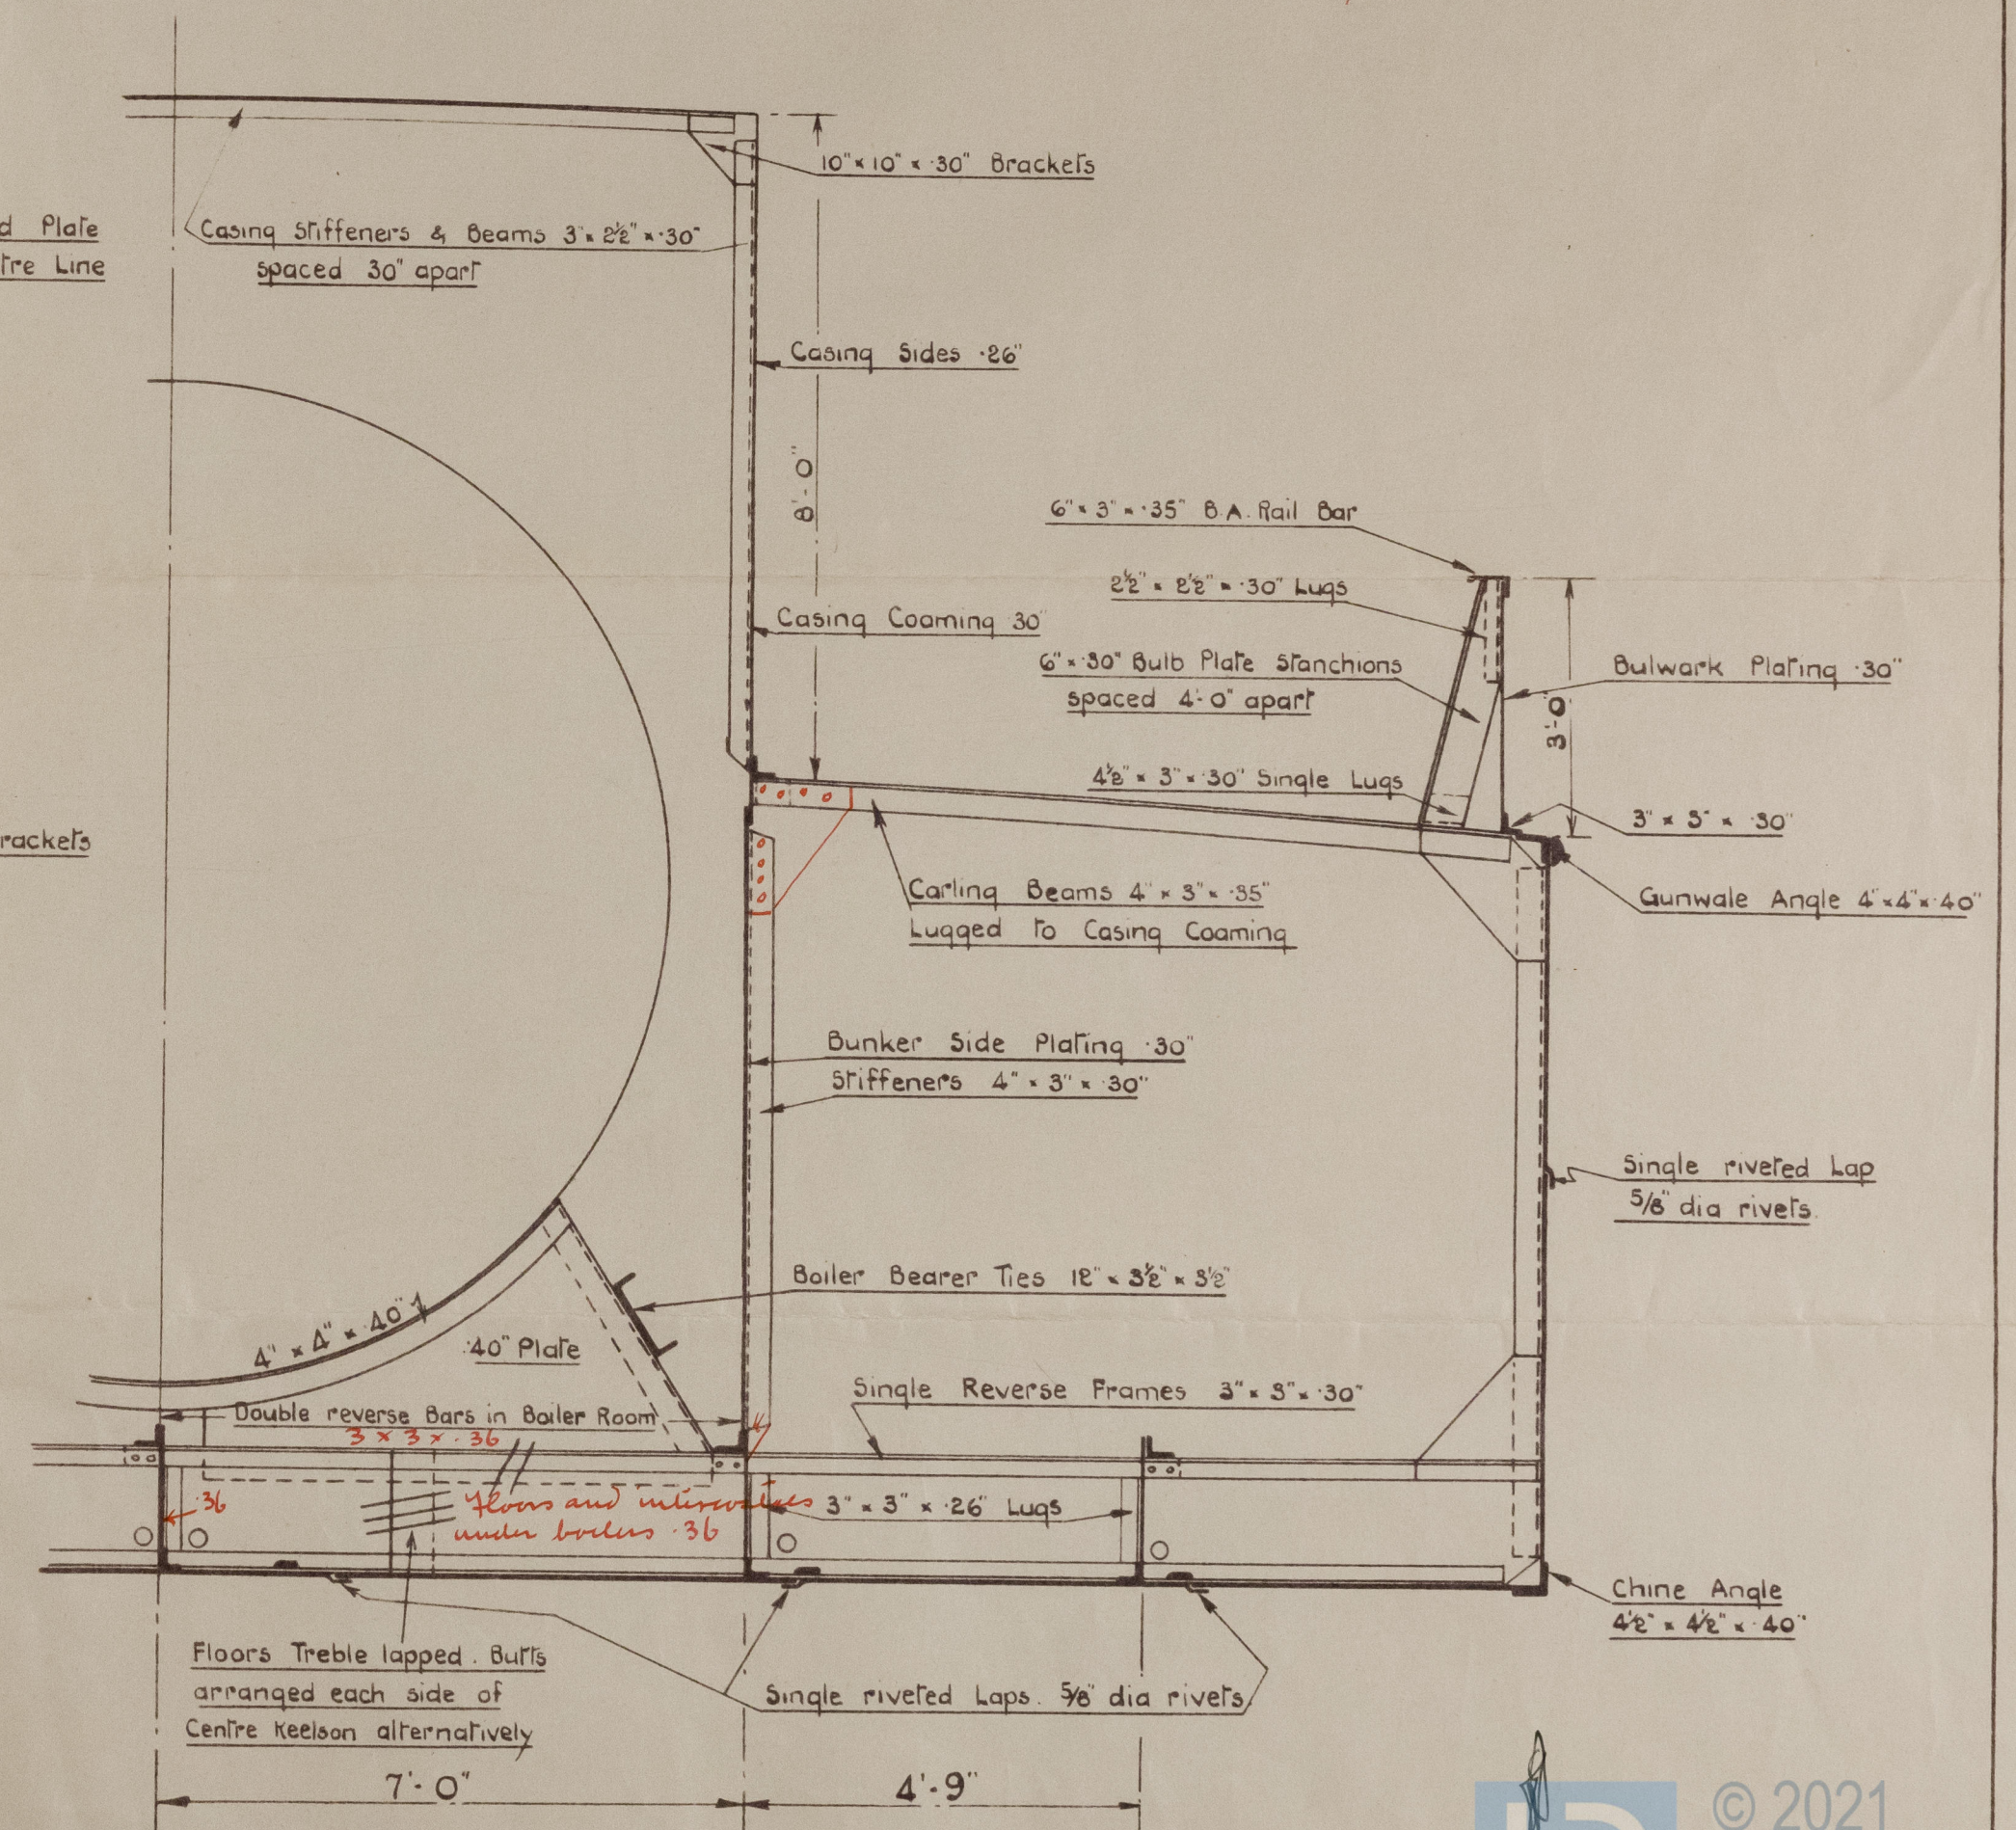

SECTION THRO' BOILER ROOM

HULL

Book Welton & Gemmell Ltd

Yard No. 643

(Rockbreaker Pontoon)

Plan of Midship Section

S.S. James Rockbreakers VII

HULL REPORT No. 48776



© 2021

Lloyd's Register
Foundation

012423-012430-0273