

LORD ISLINGTON

For the information of Surveyors and the Committee only.

Received at

4 NOV. 1924

Office

19

Lloyd's Register of Shipping.

(Report on Vessel No. Hull Port Hull)

Report No. 35824

No.

SHIP FORGINGS OR CASTINGS.

I have to report that the undermentioned Iron or Steel Forgings or Castings, manufactured by Messrs J. S. Forster & Son Ltd of Sunderland for the Vessel No. 947, being built by Cochrane & Son Ltd of Selby have been inspected by me as set forth below and found to be, so far as can be seen, Sound

Mark on Forgings or Castings.

Lloyd's

No. 3564



D. D. Williamson

Sunderland 1-11-24



	STERN FRAME.	RUDDER FRAME.	STEM.		
Material*	<u>Scrap Iron</u>	/	/		
How made	<u>Forged</u>				
Dimensions	<u>6" x 3 1/4"</u>				
Progress on Inspection	<u>Forged & Finished</u>				
Date when Inspected	<u>21-10-24 to 31-10-24</u>				
CASTINGS.					
Tests on Standard Test Pieces.					
Tensile Test—					
Tons per square inch					
Extension per cent. ...					
Cold Bending Test—					
Angle before fracture					
Drop Test—					
Height from ground ...					
Hammering Test—					
If made according to Rules and found satisfactory ...					


SKETCHES OF FRAMES SHOWING POSITION AND DESCRIPTION OF WELDS OF FORGINGS.

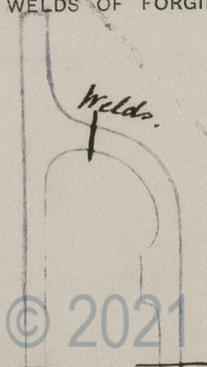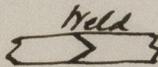

Fee (if any chargeable) £ : :

To be paid at

* If of Iron, state whether scrap or puddled Iron. If of Steel, state whether made on the Open Hearth process.

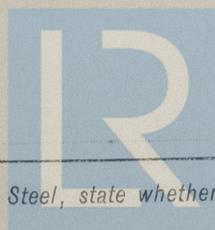

© 2021

Lloyd's Register Foundation