

S.S. "Greenisland"


~~PROPOSED~~ LENGTHENING

Midship Section.

C/S No. 24602



012446-012459-0064

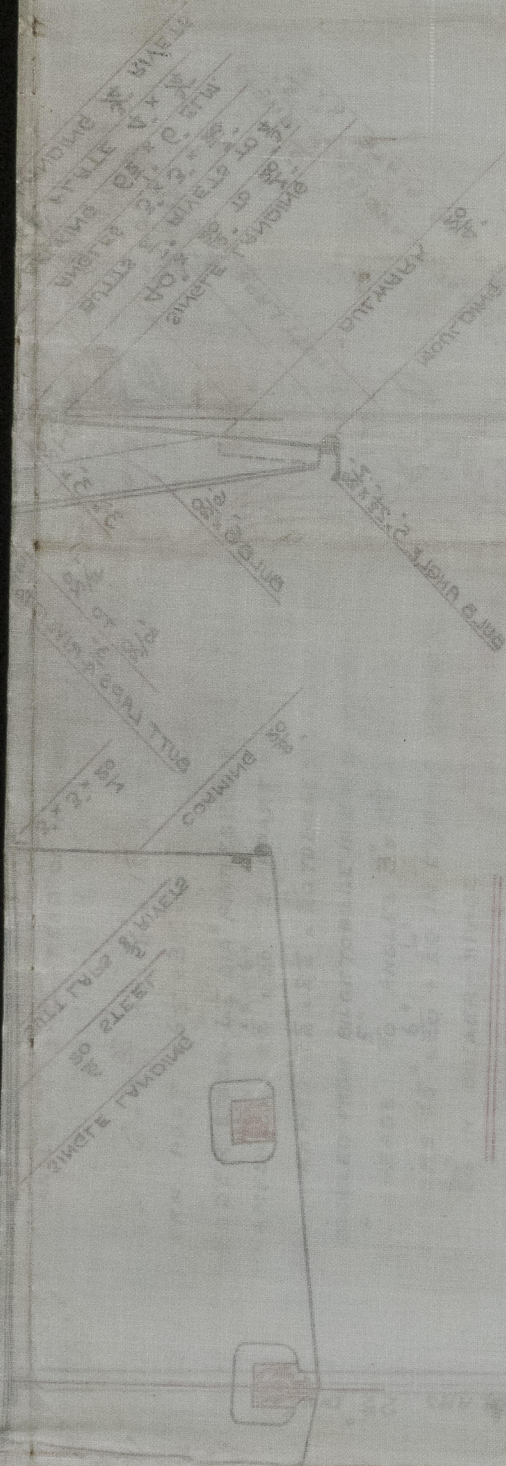







© 2021 Lloyd's Register Foundation