



—S.S. "GREENISLAND"—

—NEW DIMENSIONS:- 144'-3" x 22'-0" x 10'-0" M^{LD}—

—SCALE $\frac{1}{4}" = 1' \text{ FOOT}$ —

OLD DIMENSIONS 132'-0" x 22'-0" x 10'-0" M^{LD}

NEW MAIN DECK BEAMS $4" \times 2\frac{1}{2}" \times \frac{9}{20}$

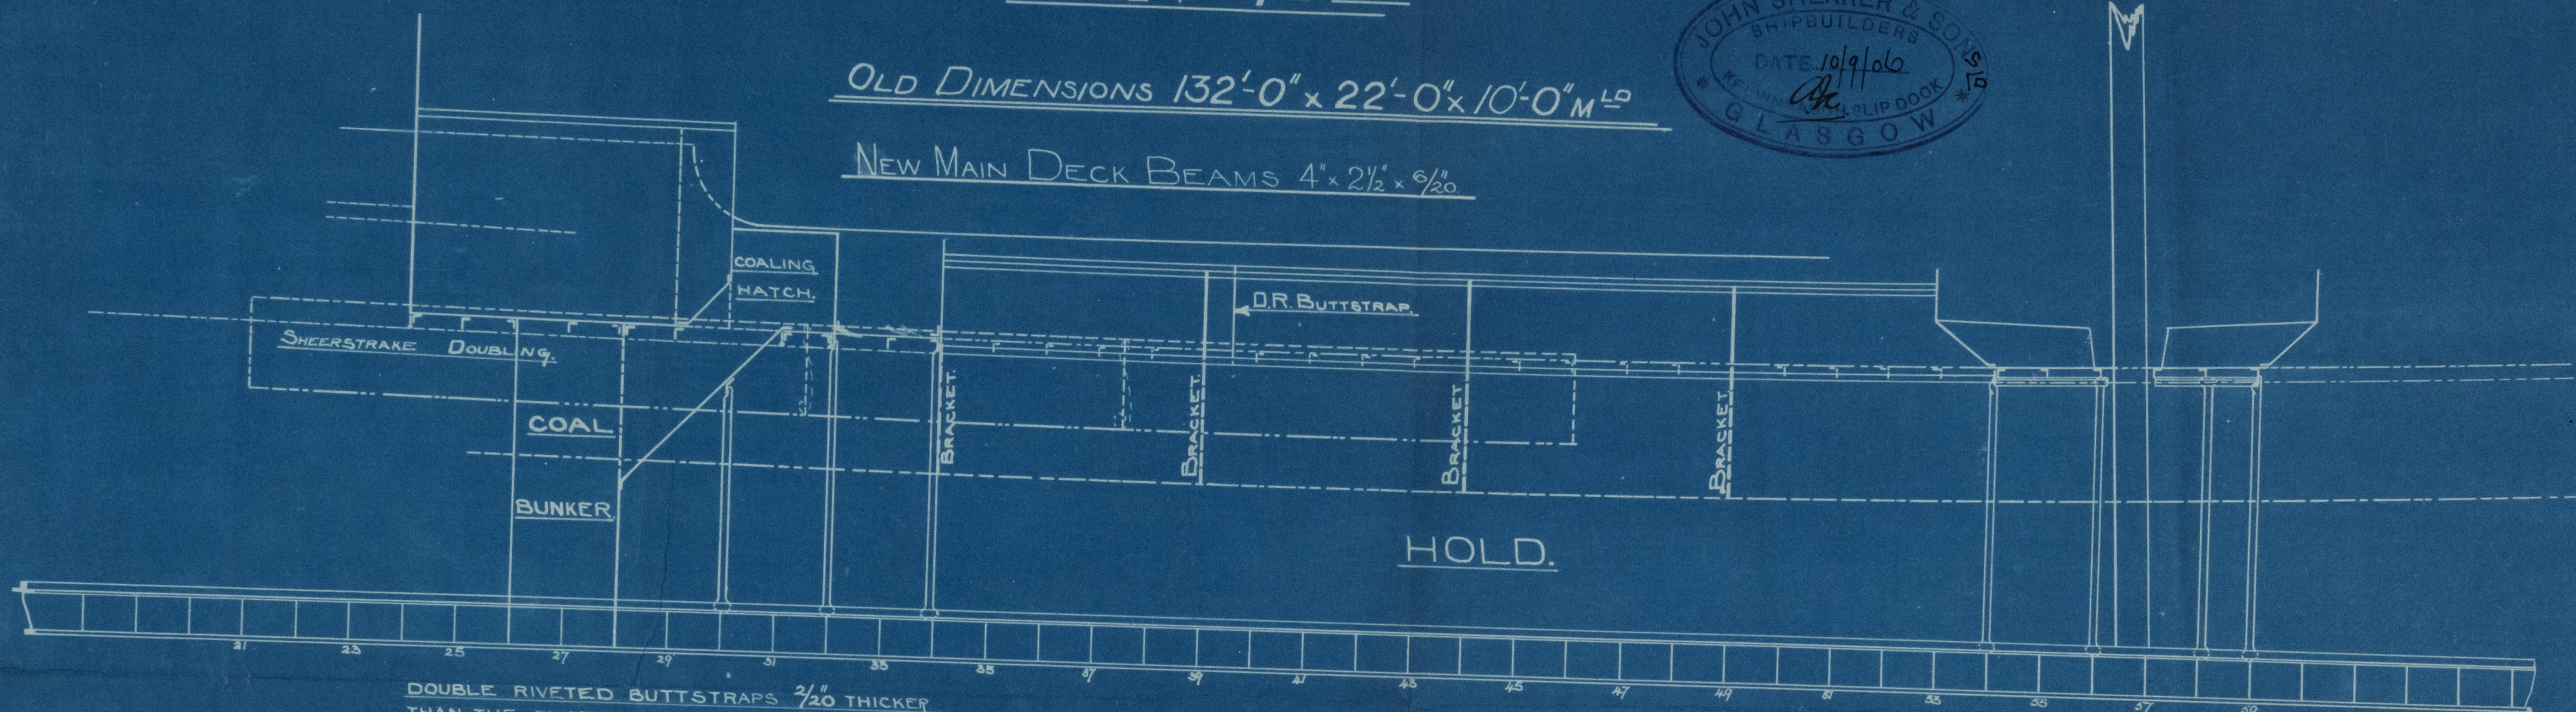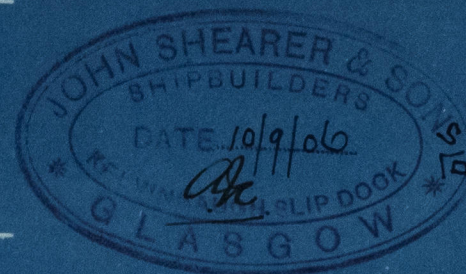

DOUBLE RIVETED BUTTSTRAPS $\frac{2}{20}$ THICKER THAN THE PLATES THEY CONNECT

— PLAN OF MAIN DECK. —



012446-012459-0065

S. S. 'Greenisland'
Lengthening.

Amended
Profile & deck plan.
Gls. rpt. No. 24602



012446 - 012459 - 0065



© 2021

Lloyd's Register
Foundation