

20.1.12
22.3.12 (1st 530.535)
536

MIDSHIP SECTION

STEEL SCREW TRAWLERS


N^o 524-589

DIMS LEN 133'-4" x 23'-0" EX x 12'-9" DEPTH MOULDED

SCALE $\frac{1}{2}$ " = ONE FOOT

PLAN No. 1132
FOR ENCLOSEURE TO
Messrs. Lloyd's Surveyors
Shull FROM
COCHRANE & SONS,
SHIPBUILDERS, SELBY
DATE Jan 17. 1912 RK

TO CLASS 100 A.I. FOR FISHING PURPOSES DECK PLATED OVER IN WAY OF
MACHINERY SPACE. ENGINE & BOILER CASING AS PREVIOUSLY APPROVED

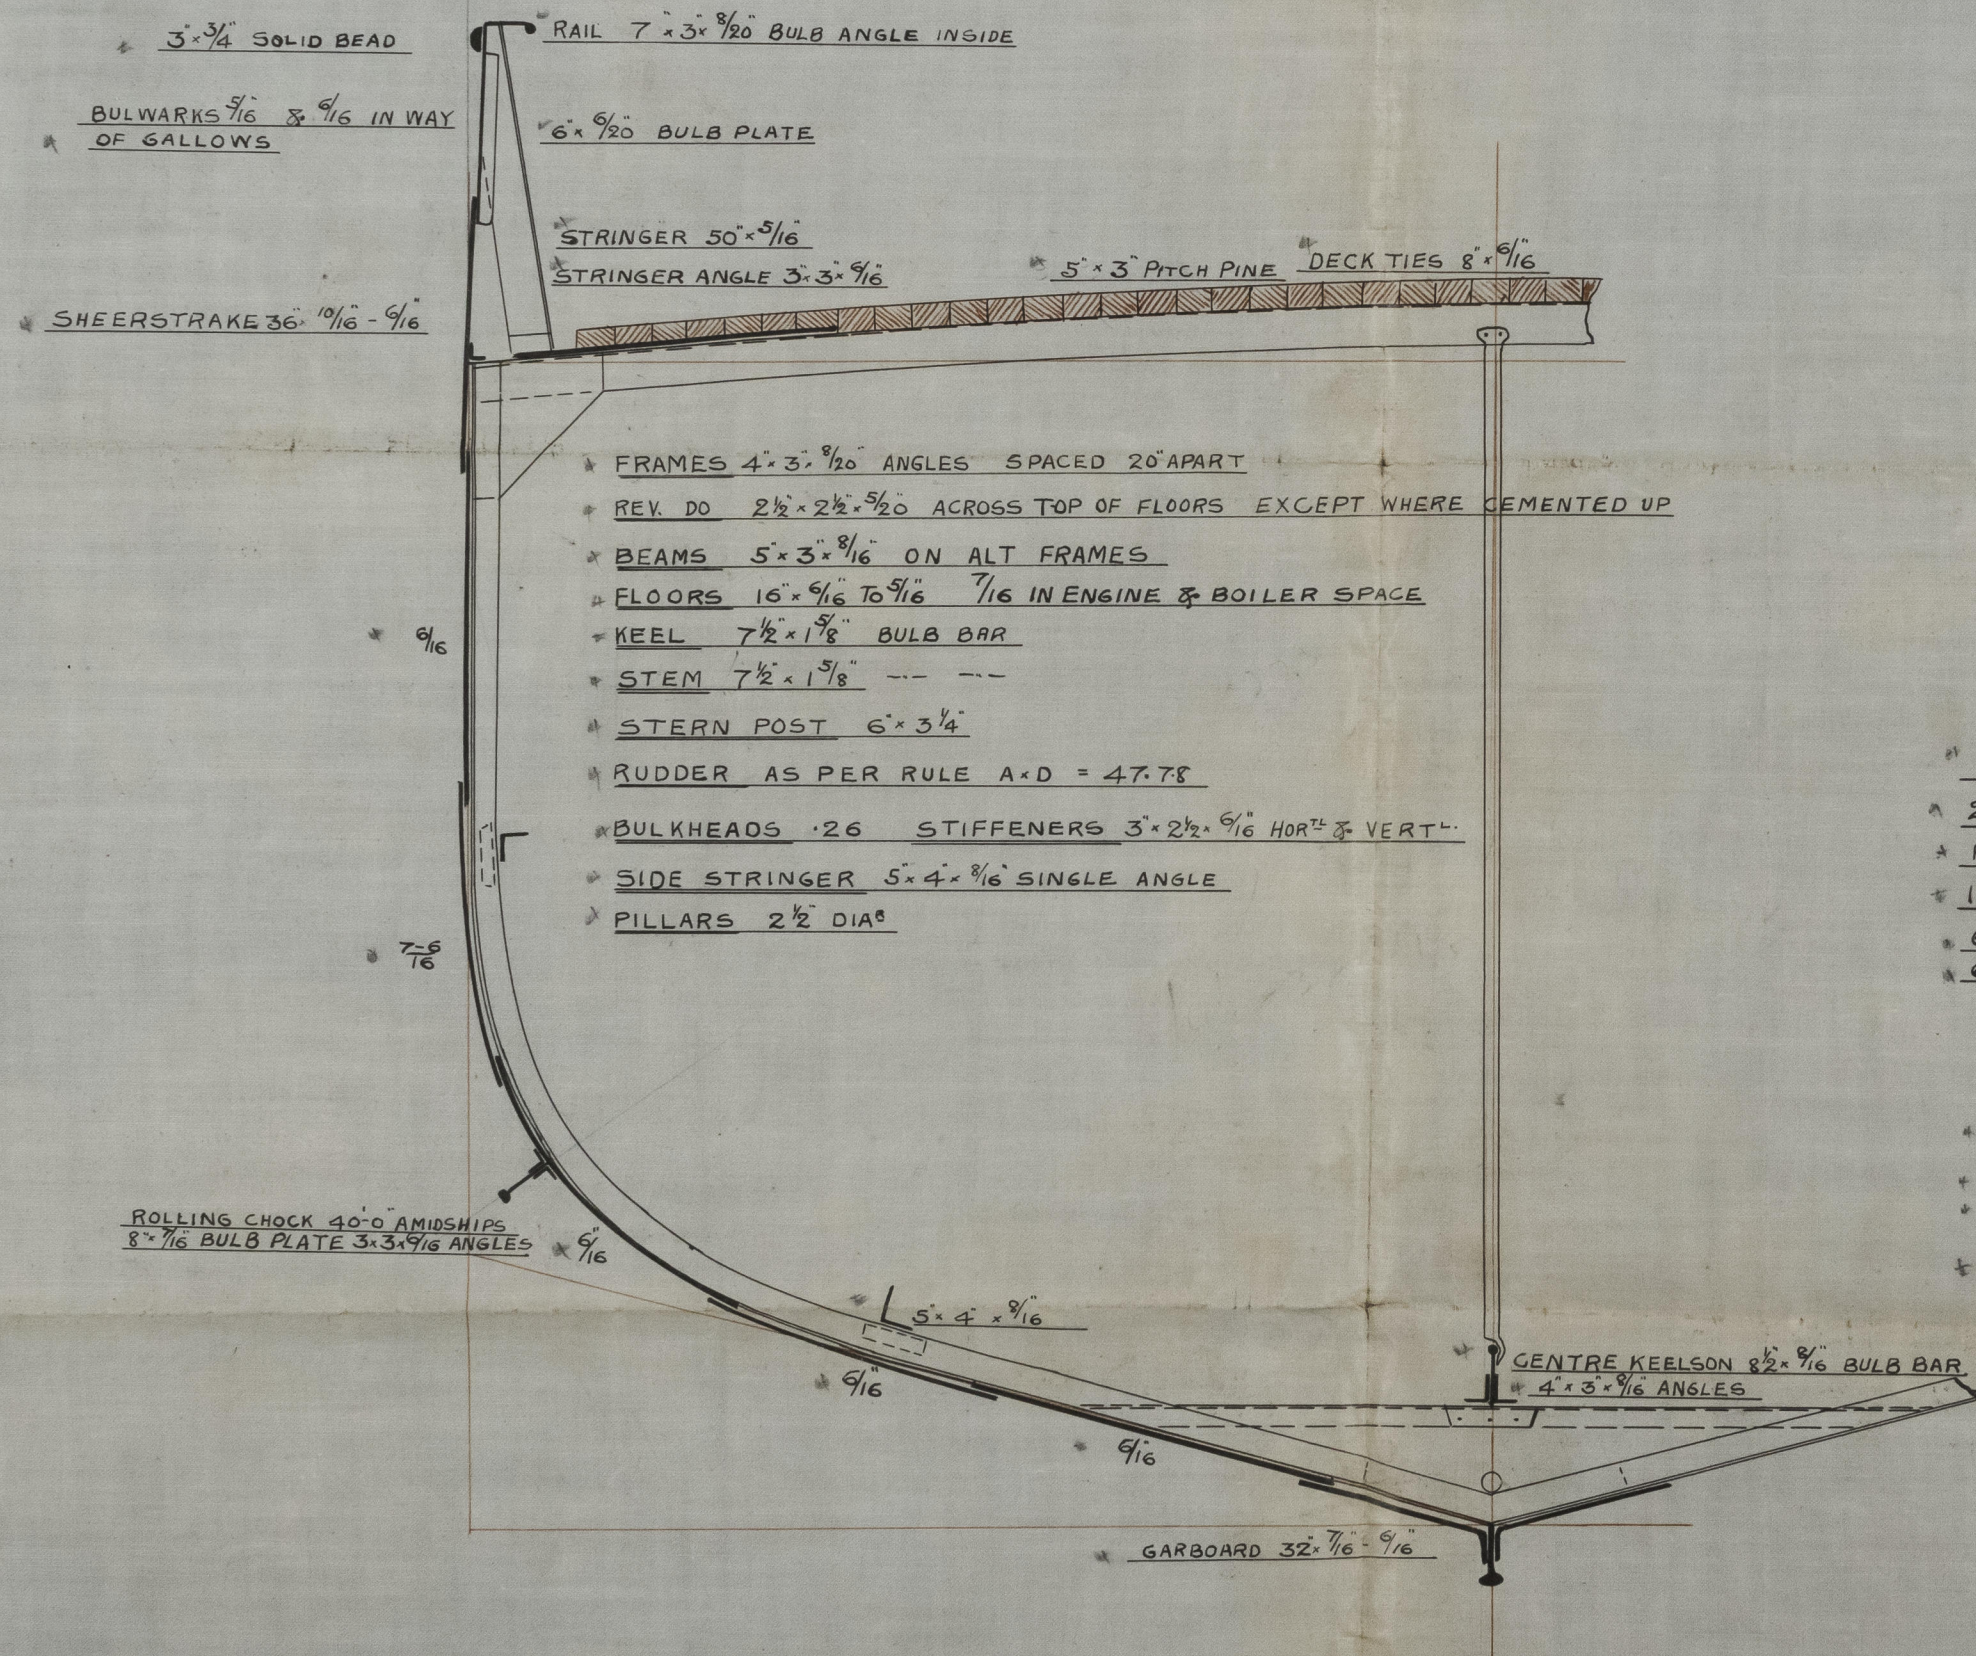

NUMERALS

$$\begin{aligned} * B+D &= 35.63 \\ * L(B+D) &= 4750.55 \end{aligned}$$

PROPORTIONS

$$\begin{aligned} \frac{L}{D} &= 10.45 \\ \frac{L}{B} &= 5.85 \end{aligned}$$

EQUIPMENT

1 st BOWER ANCHOR	5 3/4 CWTs EX STOCK
2 nd ---	5 1/4 ---
KEDGE ---	3 ---
105 FATHOMS	1 1/2 CABLE
60 ---	6" HAWSER
60 ---	5" WARP

RIVETING

- * BUTTS OF SHELL PLATING LAPPED & DOUBLE RIVETED
- * EXCEPT GARBOARD & SHEERSTRAKE WHICH ARE TO BE
- * STRAPPED & DOUBLE RIVETED. LANDINGS DOUBLE RIVETED
- * BULKHEADS SINGLE RIVETED.

filled
7-1-12
6-2-17

C.B.
20.1.12.



© 2021

Lloyd's Register
Foundation

012460-012472-0065

Cochman & Sons.

No. 524. 525. and 529.
530. 535. and 536

Midship Section.

524 s/s	Balfour Hull Rph	No	25162
525 "	Bonarhau	-	- 25163
529 "	Andrew Marvel	-	- 25250.
530 "	Lord Lister	-	- 25373.
535 "	Lora Carrington		25591.
536 "	Velia	X	

PLANS TRANSFERRED
TO SISTER VESSEL FAFE

Fafe
Santa Teresinha

Ex. Andrew
Marvel
Des Bay
190



© 2021

Lloyd's Register
Foundation

012460-012472-0065

Lloyd's Register
Foundation