


22. 3. 12 (N^o 530, 530+6)

STEEL SCREW TRAWLERS

DIMNS LEN. 133'4" 23'0" Ex x 12'9" DEPTH MOULDED

SCALE $\frac{1}{4}$ = ONE FOOT.

PLAN No. 1133
FOR ENCLOSEURE TO
Messrs Lloyds, Surveyors
Hull FROM
COCHRANE & SONS,
SHIPBUILDERS, SELBY.
DATE Jan 17th 1912. RK

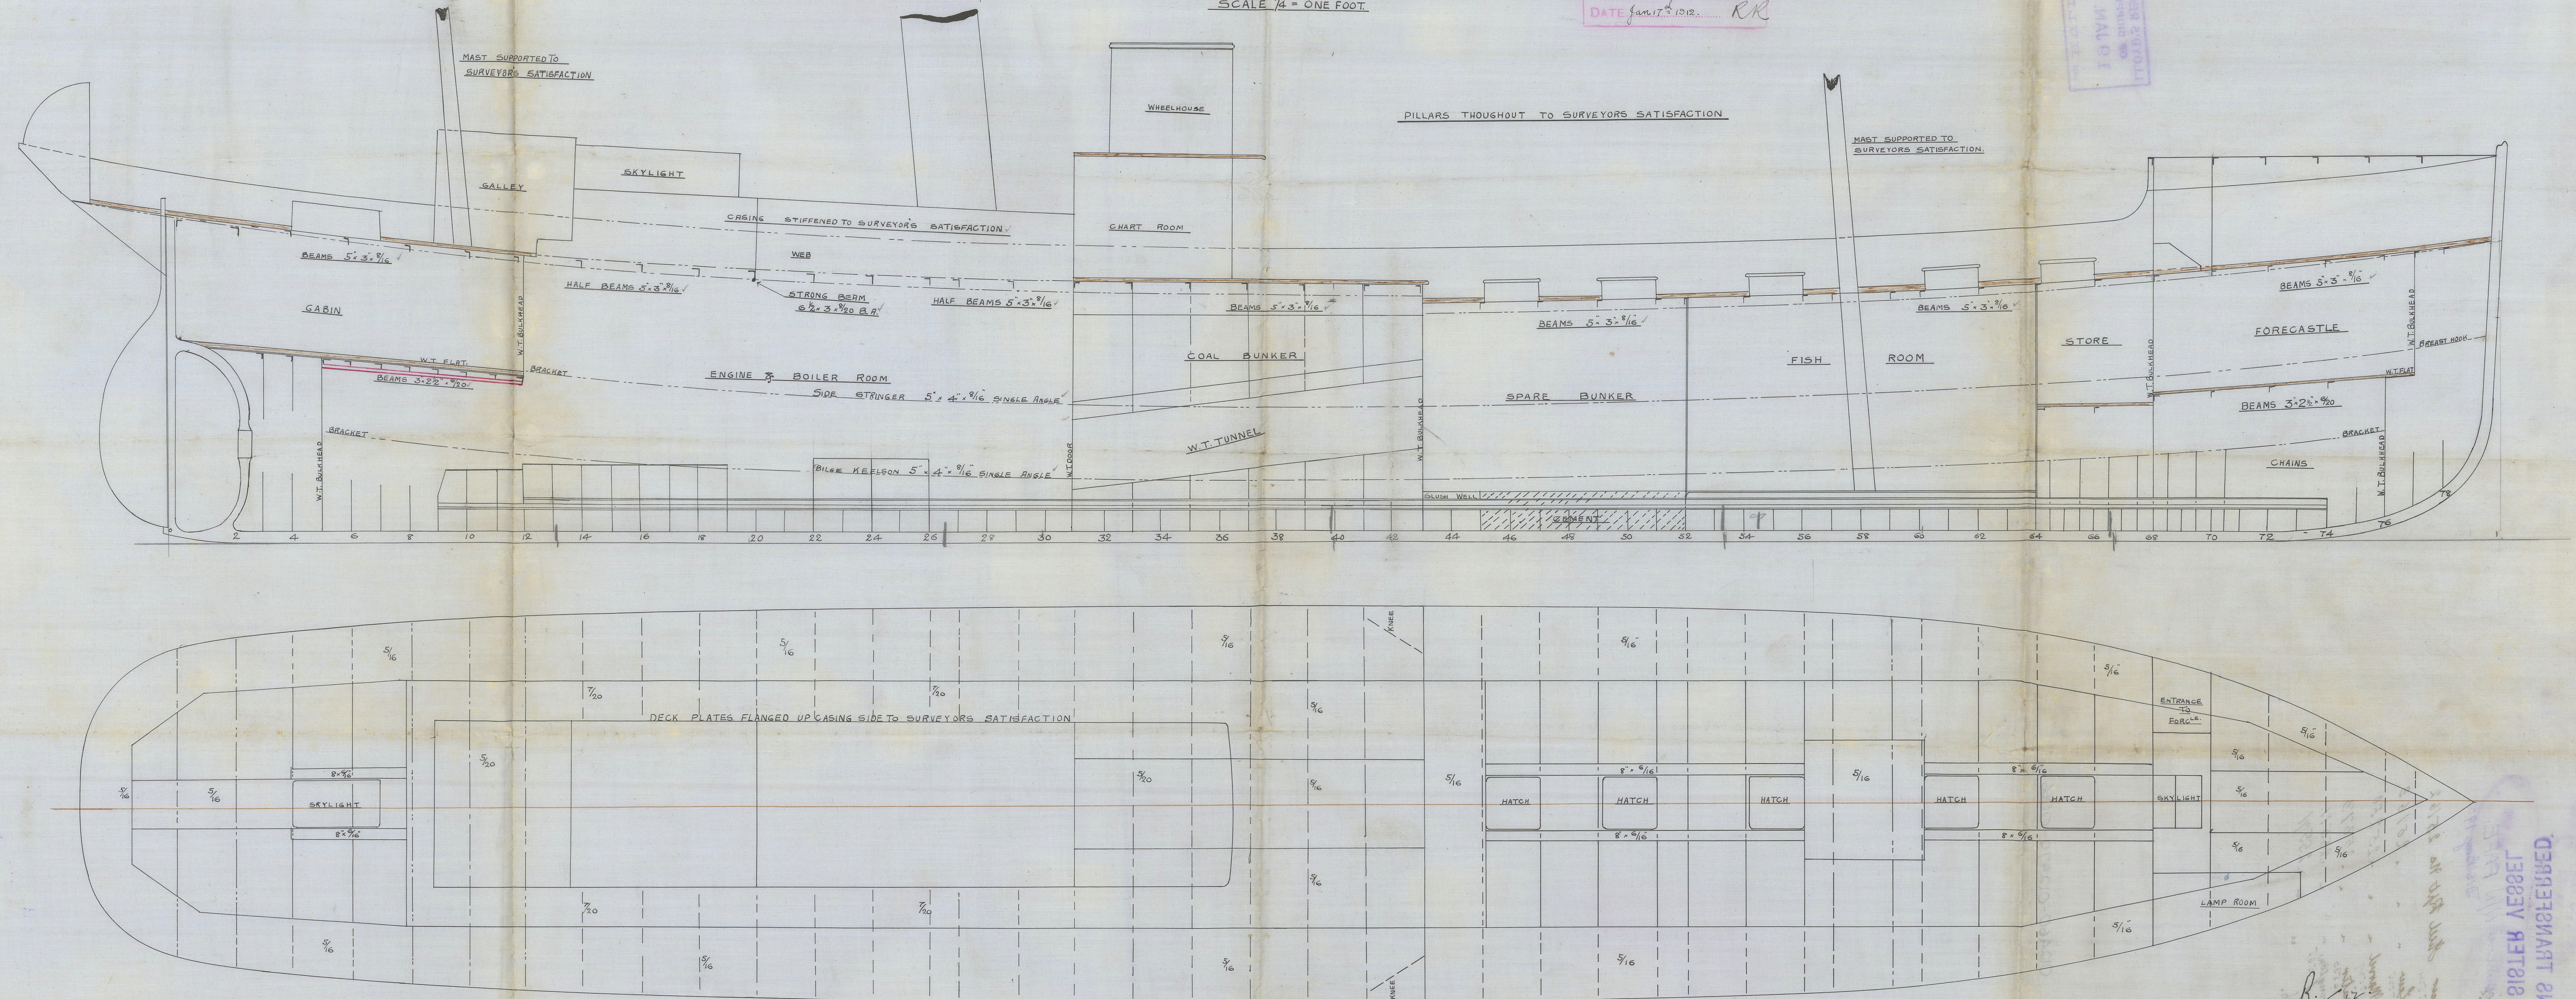

TO SISTER VESSEL
PLANS TRANSFERRED

230. 232 and 233
 16524, 252, 253, 254
 16524, 252, 253, 254

Cochrane & Sons

N^{os} 524, 525, 529,
530, 535 and 536

Profile & Deck Plan.

PLANS TRANSFERRED
TO SISTER VESSEL

Andrew Marvel N/N FAFE.
Dis Bay 190

• Belfour	Shull Rpt No 25162
• Bonar Law	" " 25163.
• Andrew Marvel	" " 25250
• Lord Diater	" " 25373
• Lord Carrington	" " 25511.
• Kelvin	" " 25591

012460-012472-0066



© 2021

Lloyd's Register
Foundation