

PLAN No. 743
 FOR ENCLOSURE TO
 Messrs Lloyd's Surveyors
 Hull FROM
 COCHRANE & SONS,
 SHIPBUILDERS, SELBY.
 DATE 11/7/12

MIDSHIP SECTION

STEEL SCREW TRAWLERS

N^o 524-589


DIM^{ns} LEN 133'-4" x 23'-0" EX x 12'-9" DEPTH MOULDED

SCALE 1/2" = ONE FOOT

Messrs Lloyd's Surveyors
 Hull

Jan 17. 1912. RK

TO CLASS 100 A1 FOR FISHING PURPOSES DECK PLATED OVER IN WAY OF
 MACHINERY SPACE. ENGINE & BOILER CASING AS PREVIOUSLY APPROVED

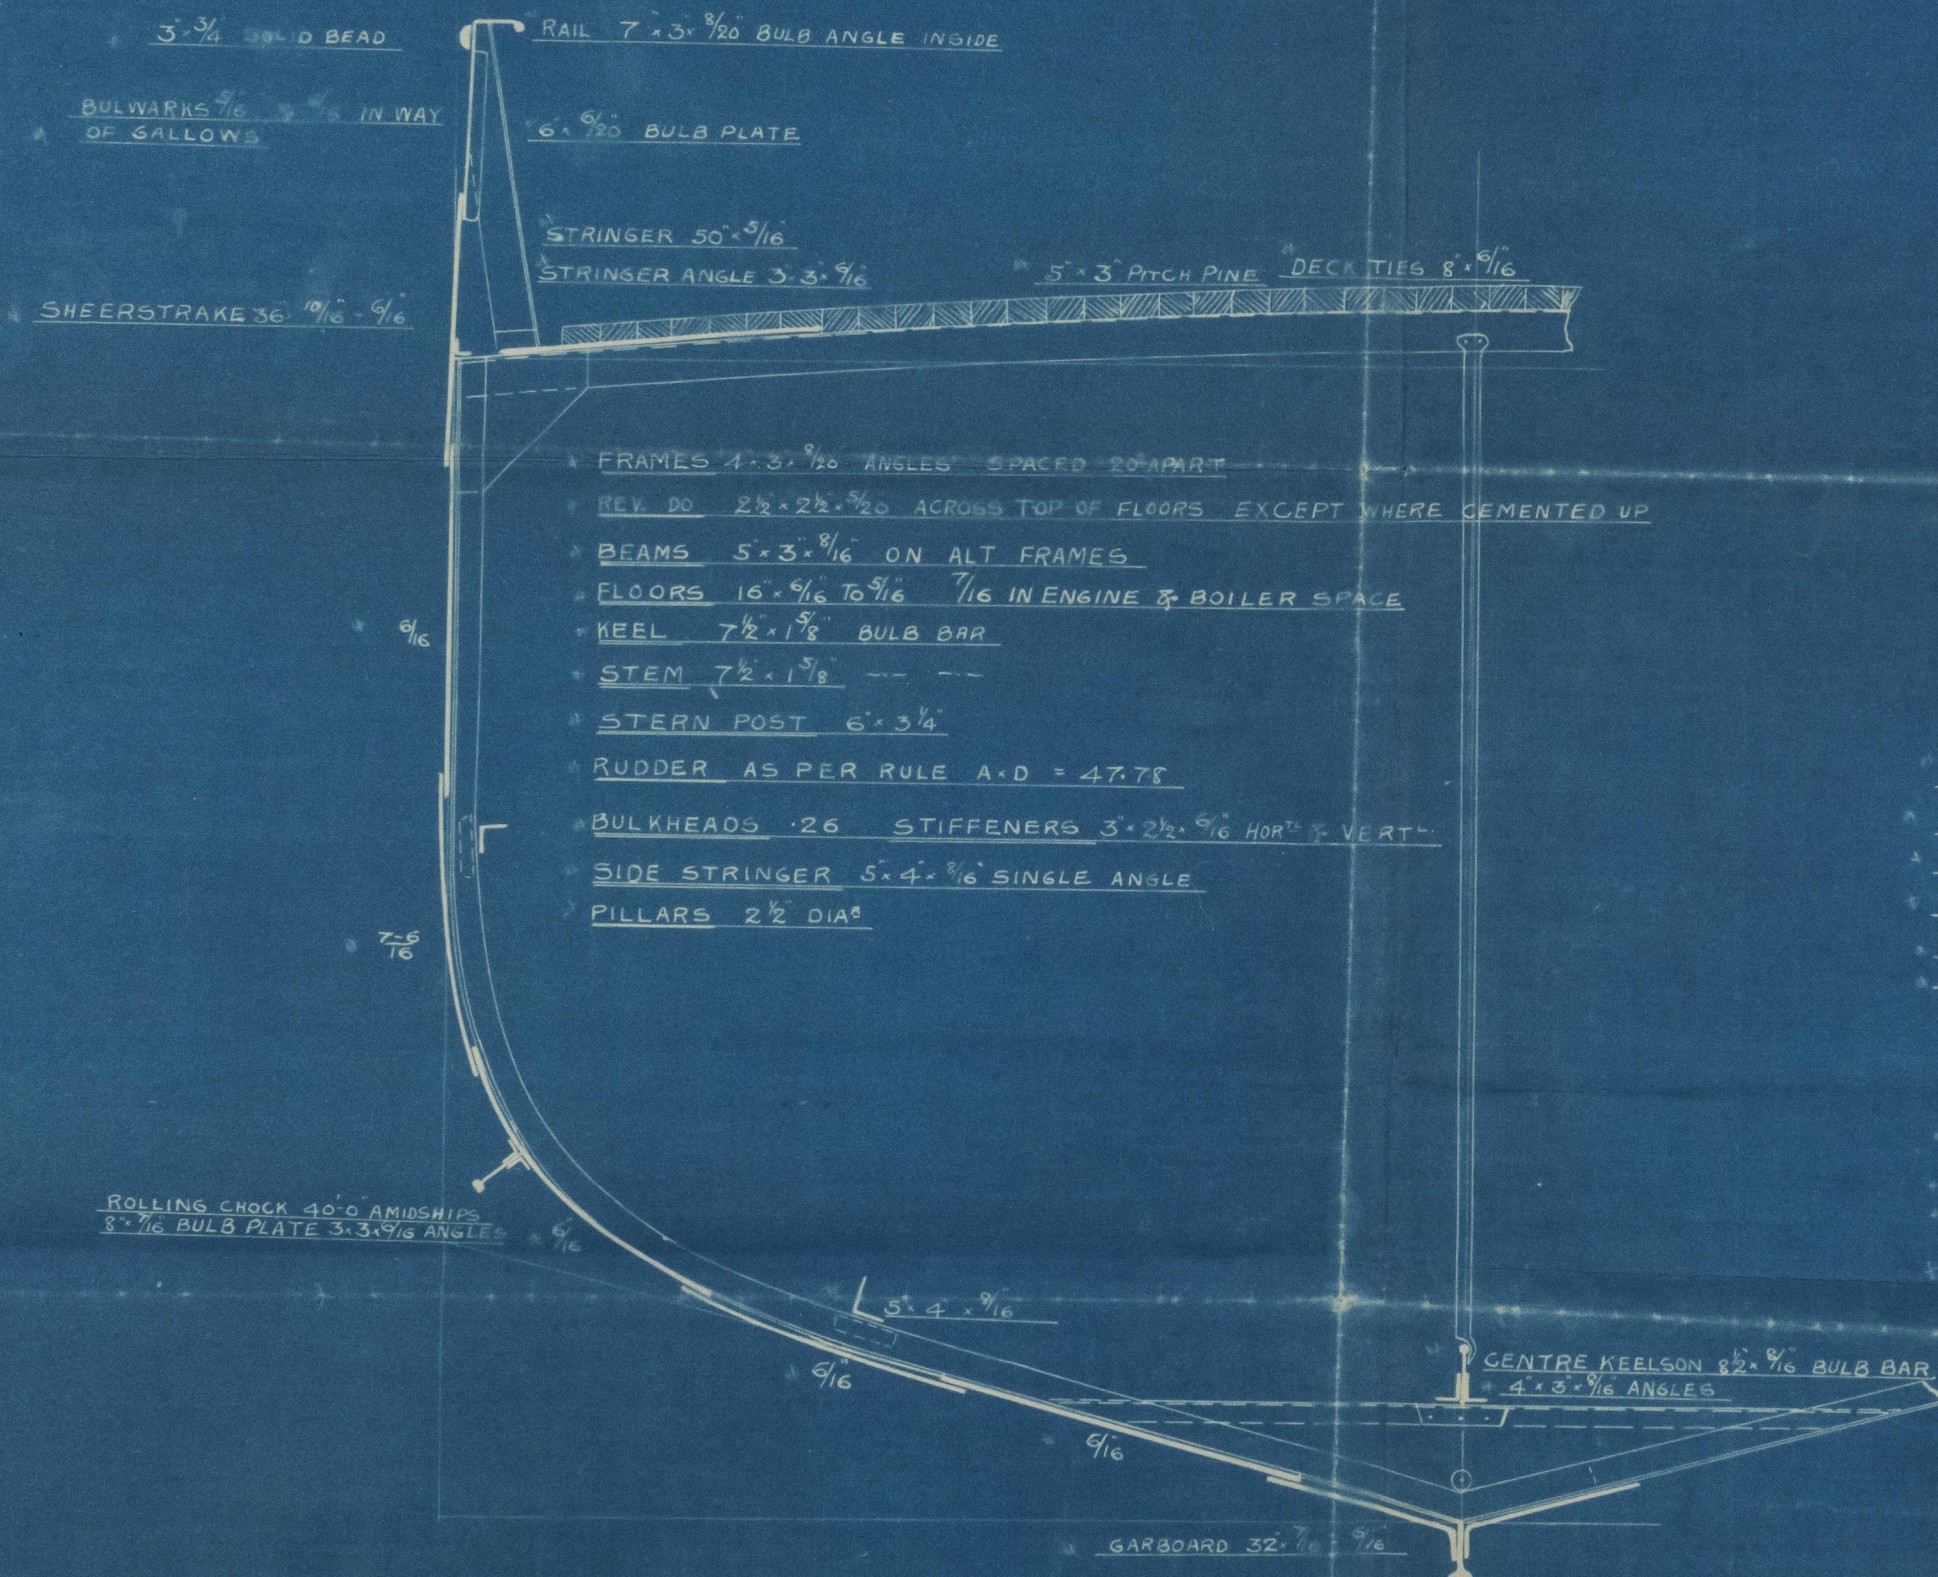

NUMERALS

B+D = 35.63
 L(B+D) = 4750.55

PROPORTIONS

L/D = 10.45
 L/B = 5.85

EQUIPMENT

1 st BOWER ANCHOR	5 1/2 CWTs EX STOCK
2 nd ---	5 1/4 ---
KEDGE ---	3 ---
105 FATHOMS	1 1/8 CABLE
60 ---	6 HAWSER
60 ---	5 WARP

RIVETING

BUTTS OF SHELL PLATING LAPPED & DOUBLE RIVETED
 EXCEPT GARBOARD & SHEERSTRAKE WHICH ARE TO BE
 STRAPPED & DOUBLE RIVETED. LANDINGS DOUBLE RIVETED
 BULWARKS SINGLE RIVETED.


C.B.
 20.1.12.



Lloyd's Register
 Foundation

01460-01472-0067

Cochrane & Sons.

Nos 524. 525. 529.

530. 535. 536.

~~1/2 Ralfour Hull Apt No. 25162~~

~~• Bonar Law " " 25163~~

~~• Andrew Marvel " " 25250~~

~~• Lord Lister " "~~

Copy Rudolph Lechov



© 2021

Lloyd's Register
Foundation

012460-012472-0061