
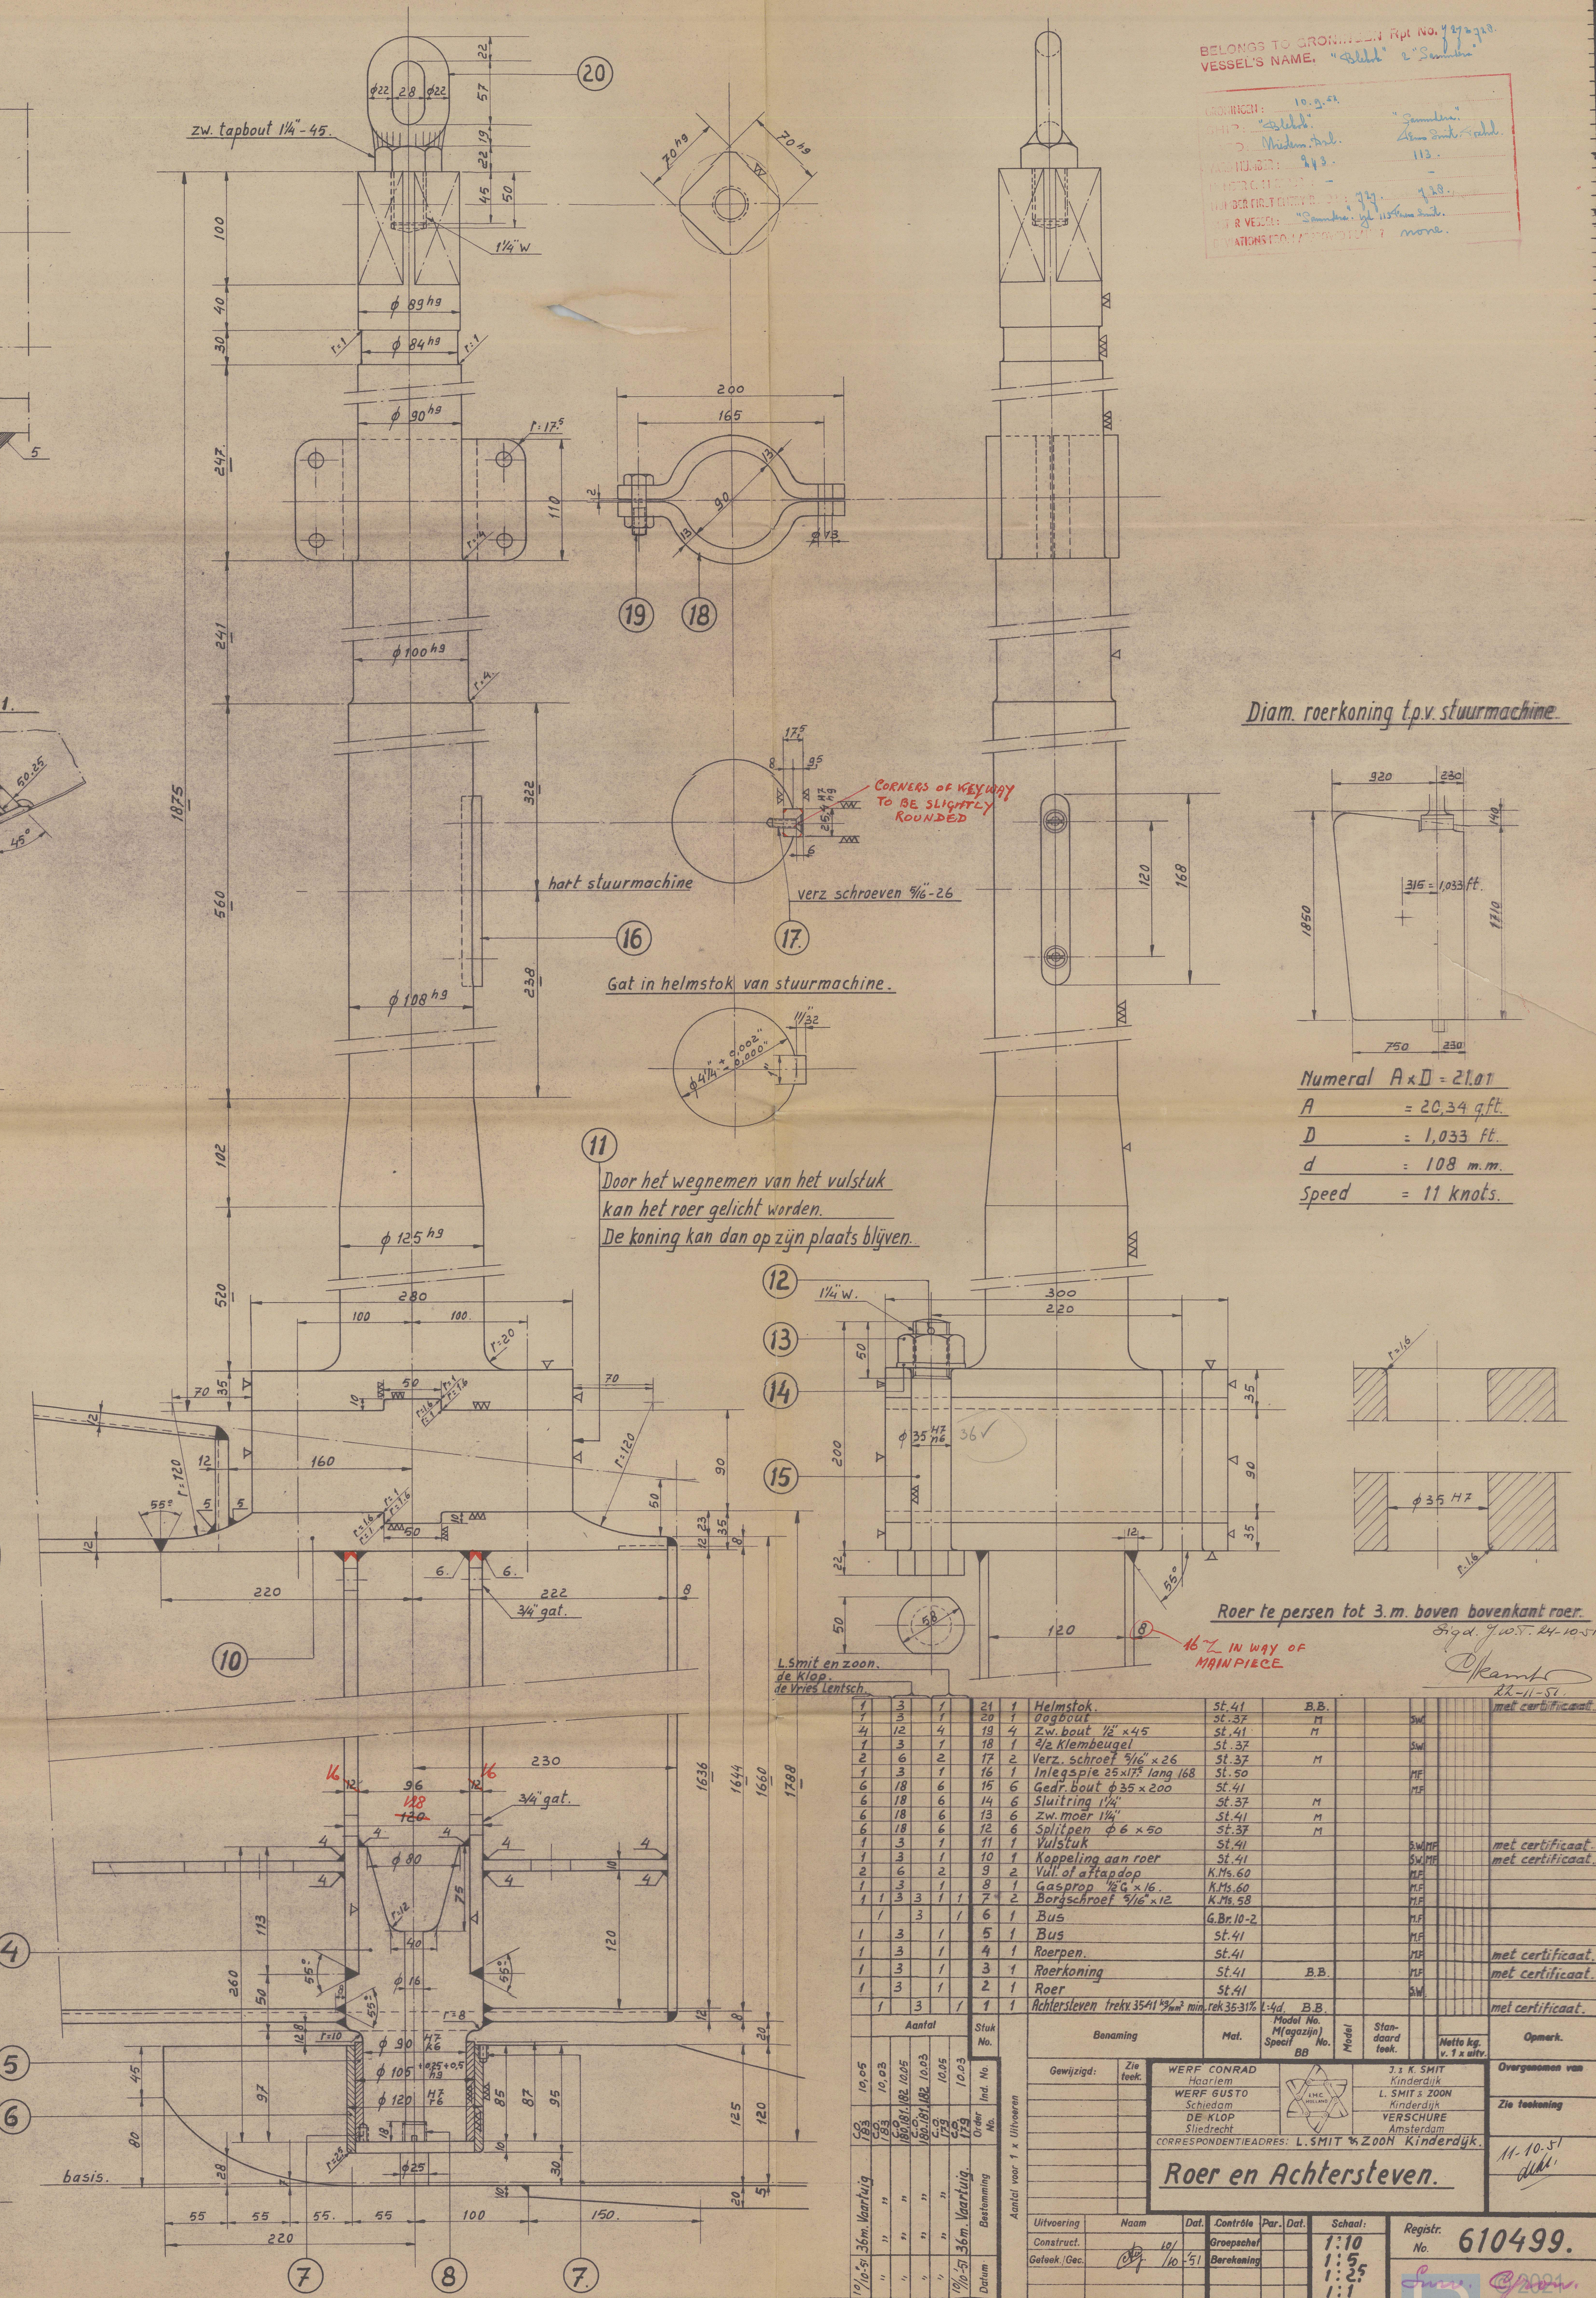


London
24-10-51

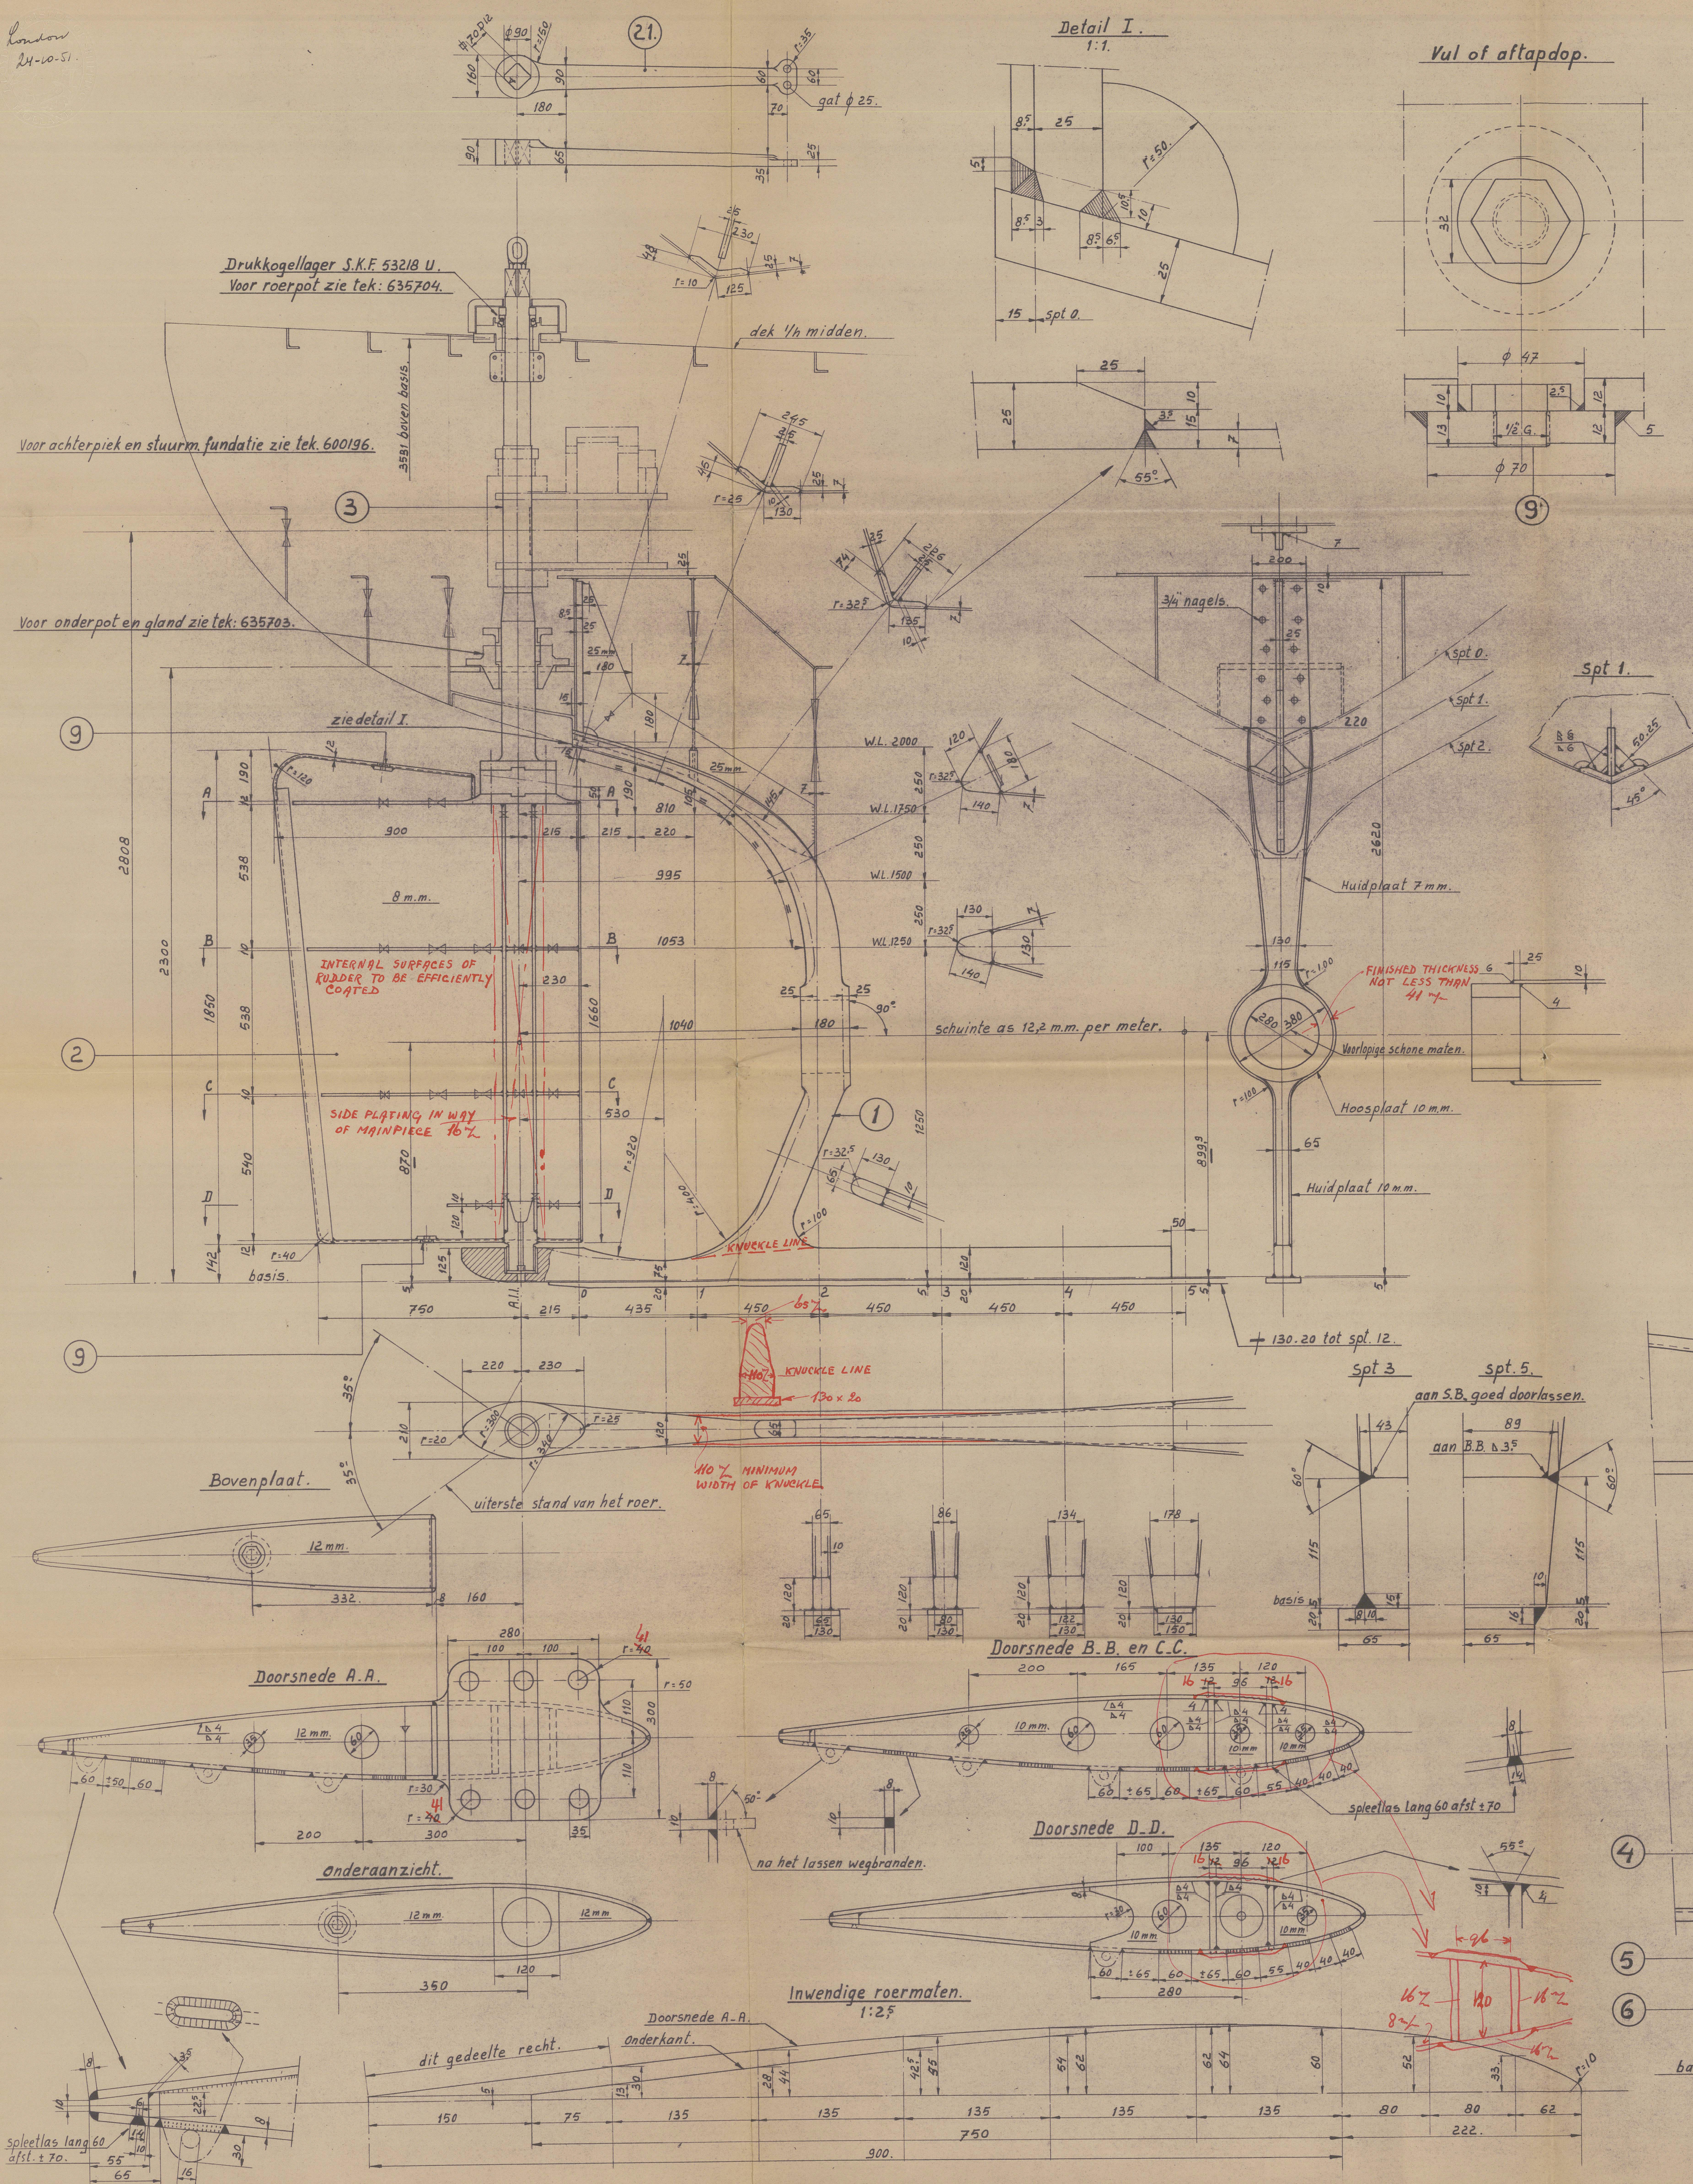

RECORDS DEPT.
LONDON

BLEKOK. XI
Stern frame & rudder

3



© 2021

Lloyd's Register

012460-012472-01237