


FUNNEL DAMPER TO BE REMOVED.

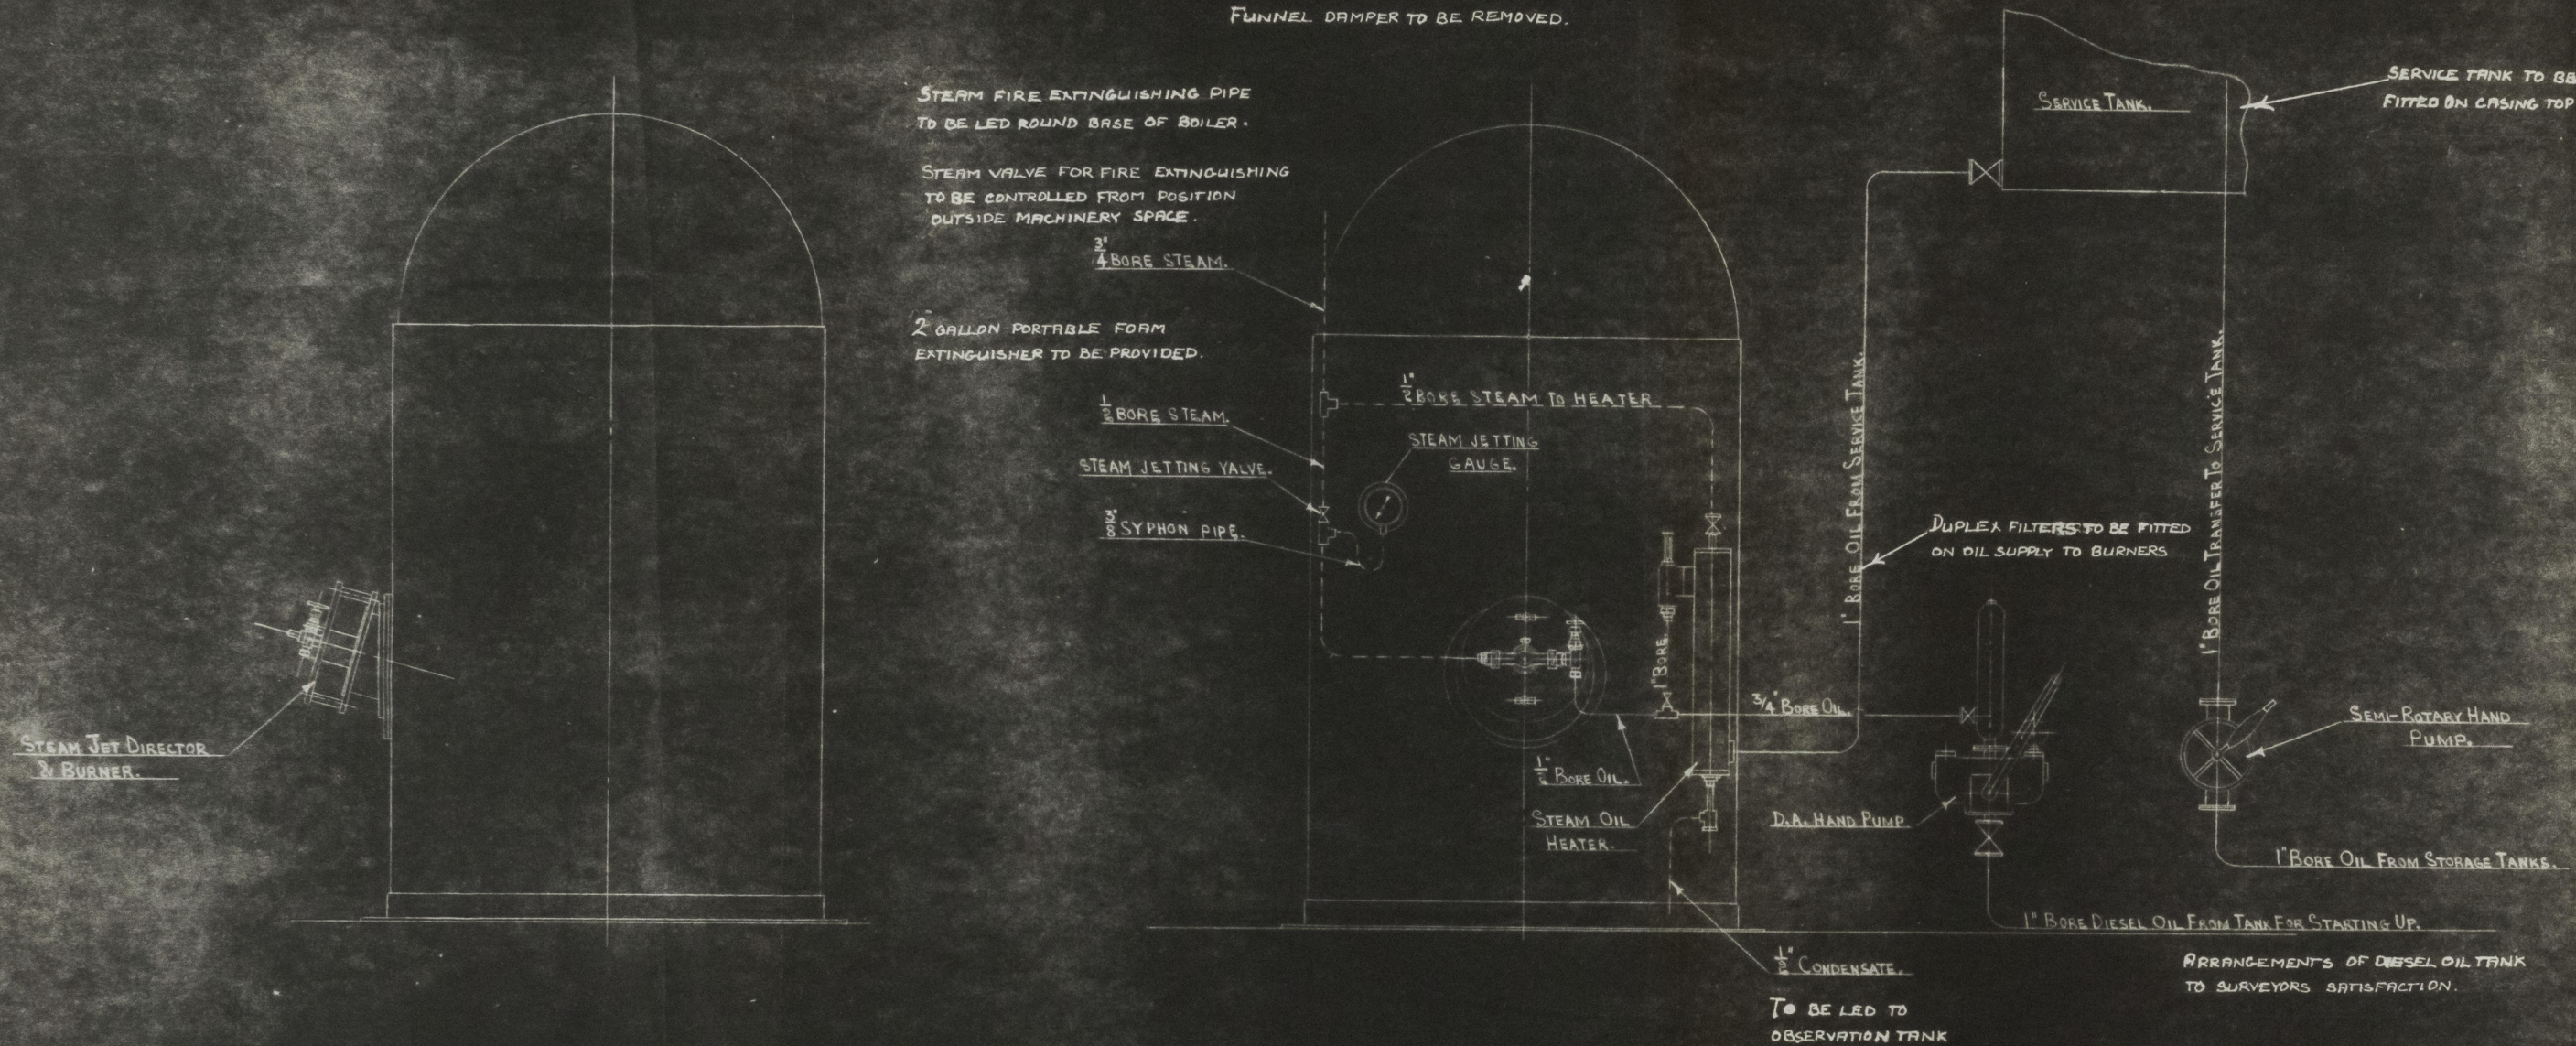

The flush point of the oil fuel to be above 140° F.

The remaining requirements of the Rules for Pumping and Piping to be complied with as far as they are applicable.

C.B.
2/7/51
lre

CLYDE FUEL SYSTEMS LTD.,

GLASGOW.

INST. N° 4484.

GEN N° 3121.

DIAG. ARRANG^t OF STEAM JET SYSTEM OF OIL BURNING FIRING THRO^g FIRING DOOR OF COCHRAN CROSSTUBE BOILER.

Scale: 1" = 1 Foot.



FILING No. 6A	DRAWING No.
DRAWN BY C.B.	15606
CHECKED BY	
DATE 20.12.50	

"Rahmani"

ipl. n^o Cbo. 2572



© 2021

Lloyd's Register
Foundation

012501-012507-0114