

PROFILE & DECK.



"DAMNTLESS STAR" & "SUNLIT WATERS"

STEEL SCREW DRIFTERS

Nos 1331 & 1332.

DIMNS 96'-0" BP * 21'-0" MLD * 10'-0" MLD

SCALE - 1/4 IN. = 1 FOOT.

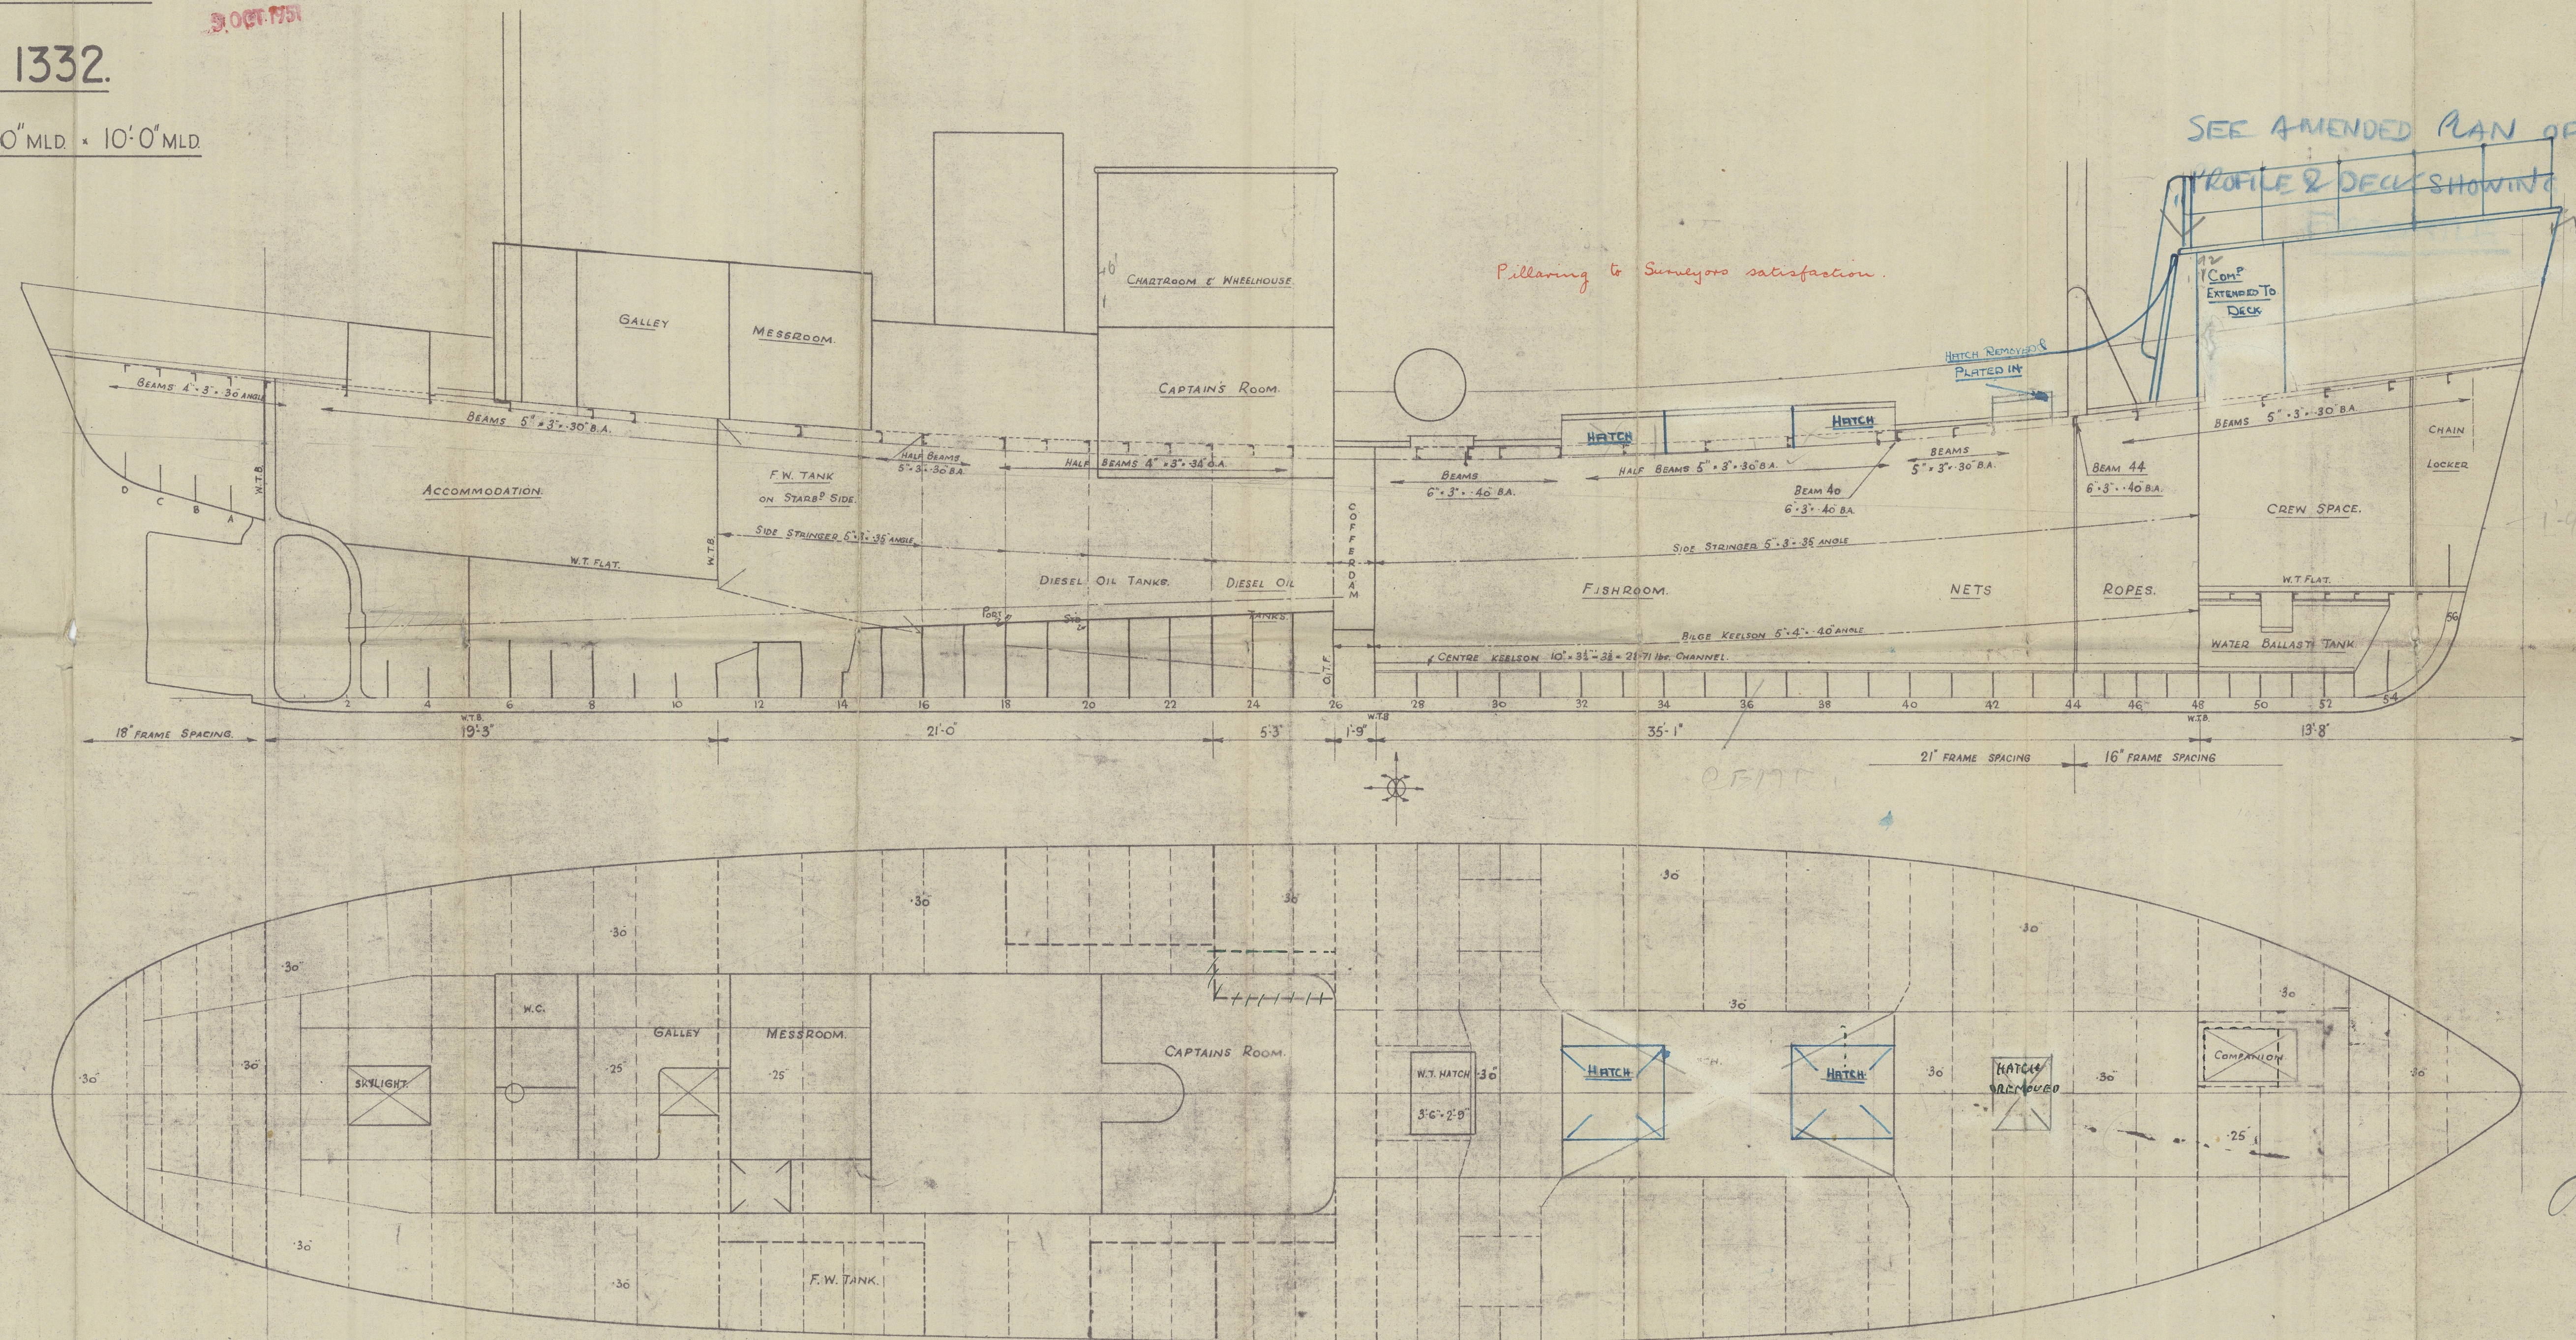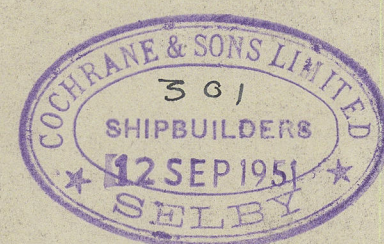

5/10/51

Dauntless Star
Profile & Deck

RECORDS DEPT.,
LONDON

2



© 2021

Lloyd's Register
Foundation

012507-012507-0185