
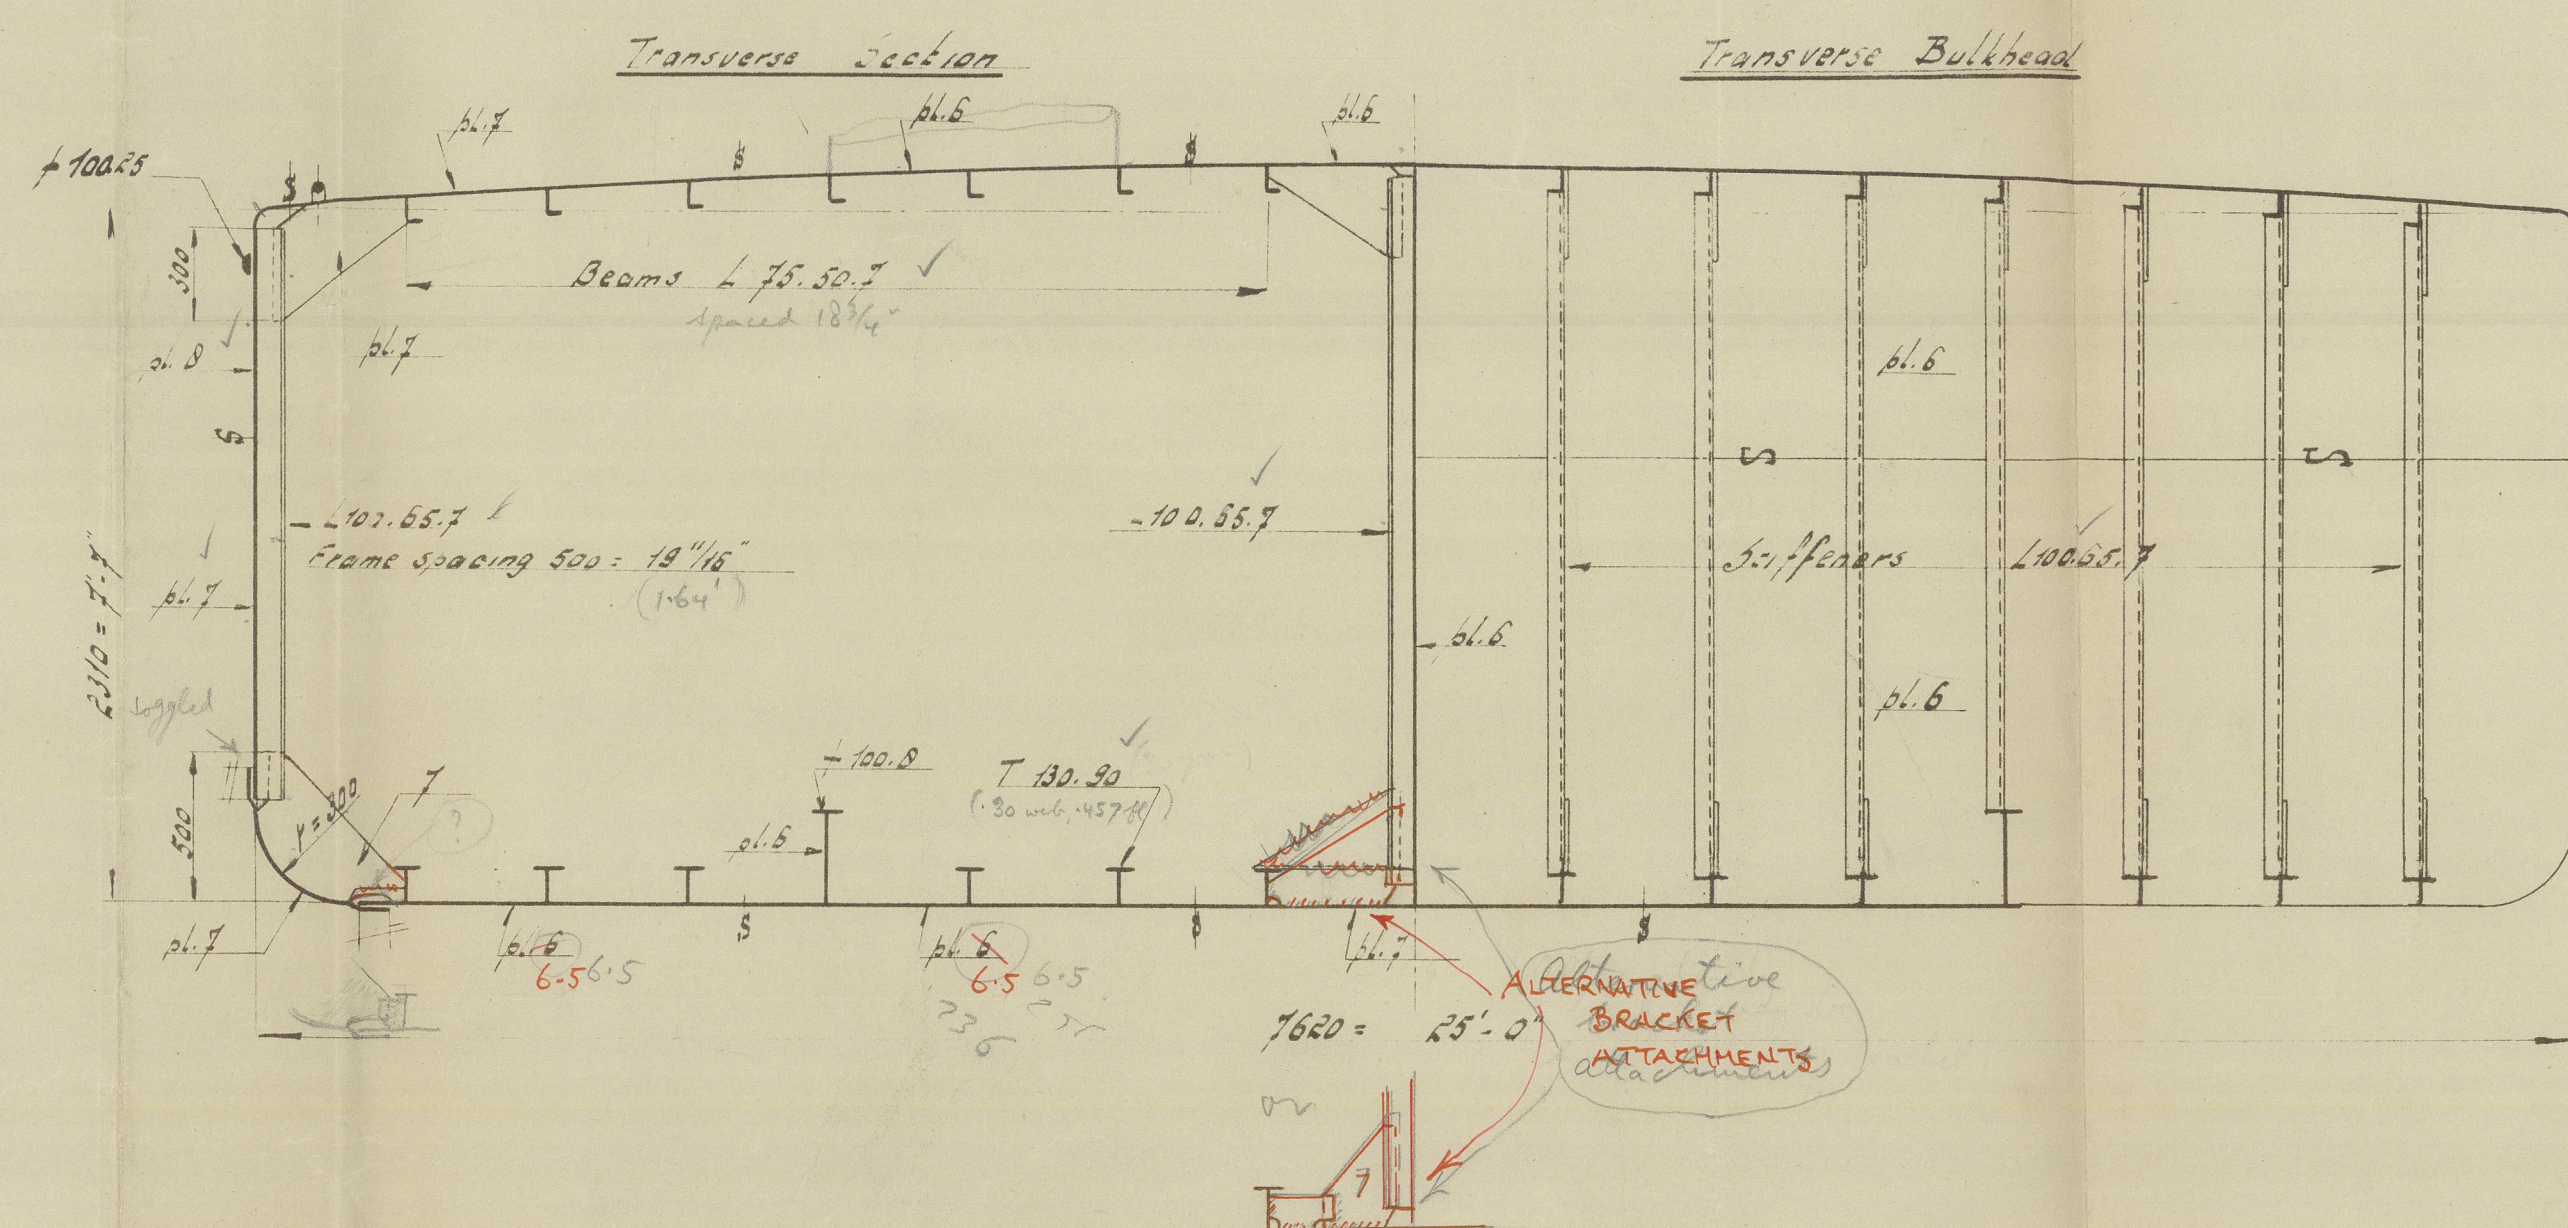
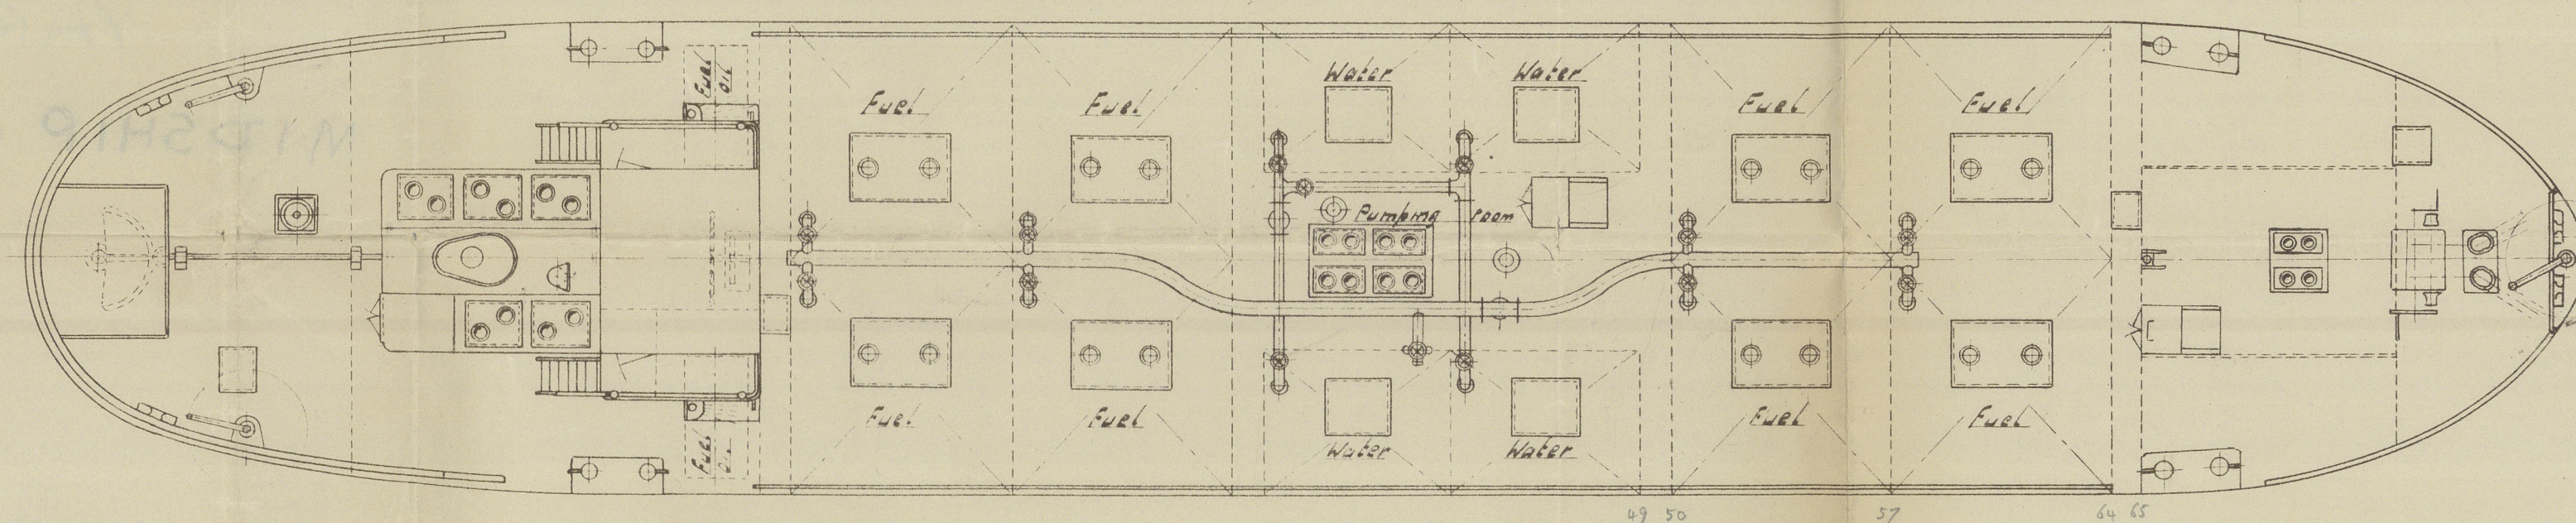


+ A.I. Motortankerlighter for river services


Class A.1. Sarge
"Carrying ~~Admiral~~^{Cap} in Bulk, ~~FR~~ above 150 °F."
"For River Service"
"Longitudinal Tracing at Bottom and at Deck."

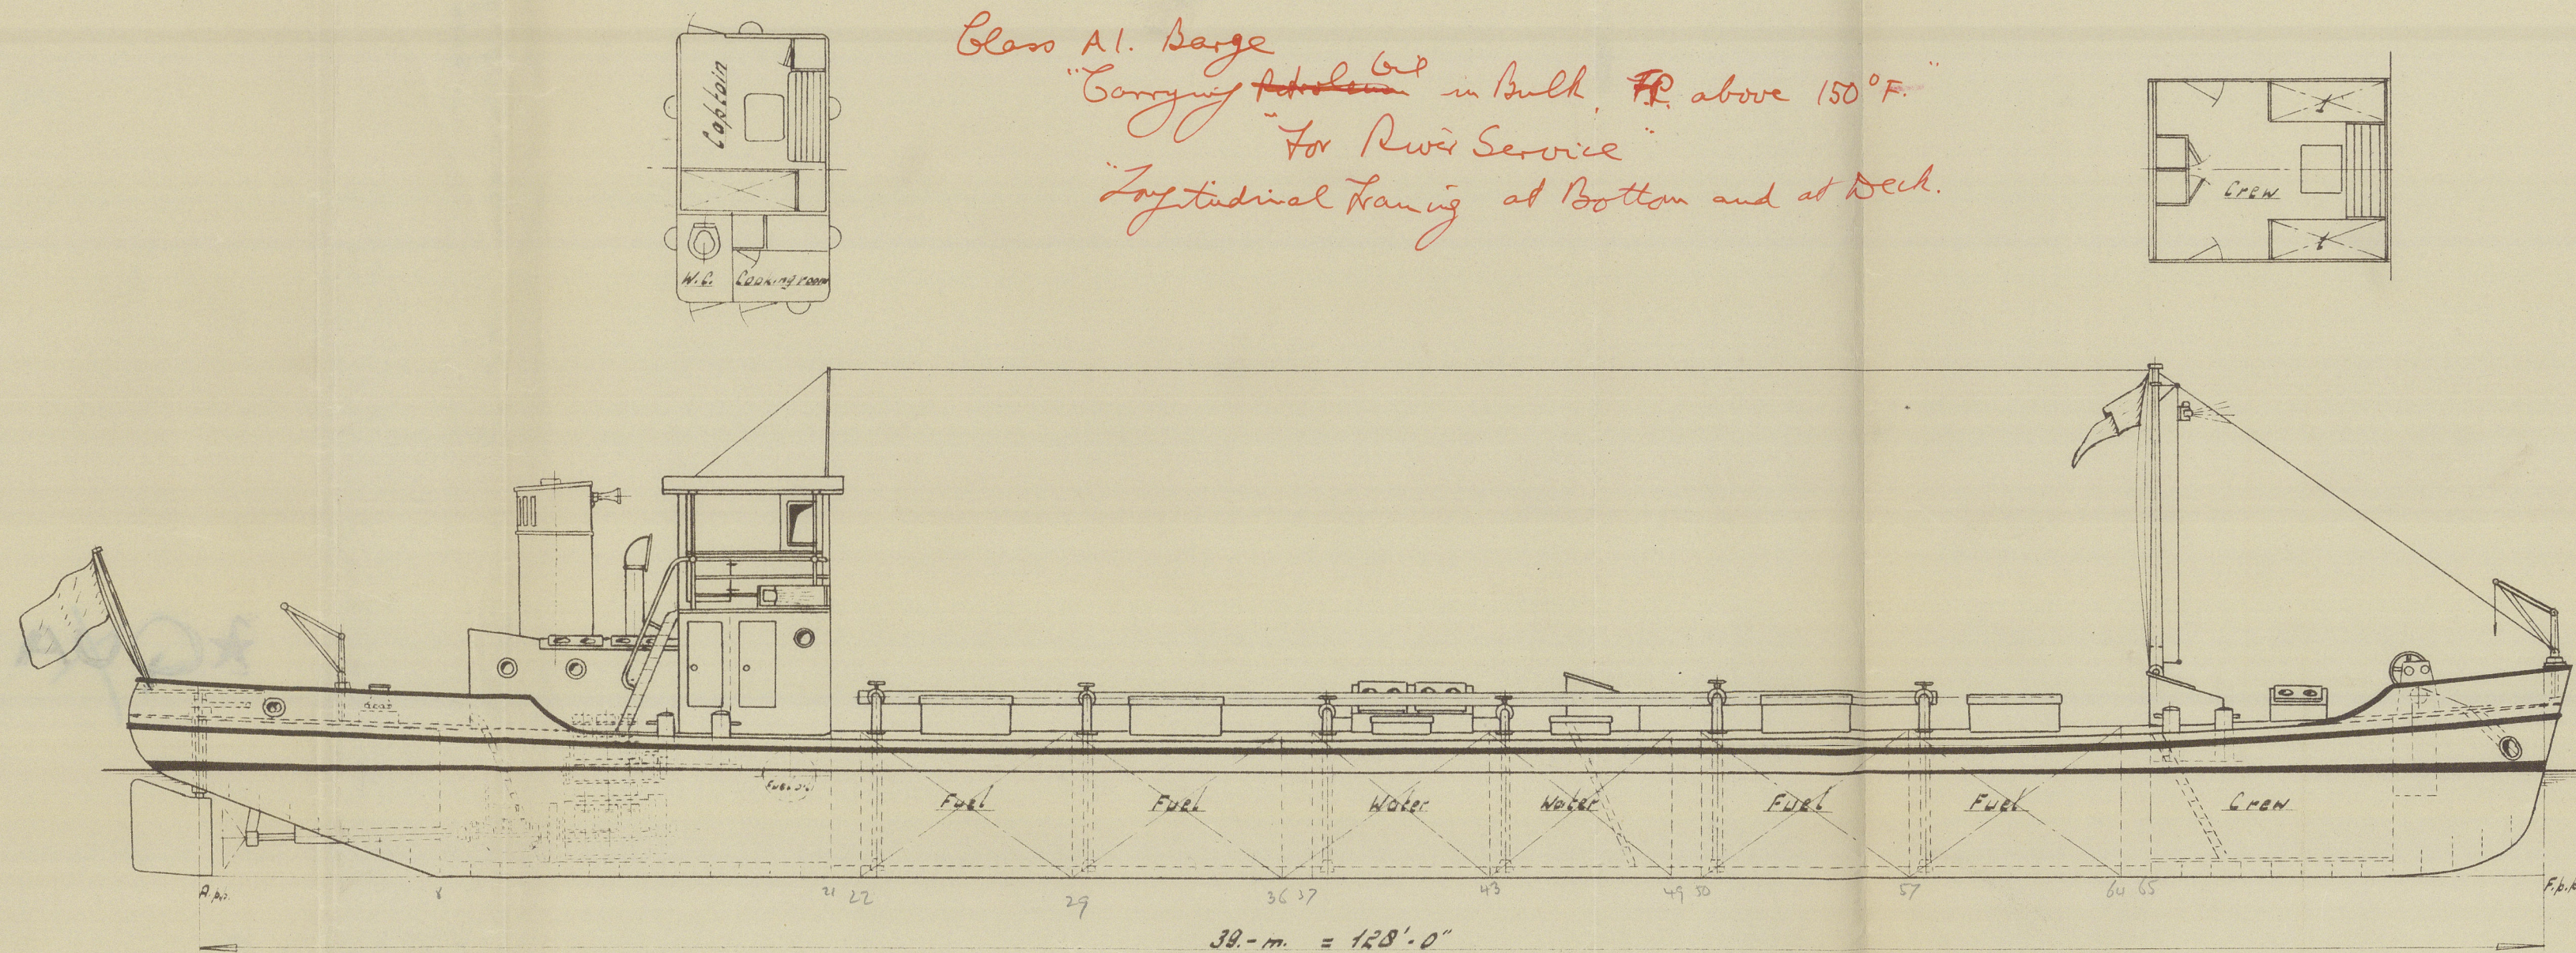

Ad
11.1.52

[illegible]

RECEIVED DEPT.
LONDON

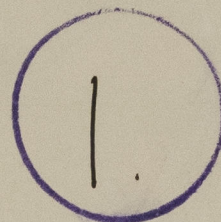

*~~Q~~VASEE MUL BAHR

SCHEEPS. "DE KLOP"

YARD NO. C.O. 197

MIDSHIP SECTION & GENERAL
ARRGT.

© 2021

Lloyd's Register
Foundation

012601-012607-0242

L.

"DE KLOP"

YARD No C.O. 194

MIDSHIP SECTION.



© 2021

Lloyd's Register
Foundation