
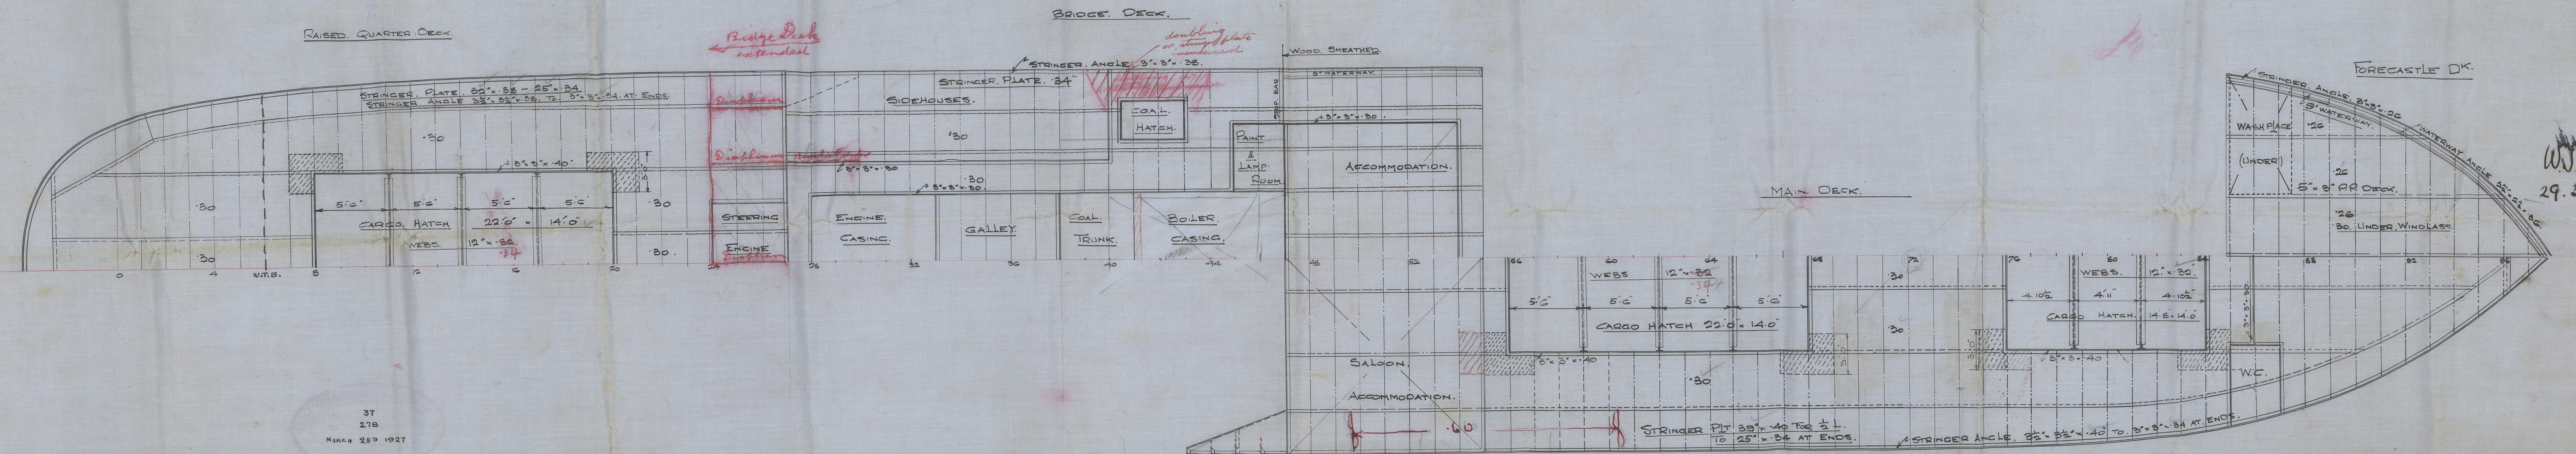


872:11
29/3/27

S.S. No 278
PROFILE & DECKS
SCALE $\frac{1}{4}'' = 1 \text{ FOOT}$
DIMENSIONS. 180' 0" B.P. x 29' 3" M.D. x 14' 0" M.L.

See bulks plan for
diff as fitted

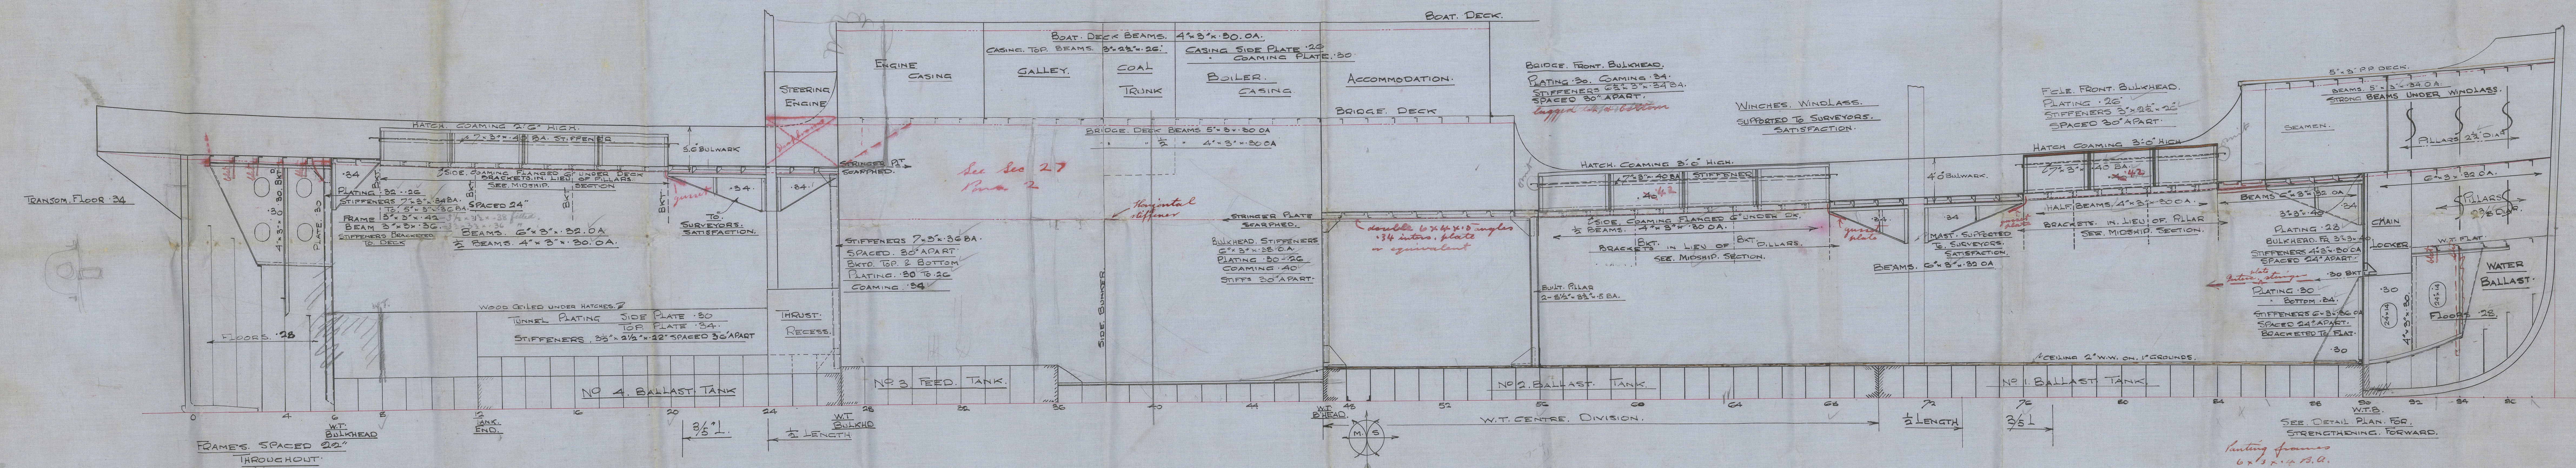

37
278
MARCH 28th 1927

29.3.27

Nº 278.

Profile + Decks
(approved plan)

Goole S.B. & R. Co. Ltd.

*See amended
plan of Harrold at
break.*

"Purke"

See F.E. Report No. 38483

012508-012513-0002



© 2021

Lloyd's Register
Foundation