



FORB SIDE OF BULKHEAD

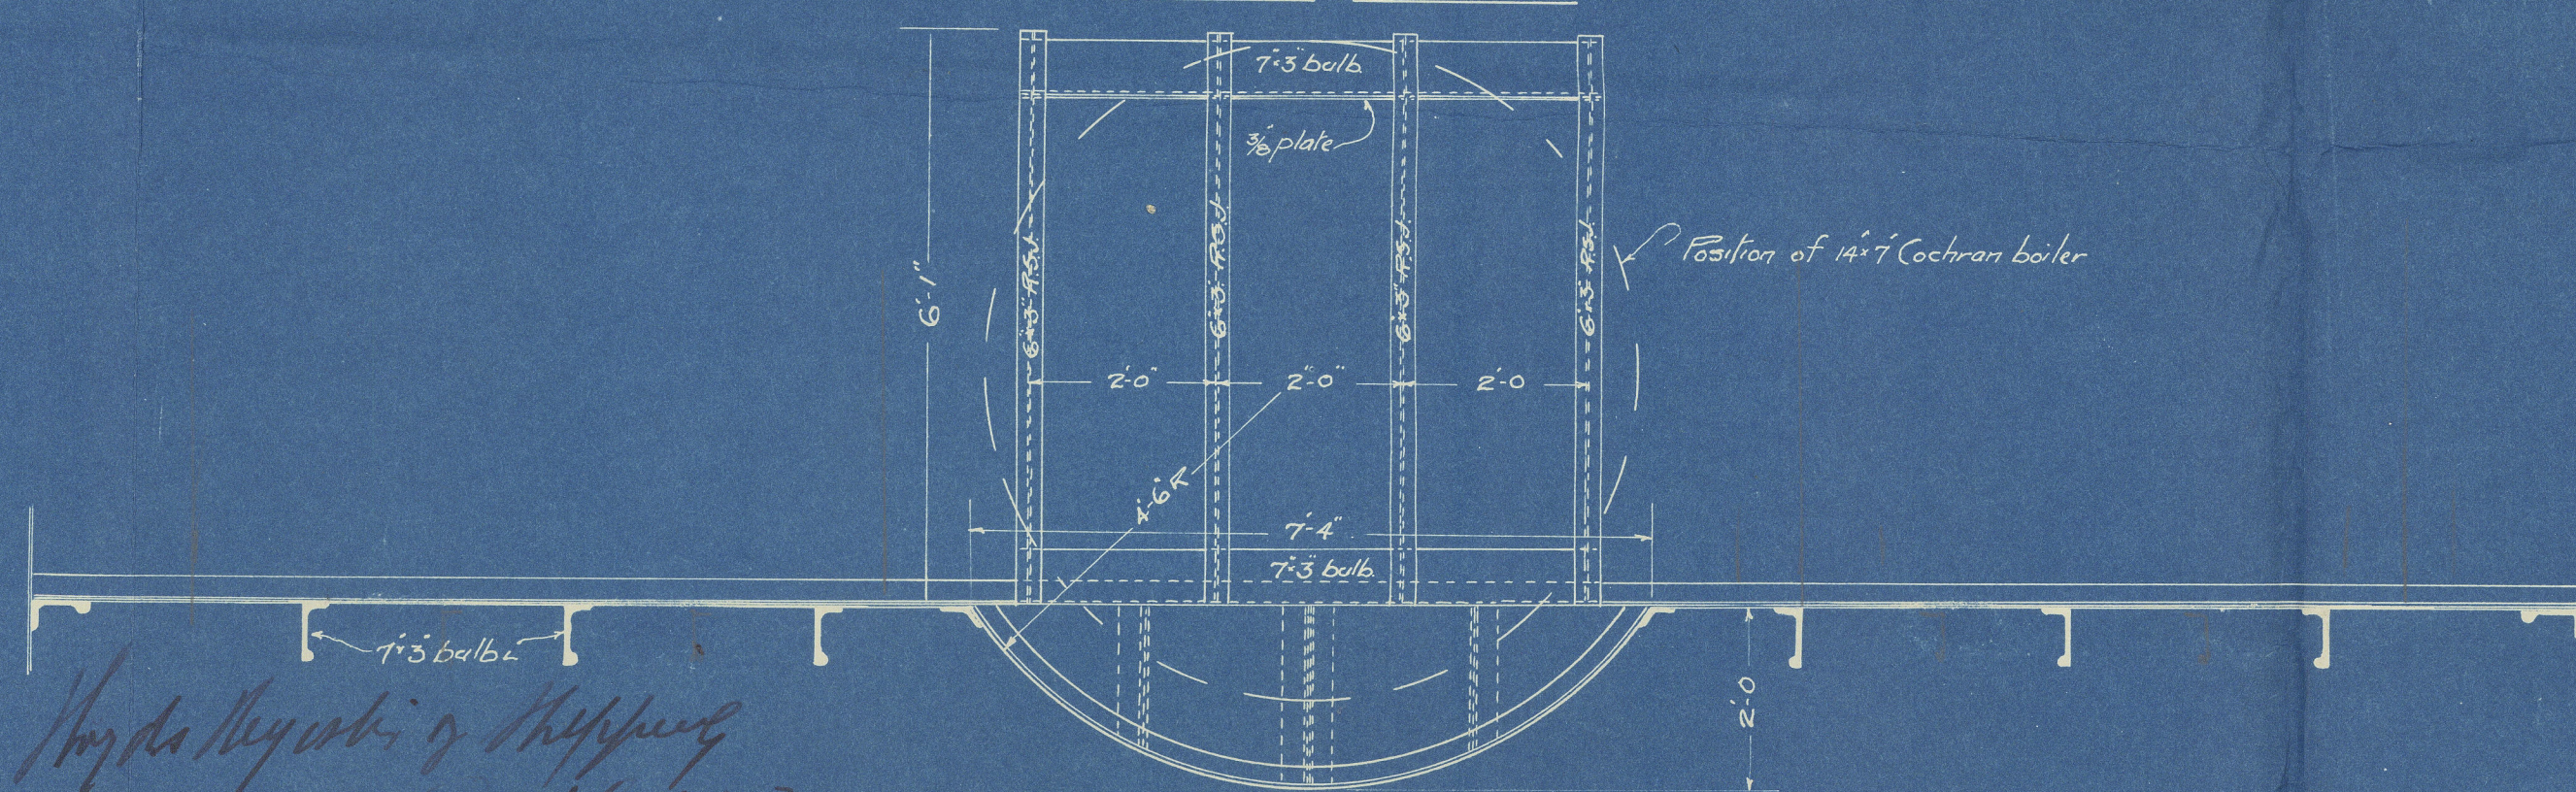

SECTION OF A.A.

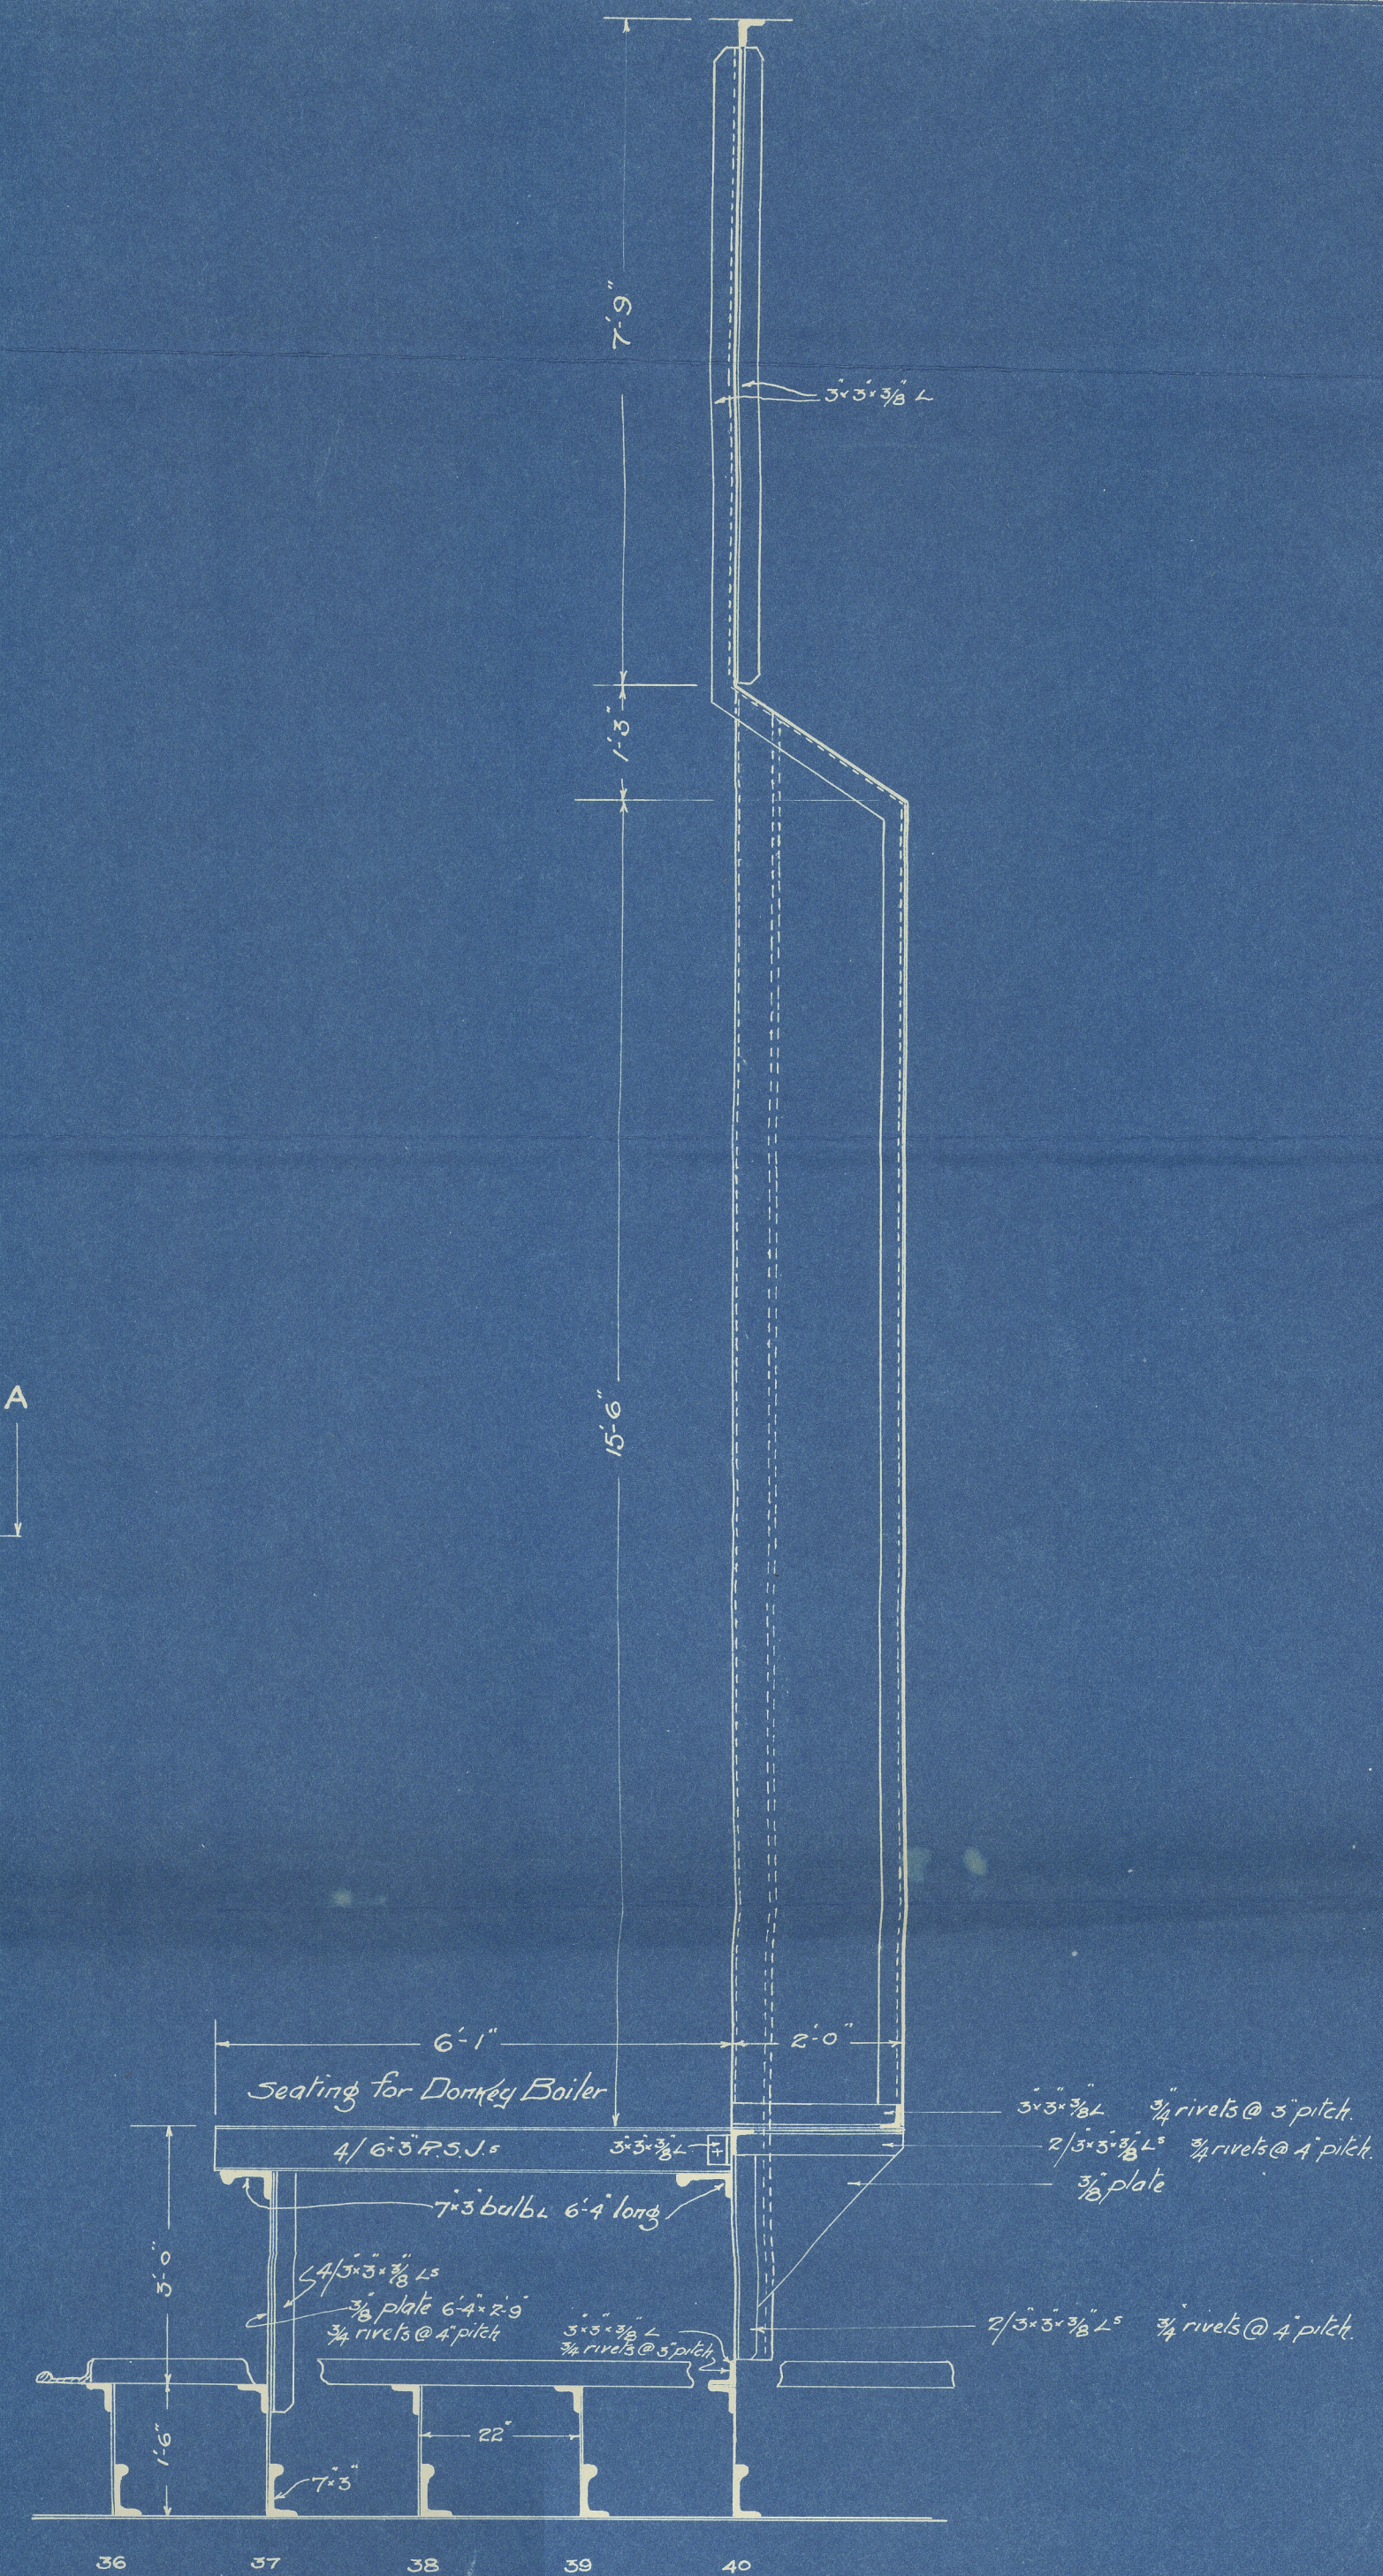

M.V. PUKEKO

FUME TIGHT BULKHEAD TO BE FITTED AT FRAME 40 and SEATING FOR 14'-0" x 7'-0" COCHRAN BOILER

Scale 1/2" = 1'

1/4 Plate; 3/8 rivets @ 5" pitch in all fume-tight joints
Stiffeners; 7/8 bolts @ 5" pitch

*Hydrographic & Shipping
Cuckland N.Z.
W. H. Smith
Surveyor & Hydrographic
15/4/31*

Mason Bros Engineering Co Ltd
Auckland

0004

19 MAY 1931



© 2021

Lloyd's Register
Foundation