
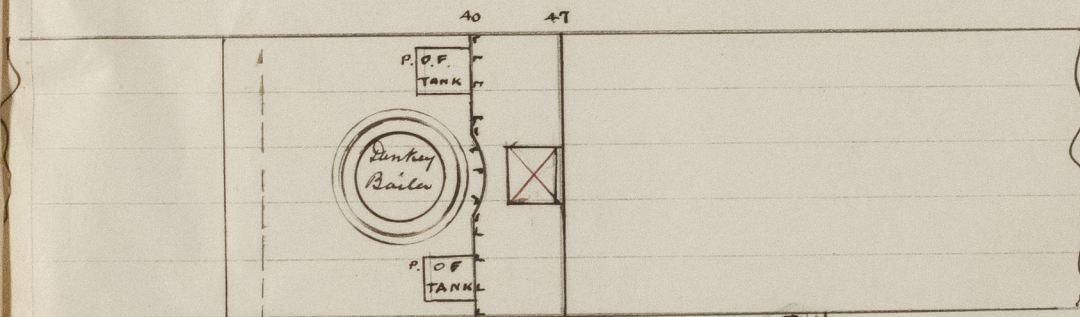


Motor Vessel Twin Screw.


Copy.

YKEKO

Main Beam $11\frac{1}{2} \times 30$

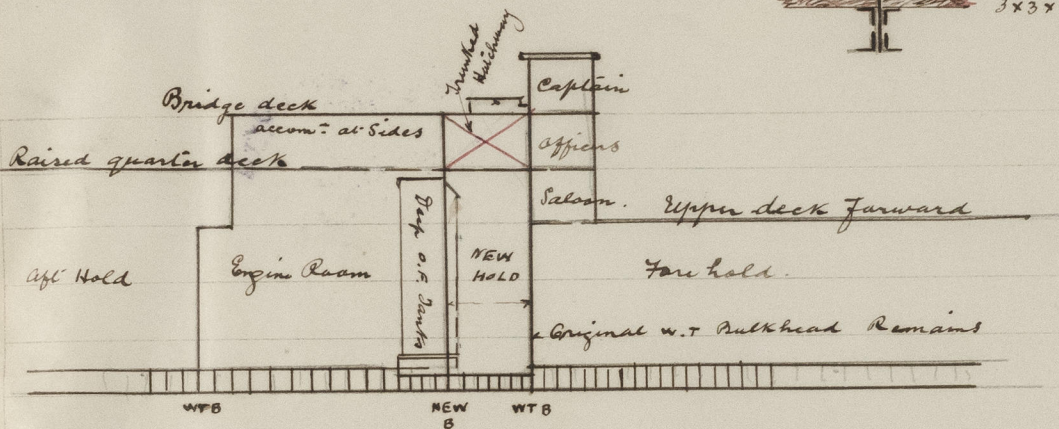

Proper designation of Decks

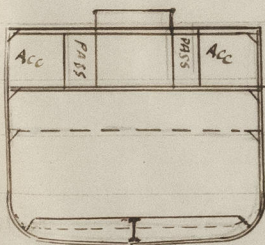

Bridge deck

Raised quarter deck

Upper deck forward.

ENGINE ROOM.

NEW HOLD Proposed if necessary.
Semi box
Horizontal Stiffener
about $21\frac{1}{2}$ "
about 8'-9 feet
from bottom

For general guidance

Proper designation of decks +:

sent to W. R. Smith, Auckland.

A.C.H.



© 2021

Lloyd's Register
Foundation

012508-012513-0046