
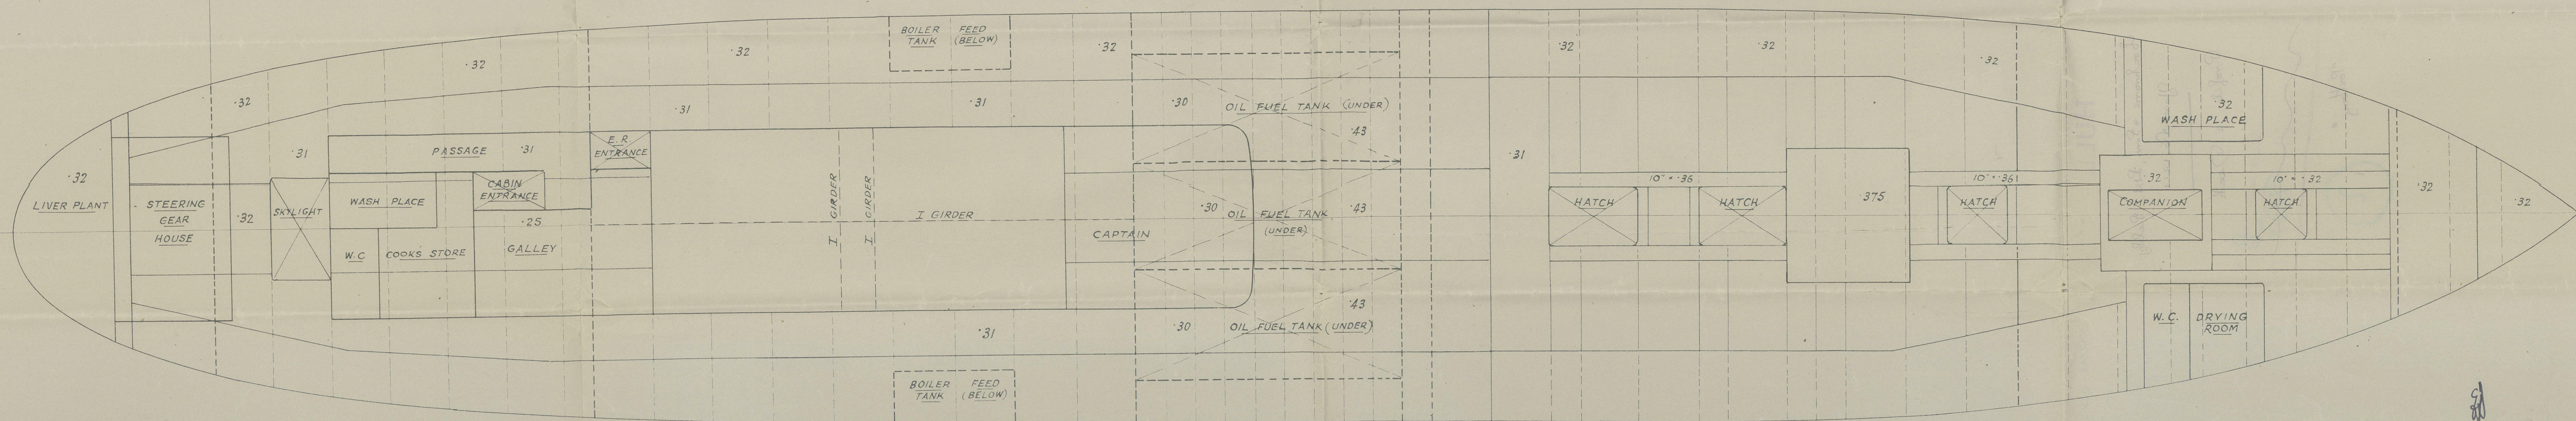


PROFILE & DECK PLAN
MOTOR SCREW TRAWLER
No 1211
140'-0" B.P. x 24'-6" MLD x 13'-6" MLD.
TO CLASS 100 A.I. LLOYD'S MOTOR TRAWLER
SCALE 1/4" IN. = 1 FT.

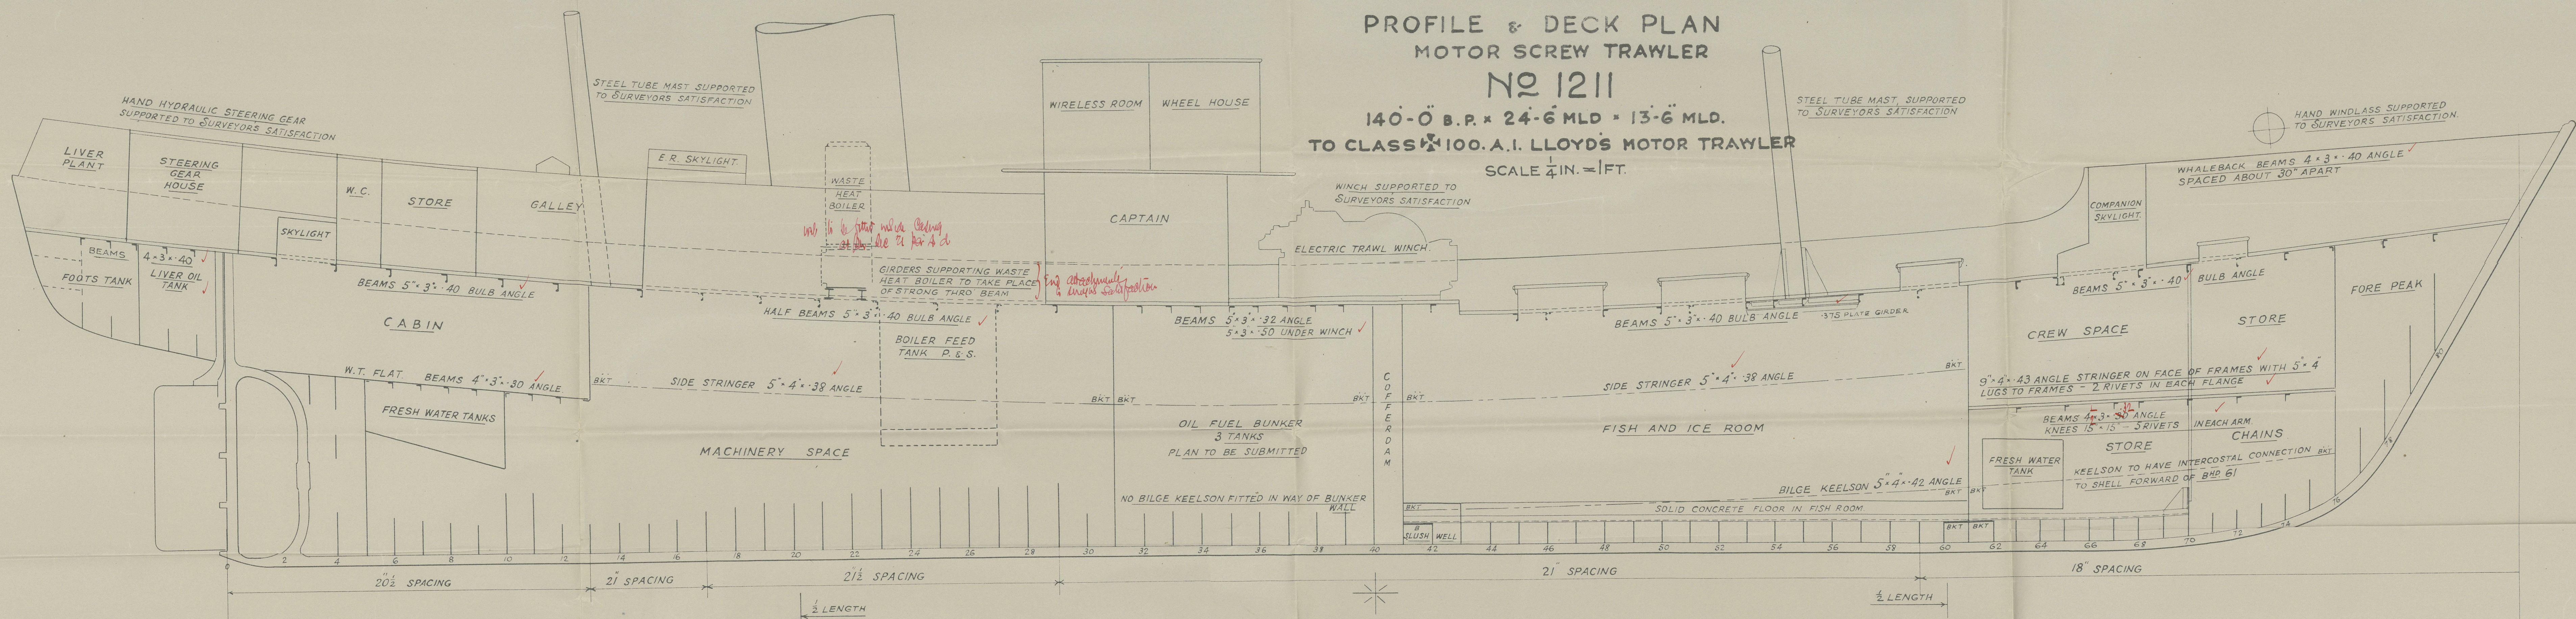

24 10 24


HULL

012508 - 012513 - 0110

Bochran & Sons, Ltd. Pelby.

Yard No. 1211.

Profile & Deck.

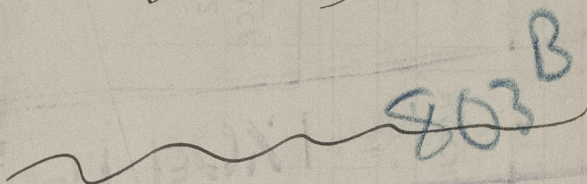

"Postboy"



PLAN No. 3790
FOR ENCLOSURE TO
Messrs. Almy & Co. Ltd.
of shipping
FROM
BOCHRAE & SONS, LTD.
SHIPBUILDERS, PELBY
DATE 19.10.34



Lloyd's Register
Foundation