

24 OCT 1939

MIDSHIP SECTION STEEL MOTOR TRAWLER

~ No 1211 ~

140'-0" B.P. x 24'-6" MLD. x 13'-6" MLD.

TO CLASS 100 A.I. MOTOR TRAWLER

SCALE 1/2 IN. = 1 FT.

NUMERALS

L x D 1890

L x (B+D) 5320

EQUIPMENT

1st BOWER ANCHOR 8 1/4 CWTs STOCKLESS

2nd " " 7 1/4 7 1/2 " "

KEDGE " 3 1/4 " " "

120 FMS 1 3/16" STUD LINK CABLE

60 " 5 1/2" HAWSER

60 " 5" WARP

*should be "or check" as fitted.
See F.E. Report*


RIVETING

ALL SHELL LANDING EDGES DOUBLE RIVETED
EXCEPT TOP EDGE OF SHEERSTRAKE WHICH
IS TO BE SINGLE RIVETED.

BUTTS OF GARBOARD & SHEERSTRAKE STRAPPED
AND DOUBLE RIVETED ALL FORE & AFT.

REMAINDER OF BUTTS OF SHELL PLATING TO BE
OVERLAPPED & DOUBLE RIVETED ALL FORE & AFT.

ALL RIVETS TO BE STEEL.

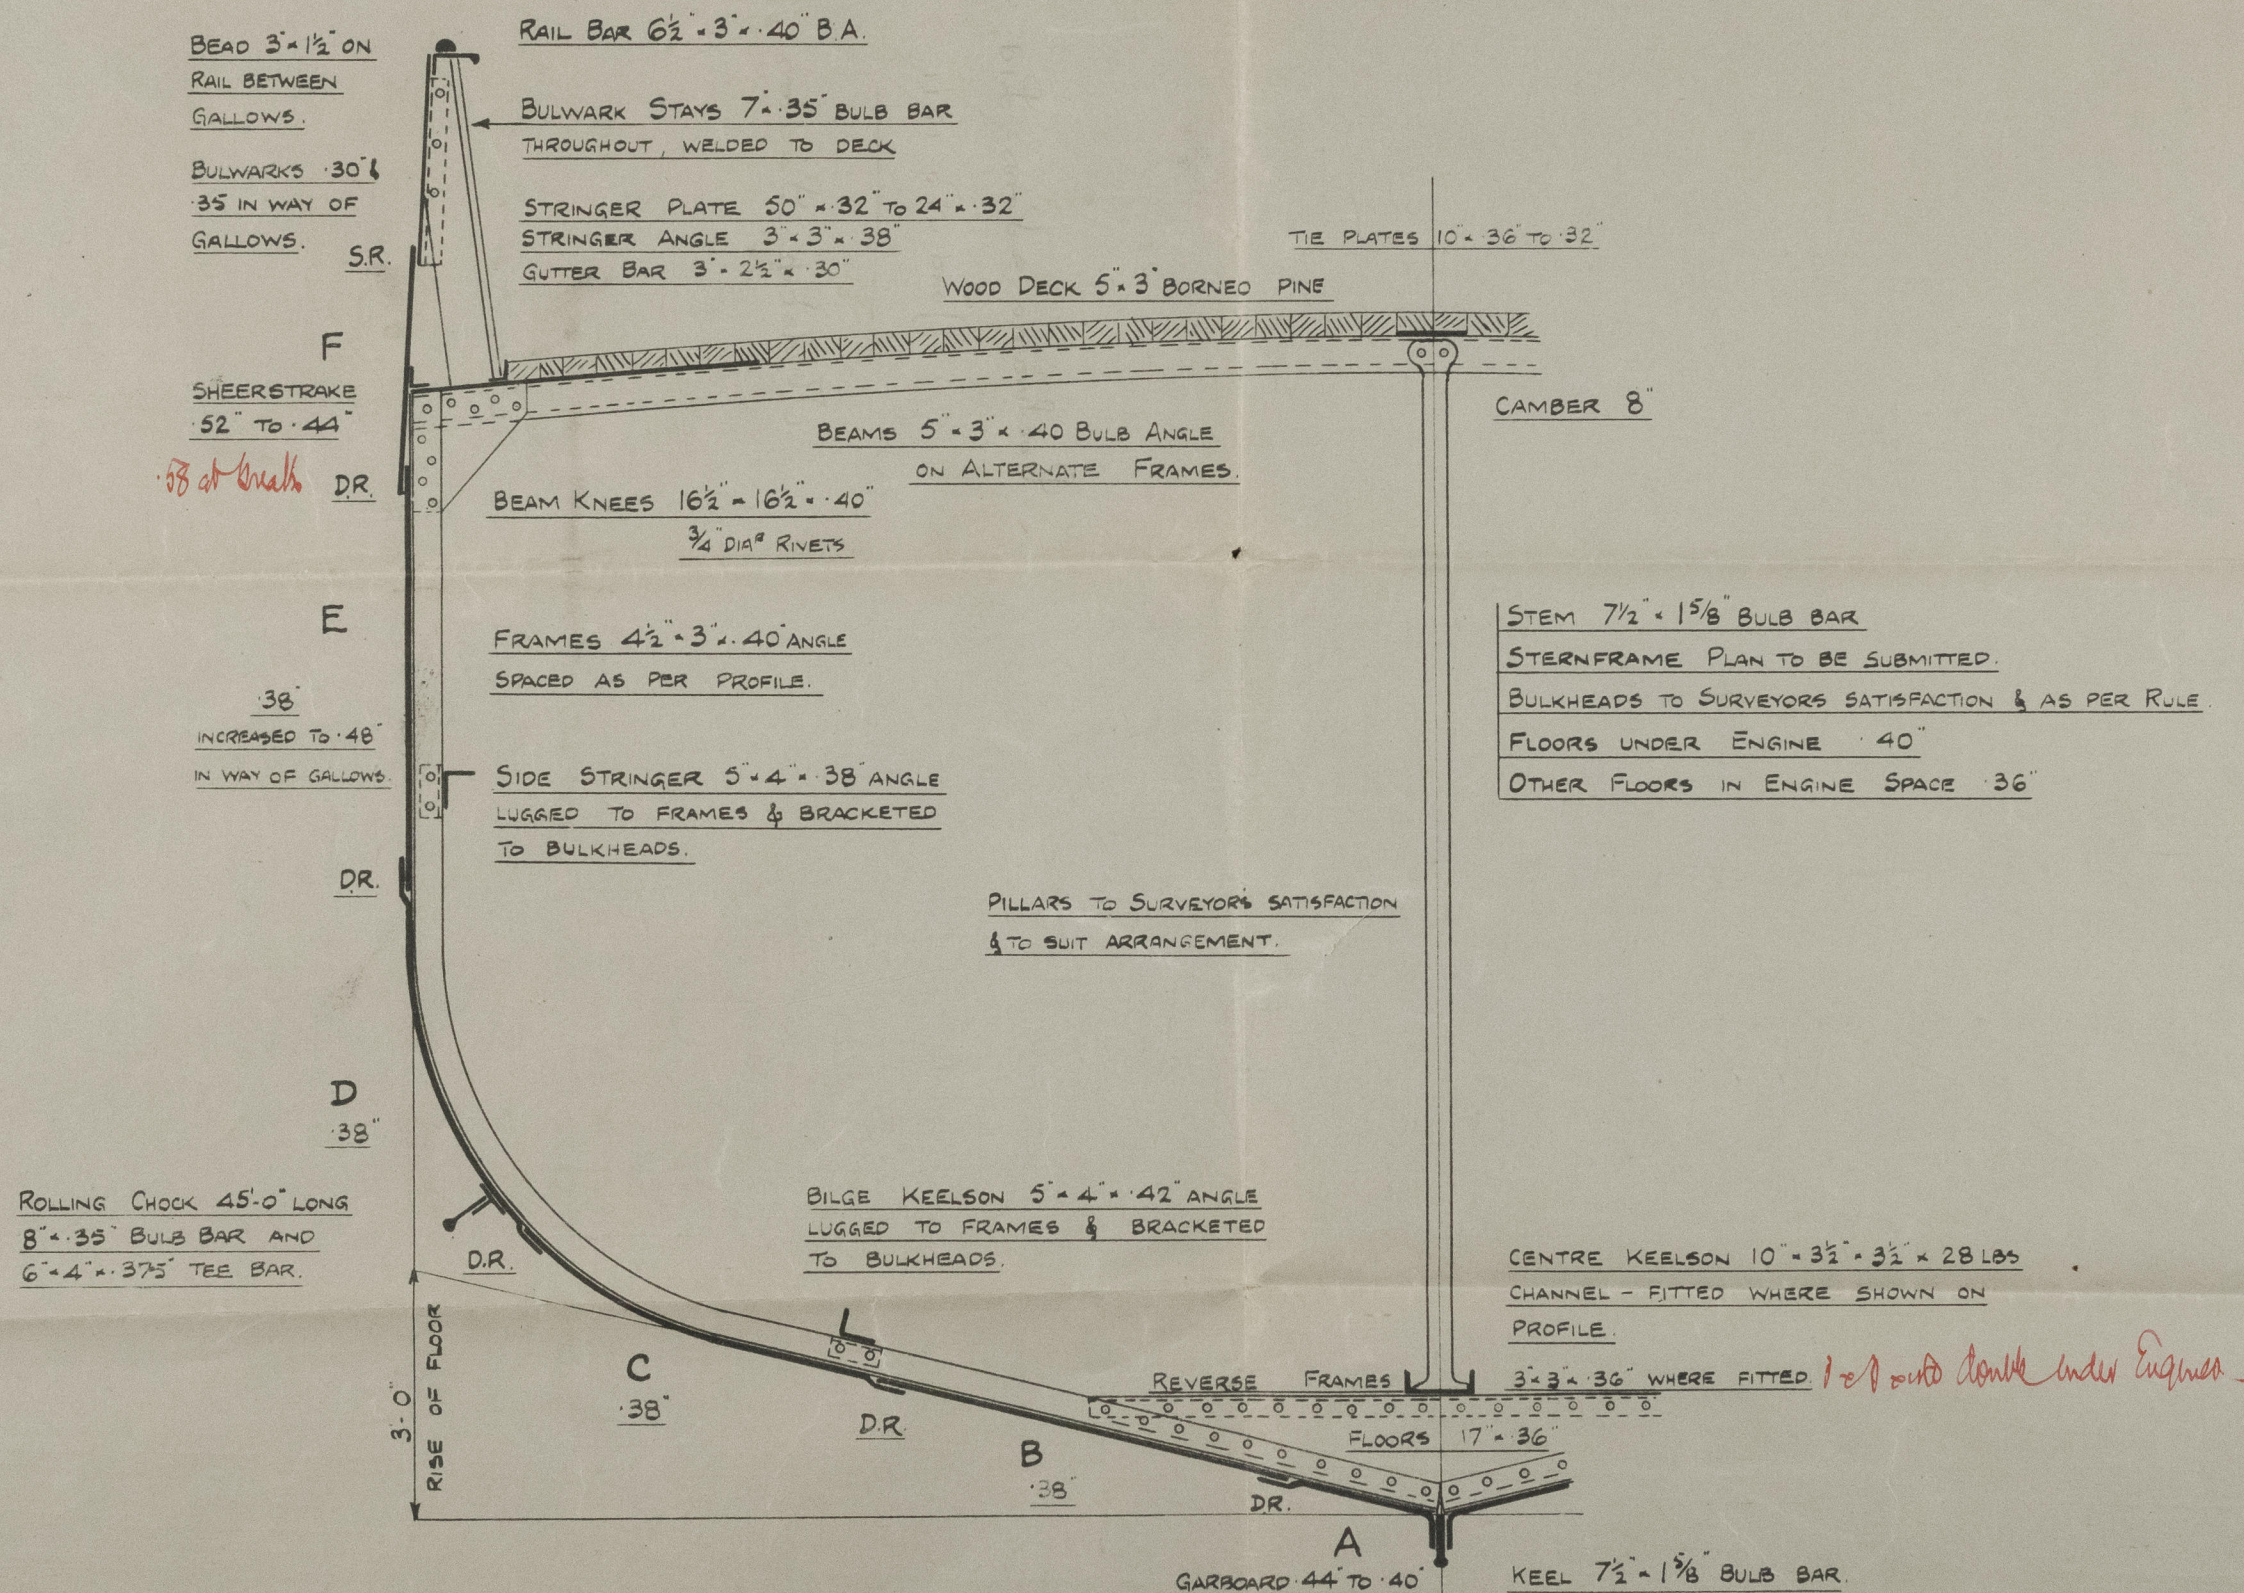



PLAN No 3791
FOR ENCLOSURE TO
Messrs Lloyd's Register
of Shipping
FROM
COCHRANE & SONS, LTD.
SHIPBUILDERS, SELDY.
DATE 19.10.39.

MIDSHIP SECTION
STEEL MOTOR TRAWLER

HULL

Cochrane & Sons Ltd, Selly

Plan No. 1211

Midship Section

Struct 51167

Port

