


S.S. UMLAZI

PROPOSED STEEL CROSS BUNKER BULK

SCALE $\frac{1}{2}'' = 1'$

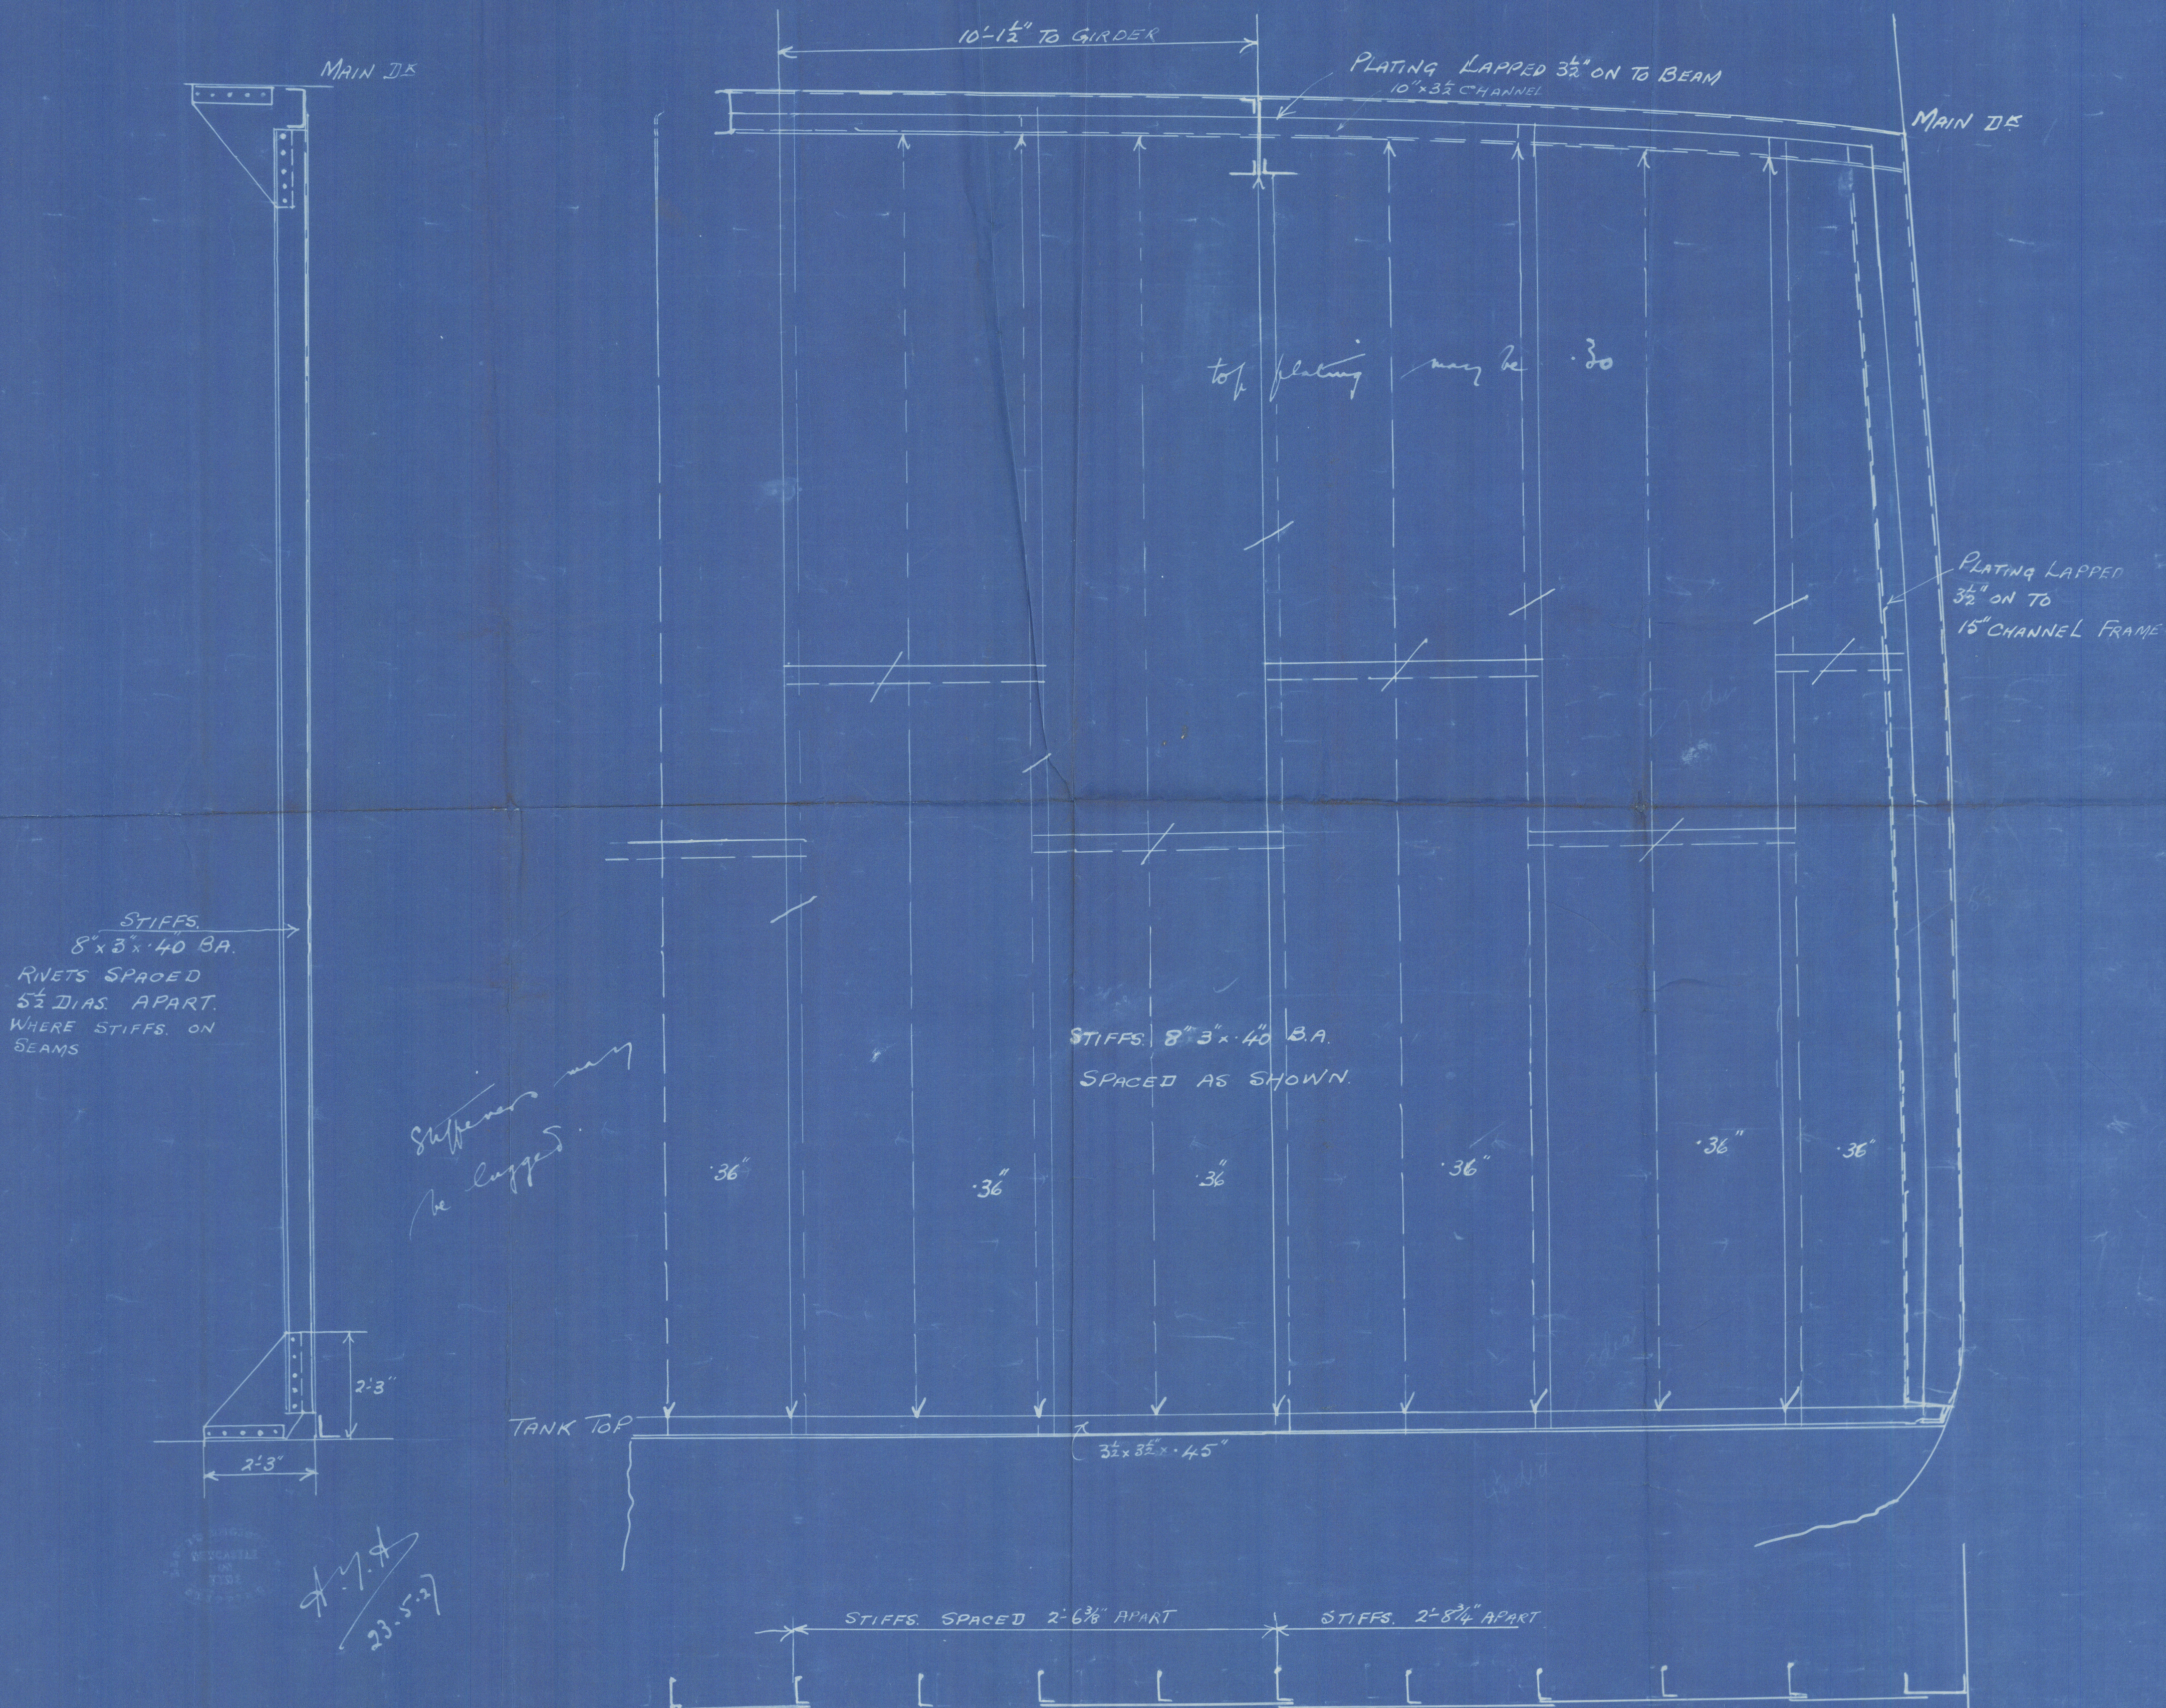

J. Unlazi

Aug / 1914

from W. T. Buckhead


S.S. Unlazi

New Cross Bunker

Buckhead

fitted June 1927

New Rept. No. 81492

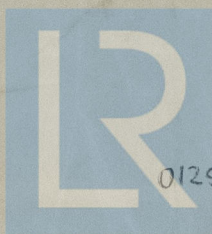

© 2021

Lloyd's Register
Foundation

012514-012621-0146