

STEEL SCREW STEAMERS - SINGLE DECK TYPE.



SHIPS Nos 19 & 20.

PLAN No

DIMENSIONS


LENGTH B.P. 380'-0" BREADTH M^d 49'-0" DEPTH M^d 30'-0"

SCALE 1/8" = ONE FOOT.

 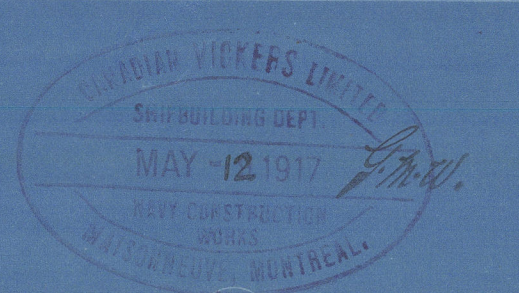


Sketch of A. Peak Bldg etc. & Tunnel Revis to be submitted


Sketch of Coll. Bldg & painting arrangements to be submitted

 

PLAN of TANK TOP

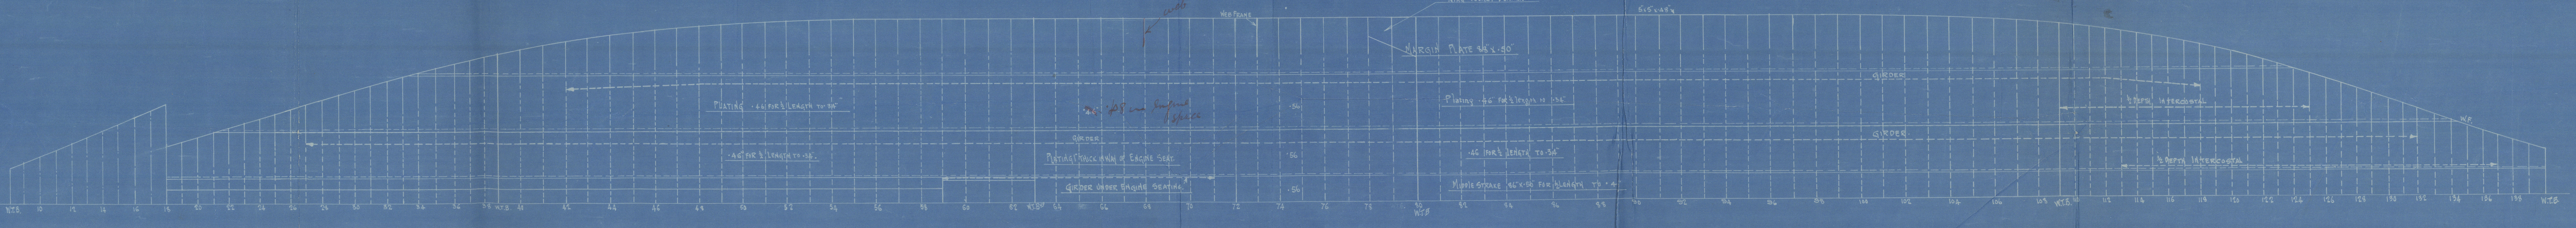

J. J. J. J.

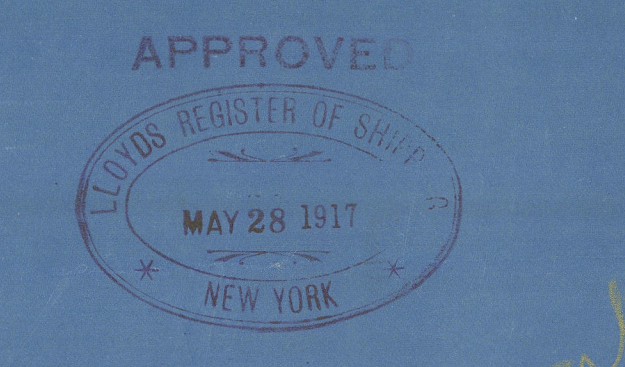


19-20





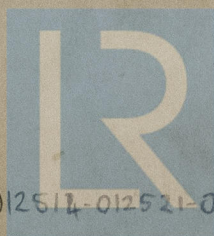

© 2021

Lloyd's Register
Foundation

012514-012521-0146

Montreal

0146



© 2021

Lloyd's Register
Foundation