

PROFILE & DECK.


STEEL SCREW TUGS.

N^os 380-M. "NOBLEMAN"

DIMNS. 100'-0" B.P. x 25'-0" M.L.D. x 13'-0" M.L.D.


TO CLASS 100 A.1. AT LLOYDS.

SCALE 1/4" = 1 FT.

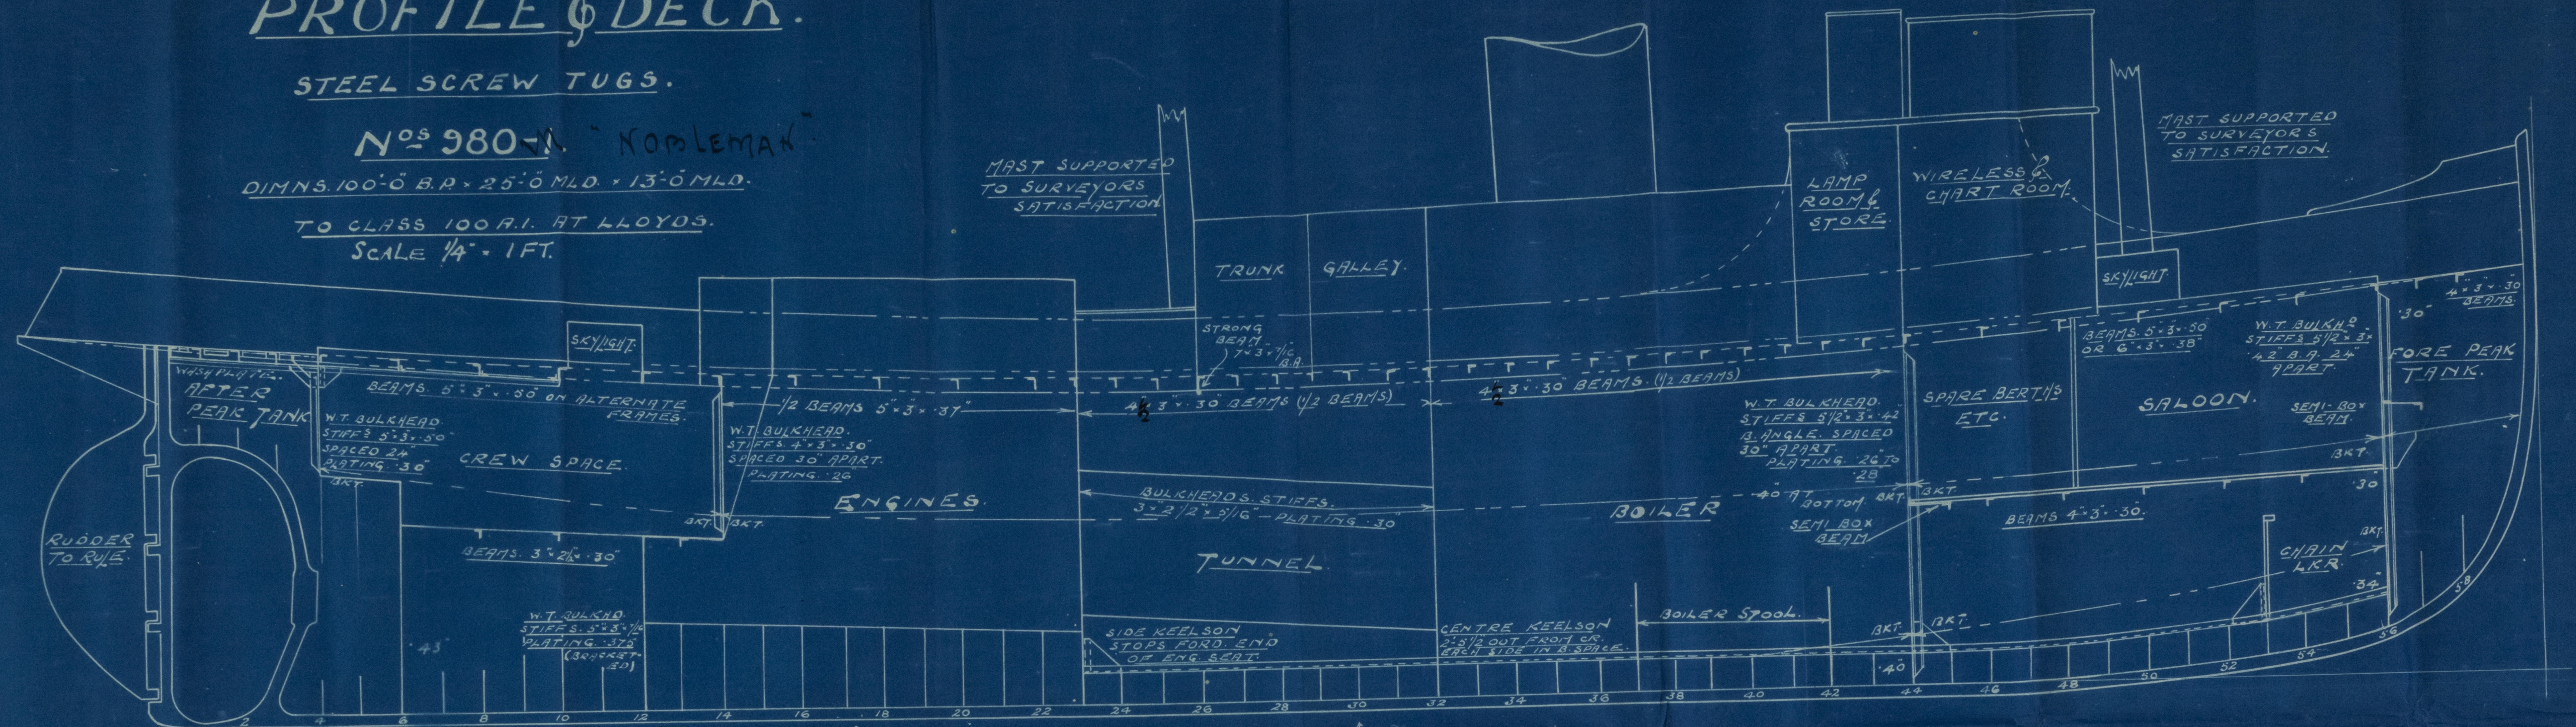

FRAME SPACING. 20" THROUGHOUT.

PILLARING THROUGHOUT TO RULE & TO SURVEYORS SATISFACTION.

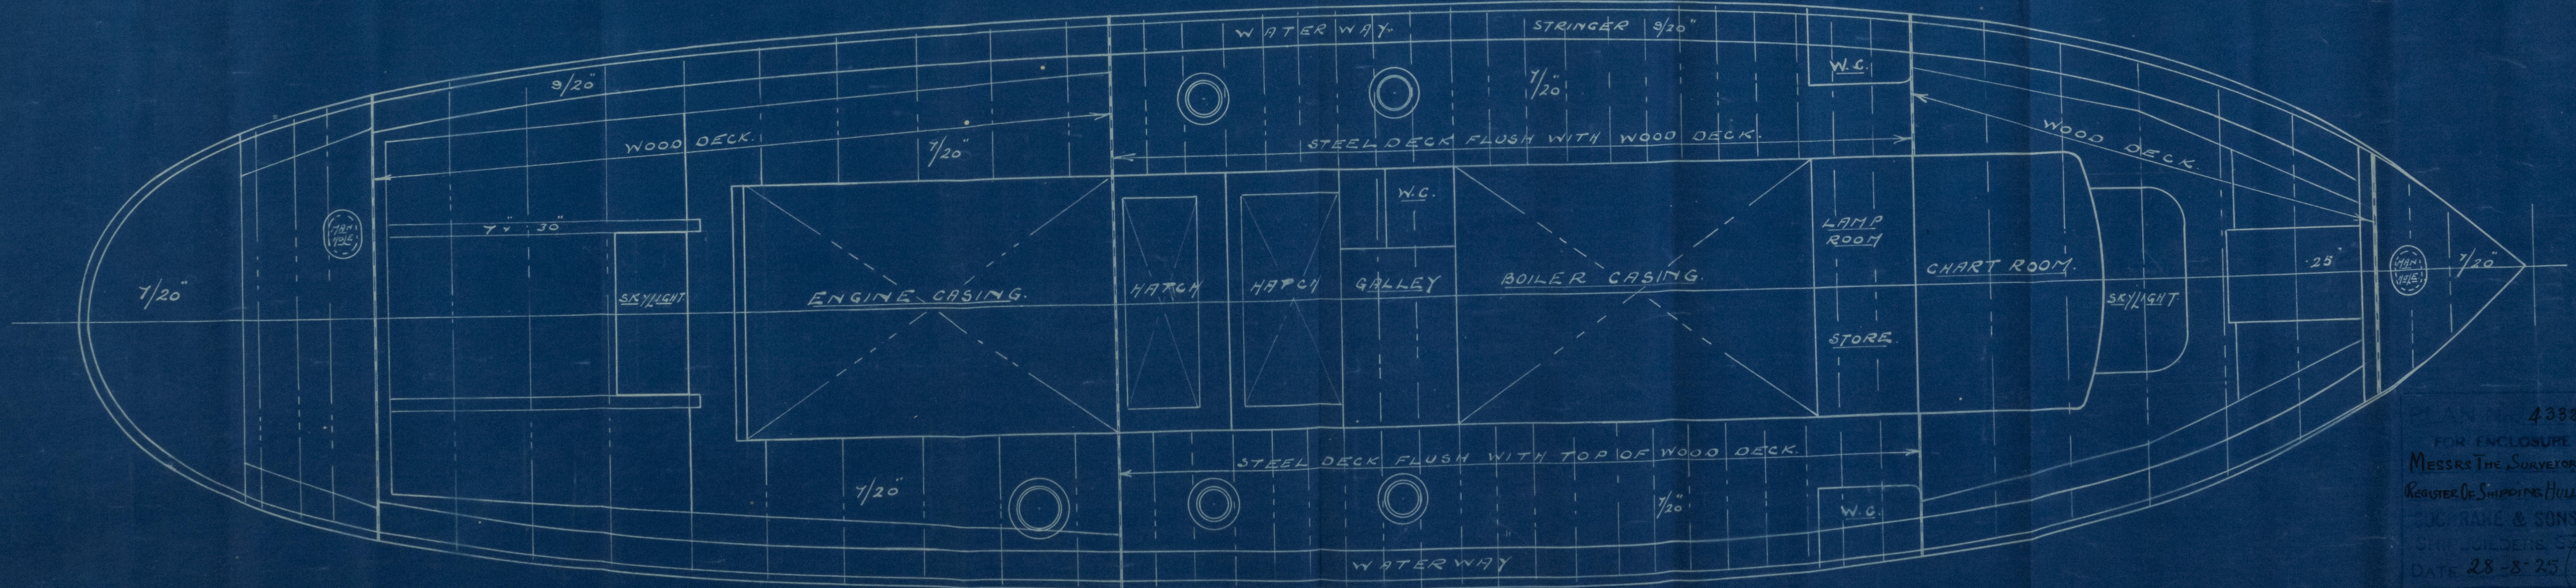

PLAN NO. 4382
FOR ENCLOSURE TO
MESSRS THE SURVEYORS LLOYDS
REGISTER OF SHIPBUILDING HULL FROM
JOHN & SONS LTD.
SHIPBUILDERS, 52, 54
DATE 28-8-25



Cochrane + Sons

Profile + Oh Plans.

N^o 980

"NOBLEMAN"

etc built

Hull Report No. 36528.
8



© 2021

Lloyd's Register
Foundation

012514-012821-0178