

NUMERALS

D. 13.00
 L x D. 1300 00
 L x (B D) 3800 00
 L/D 7.69
 d 11.67

EQUIPMENT

1st BOILER ANCHOR 6 1/4" CWTs STOCKLESS.
 2nd " 5 1/2 " "
 90 FATHOMS 1" STUD LINK CHAIN.
 60 5 1/2" HAWSER
 60 4" WARP.

MIDSHIP SECTION

STEEL SCREW TUGS


Nos 980-M "NOBLEMAN"

DIMNS:- 100'-0" B.P. x 25'-0" MLD x 13'-0" MLD.

1/2" SCALE.

CLASS 100 A1 FOR TOWING PURPOSES.

PLAN No. 4334
 FOR ENCLOSURE TO
 MESSRS THE SURVEYORS LLOYDS
 REGISTER OF SHIPPING HULL FROM
 COCHRANE & SONS, LTD.
 DATE 28-8-25

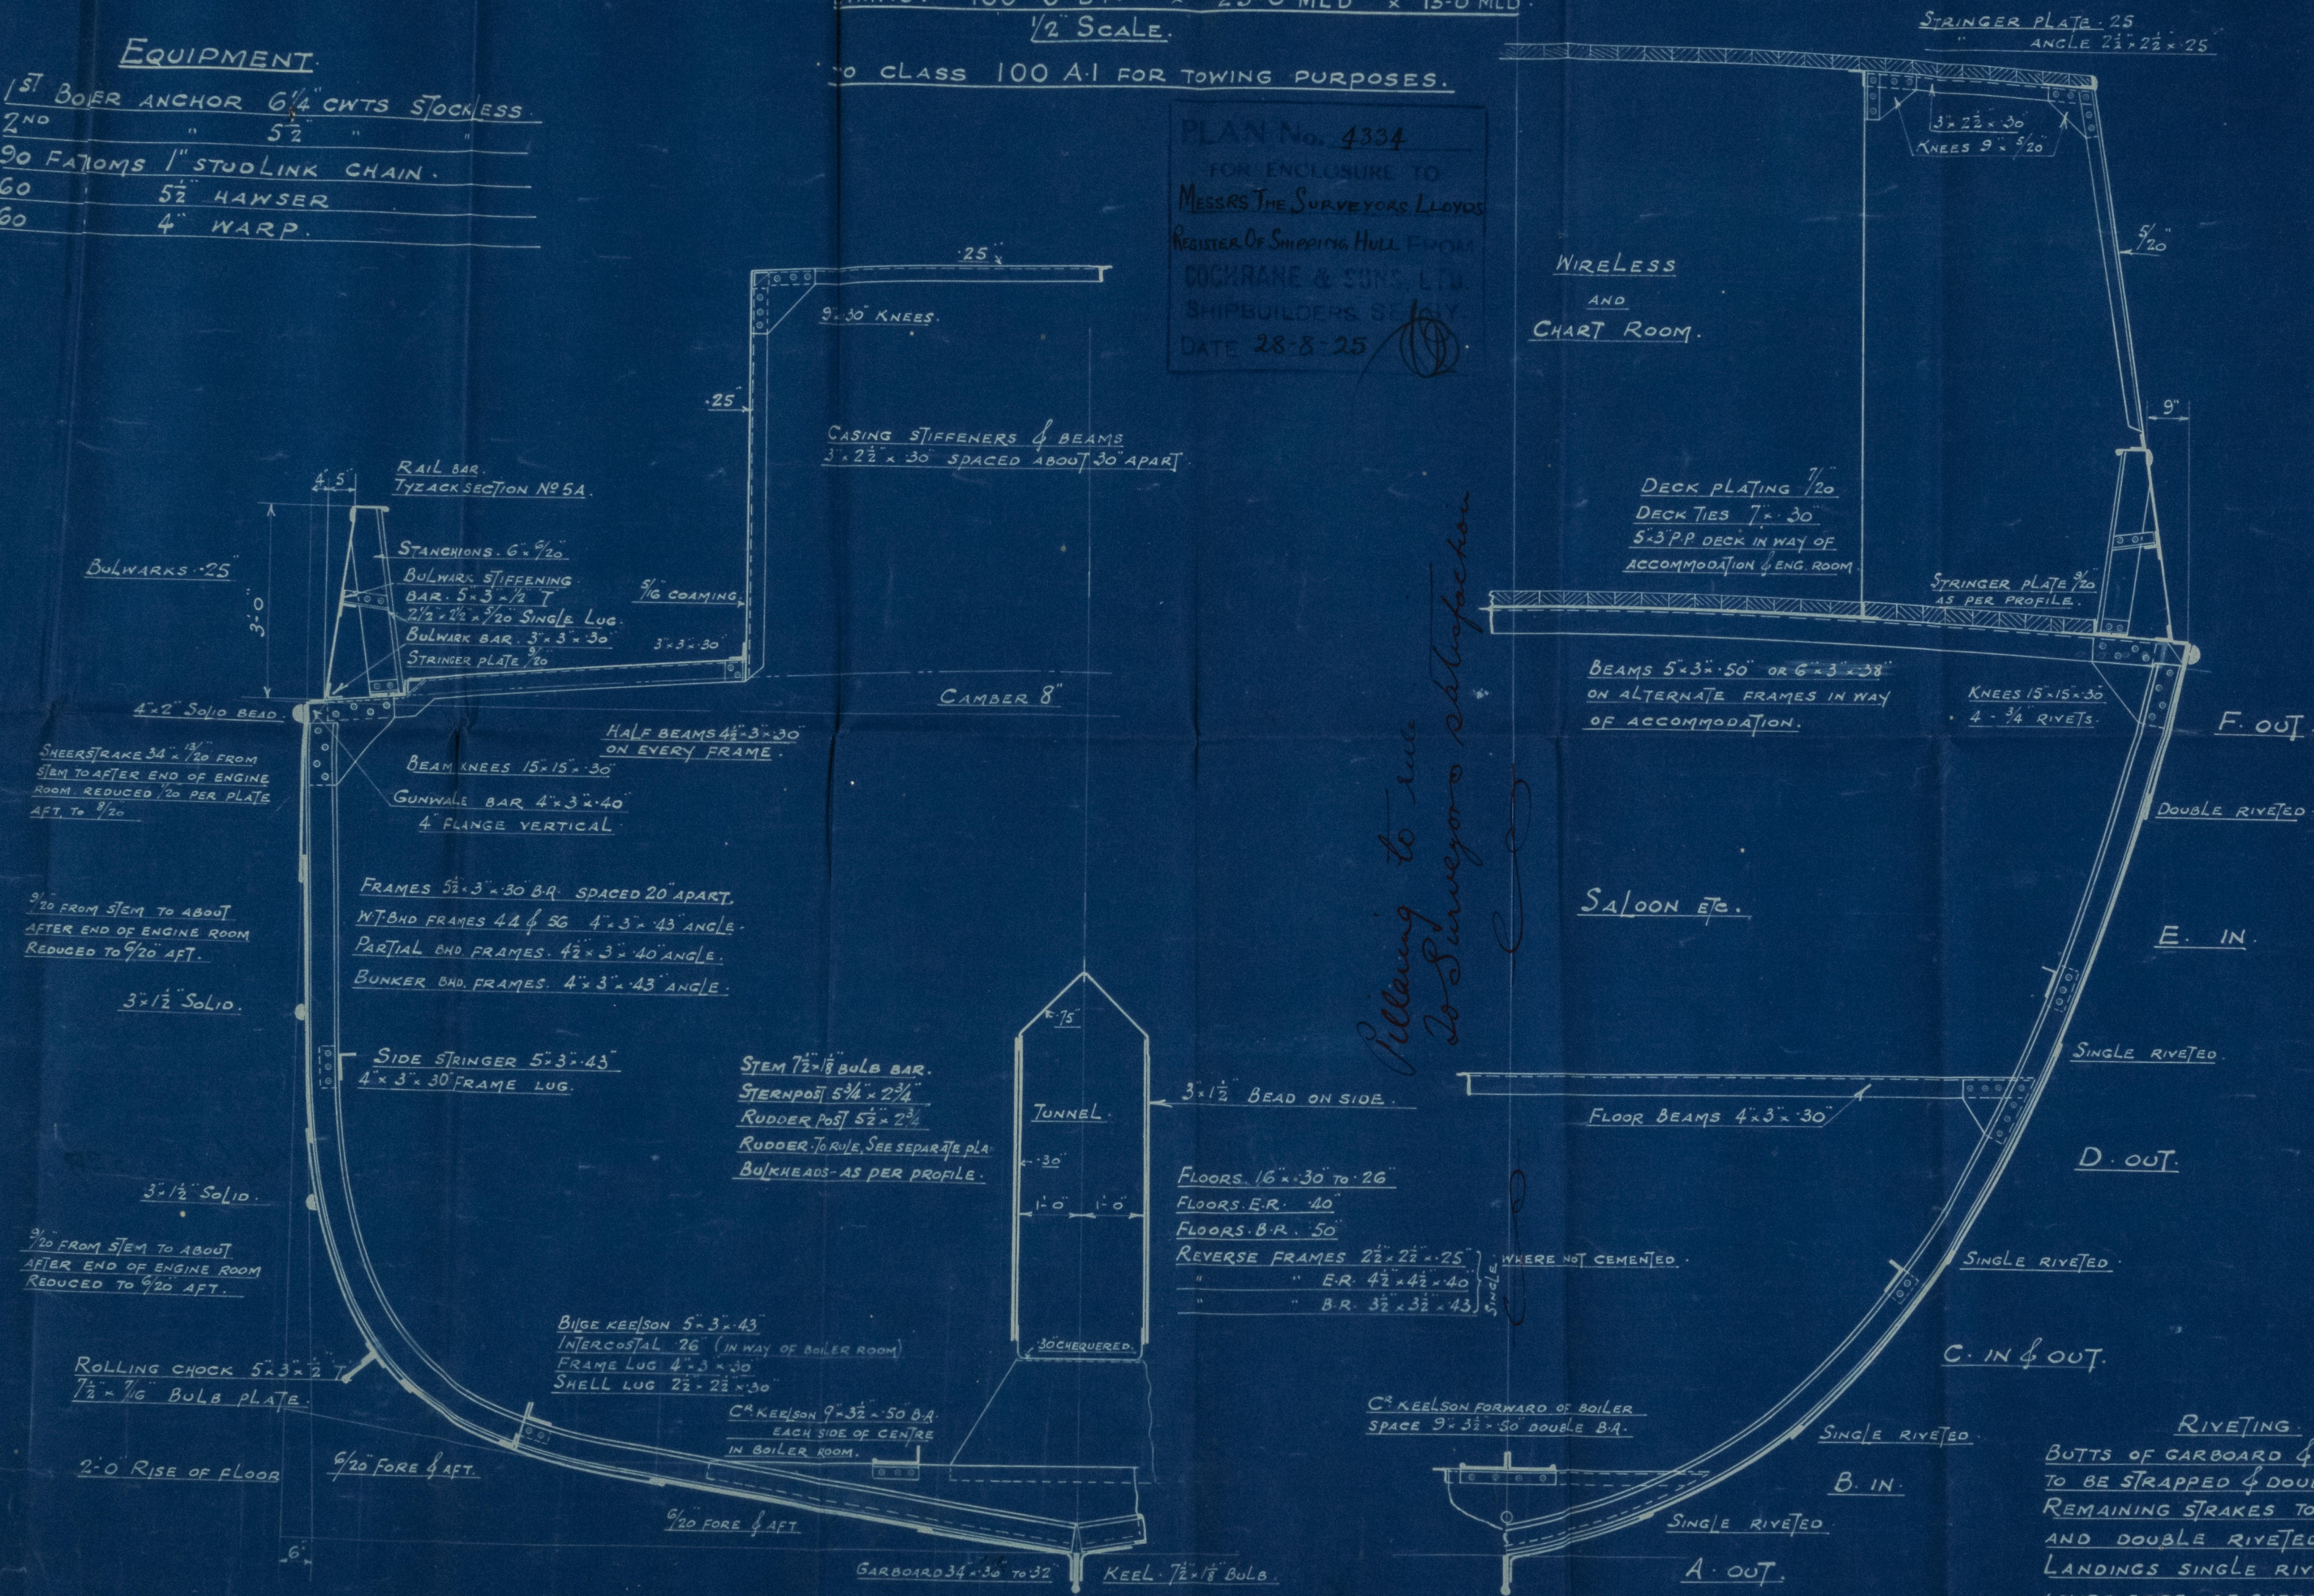

RIVETING.
 BUTTS OF GARBOARD & SHEERSTRAKE
 TO BE STRAPPED & DOUBLE RIVETED.
 REMAINING STRAKES TO BE LAPPED
 AND DOUBLE RIVETED.
 LANDINGS SINGLE RIVETED EXCEPT
 LOWER EDGE OF SHEERSTRAKE WHICH
 IS TO BE DOUBLE RIVETED *maybe single riveted*

Midship Section
980-1

Cochrane Sons
Midship Section
No 980.

- NOBLEMAN -

also built

Hull Report 36529.

ST AGNES



© 2021

Lloyd's Register
Foundation

0125210-415210