

Lloyd's Register of Shipping.

(Report on Vessel No. 36528 Port Hull)W. S. Holleran.

No.

SHIP FORGINGS OR CASTINGS.

I have to report that the undermentioned Iron ~~or Steel~~ Forgings ~~or Castings~~, manufactured by M^{rs} J. S. Forster & Son L^{td} of Sunderland for the Vessel No. 980, being built by Cochrane & Son of Gelby have been inspected by me as set forth below and found to be, so far as can be seen, Sound.



Mark on Forgings ~~or Castings~~.

Lloyd's

No. 373619-6-25D. D. WilliamsonSunderland 20-6-25

	STERN FRAME.	RUDDER FRAME.	STEM.
Material*		<u>Scrap Iron</u>	
How made		<u>Forged</u>	
Dimensions		<u>5' dia 5' x 3 3/4" x 3 1/4" x 3"</u>	
Progress on Inspection		<u>Forged & Finished</u>	
Date when Inspected		<u>8-6-25 to 19-6-25</u>	
CASTINGS.			
Tests on Standard Test Pieces.			
Tensile Test—			
Tons per square inch			
Extension per cent.			
Cold Bending Test—			
Angle before fracture			
Drop Test—			
Height from ground			
Hammering Test—			
If made according to Rules and found satisfactory			

SKETCHES OF FRAMES SHOWING POSITION AND DESCRIPTION OF WELDS OF FORGINGS.

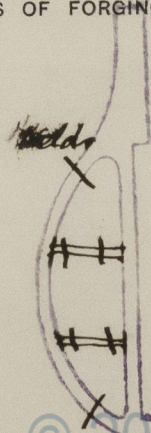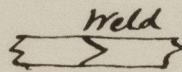


Fee (if any chargeable) £ : :

To be paid at

* If of Iron, state whether scrap or puddled Iron. If of Steel, state whether made on the Open Hearth process.

3m, 9.23. T.

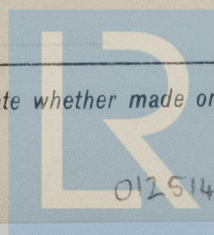

© 2021

Lloyd's Register
Foundation

012514-012521-0203