
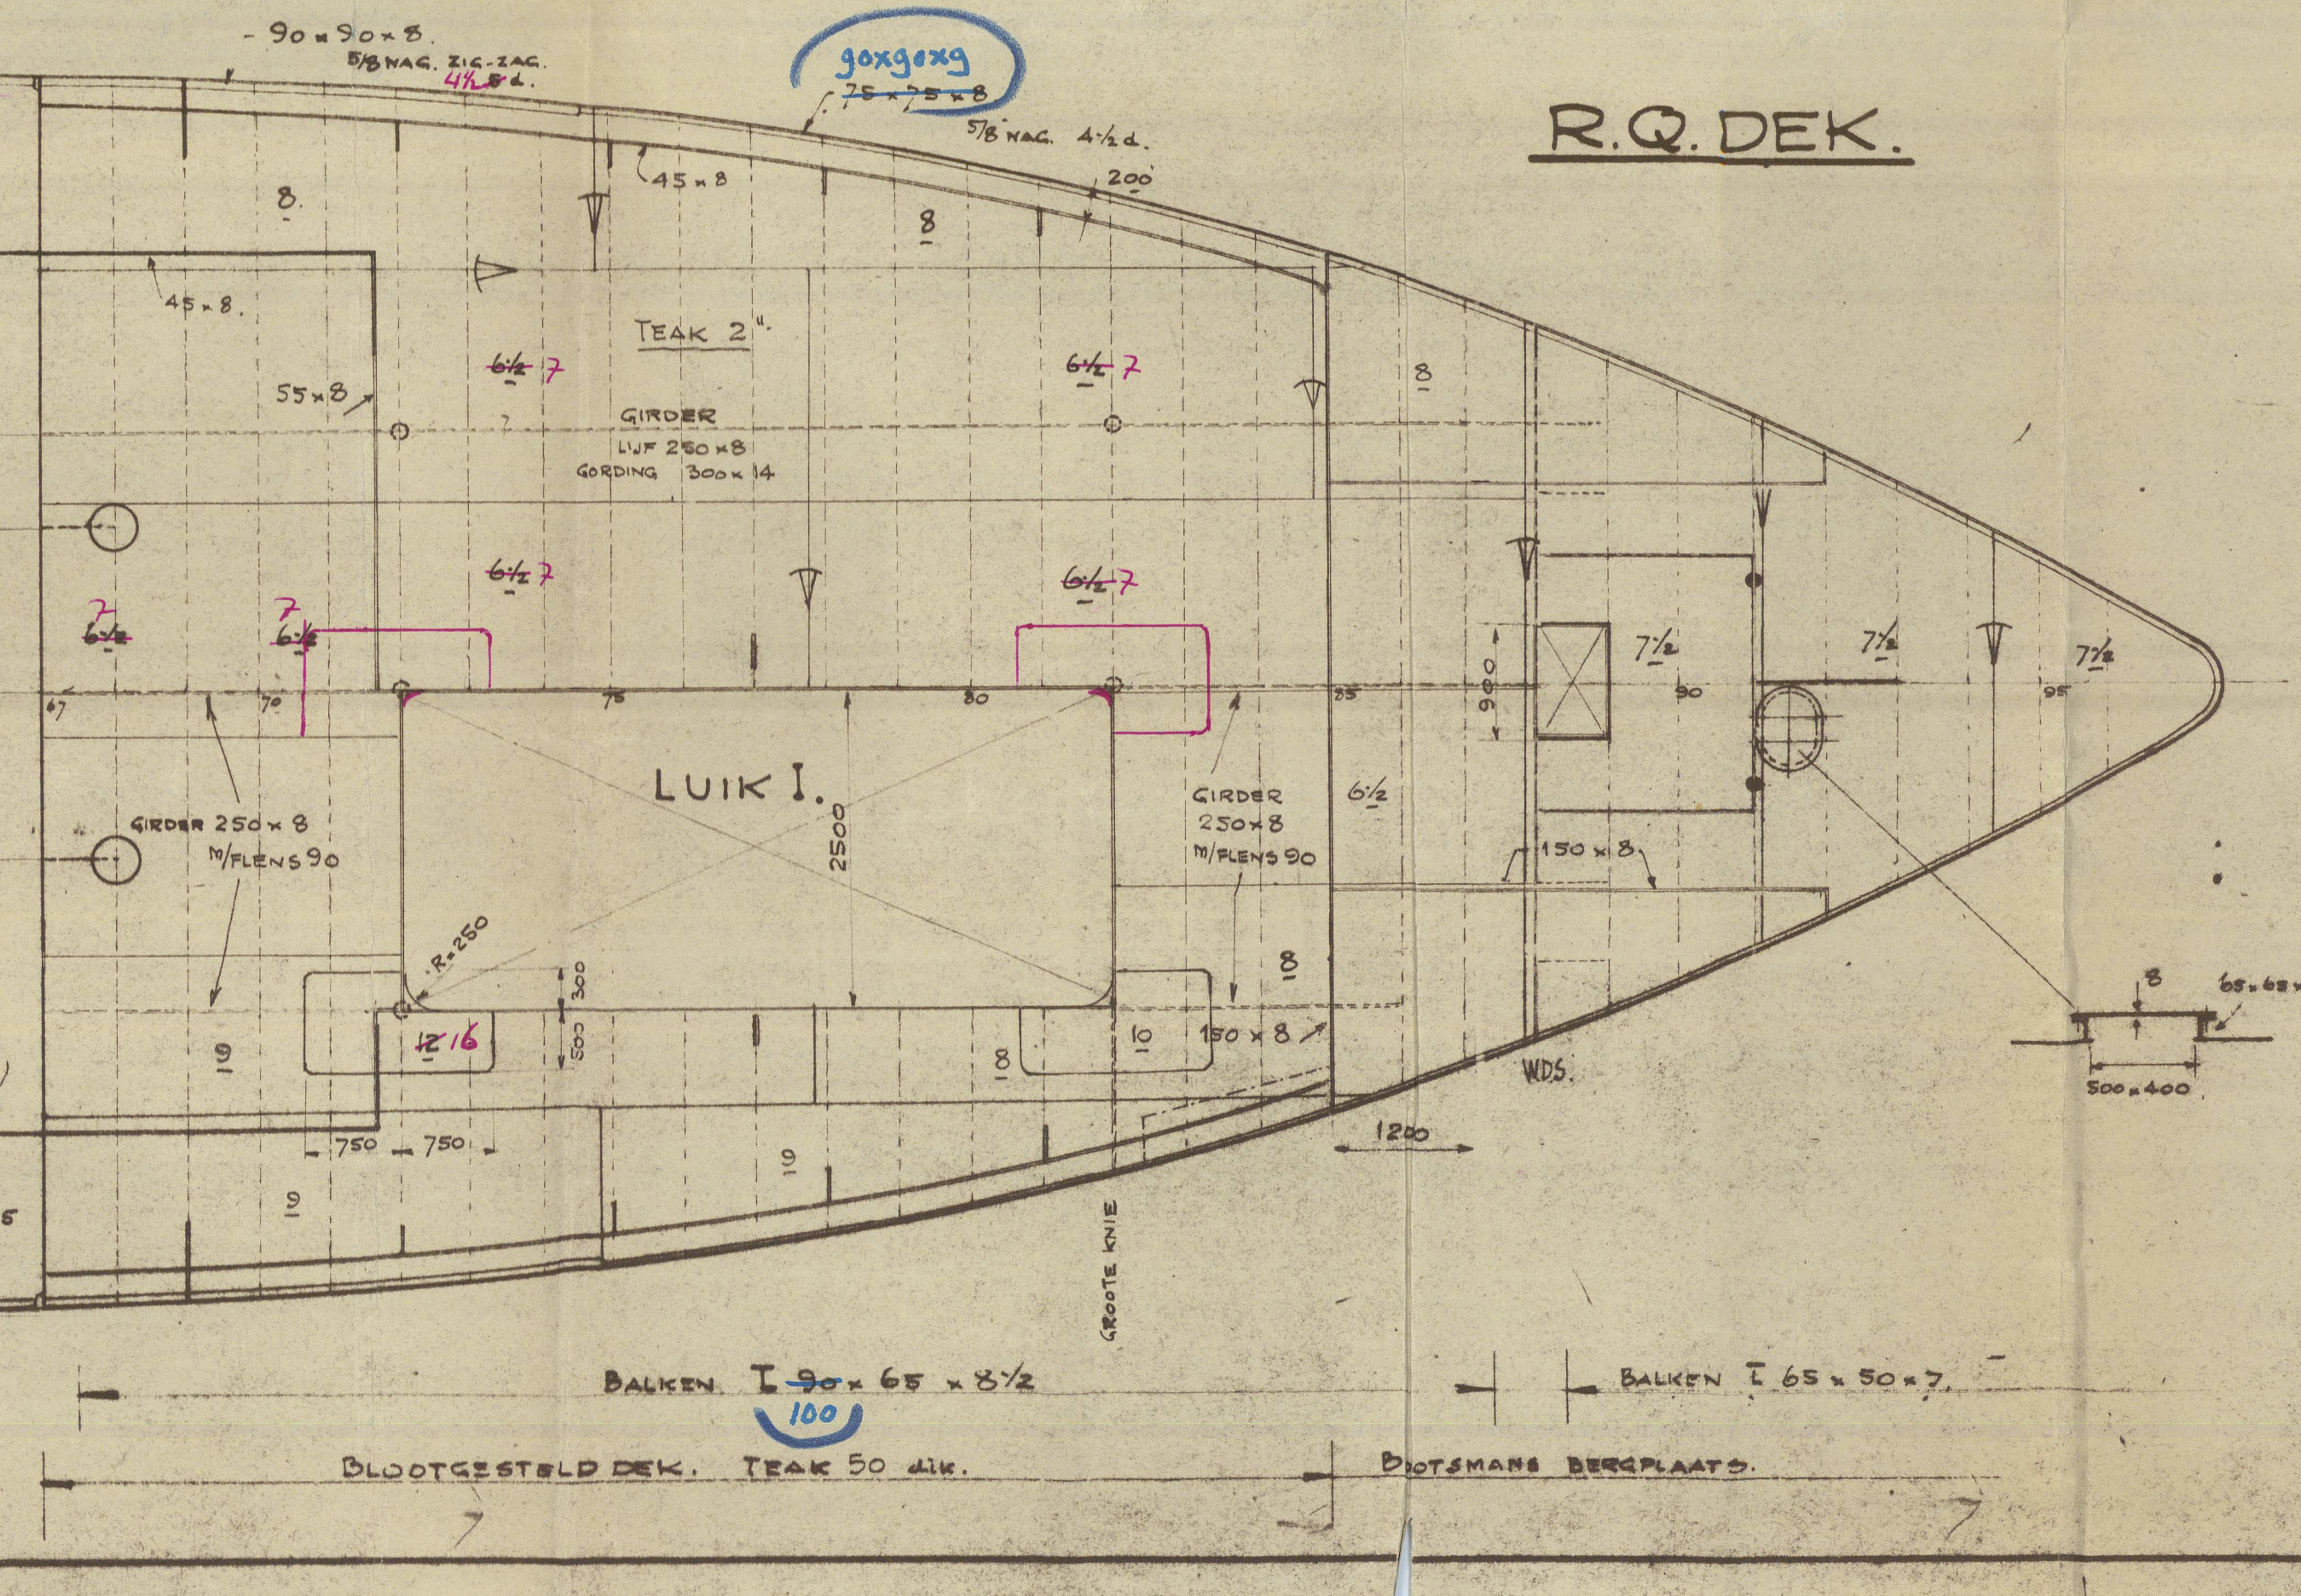
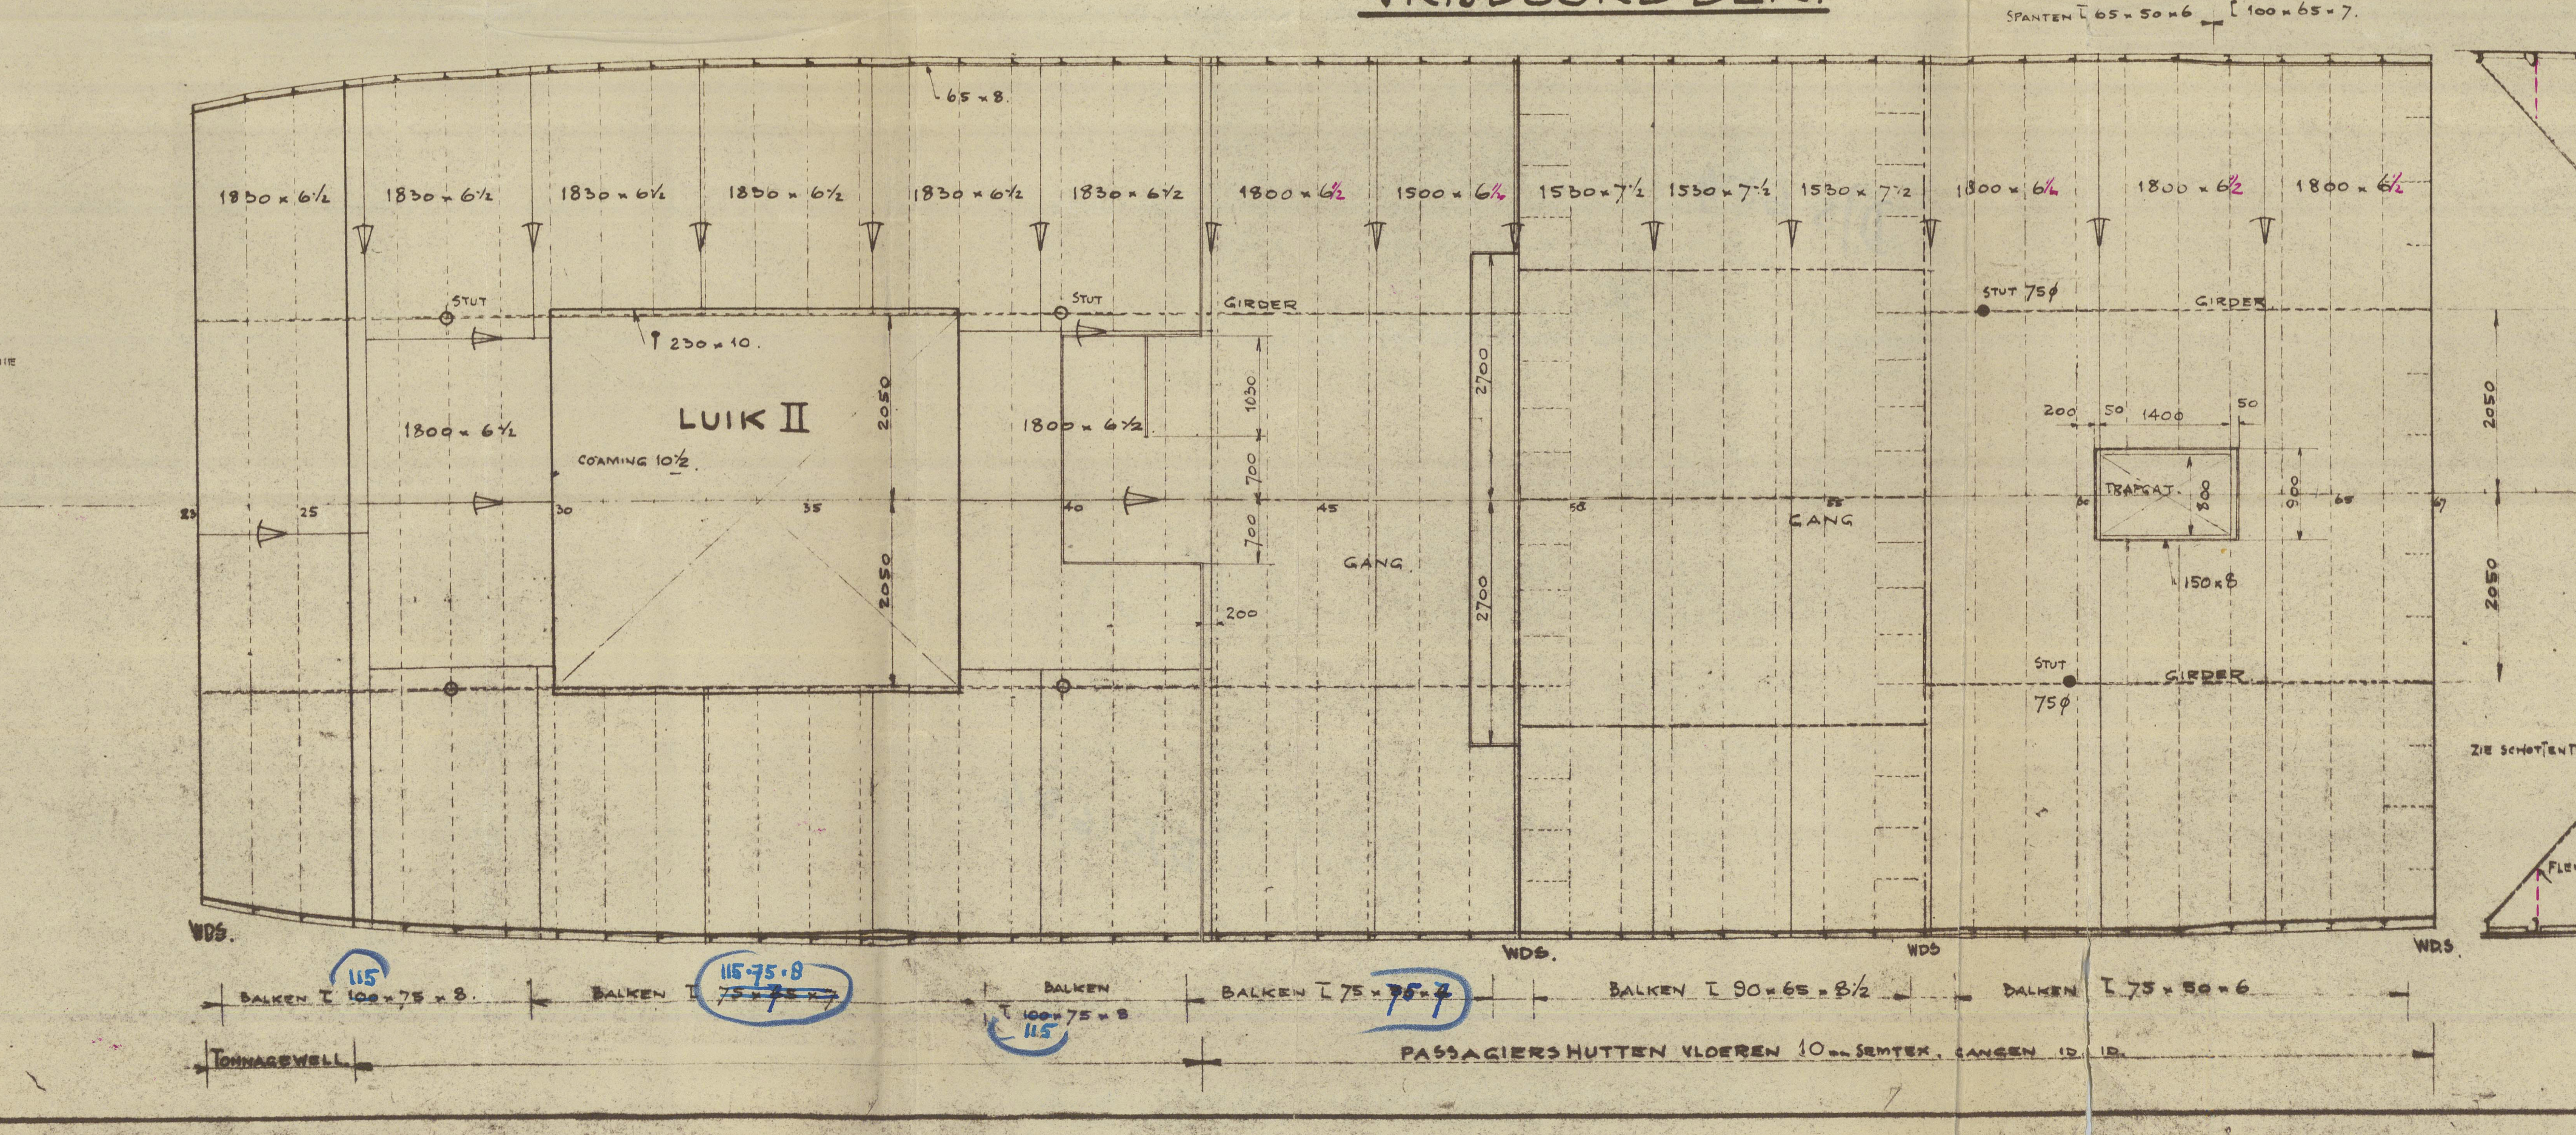
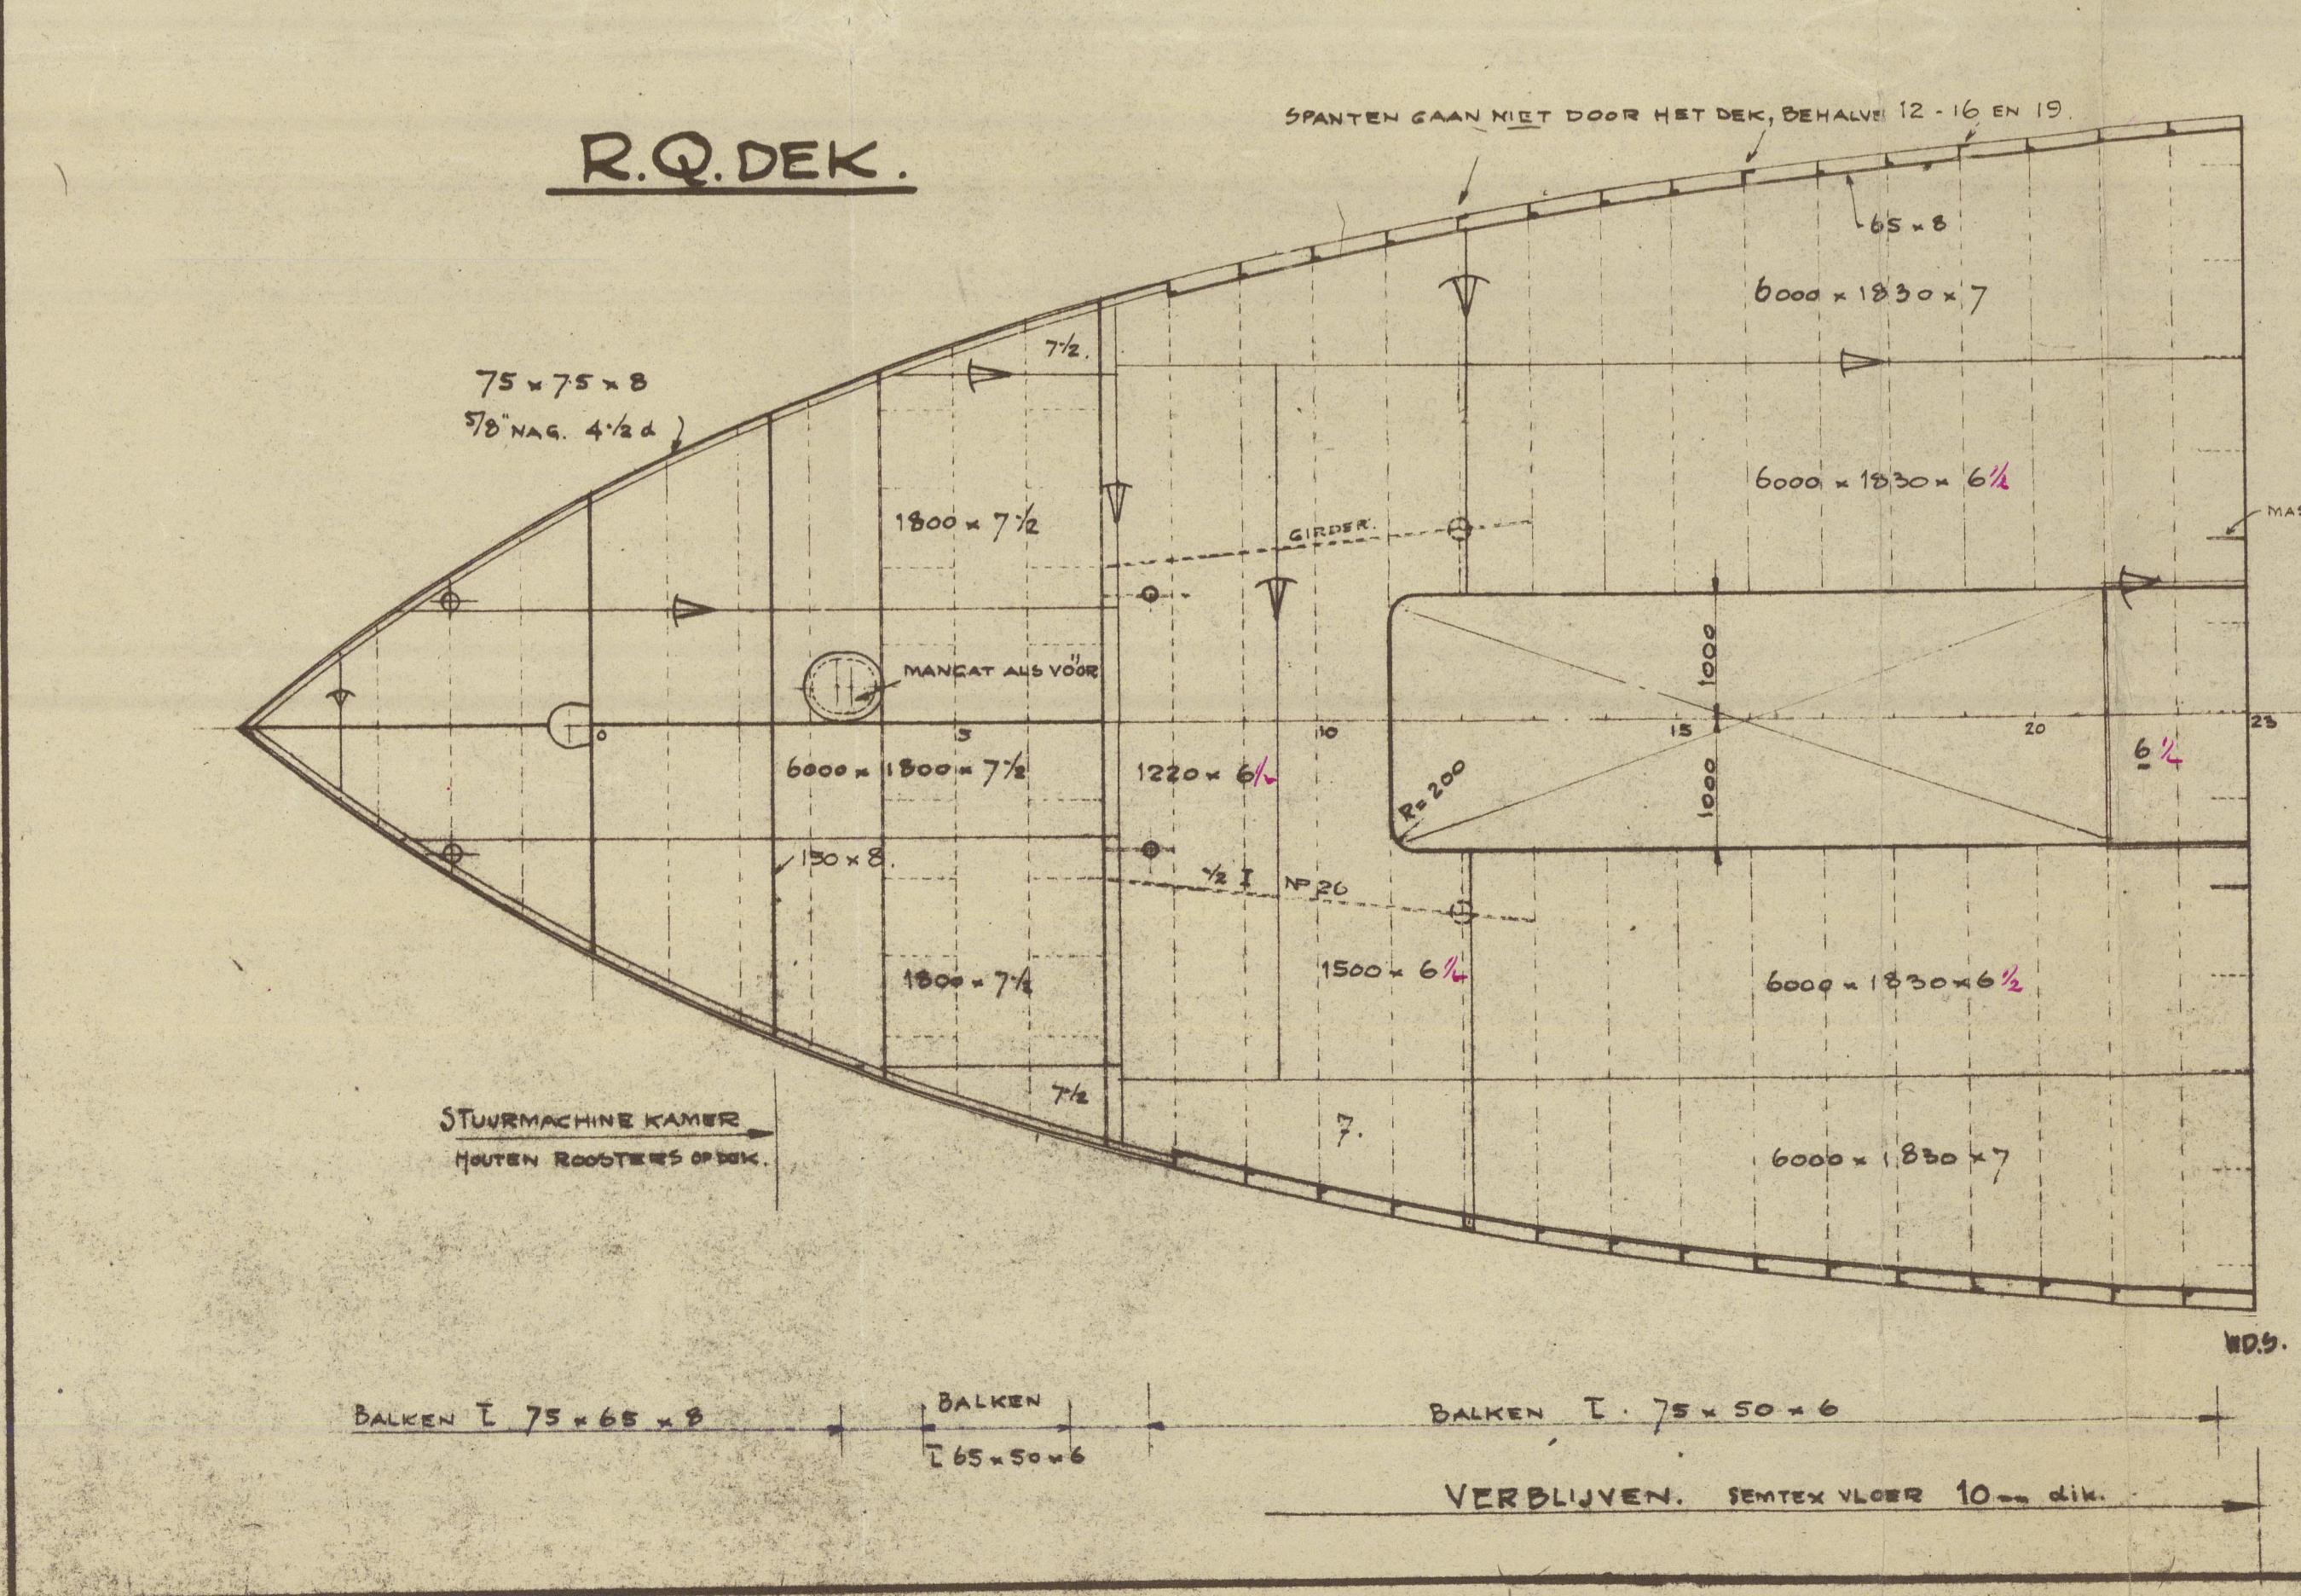
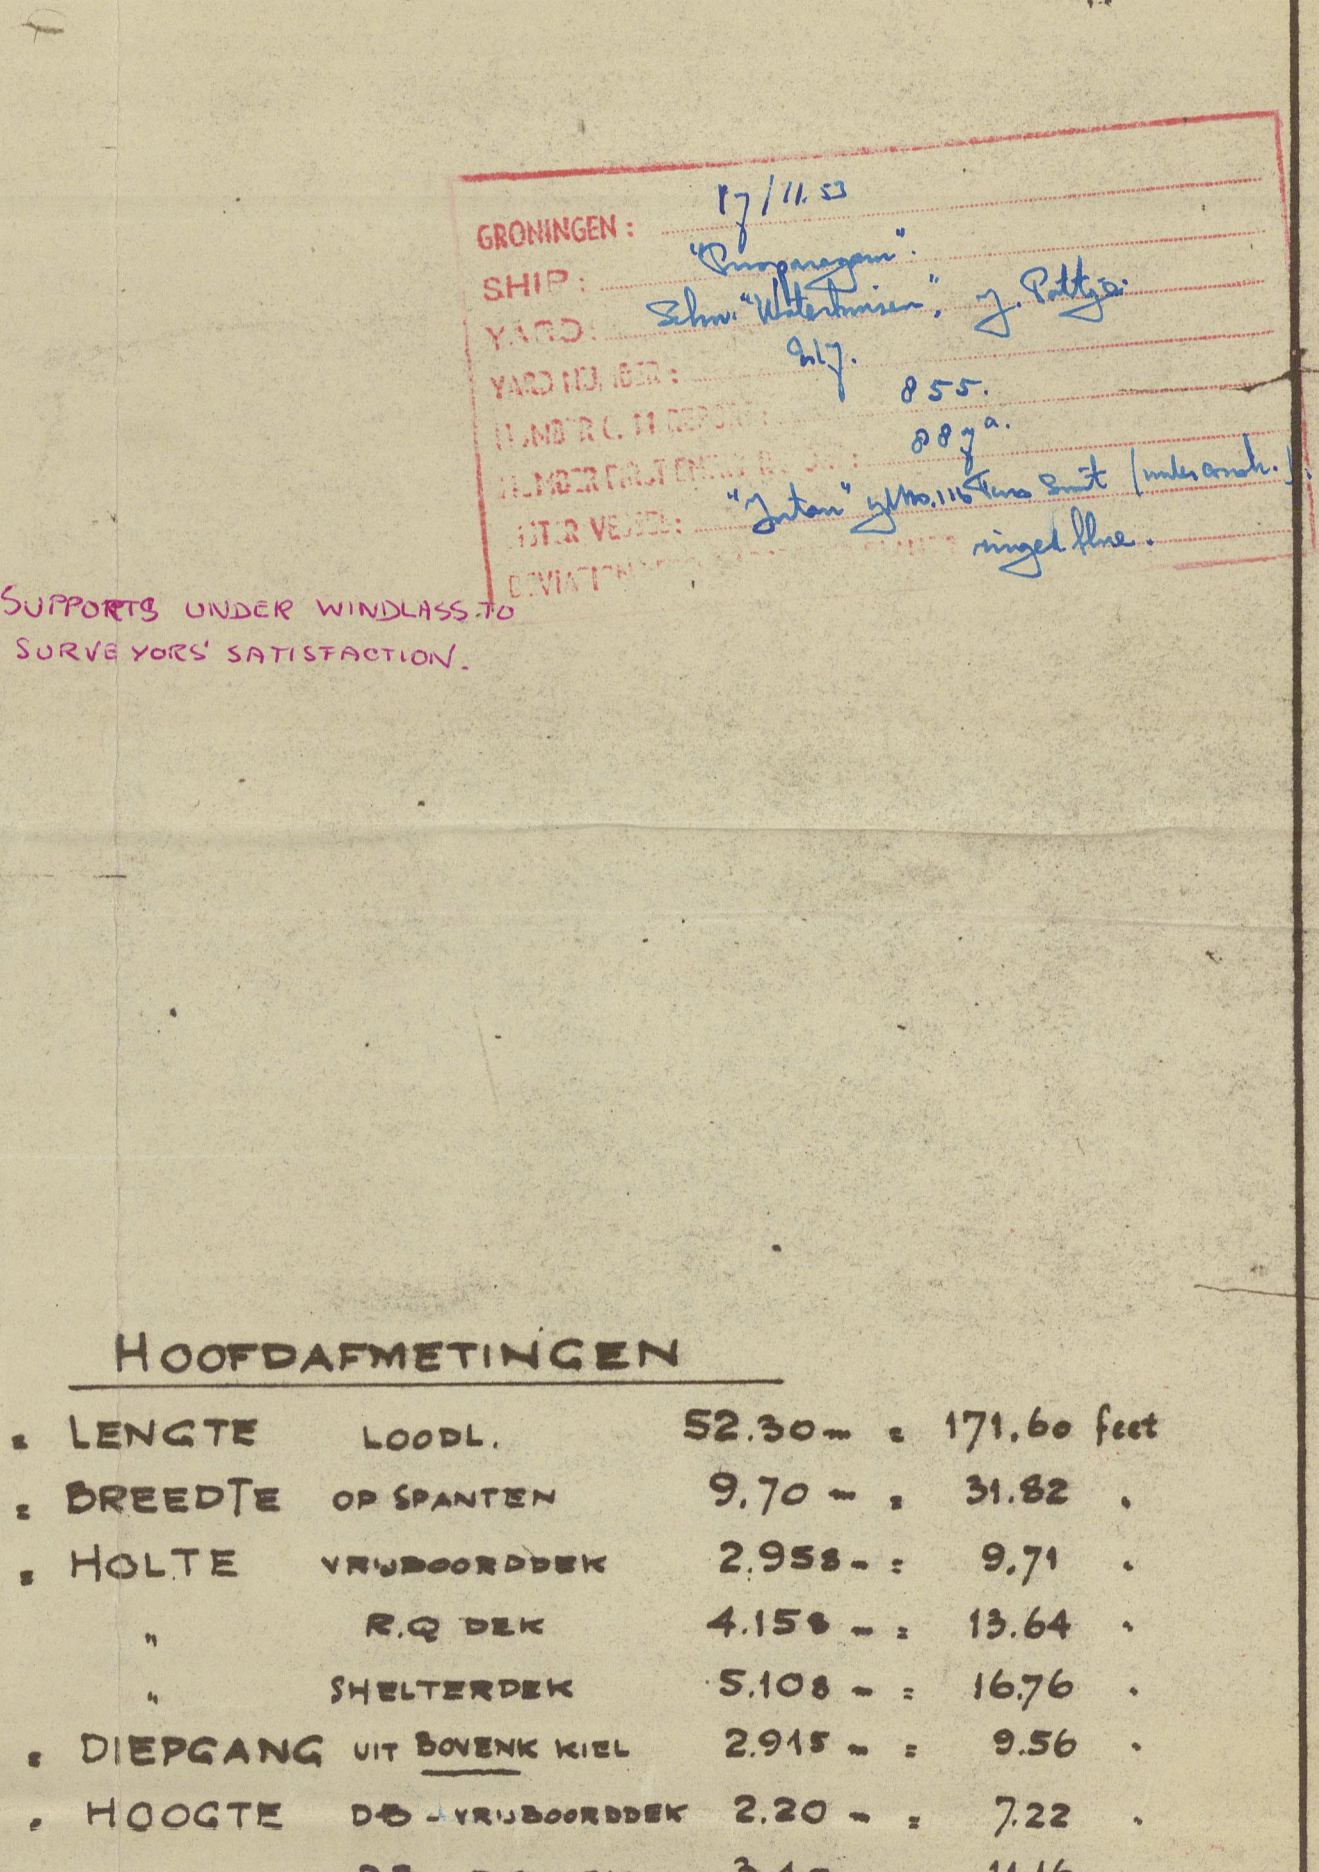
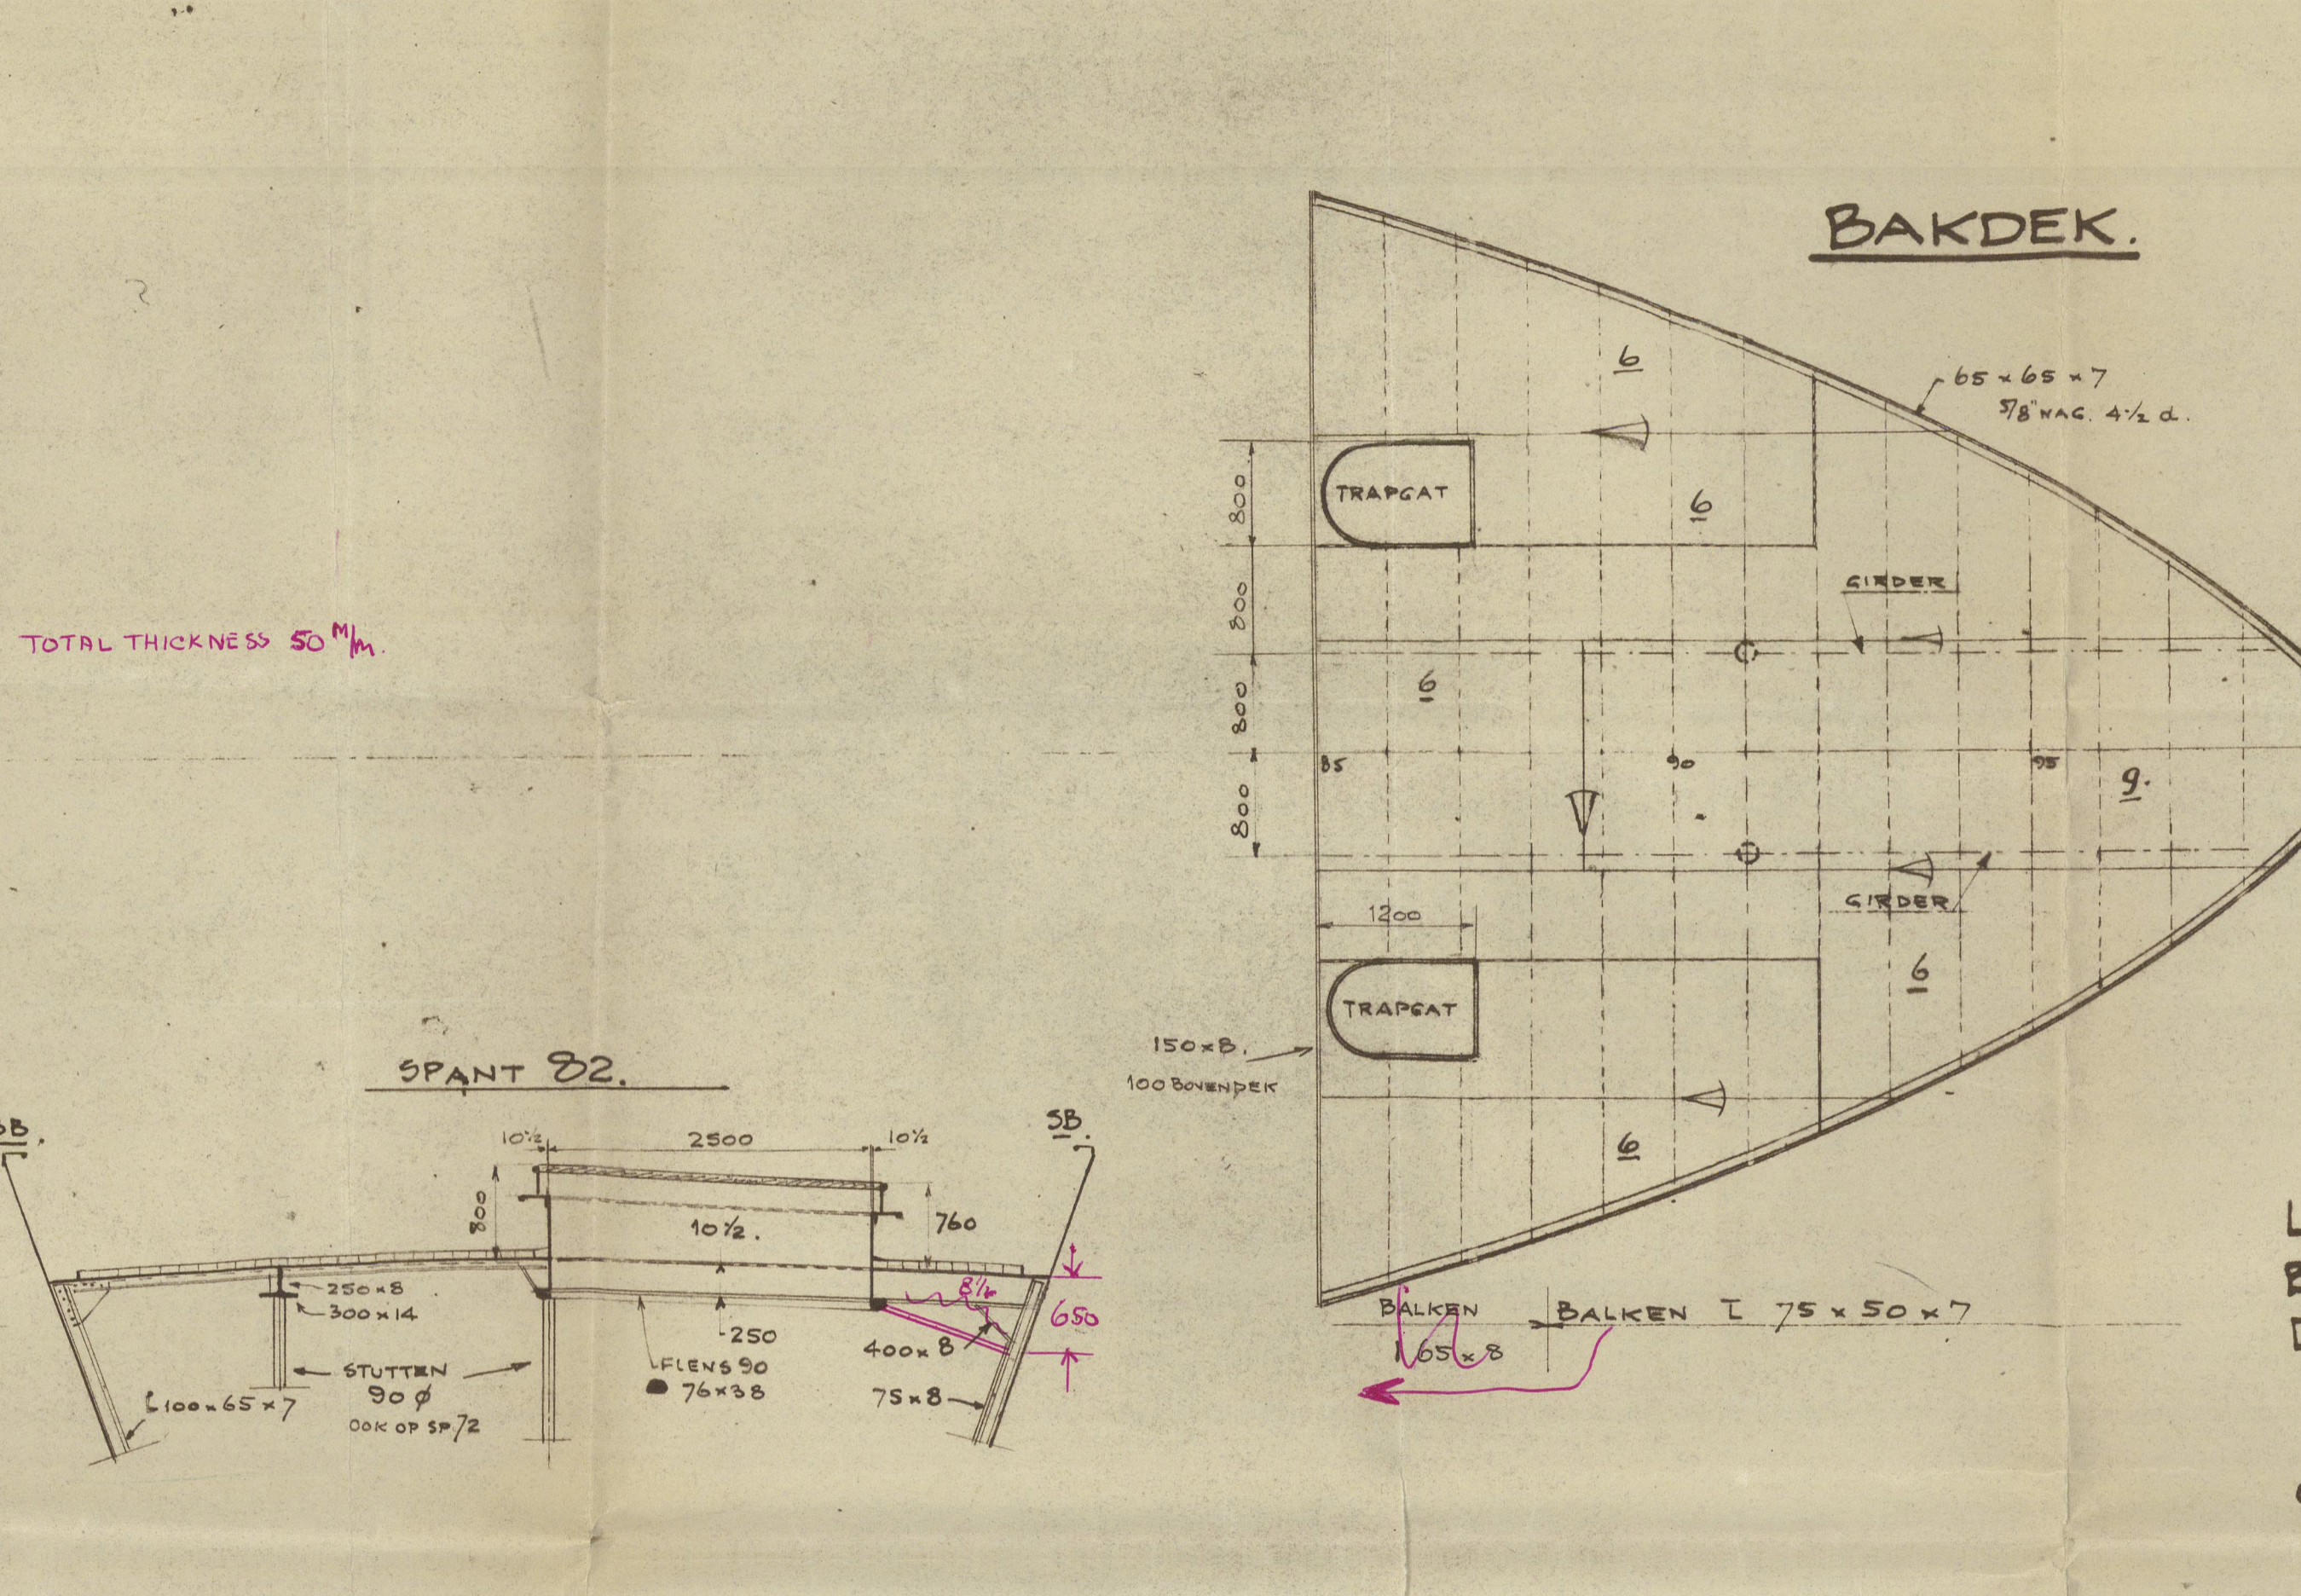
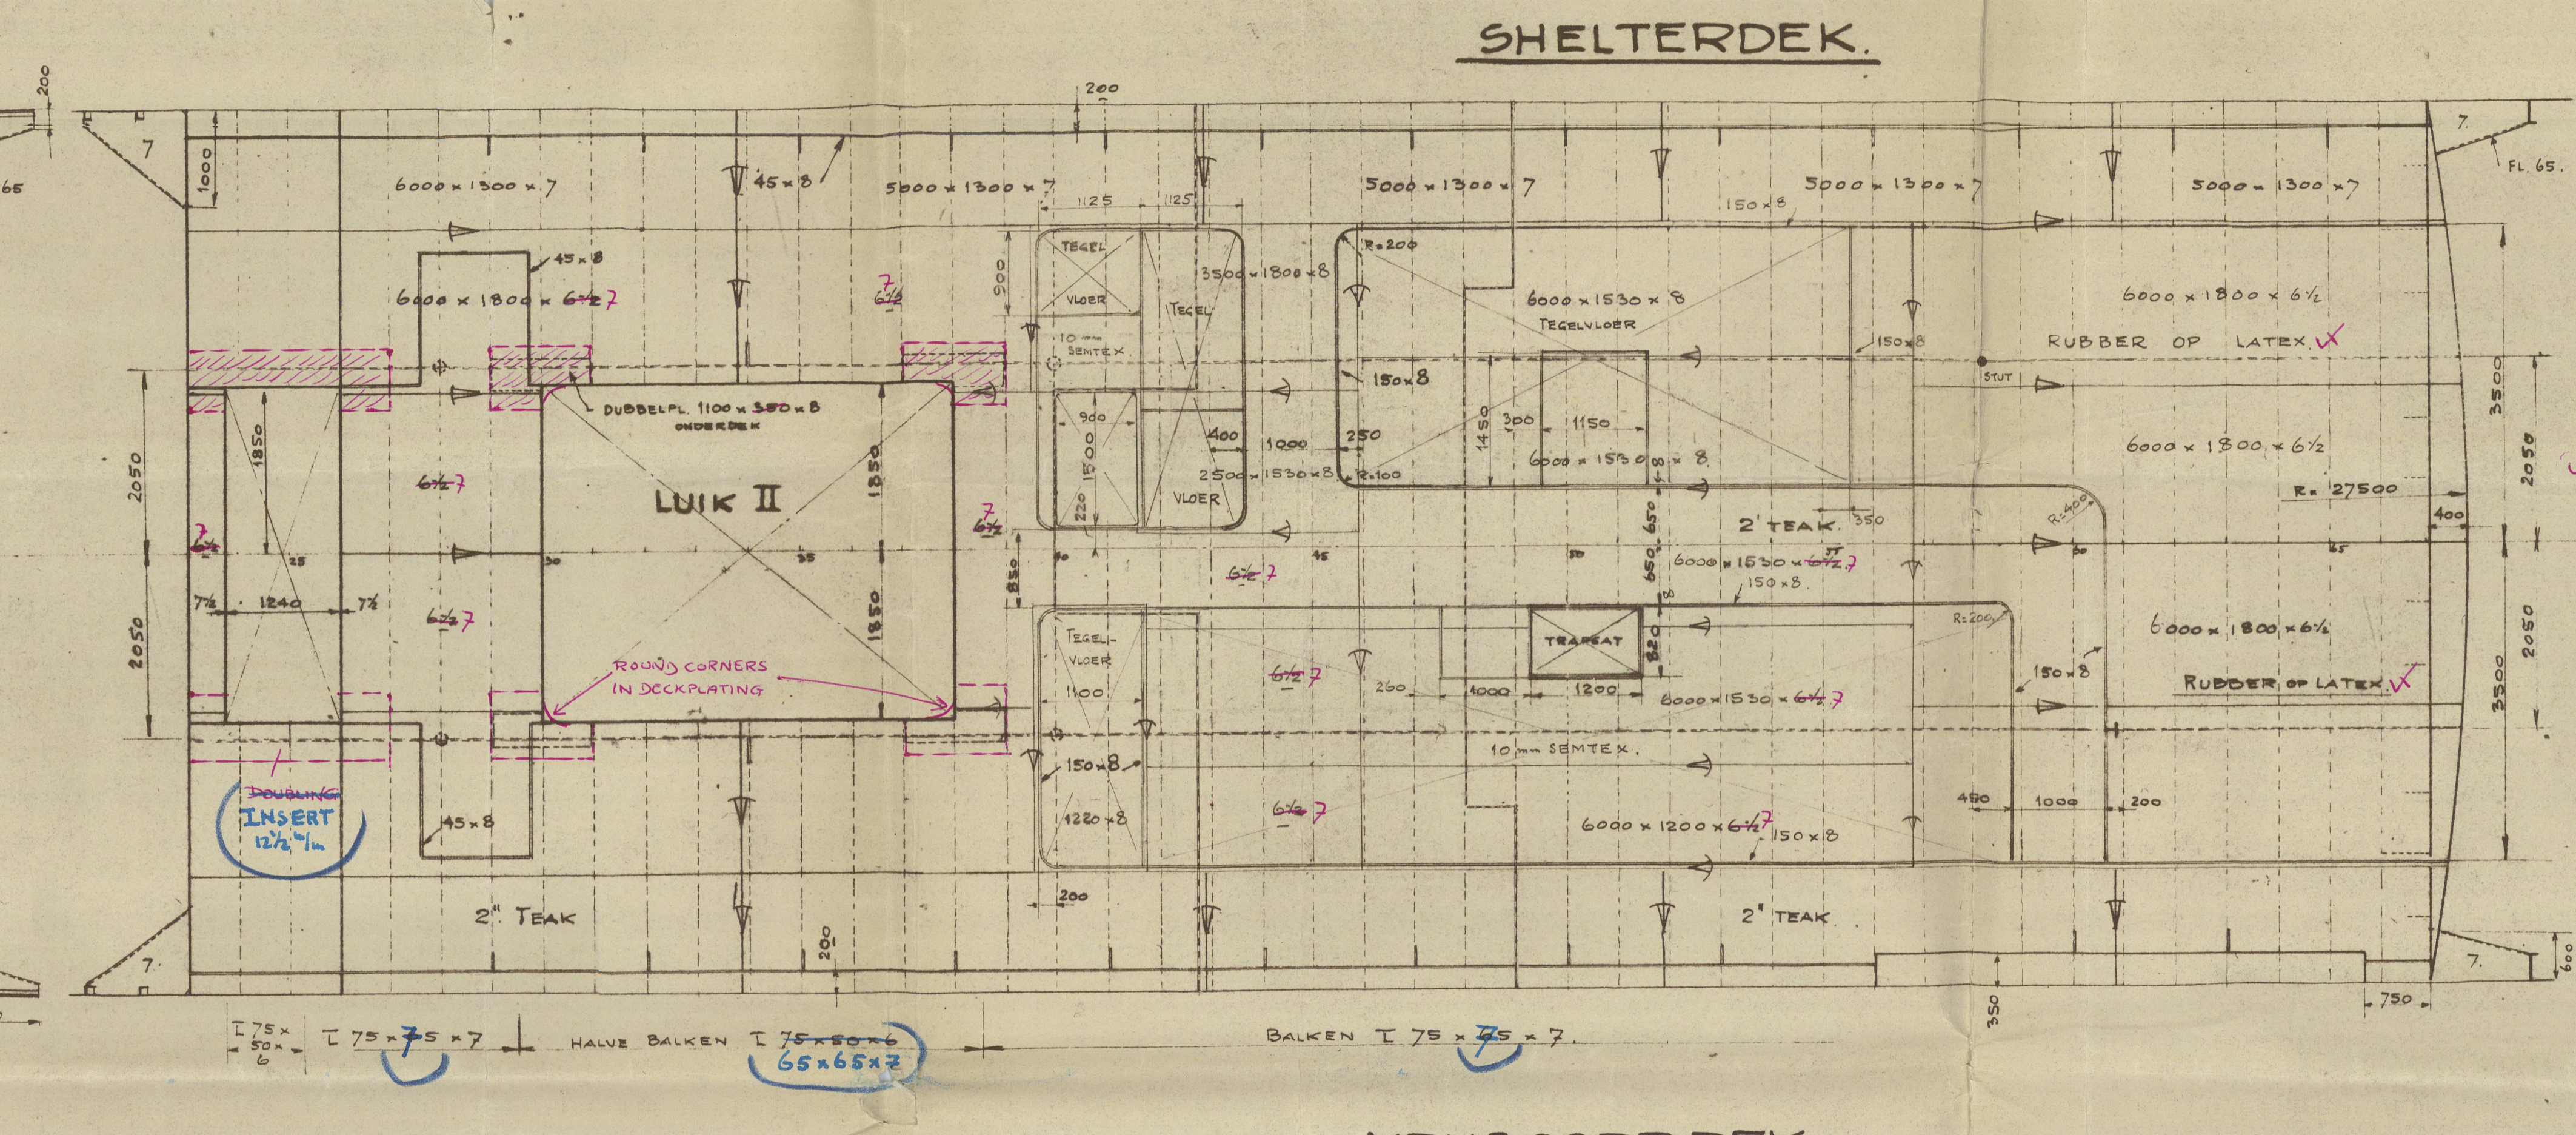
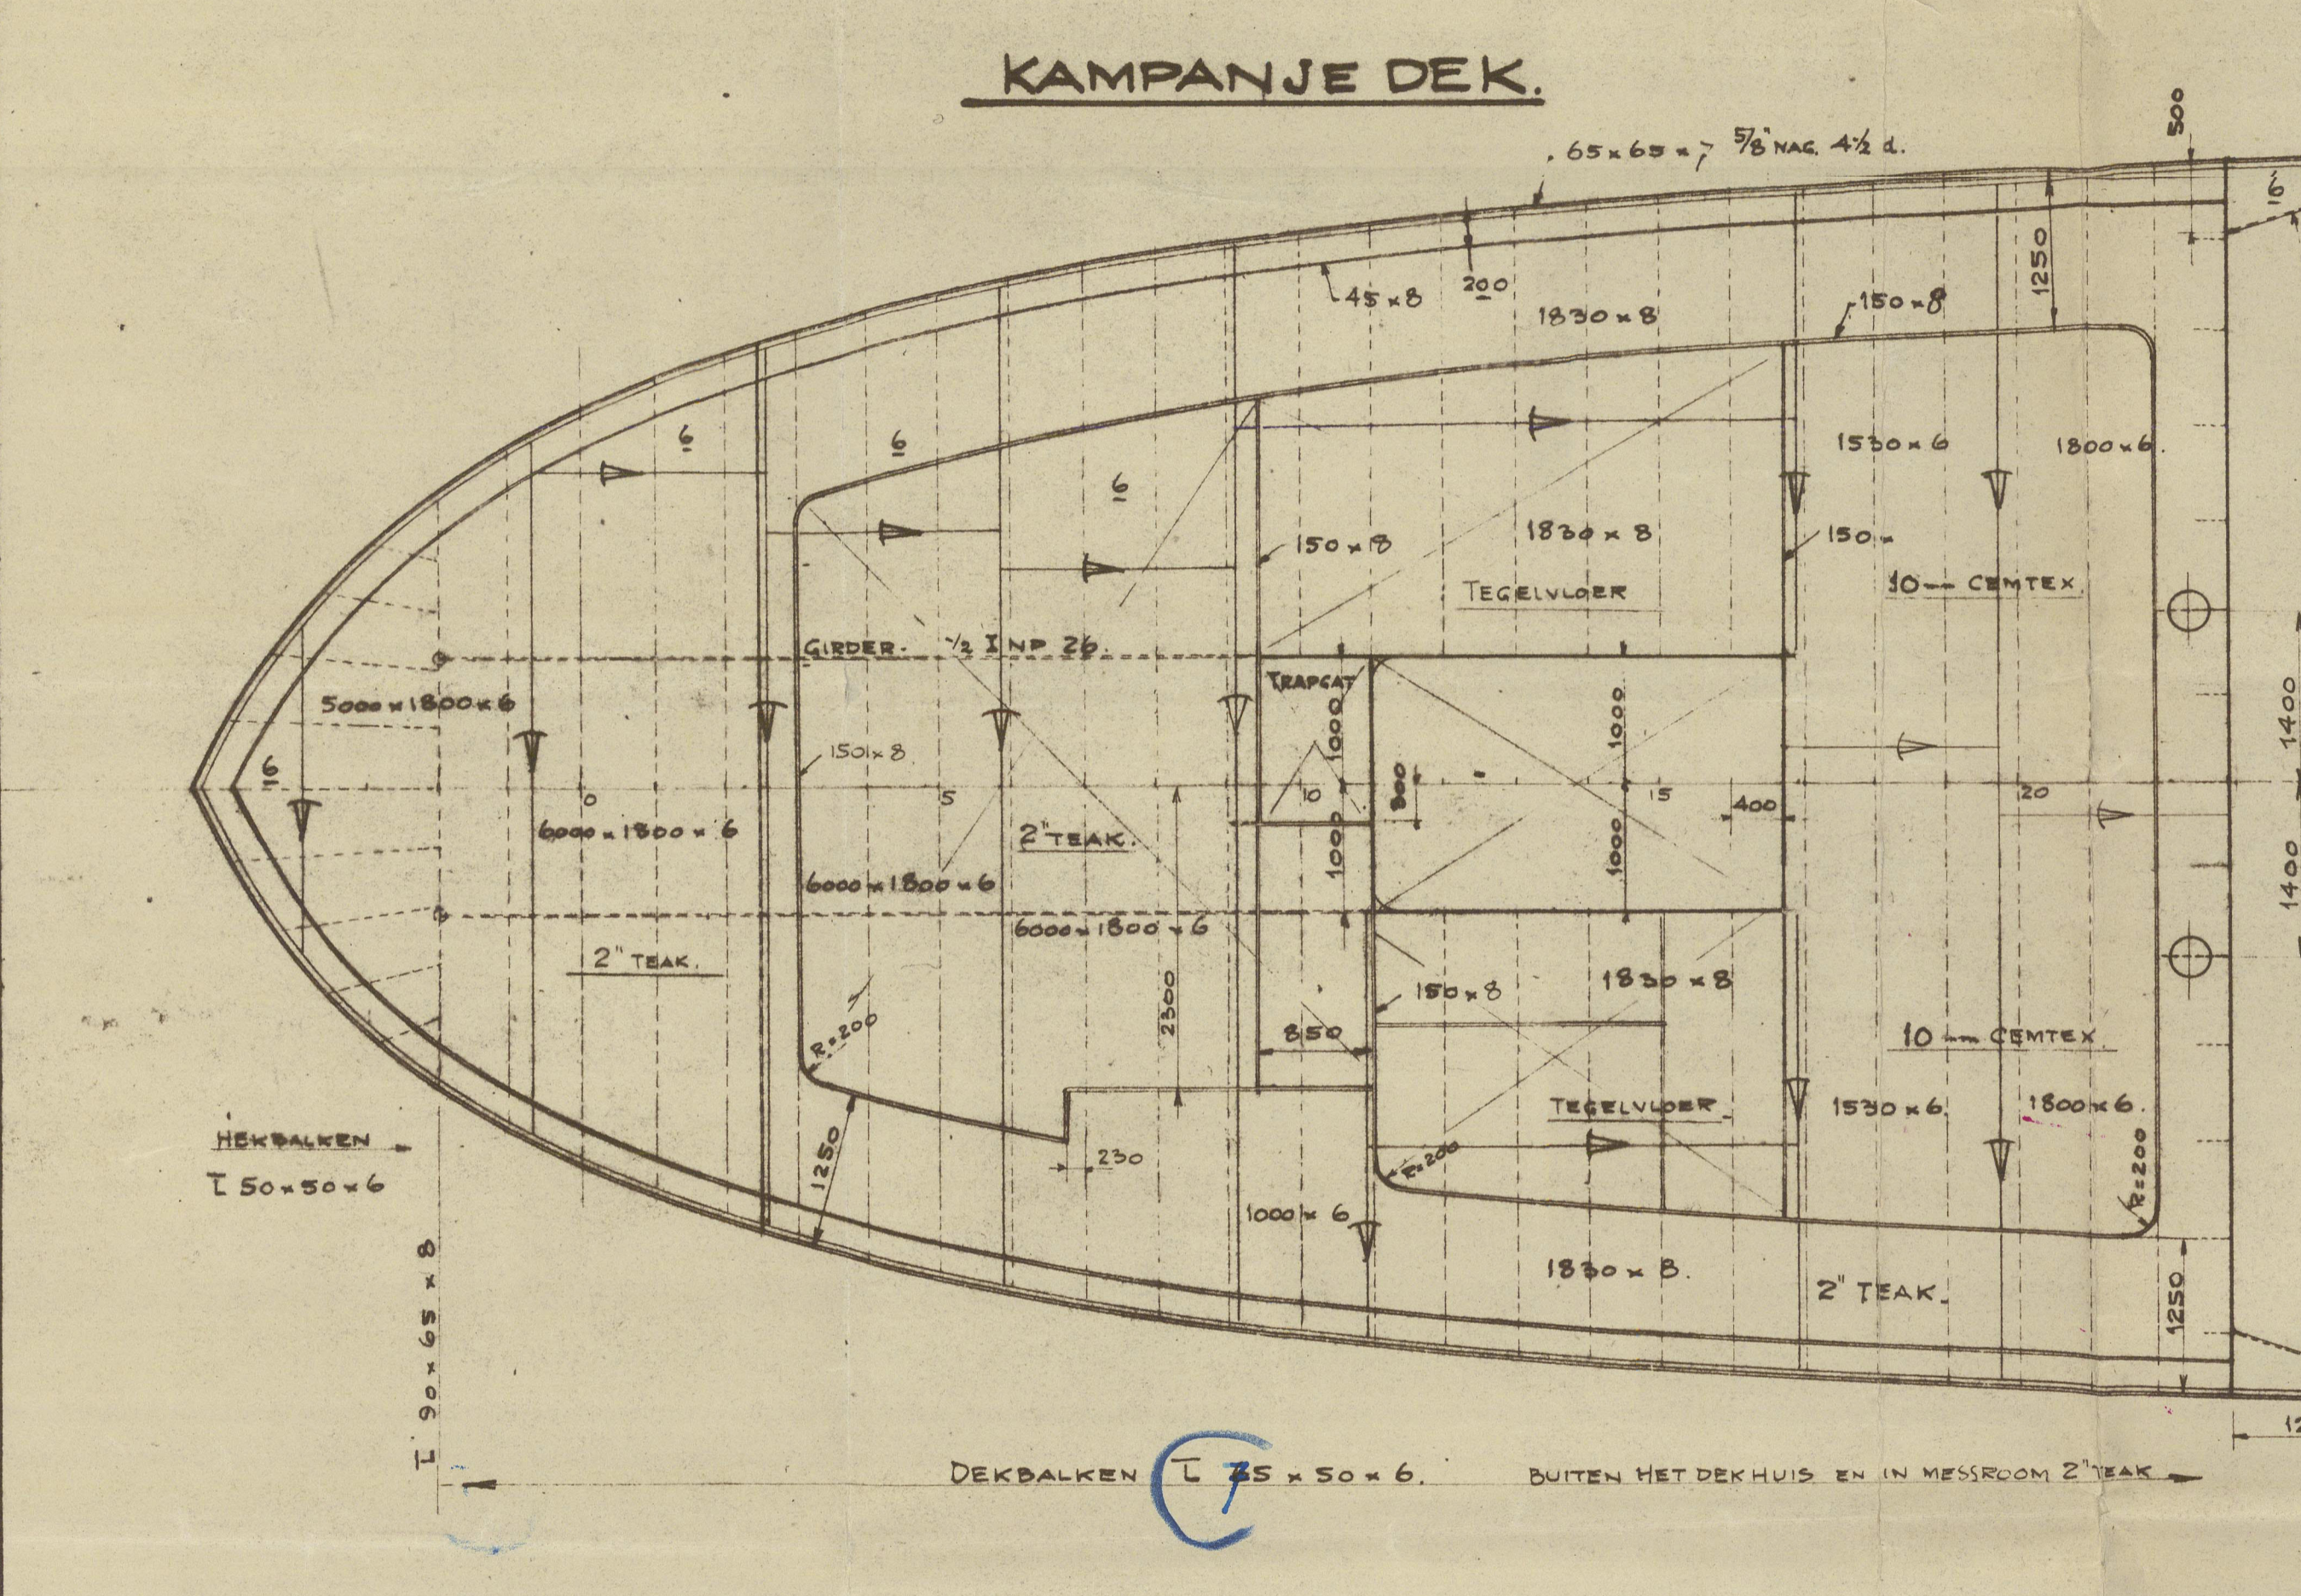
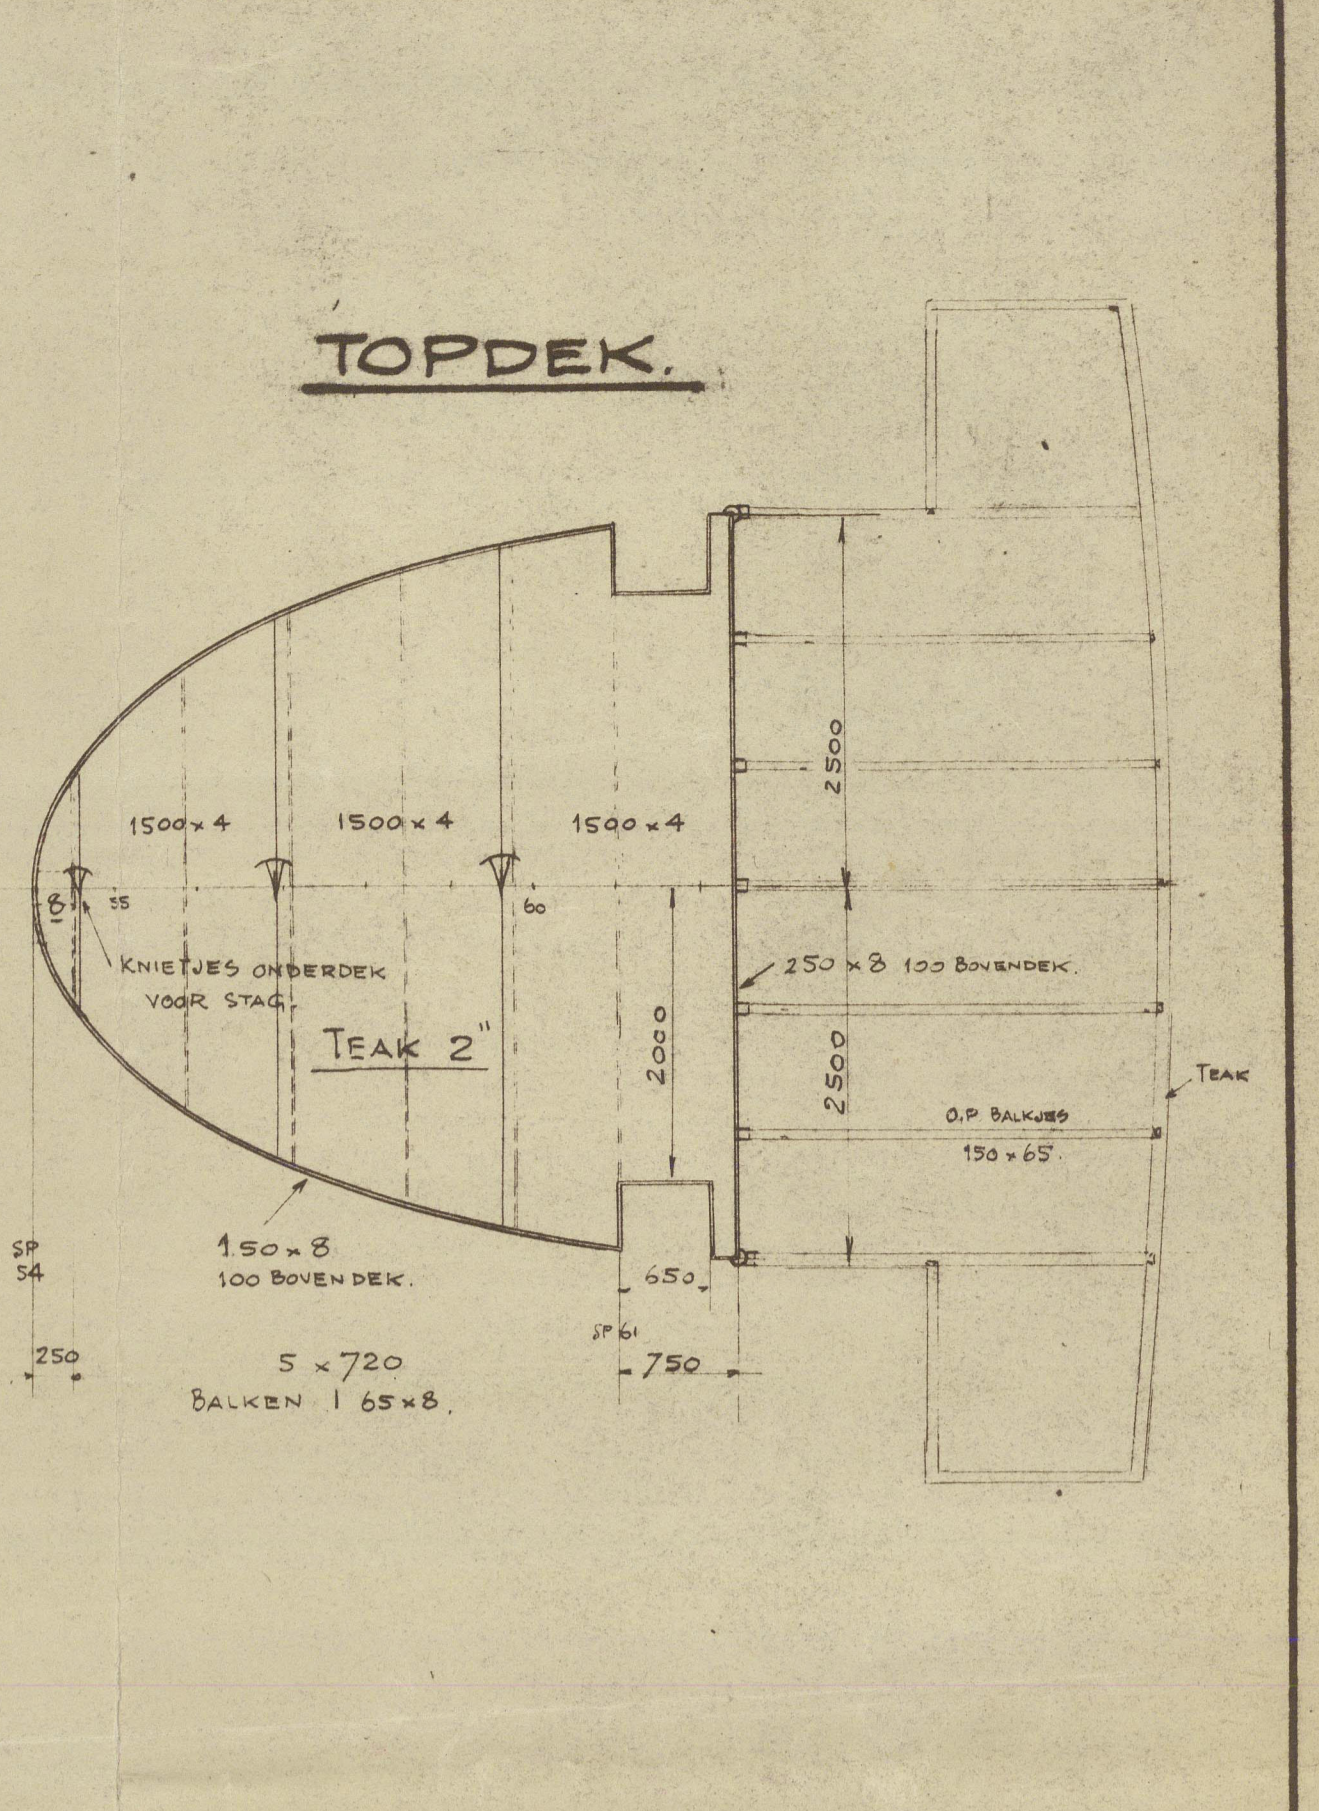
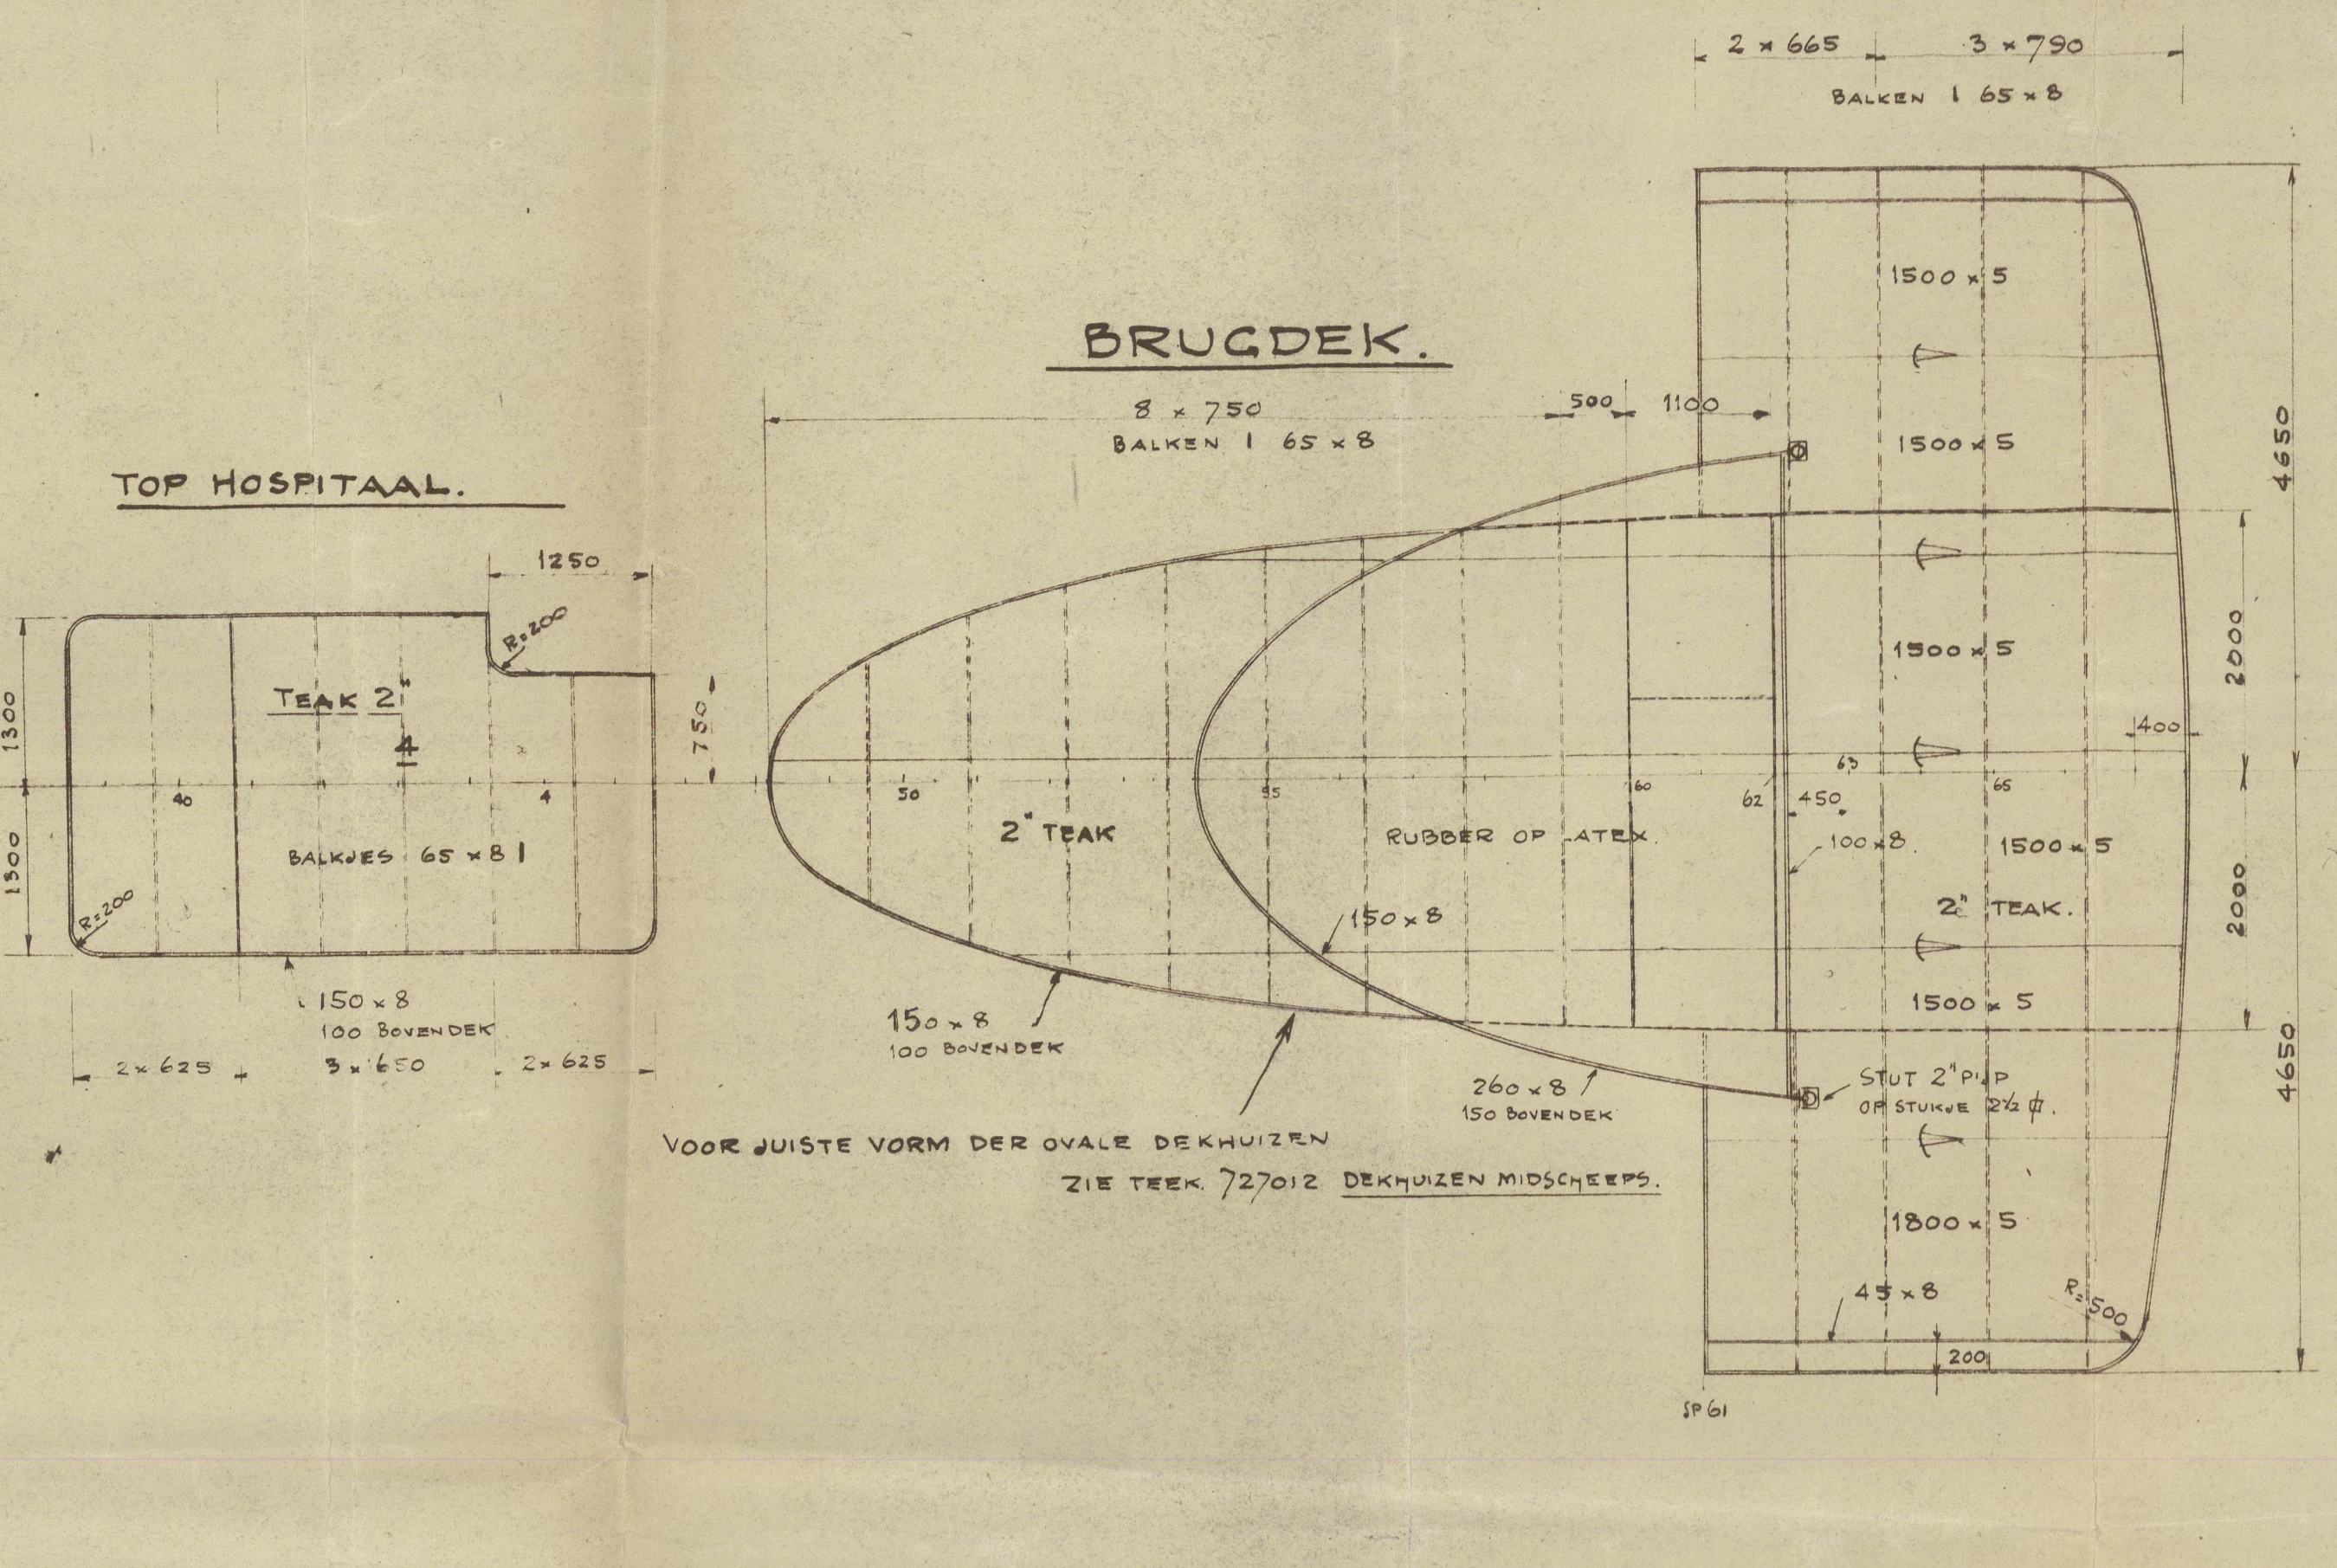
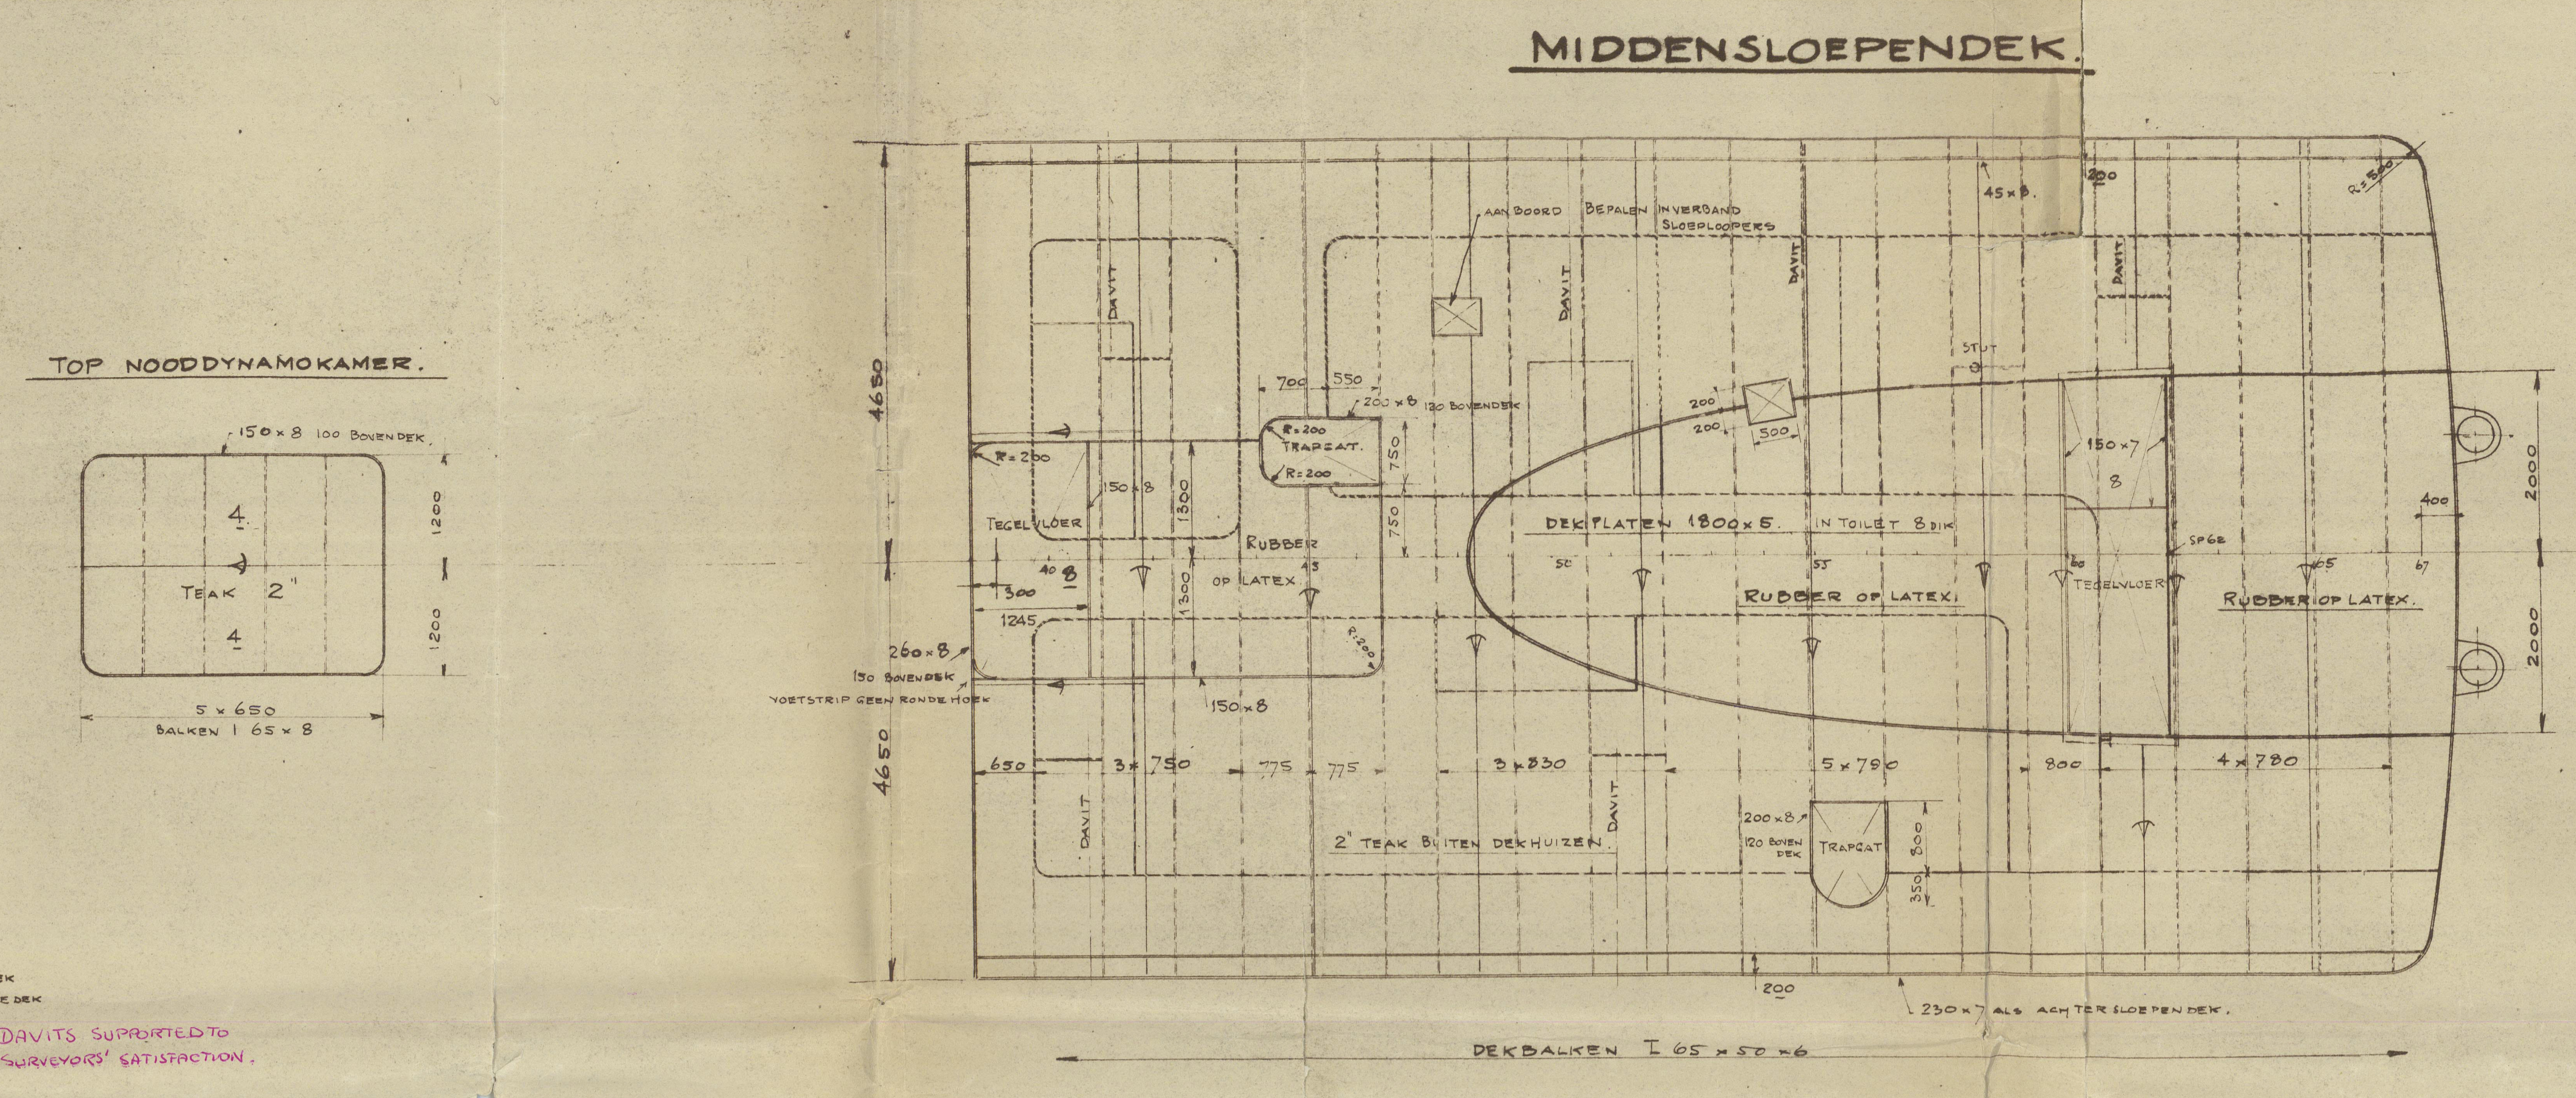


5-3-93

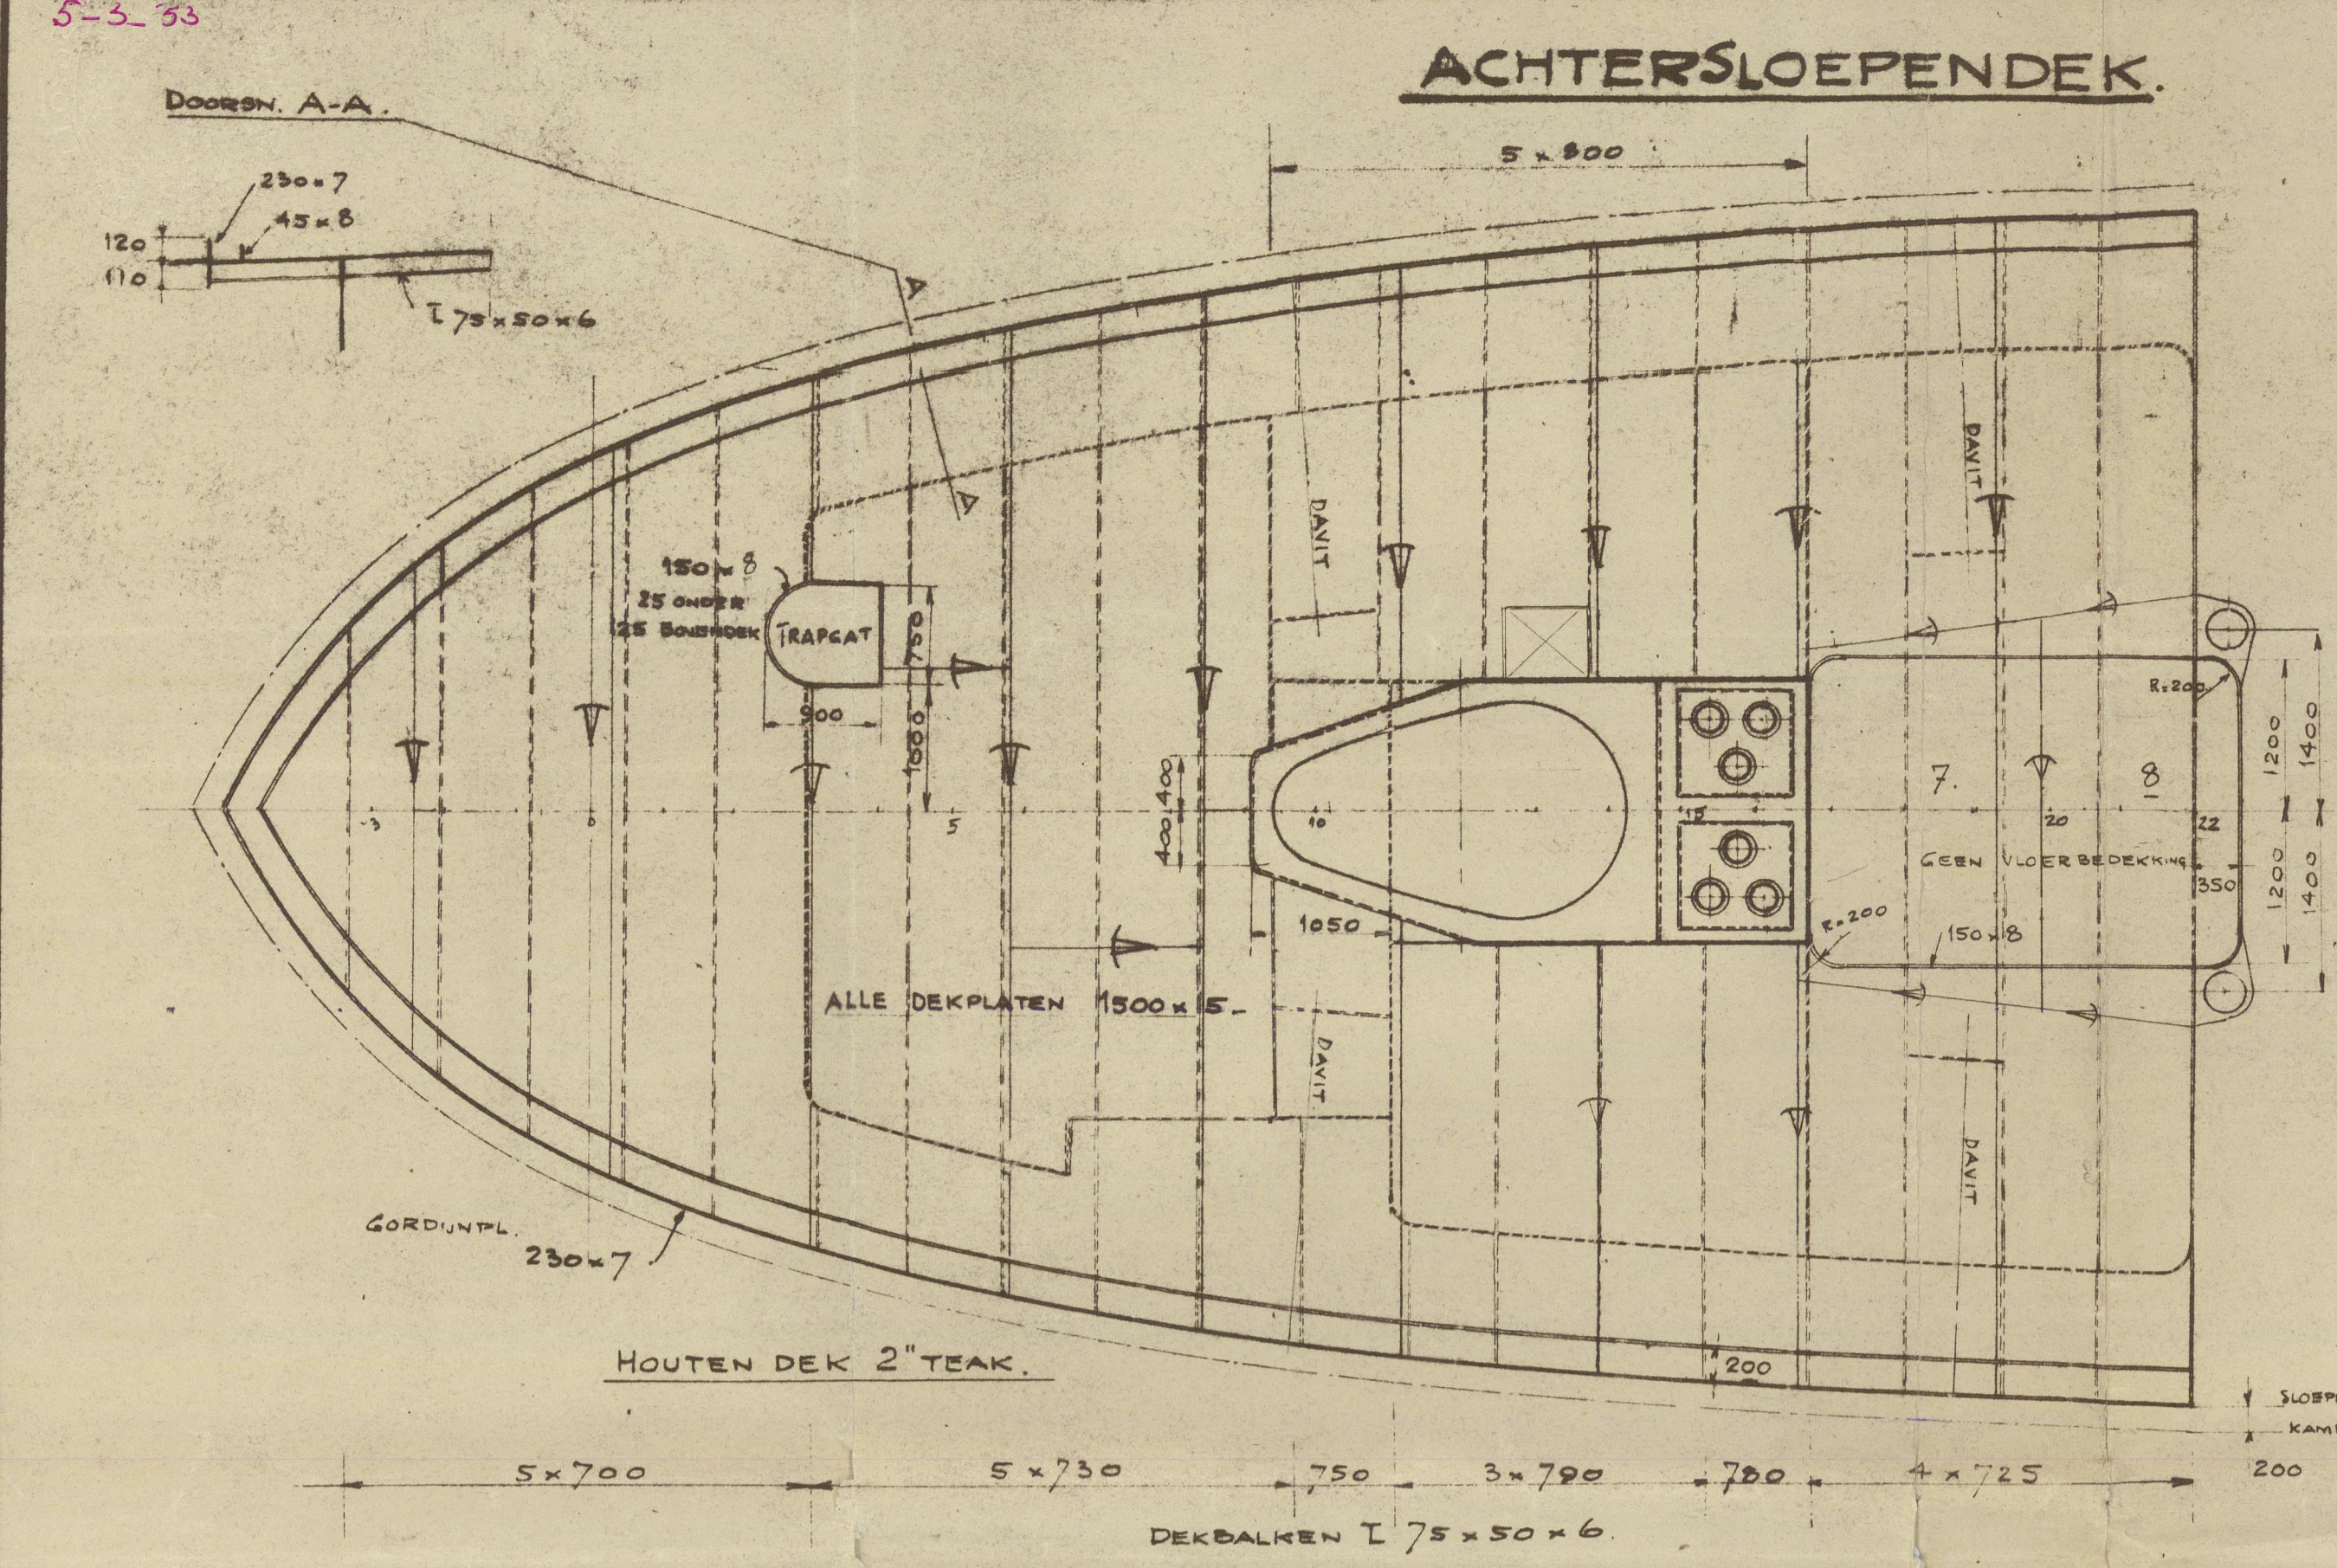

DEKKENPLAN.

SCHAAL 1:50.

BELONGT TOE GRONINGEN NO. 85-1-156
VESSEL'S NAME: "PUSPARAGAM"

WIZIGINGEN: LAYEN, DATUM, BAAIJ

N.V. E.J. SMIT & ZOON'S
SCHEEPSWERVEN
WESTERDROEK (GR.) HOLLAND.

DEKKENPLAN.
SCHAAL 1:50.

BLAD II

D/s 684

Deck plan.

* PUSPARAGAM.

RECORDS DEPT
LONDON

2

D/s 684



© 2021

Lloyd's Register
Foundation

012522-012526-0174